


Rev No.	Date	Reason for issue	Issued by	Rev No.	Date	Reason for issue	Issue	ued by	Rev No.	Date	Reason for issue	Issued by	Cono This
Α	16.10.19	ISSUED FOR INFORMATION AND COORDINATION	MN										stag
В	08.11.19	ISSUED FOR INFORMATION AND COORDINATION	MN										who
C	27.11.19	ISSUED FOR TOWN PLANNING	RM										1.
D	03.04.20	ISSUED FOR TOWN PLANNING RFI	AM										Fr
E	29.05.20	ISSUED FOR TOWN PLANNING RFI	MN										2.
F	11.12.20	ISSUED FOR TOWN PLANNING RFI	MS										(
G	06.05.21	ISSUED FOR TOWN PLANNING RFI	RM										(1
H	24.06.21	ISSUED FOR TOWN PLANNING RFI	RM										`
	05.05.22	ISSUED FOR TP ENDORSEMENT – INFO & COORDINATION	RM										(0
J	10.03.23	ISSUED FOR TP ENDORSEMENT - RFI	DH										
K	21.11.23	ISSUED FOR TP AMENDMENT	DH										((
K	21.11.23	ISSUED FOR TP AMENDMENT	DH										3.
													e>
													Fr

17155 - 300 CITY ROAD SOUTHBANK

TOWN PLANNING ENDORSEMENT

SITE INF	ORMATION	
A0000	DRAWING LIST & LOCATION PLAN	
A0001	SITE CONTEXT PLAN	
A0002	SITE SURVEY PLAN	
A0003	EXISTING BUILDING PLAN	
	DEMOLITION PLAN	
A0005	HERITAGE FACADE - EXISTING / PROPOSED	
GENERA	L ARRANGEMENT FLOOR PLANS	
	BASEMENT 01 PLAN	
A0100_l	.G LOWER GROUND FLOOR PLAN \downarrow	
A0100_U	JG GROUND FLOOR PLAN 🗧 🗧	
A0101	LEVEL 01 FLOOR PLAN - OFFICE AND SERVICES 🕥	
A0102	LEVEL 02 FLOOR PLAN - COMMON AREA 🛛 🔍	
A0103	LEVEL 03 - 07 FLOOR PLAN 🛛 🕹 🔾	
A0108	LEVEL 08, 10 -29 FLOOR PLAN	
A0109	LEVEL 09 FLOOR PLAN - PLANT ROOM	
A0130	LEVEL 30 FLOOR PLANS - ROOF	
A0131	LEVEL 31 FLOOR PLAN - MACHINE ROOM	
ELEVATI)NS	
A0900	SOUTH ELEVATION - CITY ROAD	
A0901	NORTH ELEVATION - HAIG LANE	
A0902	EAST ELEVATION - CLARKE STREET	
A0903	WEST ELEVATION	
SECTION	s s	
SECTION A0950	S SECTION A-A	
	-	
A0950 A0951	SECTION A-A SECTION B-B	
A0950 A0951 ELEMEN	SECTION A-A SECTION B-B	
A0950 A0951	SECTION A-A SECTION B-B	
A0950 A0951 ELEMEN A1102	SECTION A-A SECTION B-B TAL DETAILS HERITAGE FACADE OPENING DETAIL	
A0950 A0951 ELEMEN A1102 A1103	SECTION A-A SECTION B-B TAL DETAILS HERITAGE FACADE OPENING DETAIL THROUGH-LINK PORTAL DETAIL	
A0950 A0951 ELEMEN A1102 A1103 A1104	SECTION A-A SECTION B-B TAL DETAILS HERITAGE FACADE OPENING DETAIL THROUGH-LINK PORTAL DETAIL THROUGH-LINK CANOPY DETAIL	
A0950 A0951 ELEMEN A1102 A1103 A1104 A1105 A1106	SECTION A-A SECTION B-B TAL DETAILS HERITAGE FACADE OPENING DETAIL THROUGH-LINK PORTAL DETAIL THROUGH-LINK CANOPY DETAIL THROUGH-LINK CANOPY DETAIL THROUGH-LINK CANOPY DETAIL	
A0950 A0951 A0950 A0951 ELEMEN A1102 A1103 A1104 A1105 A1106 WALL SE A1600 A1601 A1602 A1603 A1604 A1605 A1606 A1605 A1606 A1606	SECTION A-A SECTION B-B TAL DETAILS HERITAGE FACADE OPENING DETAIL THROUGH-LINK PORTAL DETAIL THROUGH-LINK CANOPY DETAIL THROUGH-LINK CANOPY DETAIL THROUGH-LINK CANOPY DETAIL THROUGH-LINK CANOPY DETAIL WALL SECTION SHEET 01 WALL SECTION SHEET 02 WALL SECTION SHEET 03 WALL SECTION SHEET 04 WALL SECTION SHEET 05 WALL SECTION SHEET 05 WALL SECTION SHEET 07 ENT TYPES	
A0950 A0951 ELEMEN A1102 A1103 A1104 A1105 A1106 WALL SE A1600 A1601 A1602 A1603 A1604 A1605 A1606 A1605 A1606 A1605 A1606	SECTION A-A SECTION B-B TAL DETAILS HERITAGE FACADE OPENING DETAIL THROUGH-LINK PORTAL DETAIL THROUGH-LINK CANOPY DETAIL THROUGH-LINK CANOPY DETAIL THROUGH-LINK CANOPY DETAIL THROUGH-LINK CANOPY DETAIL CTION WALL SECTION SHEET 01 WALL SECTION SHEET 02 WALL SECTION SHEET 03 WALL SECTION SHEET 04 WALL SECTION SHEET 05 WALL SECTION SHEET 05 WALL SECTION SHEET 07 ENT TYPES APARTMENT TYPES - BADS ANALYSIS SHEET 01	
A0950 A0951 ELEMEN A1102 A1103 A1104 A1105 A1106 WALL SE A1600 A1601 A1602 A1603 A1604 A1605 A1606 A1605 A1606 A1606	SECTION A-A SECTION B-B TAL DETAILS HERITAGE FACADE OPENING DETAIL THROUGH-LINK PORTAL DETAIL THROUGH-LINK CANOPY DETAIL THROUGH-LINK CANOPY DETAIL THROUGH-LINK CANOPY DETAIL THROUGH-LINK CANOPY DETAIL WALL SECTION SHEET 01 WALL SECTION SHEET 02 WALL SECTION SHEET 03 WALL SECTION SHEET 04 WALL SECTION SHEET 05 WALL SECTION SHEET 05 WALL SECTION SHEET 07 ENT TYPES	

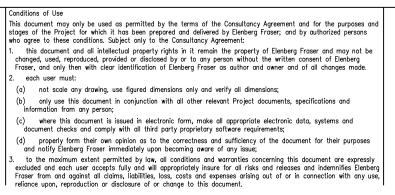



ELENBERG FRASER LEVEL 1, 160 QUEEN STREET

MELBOURNE VICTORIA 3000 AUSTRALIA TEL +61 3 9600 2260 FAX +61 3 9600 2266 EMAIL MAIL@ELENBERGFRASER.COM WWW.ELENBERGFRASER.COM ABN 97 556 188 726

IMG

Project Title

)
	1
)
)
	ノ
)
25	
_0)
	1
	1
	7
	<u>ک</u>
	~ <
	-)
	~ <
)
	~ <
)
	
)
	
)
	
)
	- <
)
	- 5
)
	- 5
)
	1
)
\sim	

300 CITY ROAD SOUTHBANK


Drawing Title **COVER PAGE**


ADVERTISED


PLAN

Project Number 17155 Drawing Status TP

Drawing Number A0000 Revision Jan 29, 2024 — 4:01pm

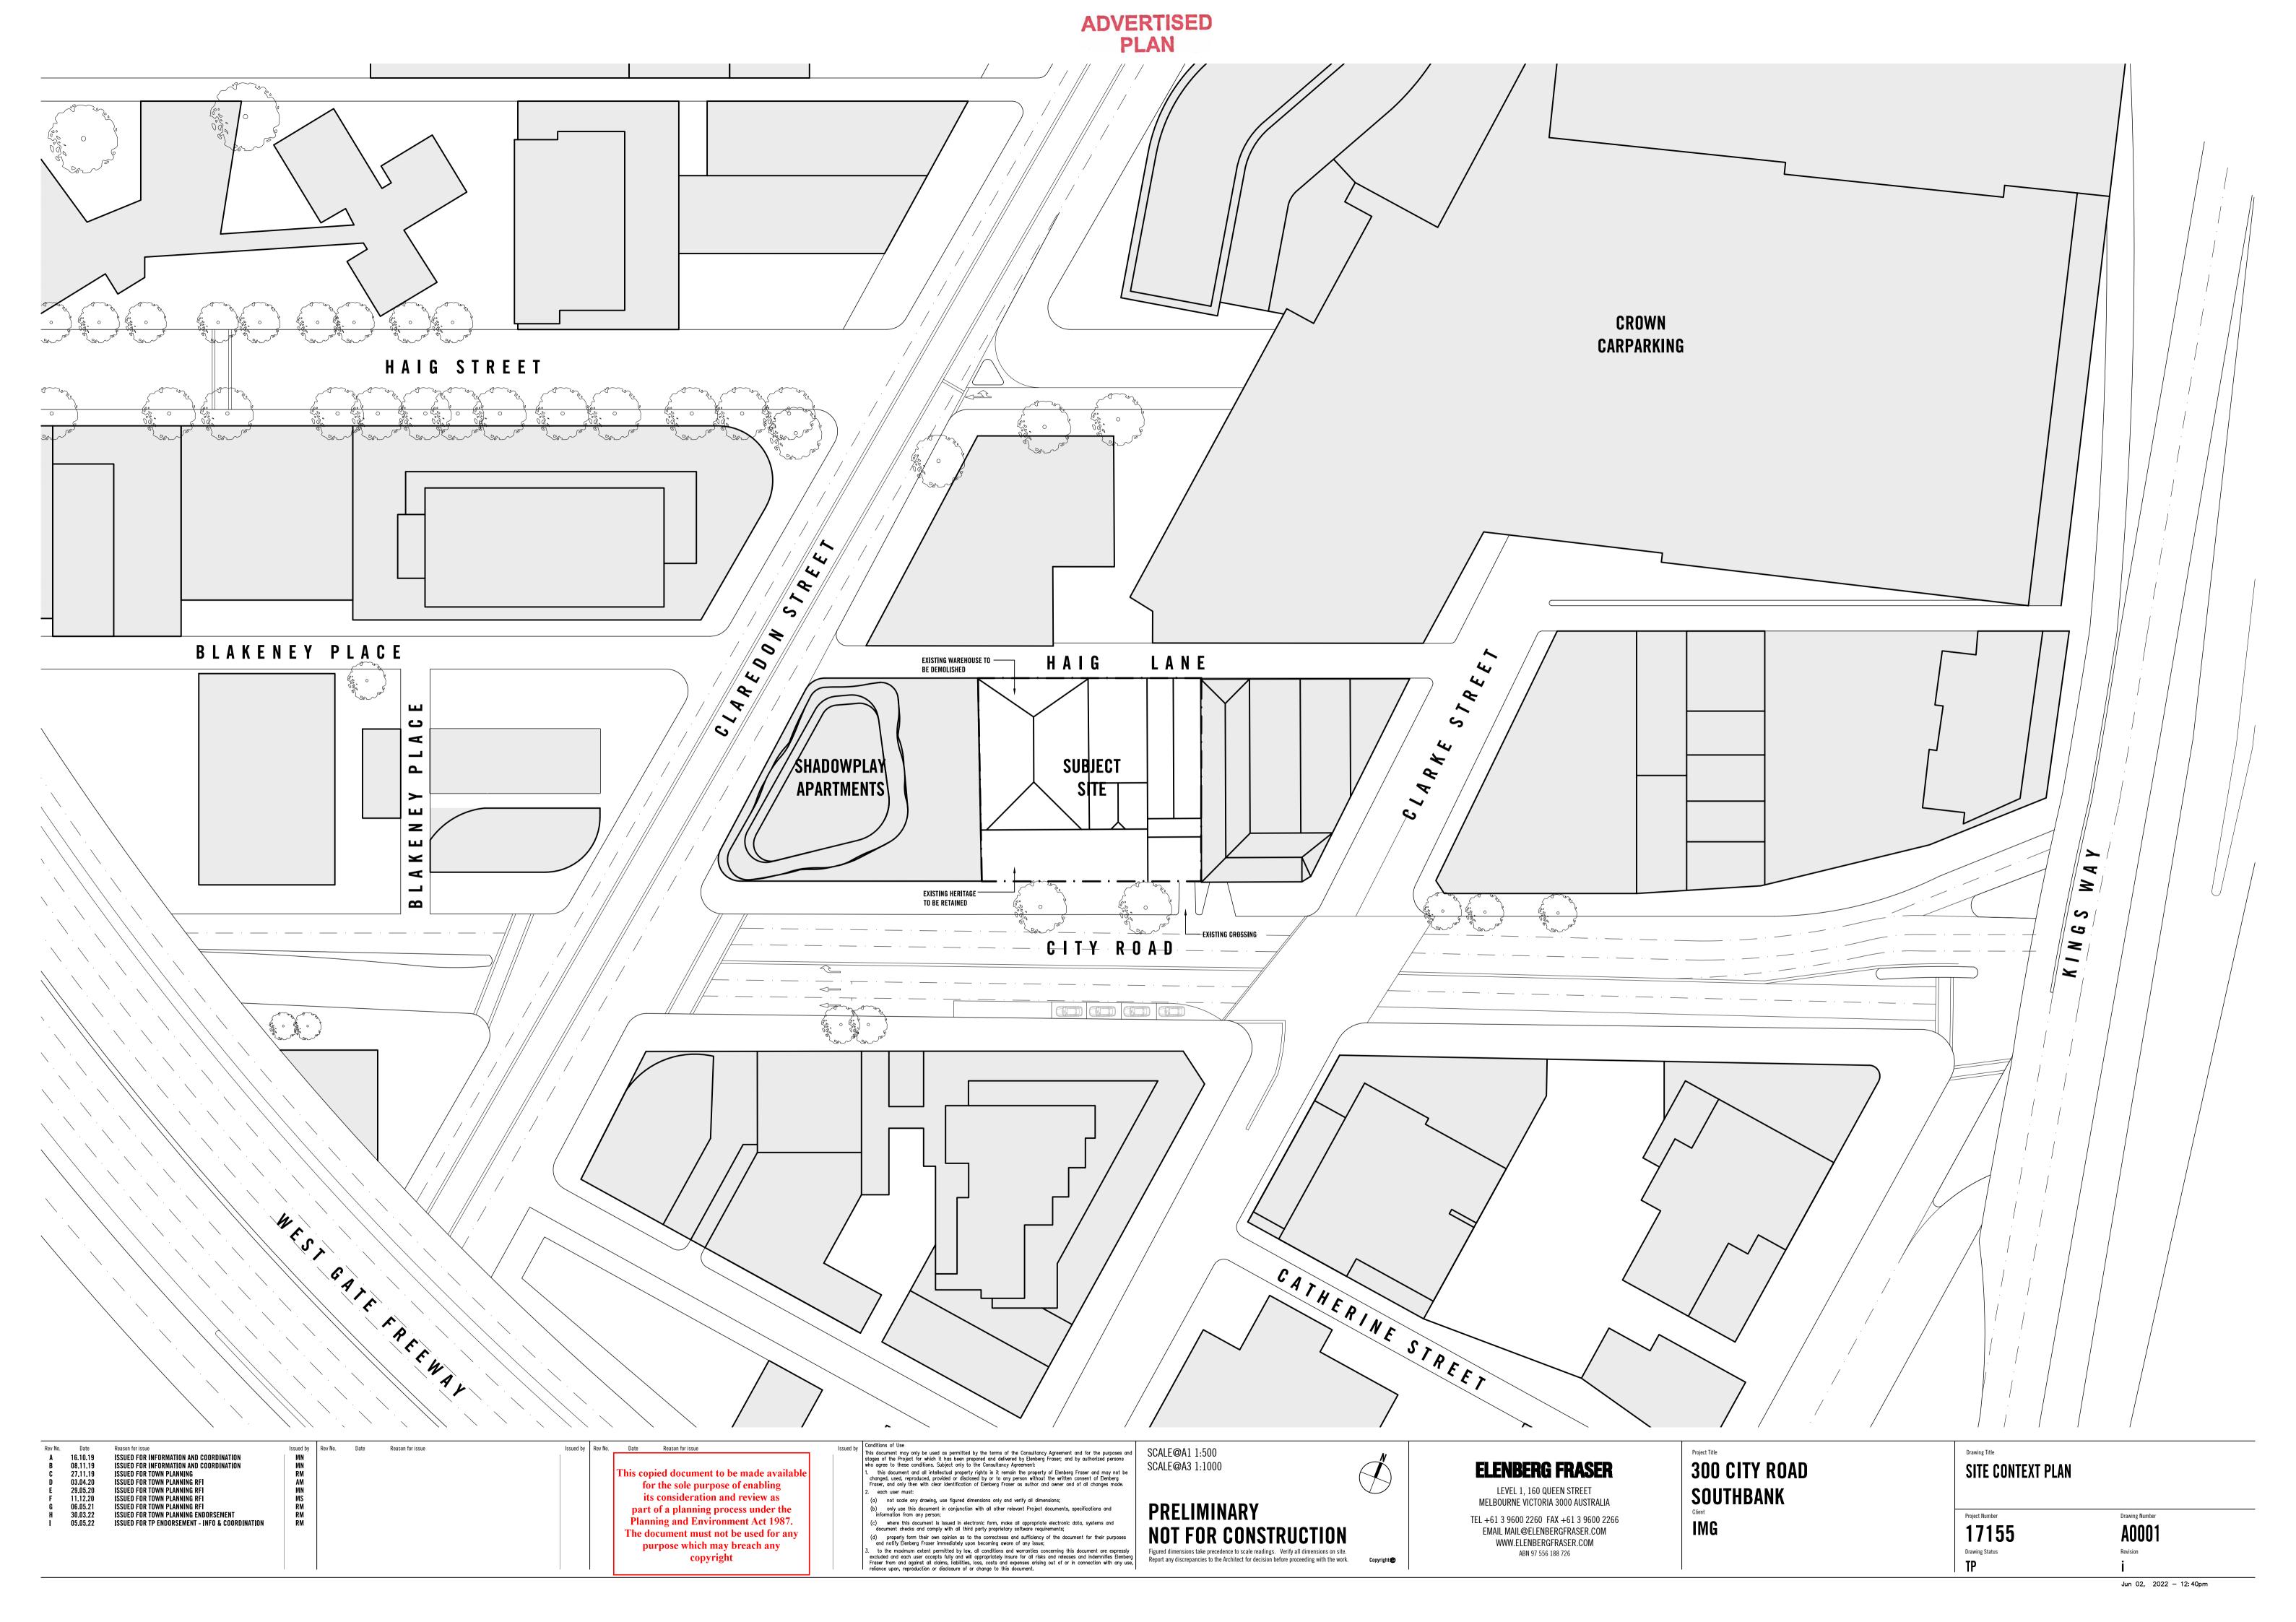

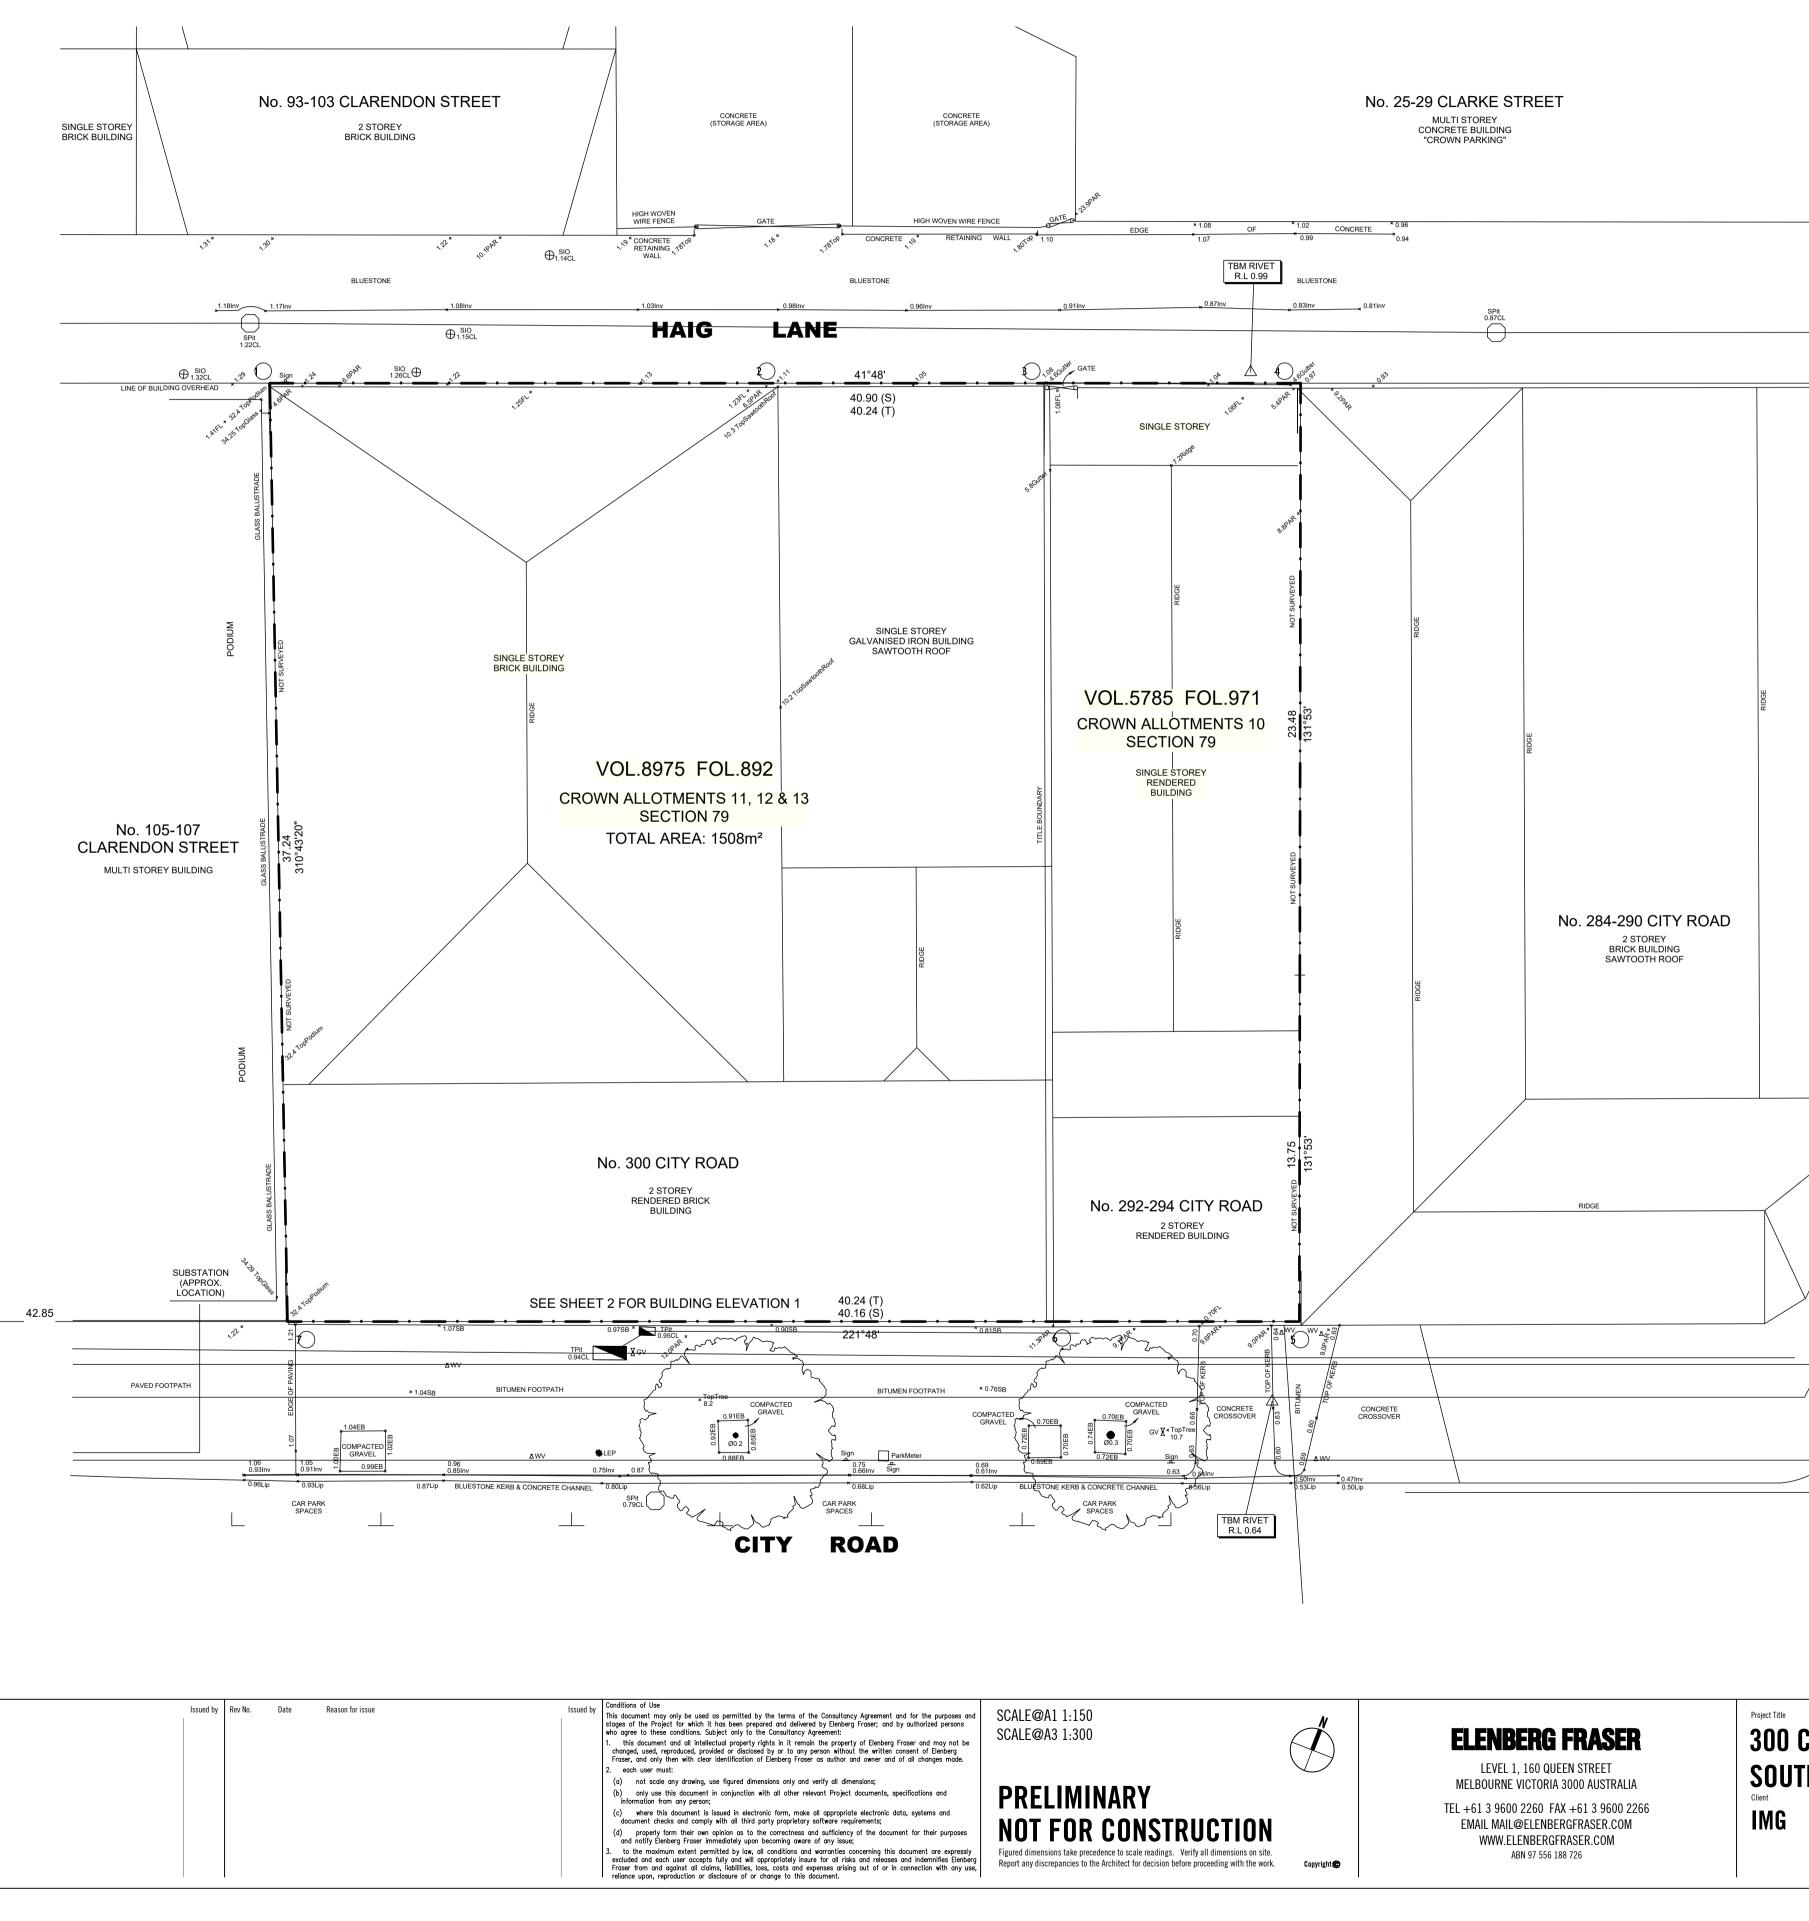

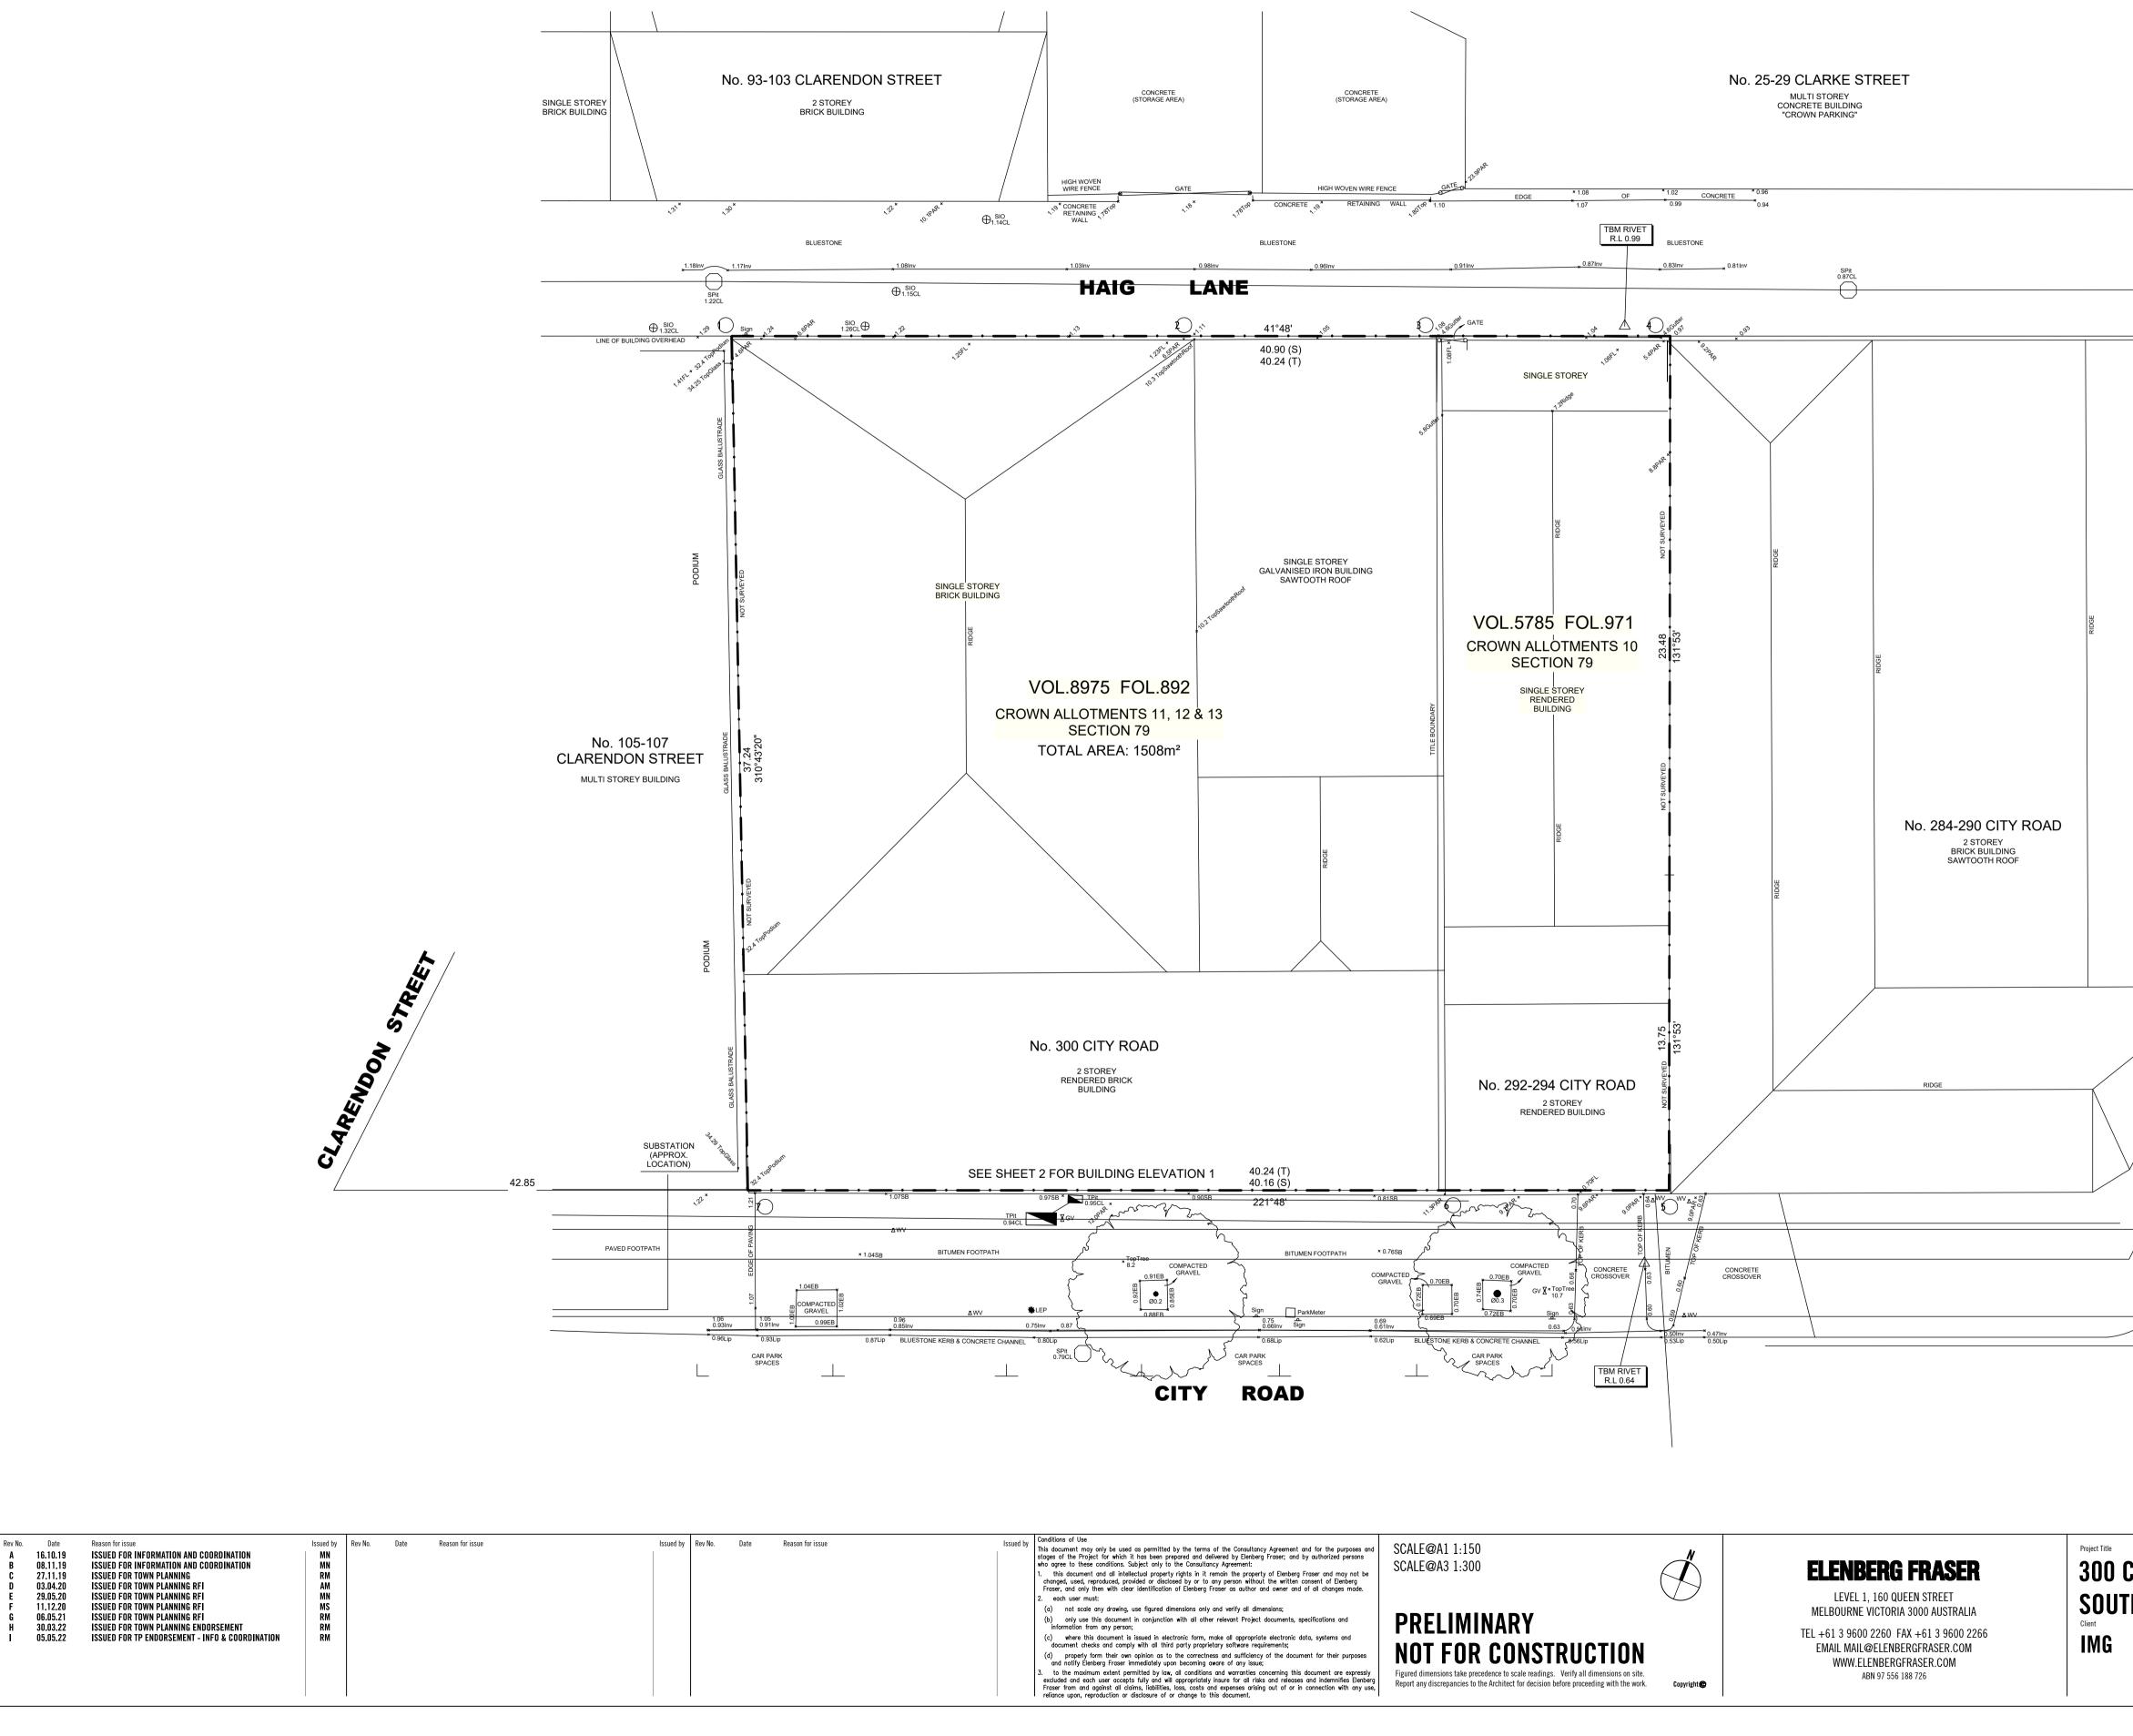

ADVERTISED PLAN


Drawing Title **300 CITY ROAD** SITE SURVEY PLAN SOUTHBANK Project Number Drawing Number 17155 A0002 Drawing Status Revision TP Jun 02, 2022 – 12:40pm


HH H

STR


CLARKE **SURVEY INFORMATION** AUTHOR : REEDS SURVEY DATE: AUGUST 2019 SEE ORIGINAL SURVEY FOR FULL INFORMATION

This copied document to be made available for the sole purpose of enabling its consideration and review as part of a planning process under the Planning and Environment Act 1987. The document must not be used for any purpose which may breach any copyright

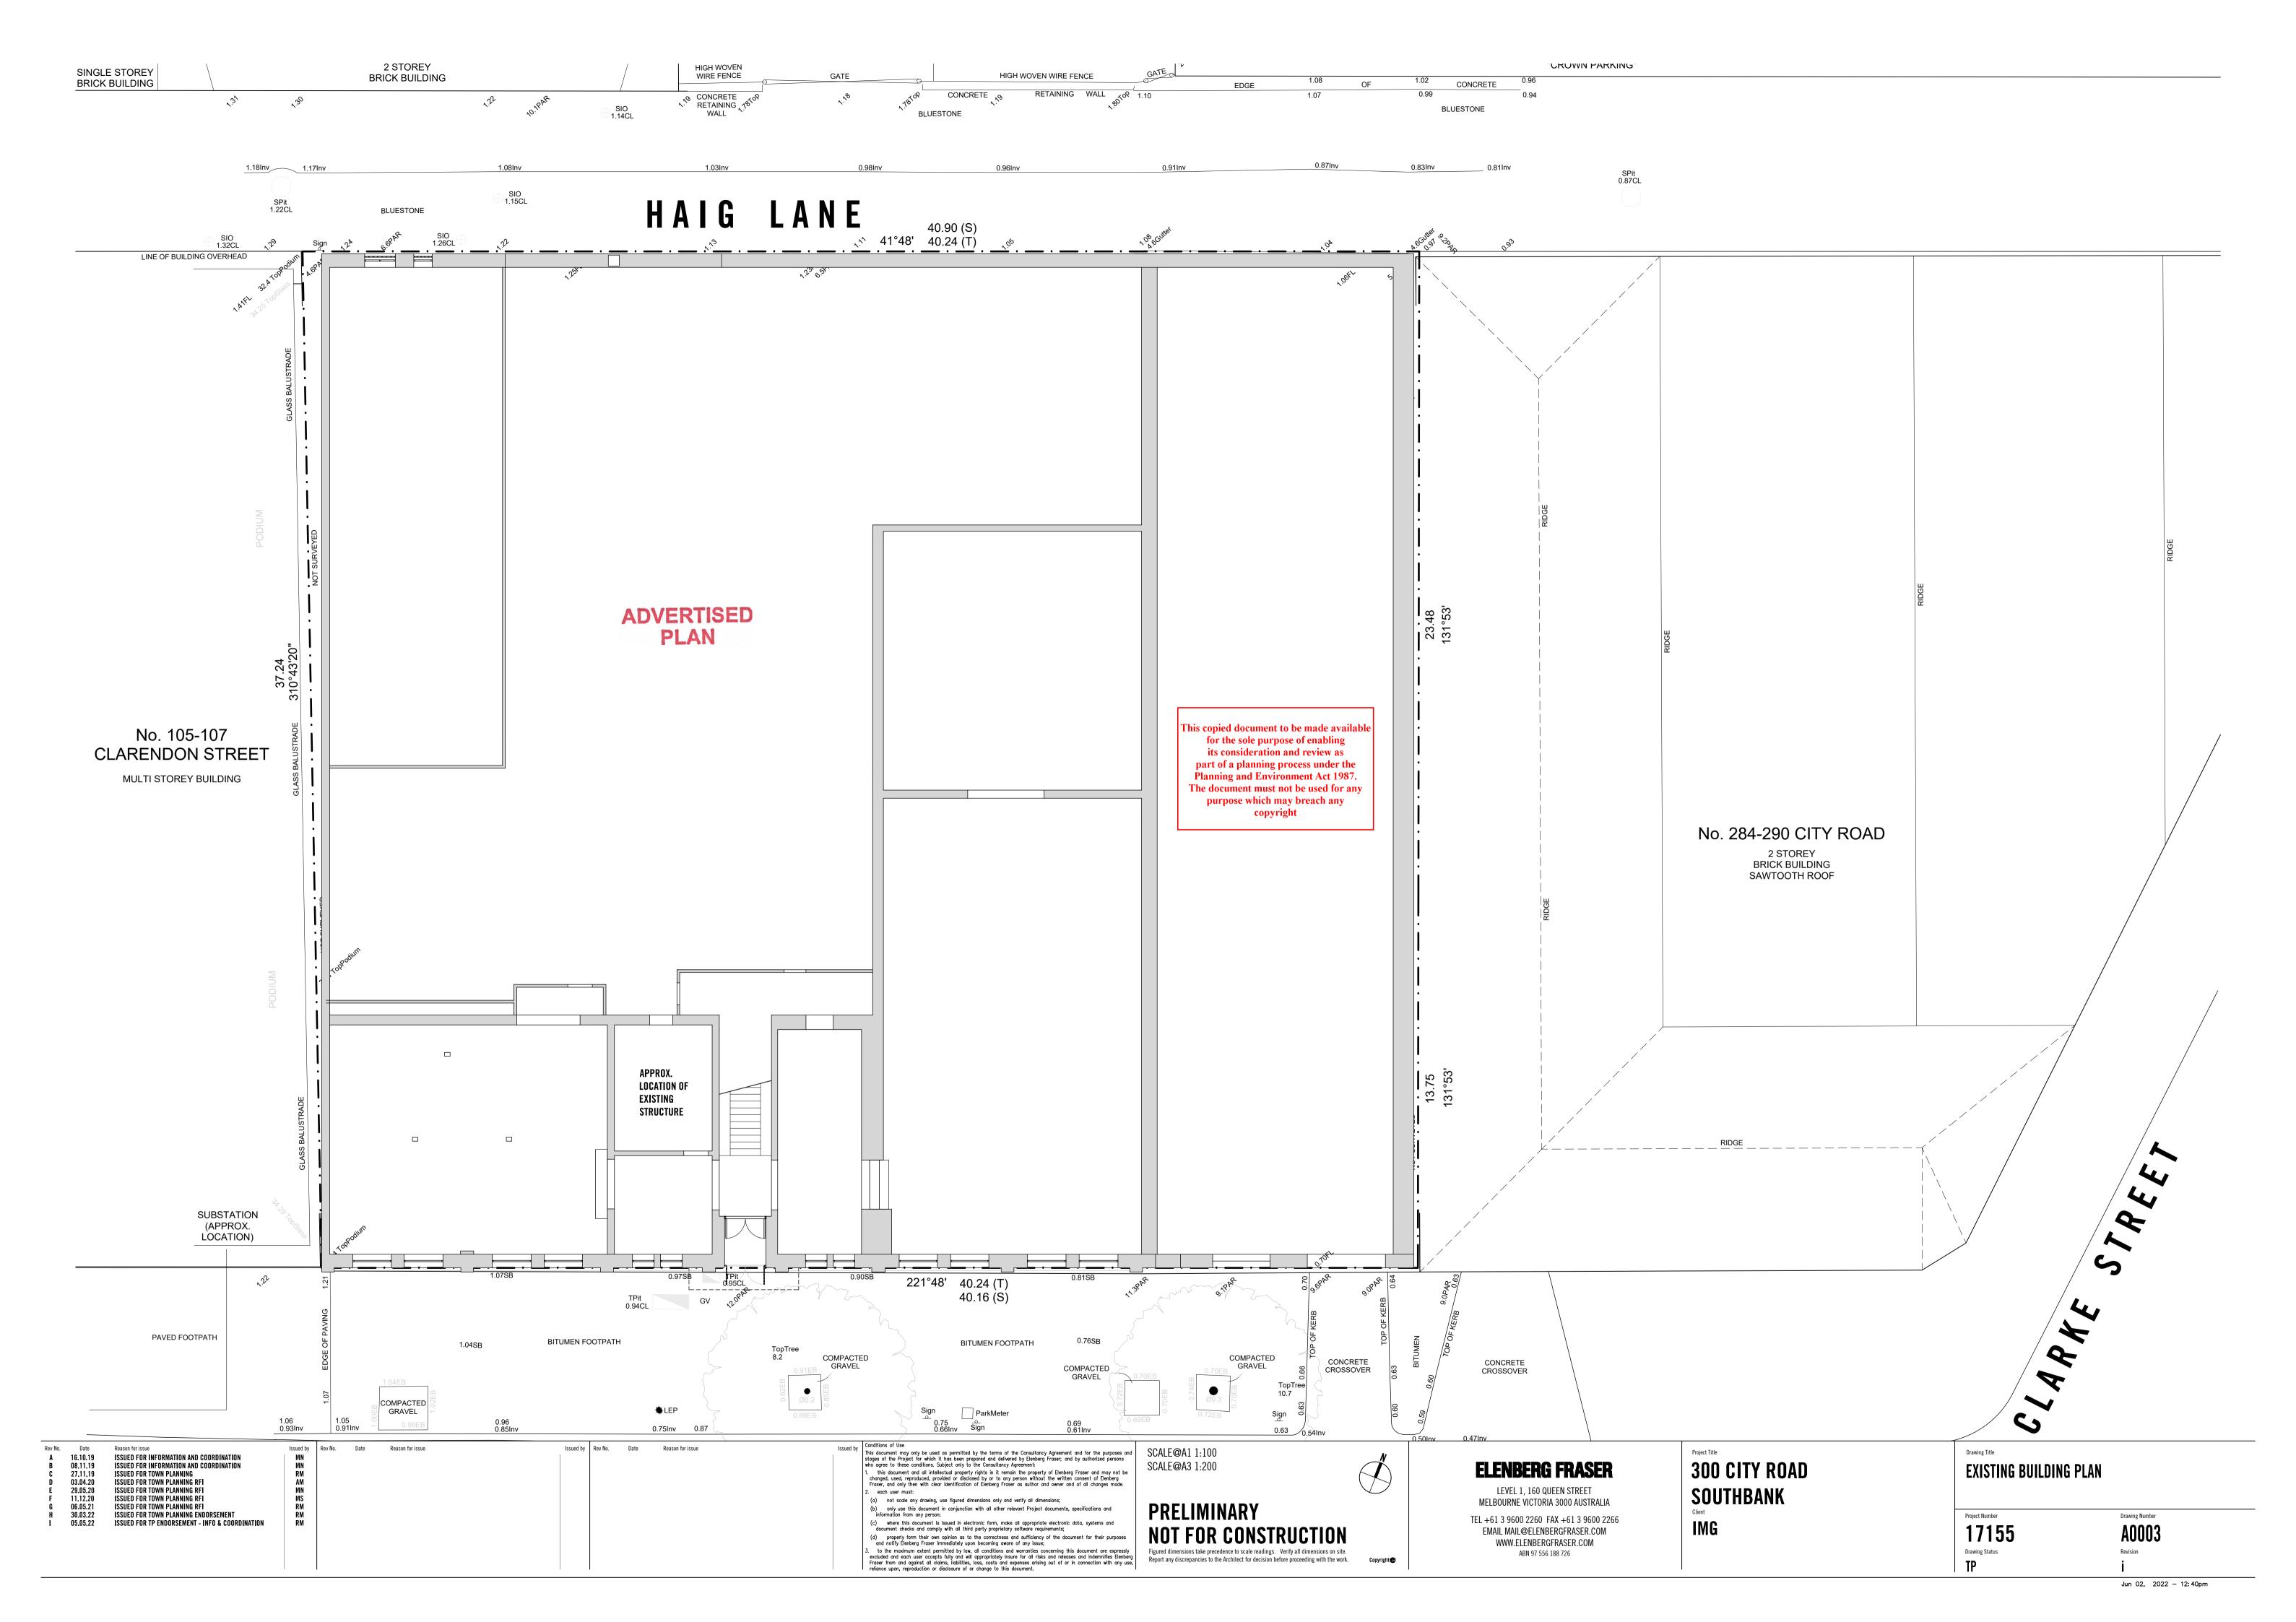

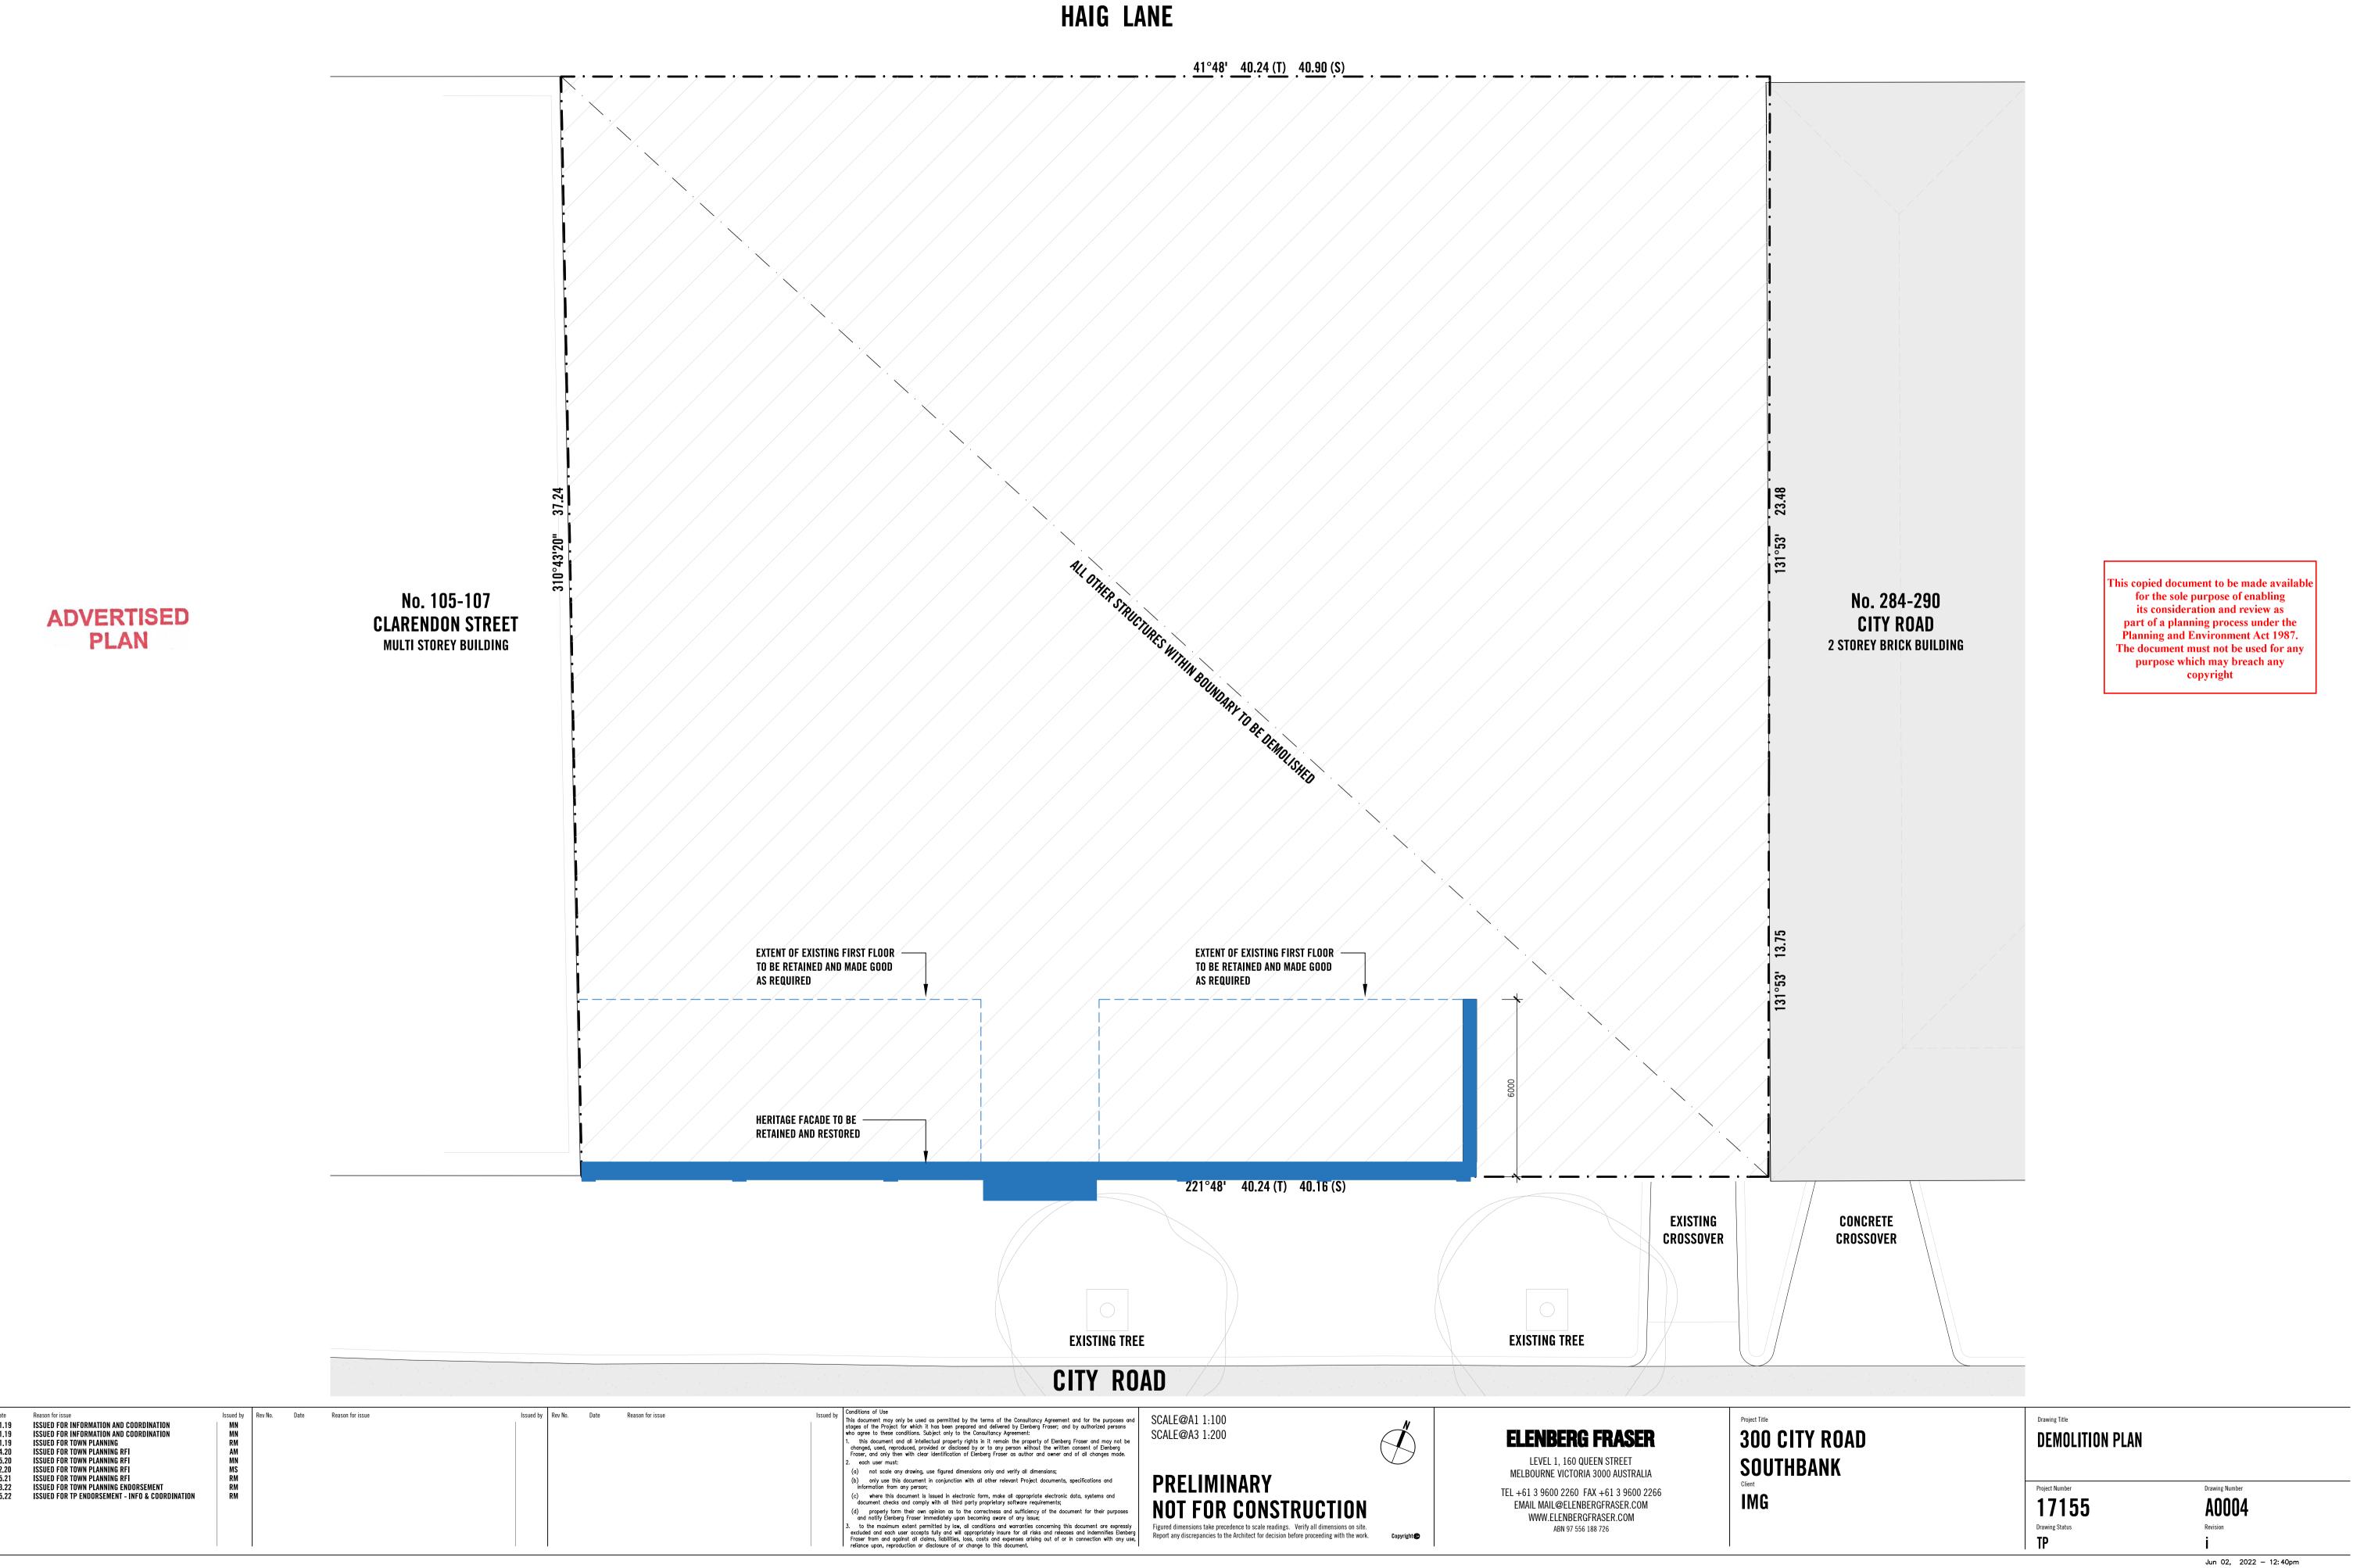


								1			
Rev No.	Date	Reason for issue	Issued by	Rev No.	Date	Reason for issue	Issued by	Rev No.	Date	Reason for issue	Issued by
Α	08.11.19	ISSUED FOR INFORMATION AND COORDINATION	MN								
В	08.11.19	ISSUED FOR INFORMATION AND COORDINATION	MN								
C	27.11.19	ISSUED FOR TOWN PLANNING	RM								1
D	03.04.20	ISSUED FOR TOWN PLANNING RFI	AM								
Е	29.05.20	ISSUED FOR TOWN PLANNING RFI	MN								
F	11.12.20	ISSUED FOR TOWN PLANNING RFI	MS								
G	06.05.21	ISSUED FOR TOWN PLANNING RFI	RM								
H	30.03.22	ISSUED FOR TOWN PLANNING ENDORSEMENT	RM								
I	05.05.22	ISSUED FOR TP ENDORSEMENT - INFO & COORDINATION	RM								

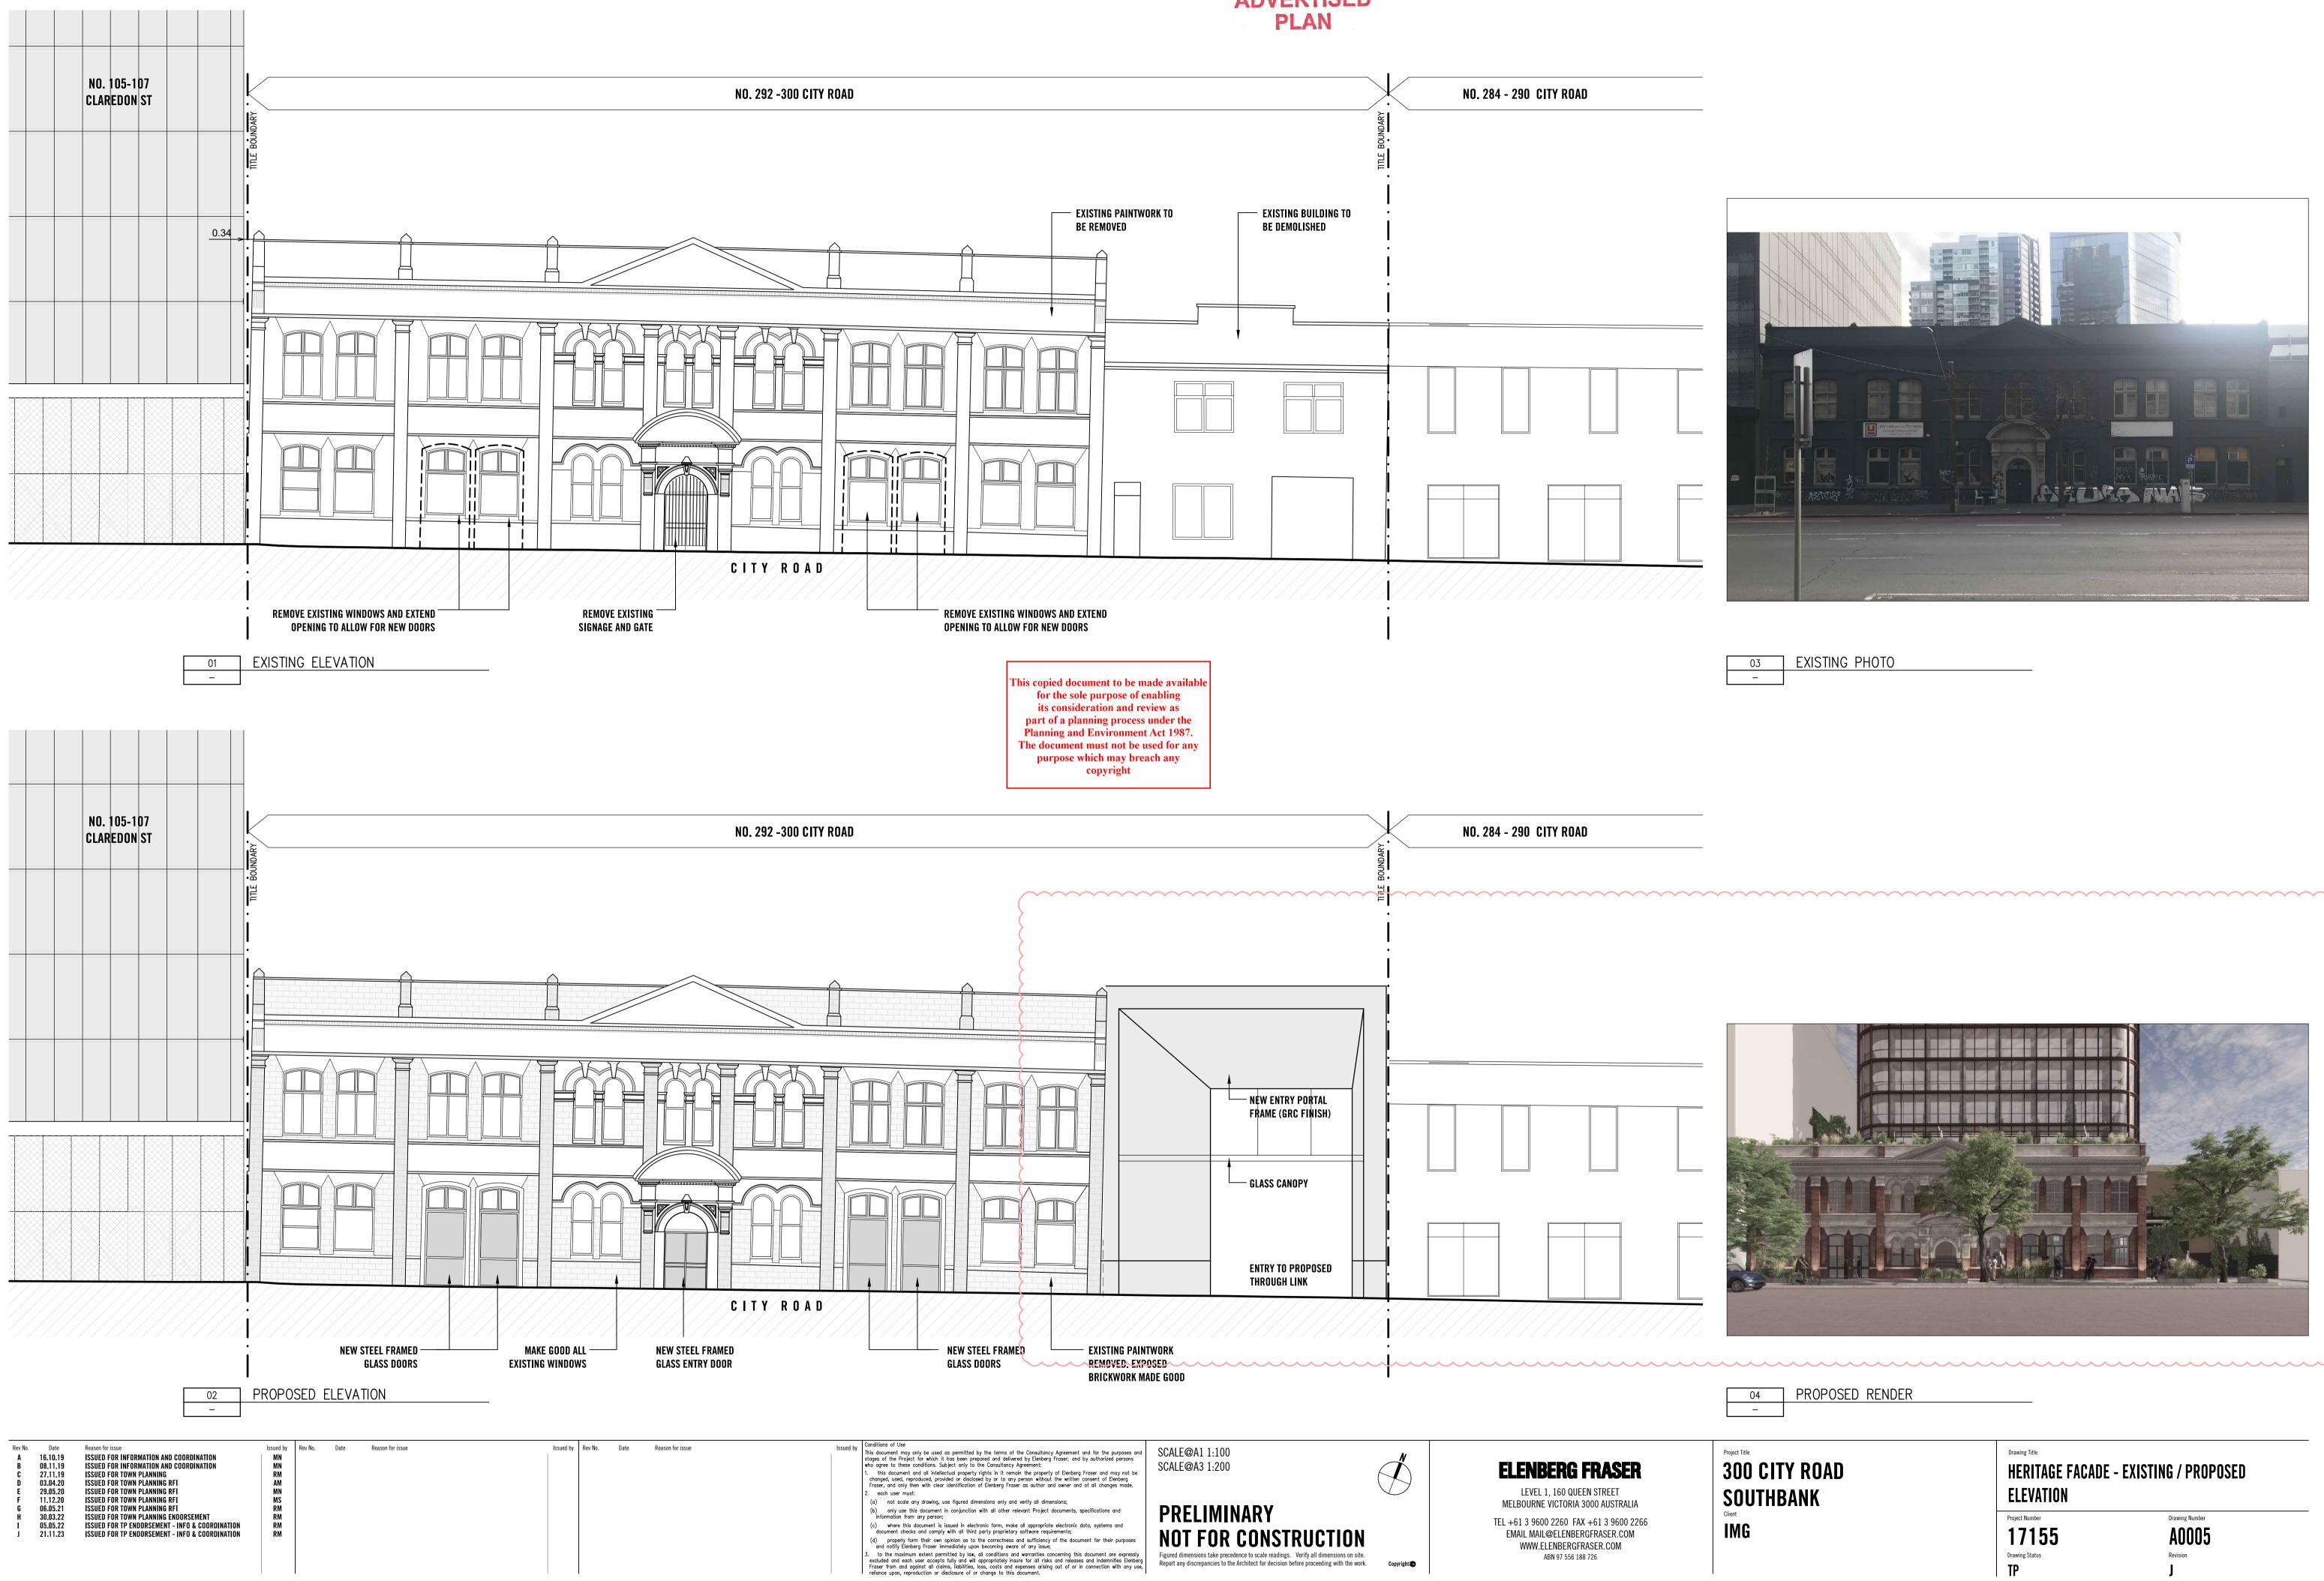



TP

Nov 27, 2023 – 6:00pm

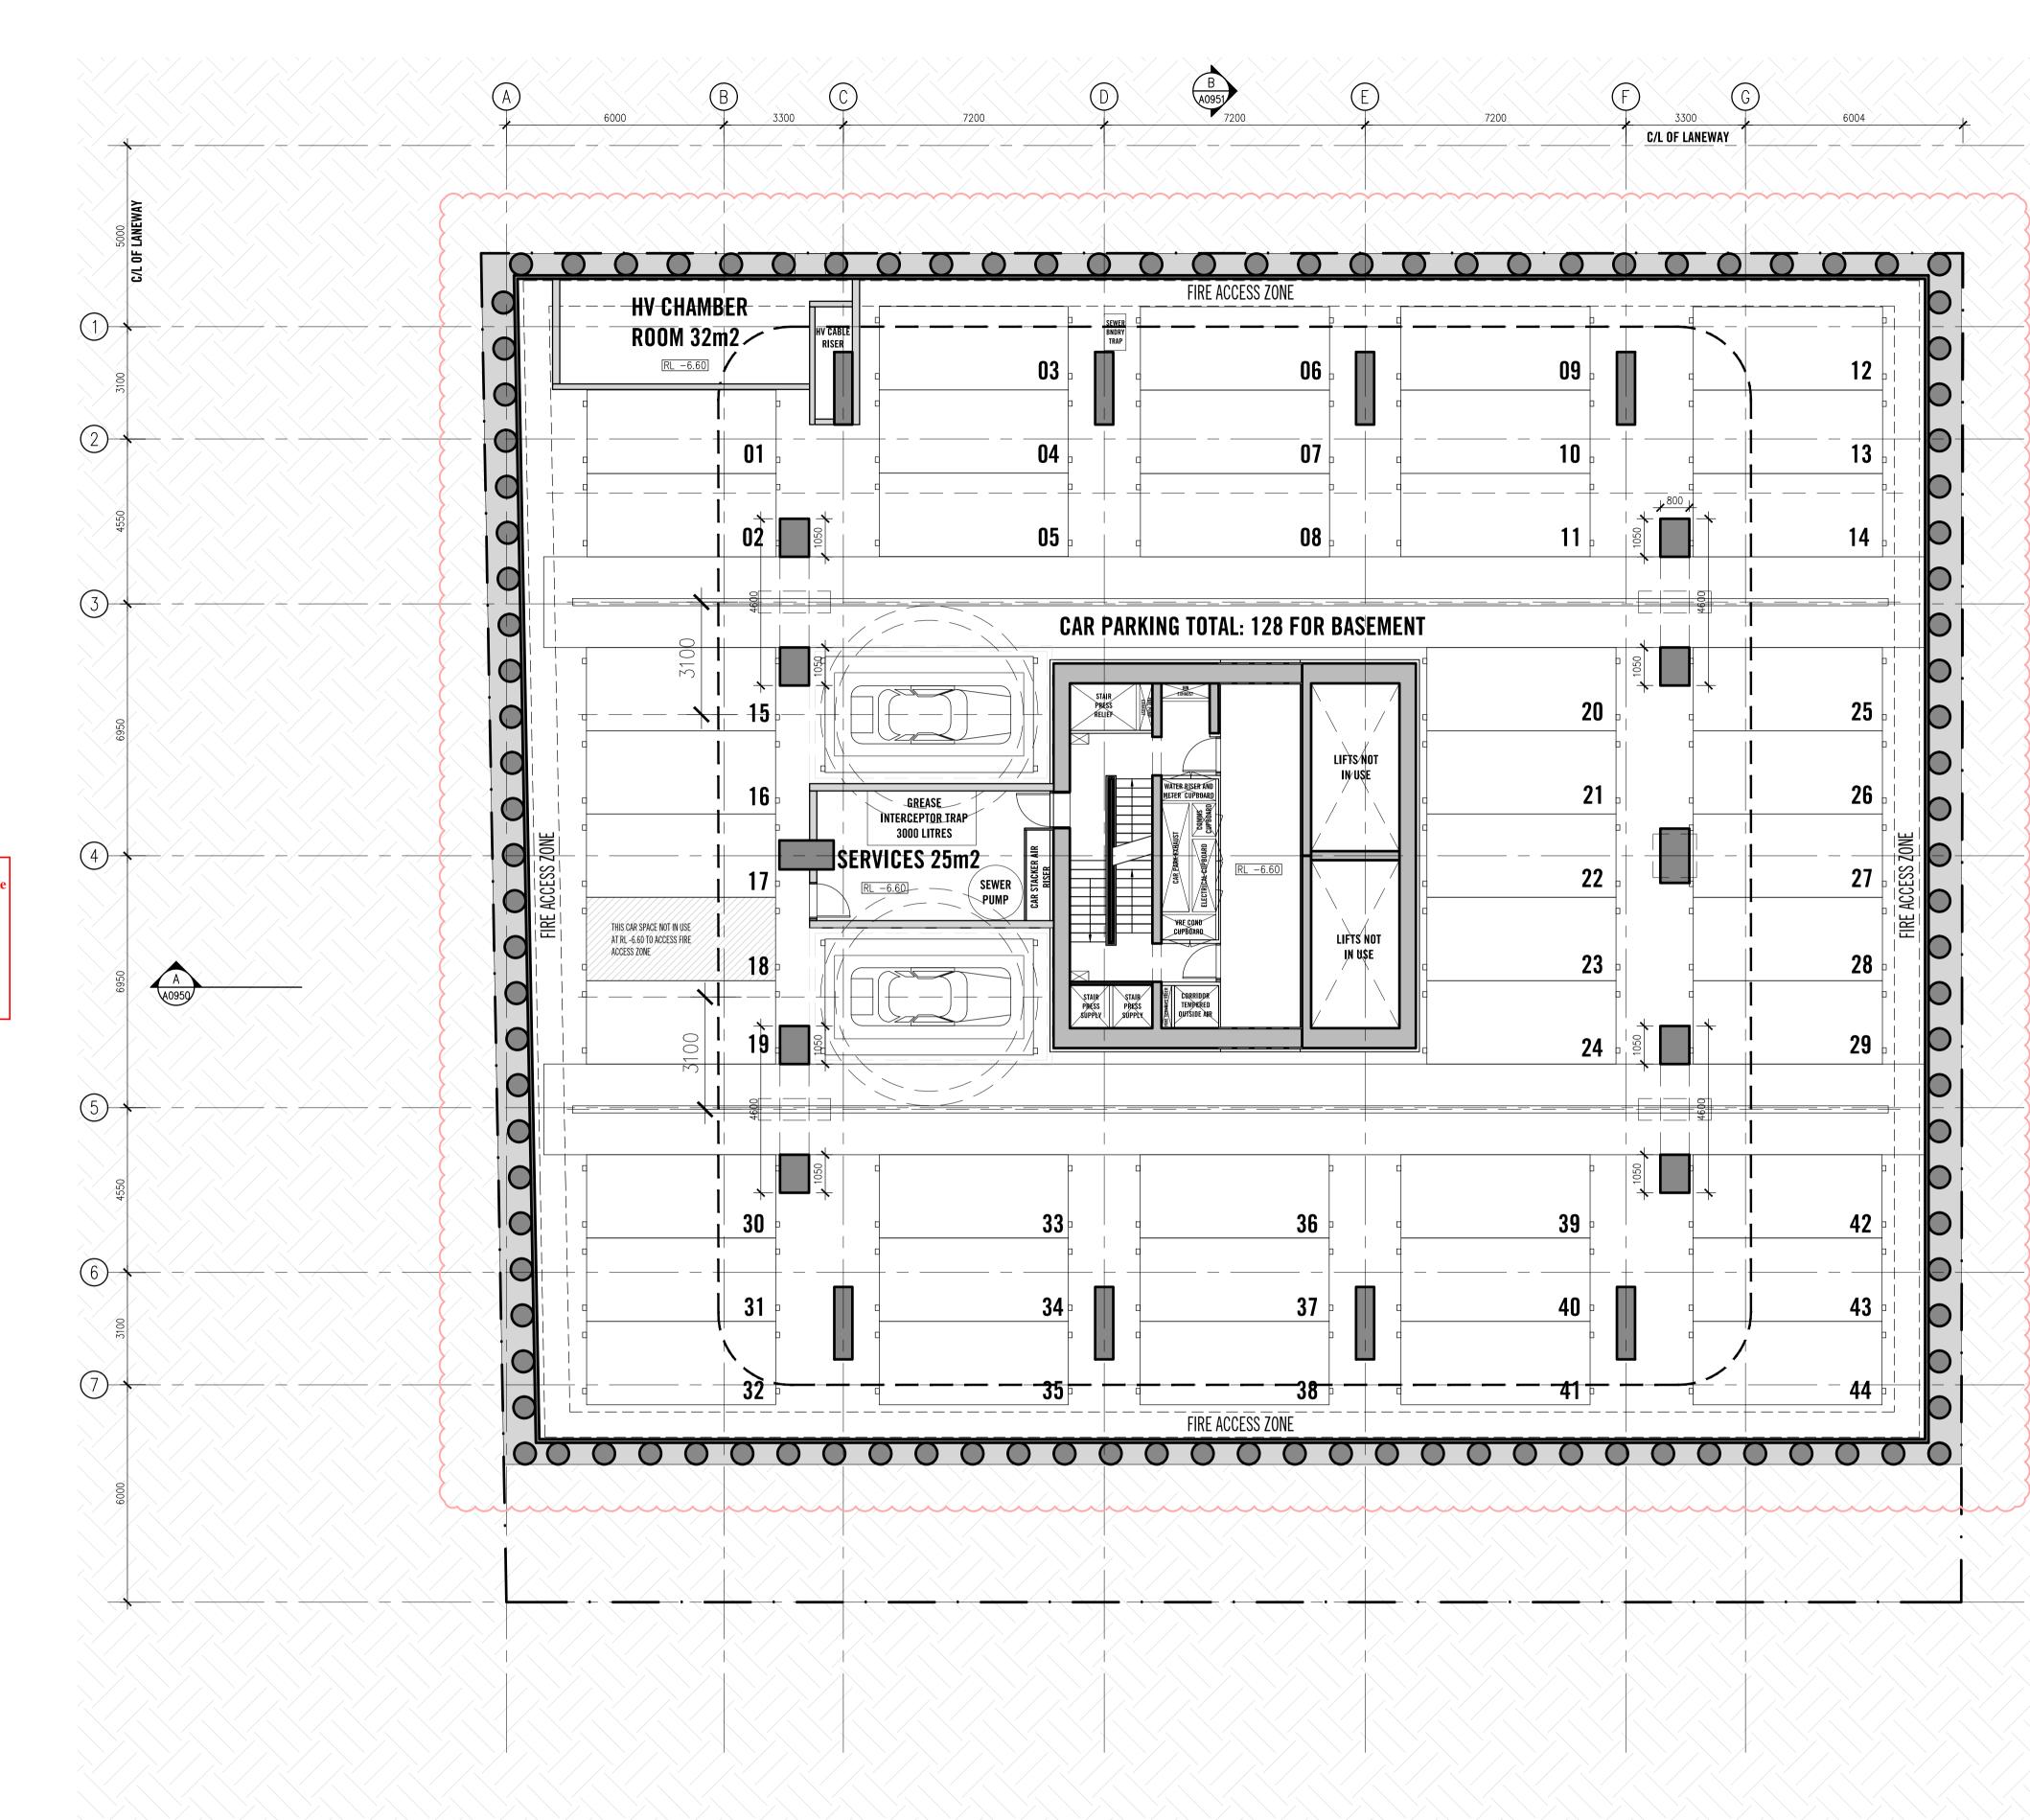

Rev No.	Date	Reason for issue	Issued by	Rev No.	Date	Reason for issue	Issued by	Rev No.	Date	Reason for issue	l	lssued by	Condition
Α	16.10.19	ISSUED FOR INFORMATION AND COORDINATION	MN										This doo stages o
В	08.11.19	ISSUED FOR INFORMATION AND COORDINATION	MN										who agr
C	27.11.19	ISSUED FOR TOWN PLANNING	RM										1. th
D	03.04.20	ISSUED FOR TOWN PLANNING RFI	AM										chang Fraser
Ε	29.05.20	ISSUED FOR TOWN PLANNING RFI	MN										2. eo
F	08.12.20	ISSUED FOR TOWN PLANNING RFI	RM										(a)
G	06.05.21	ISSUED FOR TOWN PLANNING RFI	RM										(b) inf
H	05.05.22	ISSUED FOR TP ENDORSEMENT - INFO & COORDINATION	RM										
1	21.11.23	ISSUED FOR TP AMENDMENT	DH										(c) do
													(d)
													an
													3. to exclud
													Fraser
				I								I	 relian

ued by	Conditions of Use This document may only be used as permitted by the terms of the Consultancy Agreement and for the purposes and stages of the Project for which it has been prepared and delivered by Elenberg Fraser; and by authorized persons who agree to these conditions. Subject only to the Consultancy Agreement: 1. this document and all intellectual property rights in it remain the property of Elenberg Fraser and may not be changed, used, reproduced, provided or disclosed by or to any person without the written consent of Elenberg Fraser, and only then with clear identification of Elenberg Fraser as author and owner and of all changes made. 2. each user must:	SCALE@A1 1:100 SCALE@A3 1:200		
	 (a) not scale any drawing, use figured dimensions only and verify all dimensions; (b) only use this document in conjunction with all other relevant Project documents, specifications and information from any person; 	PRELIMINARY		
	(c) where this document is issued in electronic form, make all appropriate electronic data, systems and document checks and comply with all third party proprietary software requirements;			
	 (d) properly form their own opinion as to the correctness and sufficiency of the document for their purposes and notify Elenberg Fraser immediately upon becoming aware of any issue; 	NOT FOR CONSTRUCTION		
	3. to the maximum extent permitted by law, all conditions and warranties concerning this document are expressly excluded and each user accepts fully and will appropriately insure for all risks and releases and indemnifies Elenberg Fraser from and against all claims, liabilities, loss, costs and expenses arising out of or in connection with any use, reliance upon, reproduction or disclosure of or change to this document.	Figured dimensions take precedence to scale readings. Verify all dimensions on site. Report any discrepancies to the Architect for decision before proceeding with the work.	Copyright 🤀	

ELENBERG FRASER


LEVEL 1, 160 QUEEN STREET MELBOURNE VICTORIA 3000 AUSTRALIA TEL +61 3 9600 2260 FAX +61 3 9600 2266 EMAIL MAIL@ELENBERGFRASER.COM WWW.ELENBERGFRASER.COM ABN 97 556 188 726

Project Title IMG




300 CITY ROAD SOUTHBANK


Drawing Title BASEMENT

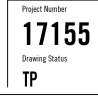


Drawing Number A0099 Revision Nov 27, 2023 – 6:11pm

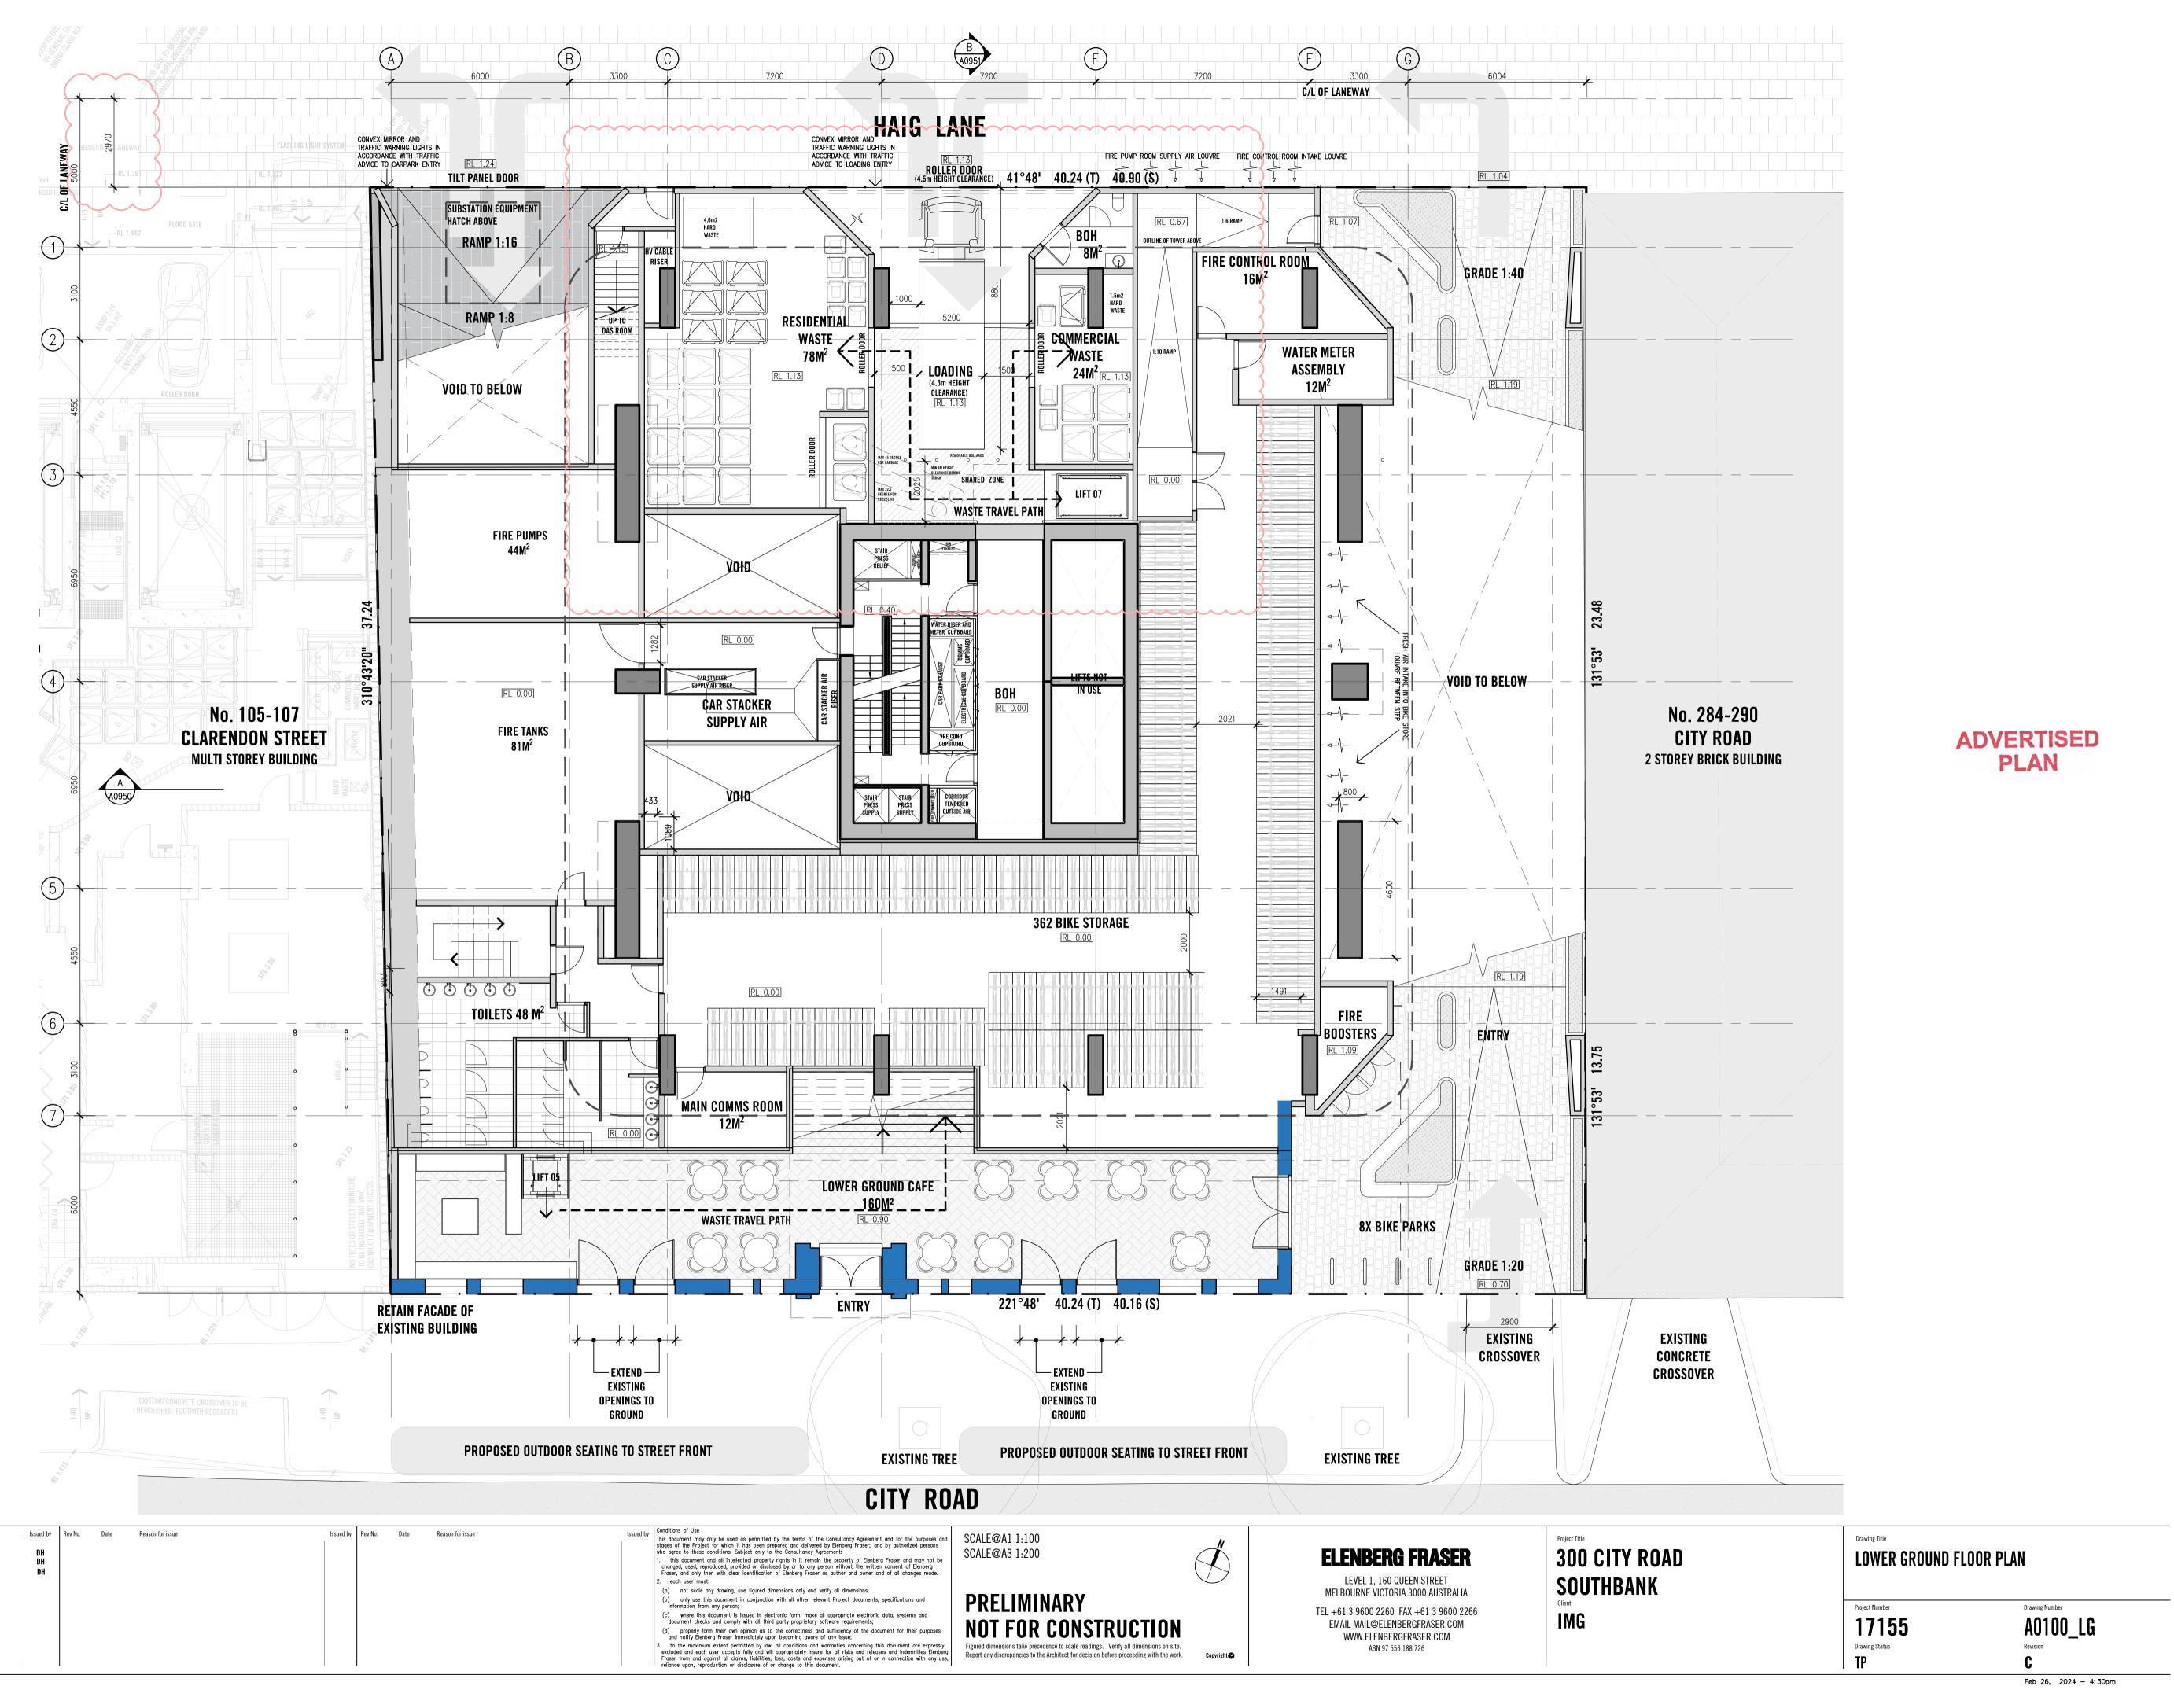


for the sole purpose of enabling its consideration and review as part of a planning process under the Planning and Environment Act 1987. The document must not be used for any purpose which may breach any

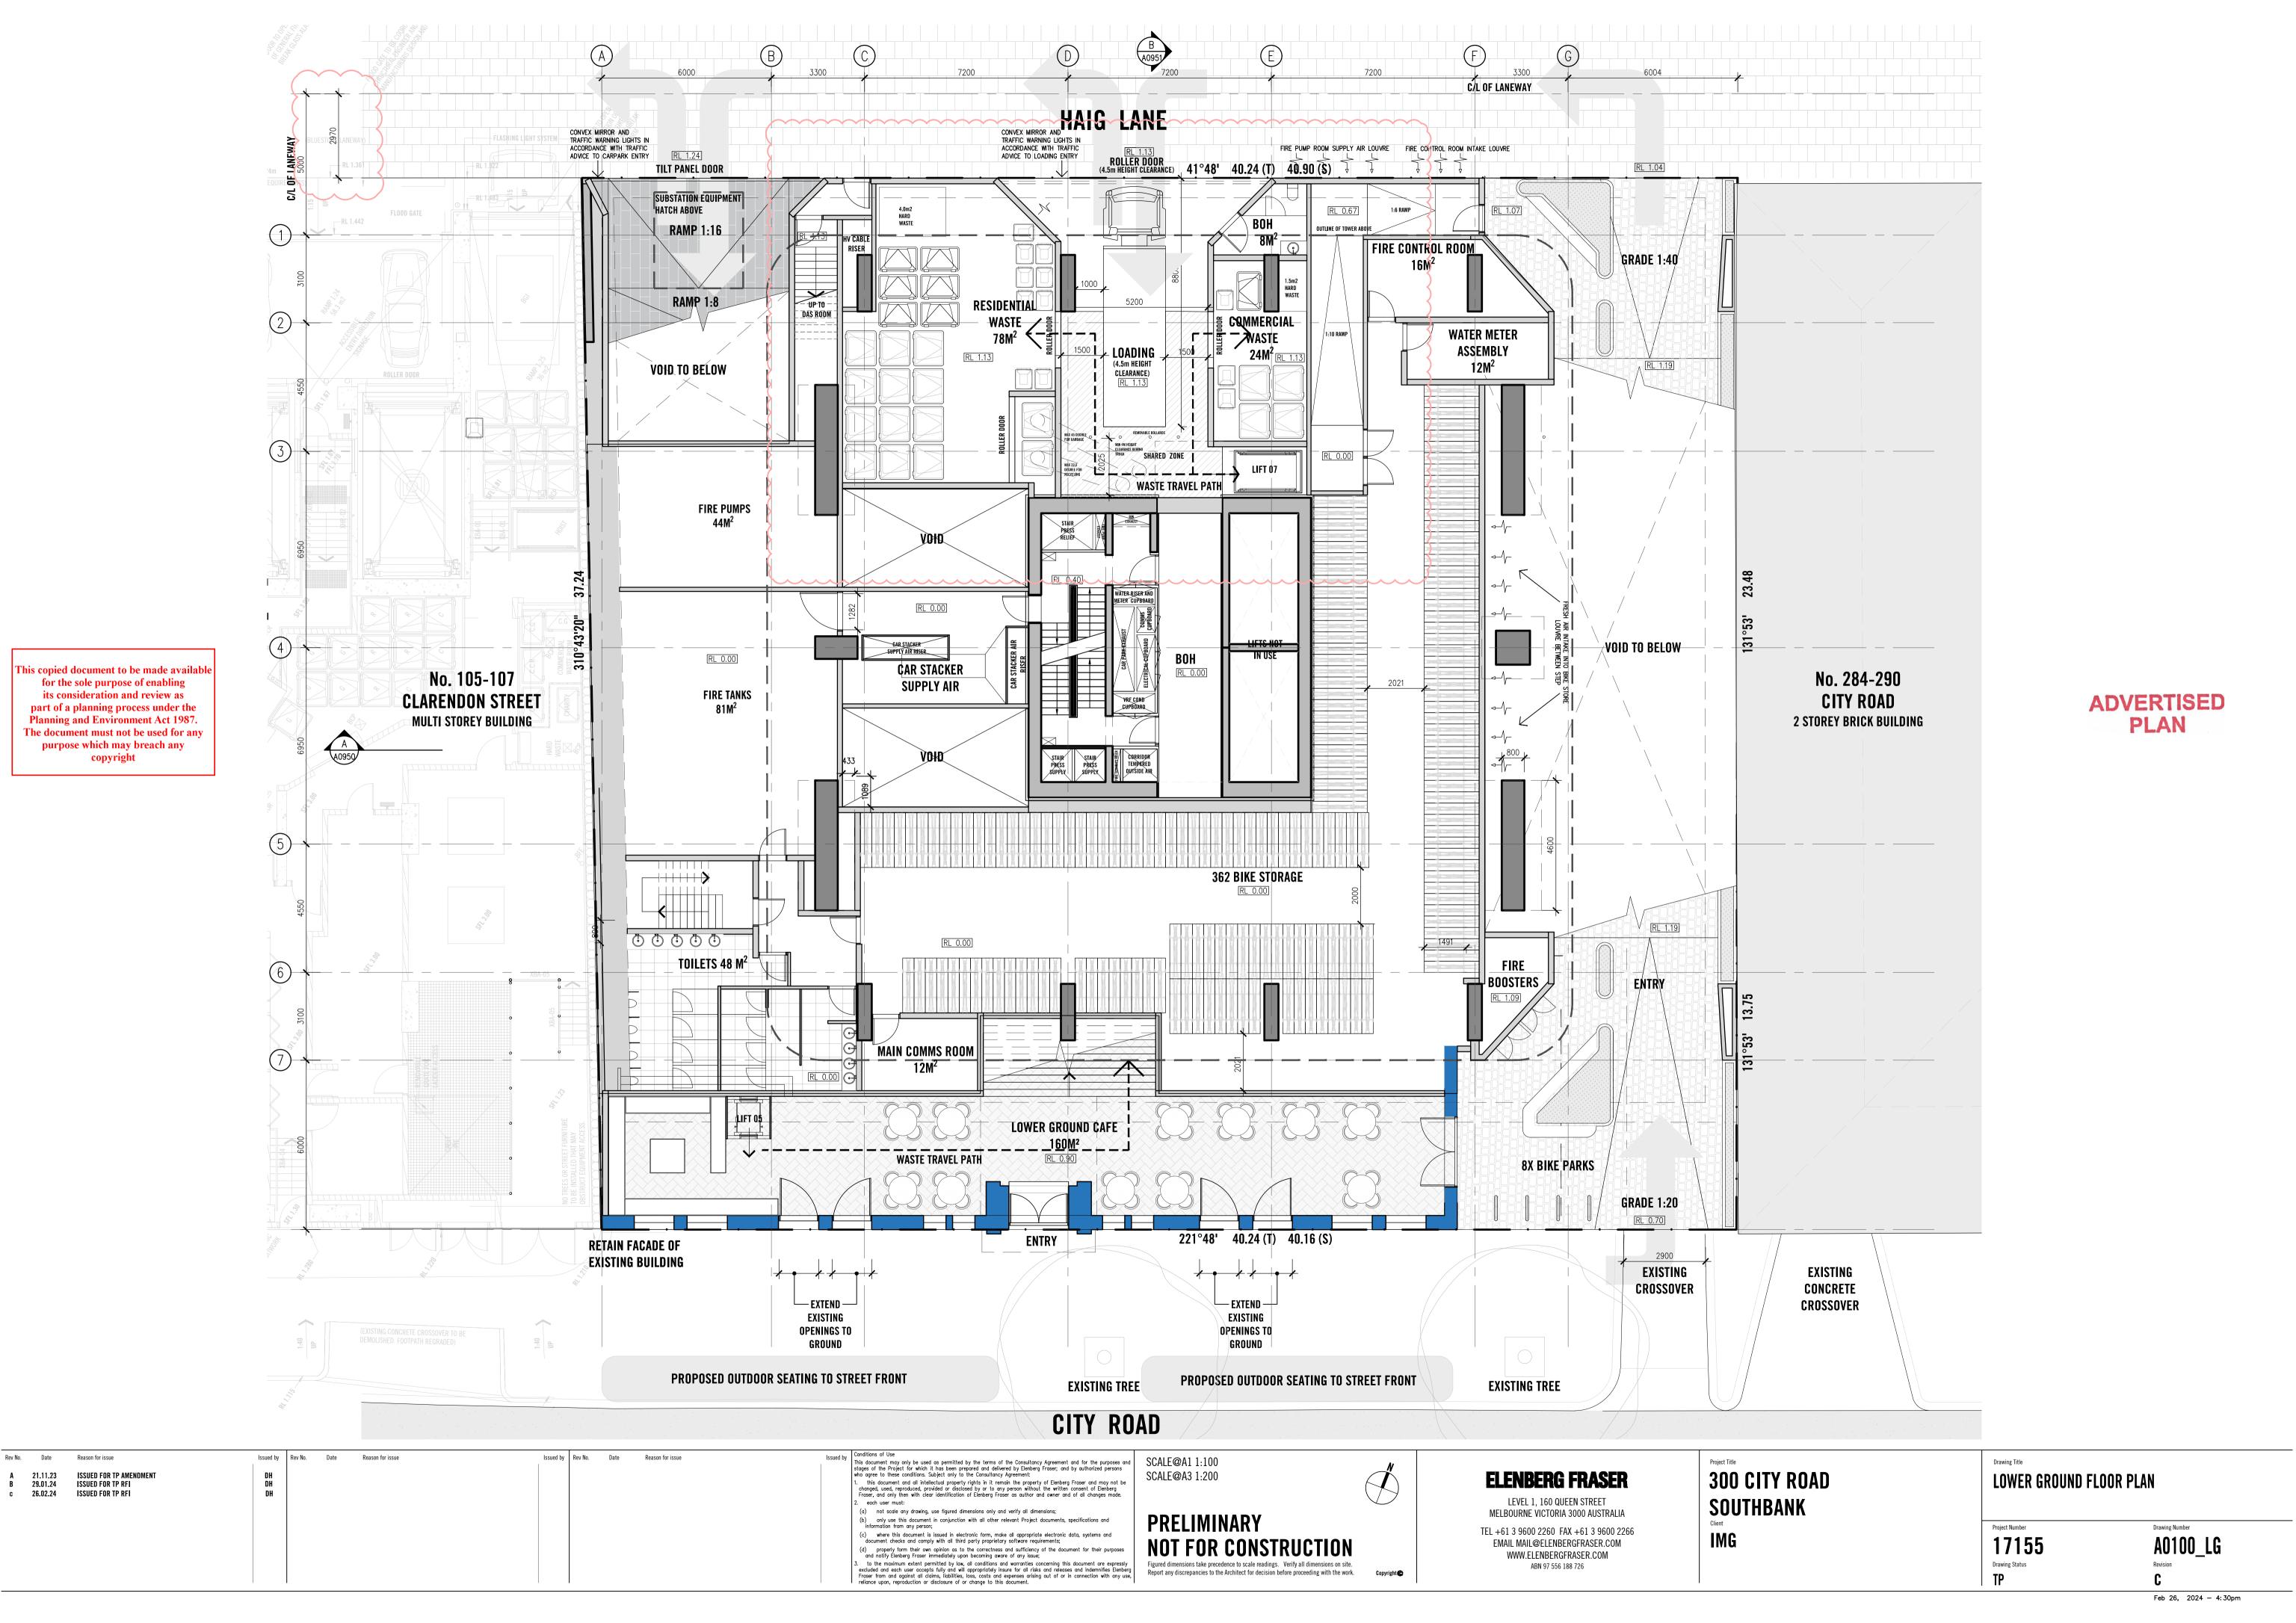


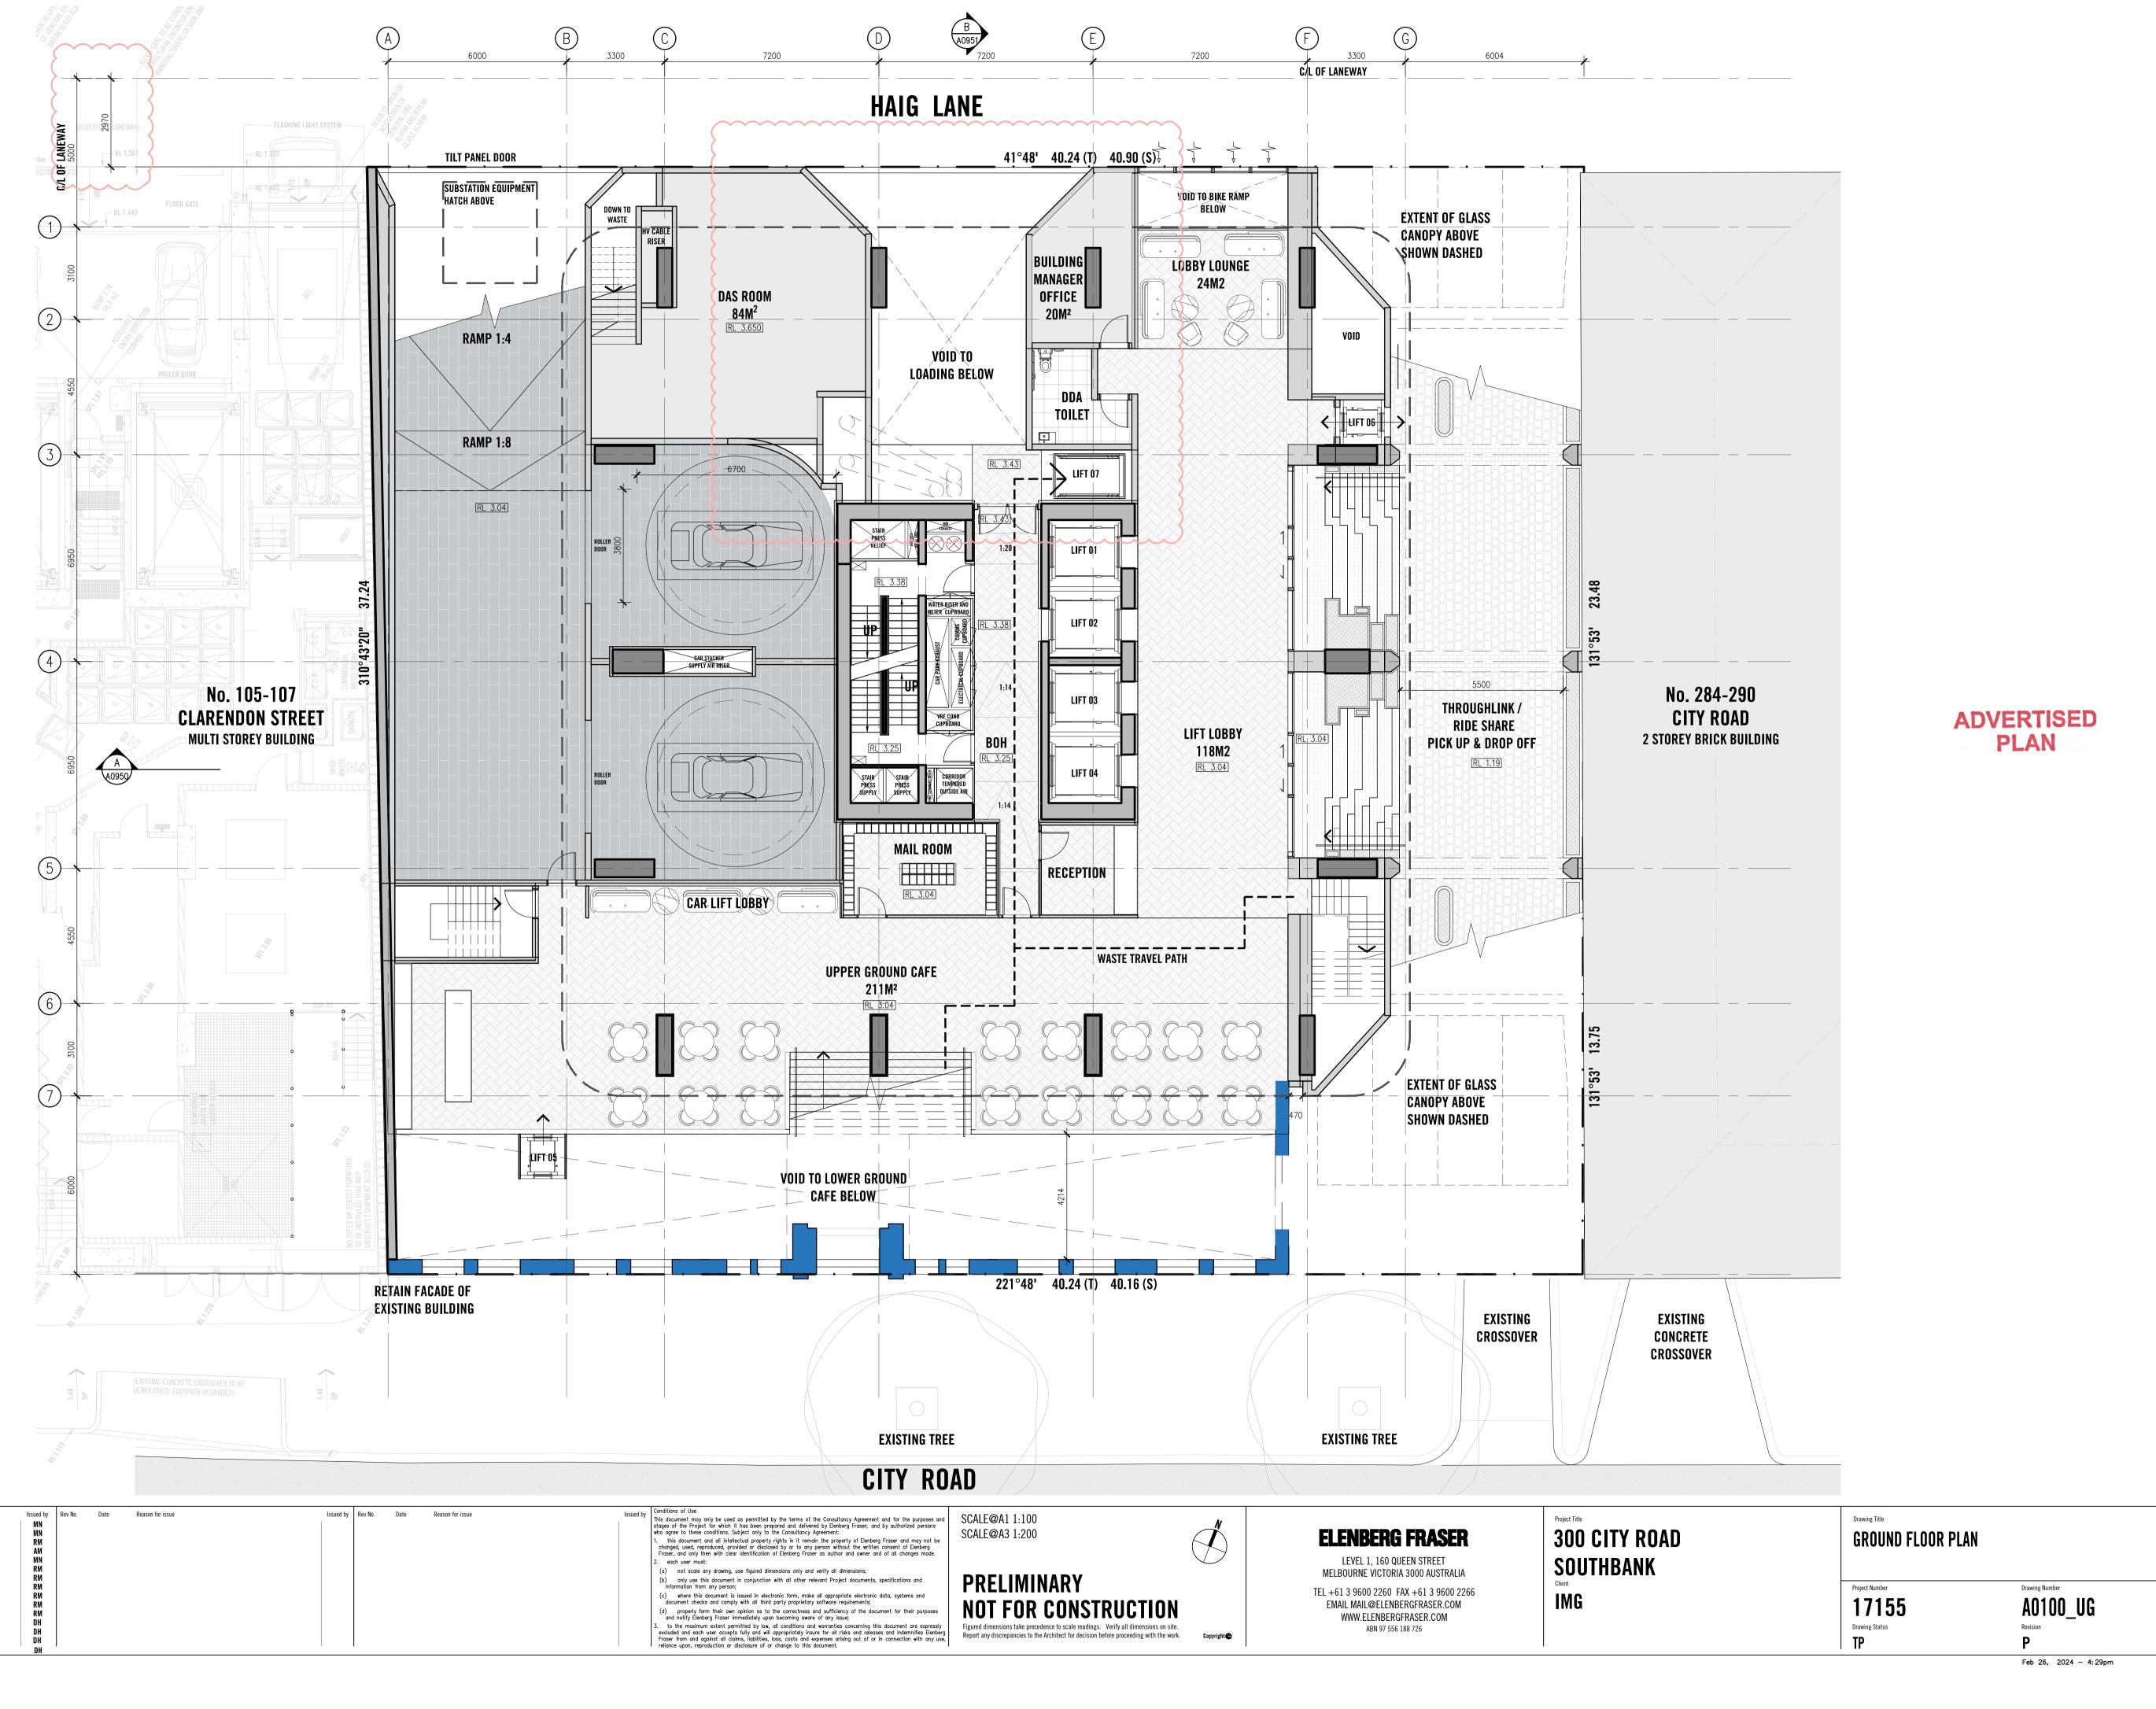

				1								Conditio
Rev No.	Date	Reason for issue	Issued by	Rev No.	Date	Reason for issue	Issued by	Rev No.	Date	Reason for issue	Issued b	This do
Α	16.10.19	ISSUED FOR INFORMATION AND COORDINATION	MN									stages
В	08.11.19	ISSUED FOR INFORMATION AND COORDINATION	MN									who ag
C	27.11.19	ISSUED FOR TOWN PLANNING	RM									1. th
D	03.04.20	ISSUED FOR TOWN PLANNING RFI	AM									chang Frase
E	29.05.20	ISSUED FOR TOWN PLANNING RFI	MN									2. ec
F	08.12.20	ISSUED FOR TOWN PLANNING RFI	RM									(a)
G	06.05.21	ISSUED FOR TOWN PLANNING RFI	RM									
H	30.06.21	ISSUED FOR TOWN PLANNING RFI	RM									(b) inf
I	05.05.22	ISSUED FOR TP ENDORSEMENT - INFO & COORDINATION	RM									(c) do
J	05.08.22	ISSUED FOR TP ENDORSEMENT RFI	RM									
K	02.12.22	ISSUED FOR TP AMENDMENT	RM									(d)
L	20.07.23	ISSUED FOR TP AMENDMENT	DH									an 3. to
М	21.11.23	ISSUED FOR TP AMENDMENT	DH									exclud
N	29.01.24	ISSUED FOR TP RFI	DH									Frase
Р	26.02.24	ISSUED FOR TP RFI	DH	1			I	1			I	l relian
<u> </u>												

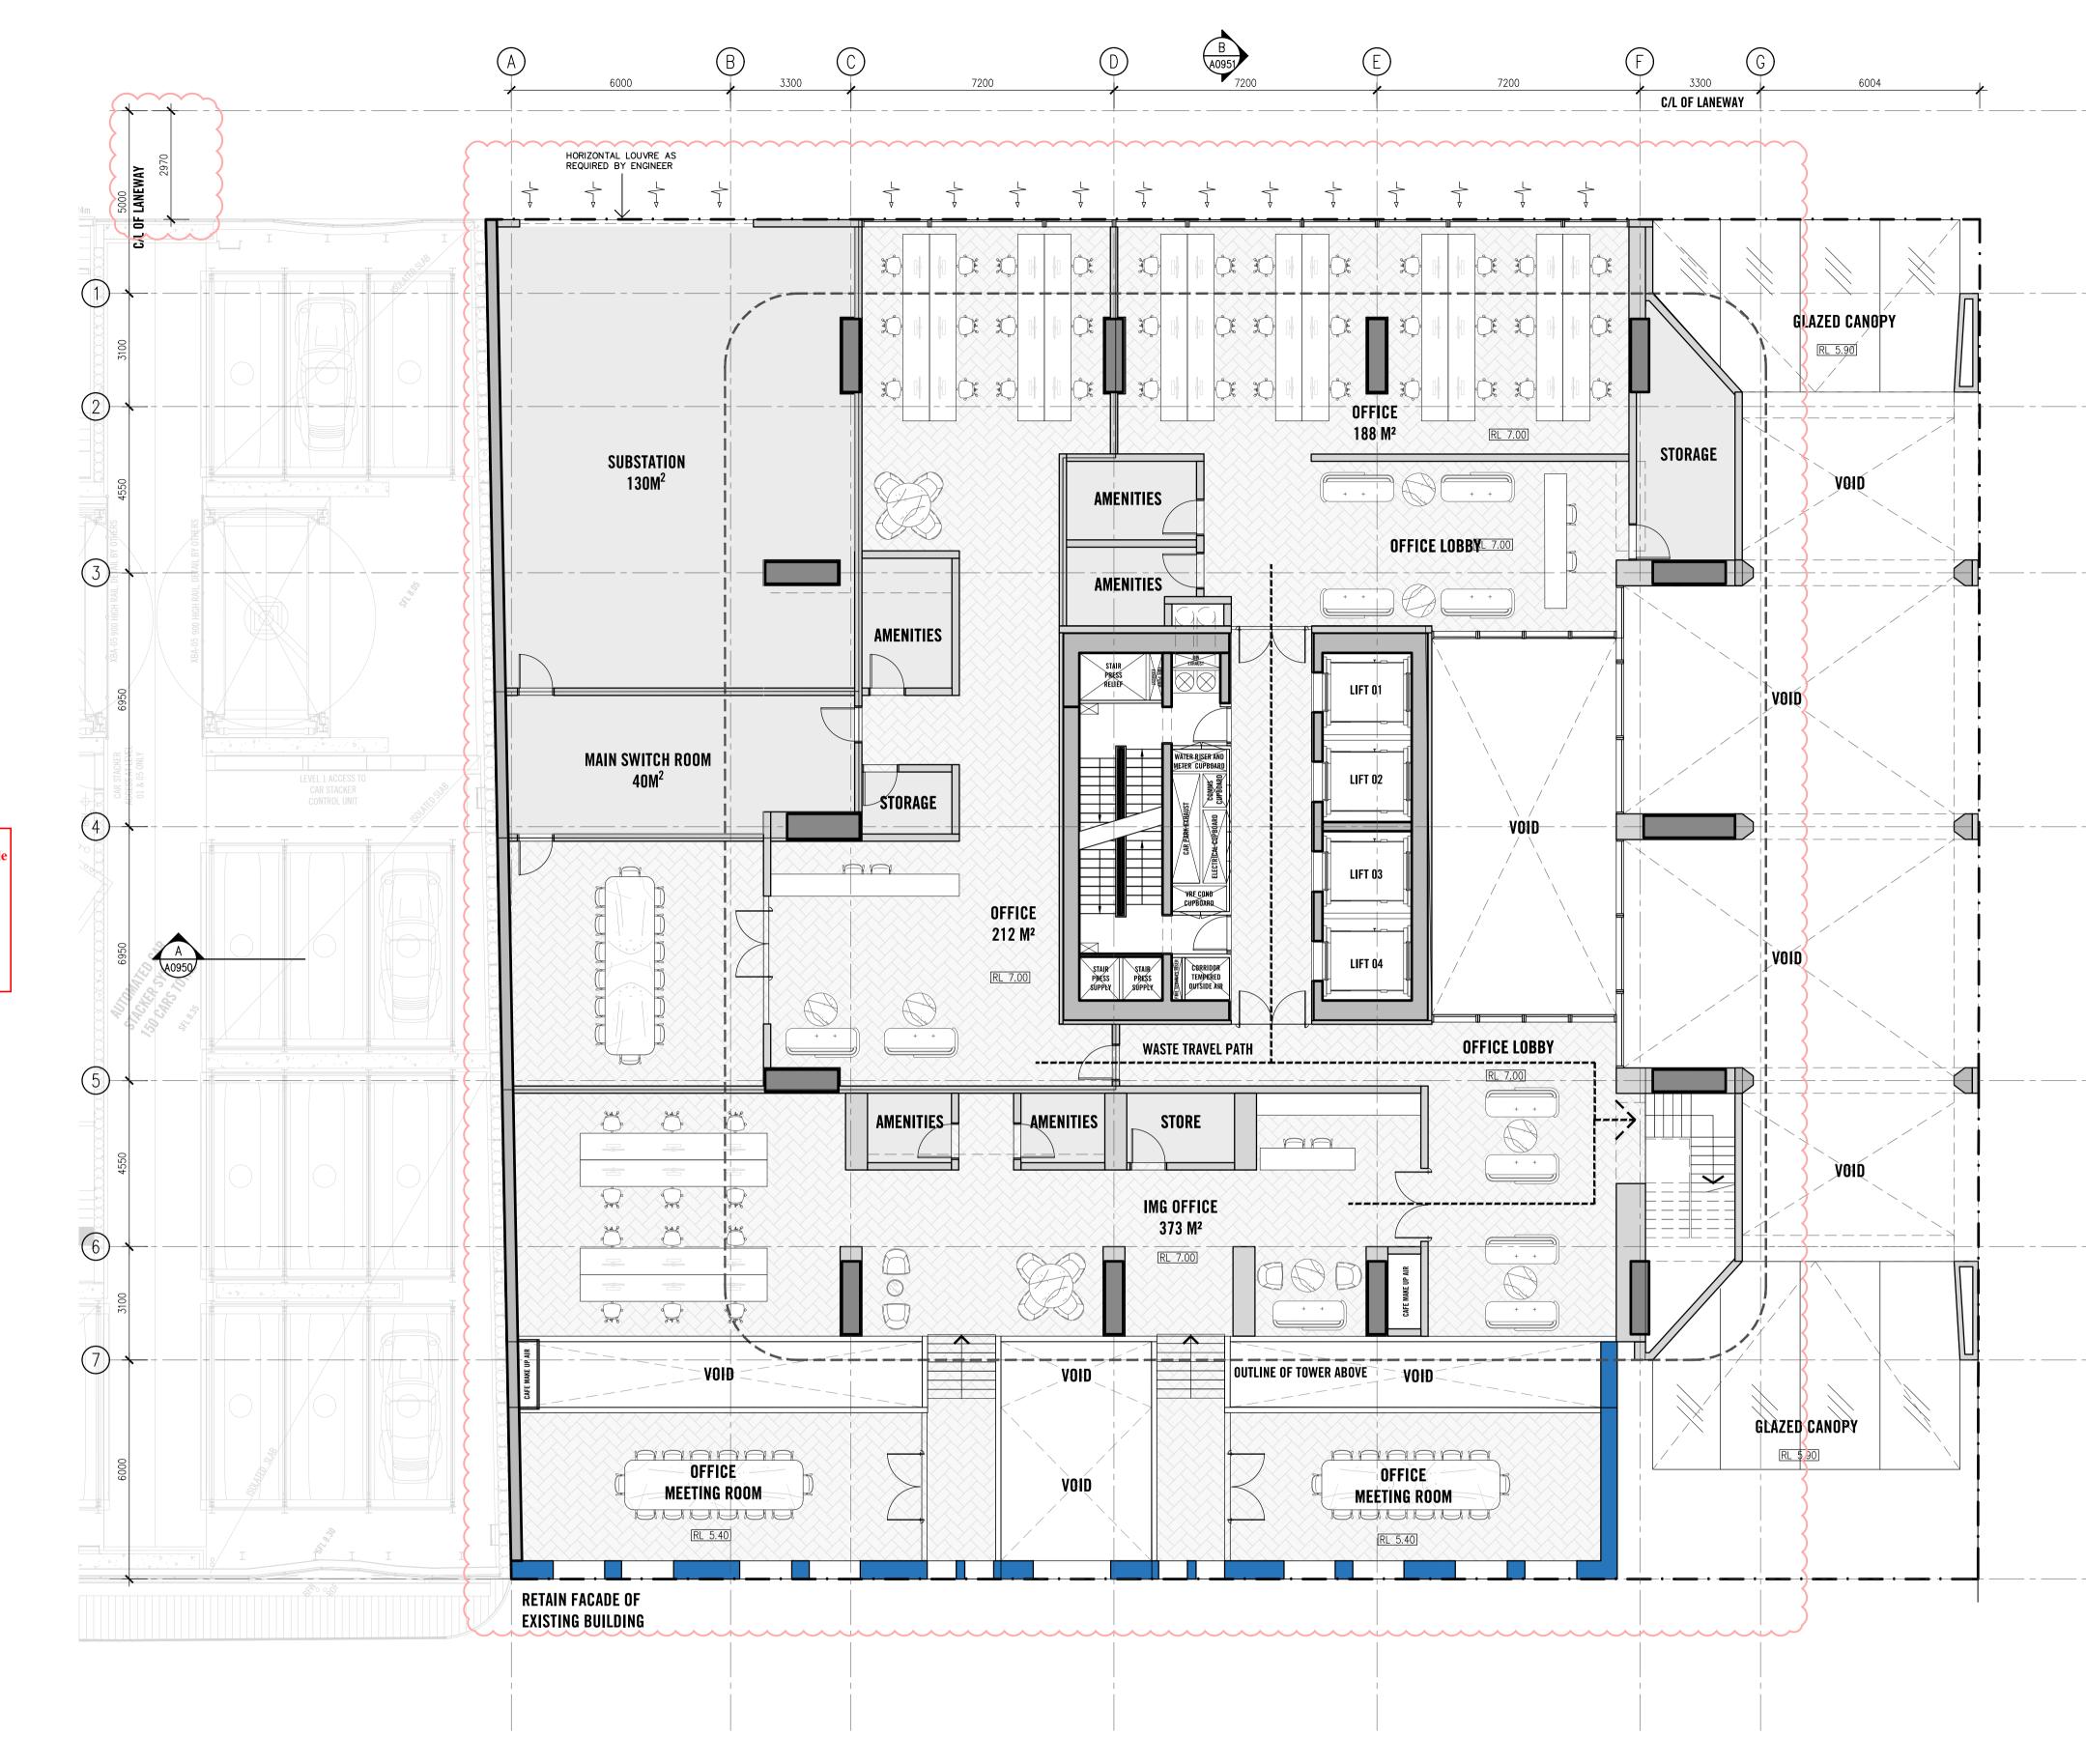

Rev No.	Date	Reason for issue	Issued by	Rev No.	Date	Reason for issue	Issued by	Rev No.	Date	Reason for issue	Issued by	Condition
Α	16,10,19	ISSUED FOR INFORMATION AND COORDINATION	MN				1					This docu stages o
В	08.11.19	ISSUED FOR INFORMATION AND COORDINATION	MN									who agre
C	27.11.19	ISSUED FOR TOWN PLANNING	RM									1. this
D	03.04.20	ISSUED FOR TOWN PLANNING RFI	AM									change Fraser,
E	29.05.20	ISSUED FOR TOWN PLANNING RFI	MN									2. eac
F	11.12.20	ISSUED FOR TOWN PLANNING RFI	MS									(a)
G	06.05.21	ISSUED FOR TOWN PLANNING RFI	RM									(b)
H	05.05.22	ISSUED FOR TP ENDORSEMENT - INFO & COORDINATION	RM									infor
I	05.08.22	ISSUED FOR TP ENDORSEMENT RFI	RM									(c)
J	02.09.22	ISSUED FOR TP AMENDMENT	DH									docu
K	21.11.23	ISSUED FOR TP AMENDMENT	DH									(d) and
L	29.01.24	ISSUED FOR TP RFI	DH									3 to
												exclude
												Fraser reliance

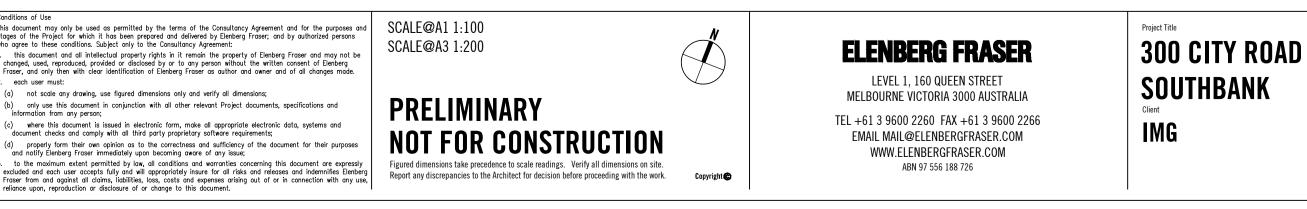




Drawing Title
LEVEL 01
OFFICE AND SERVICES
Project Number



Drawing Number A0101 Revision L Jan 29, 2024 – 4:40pm

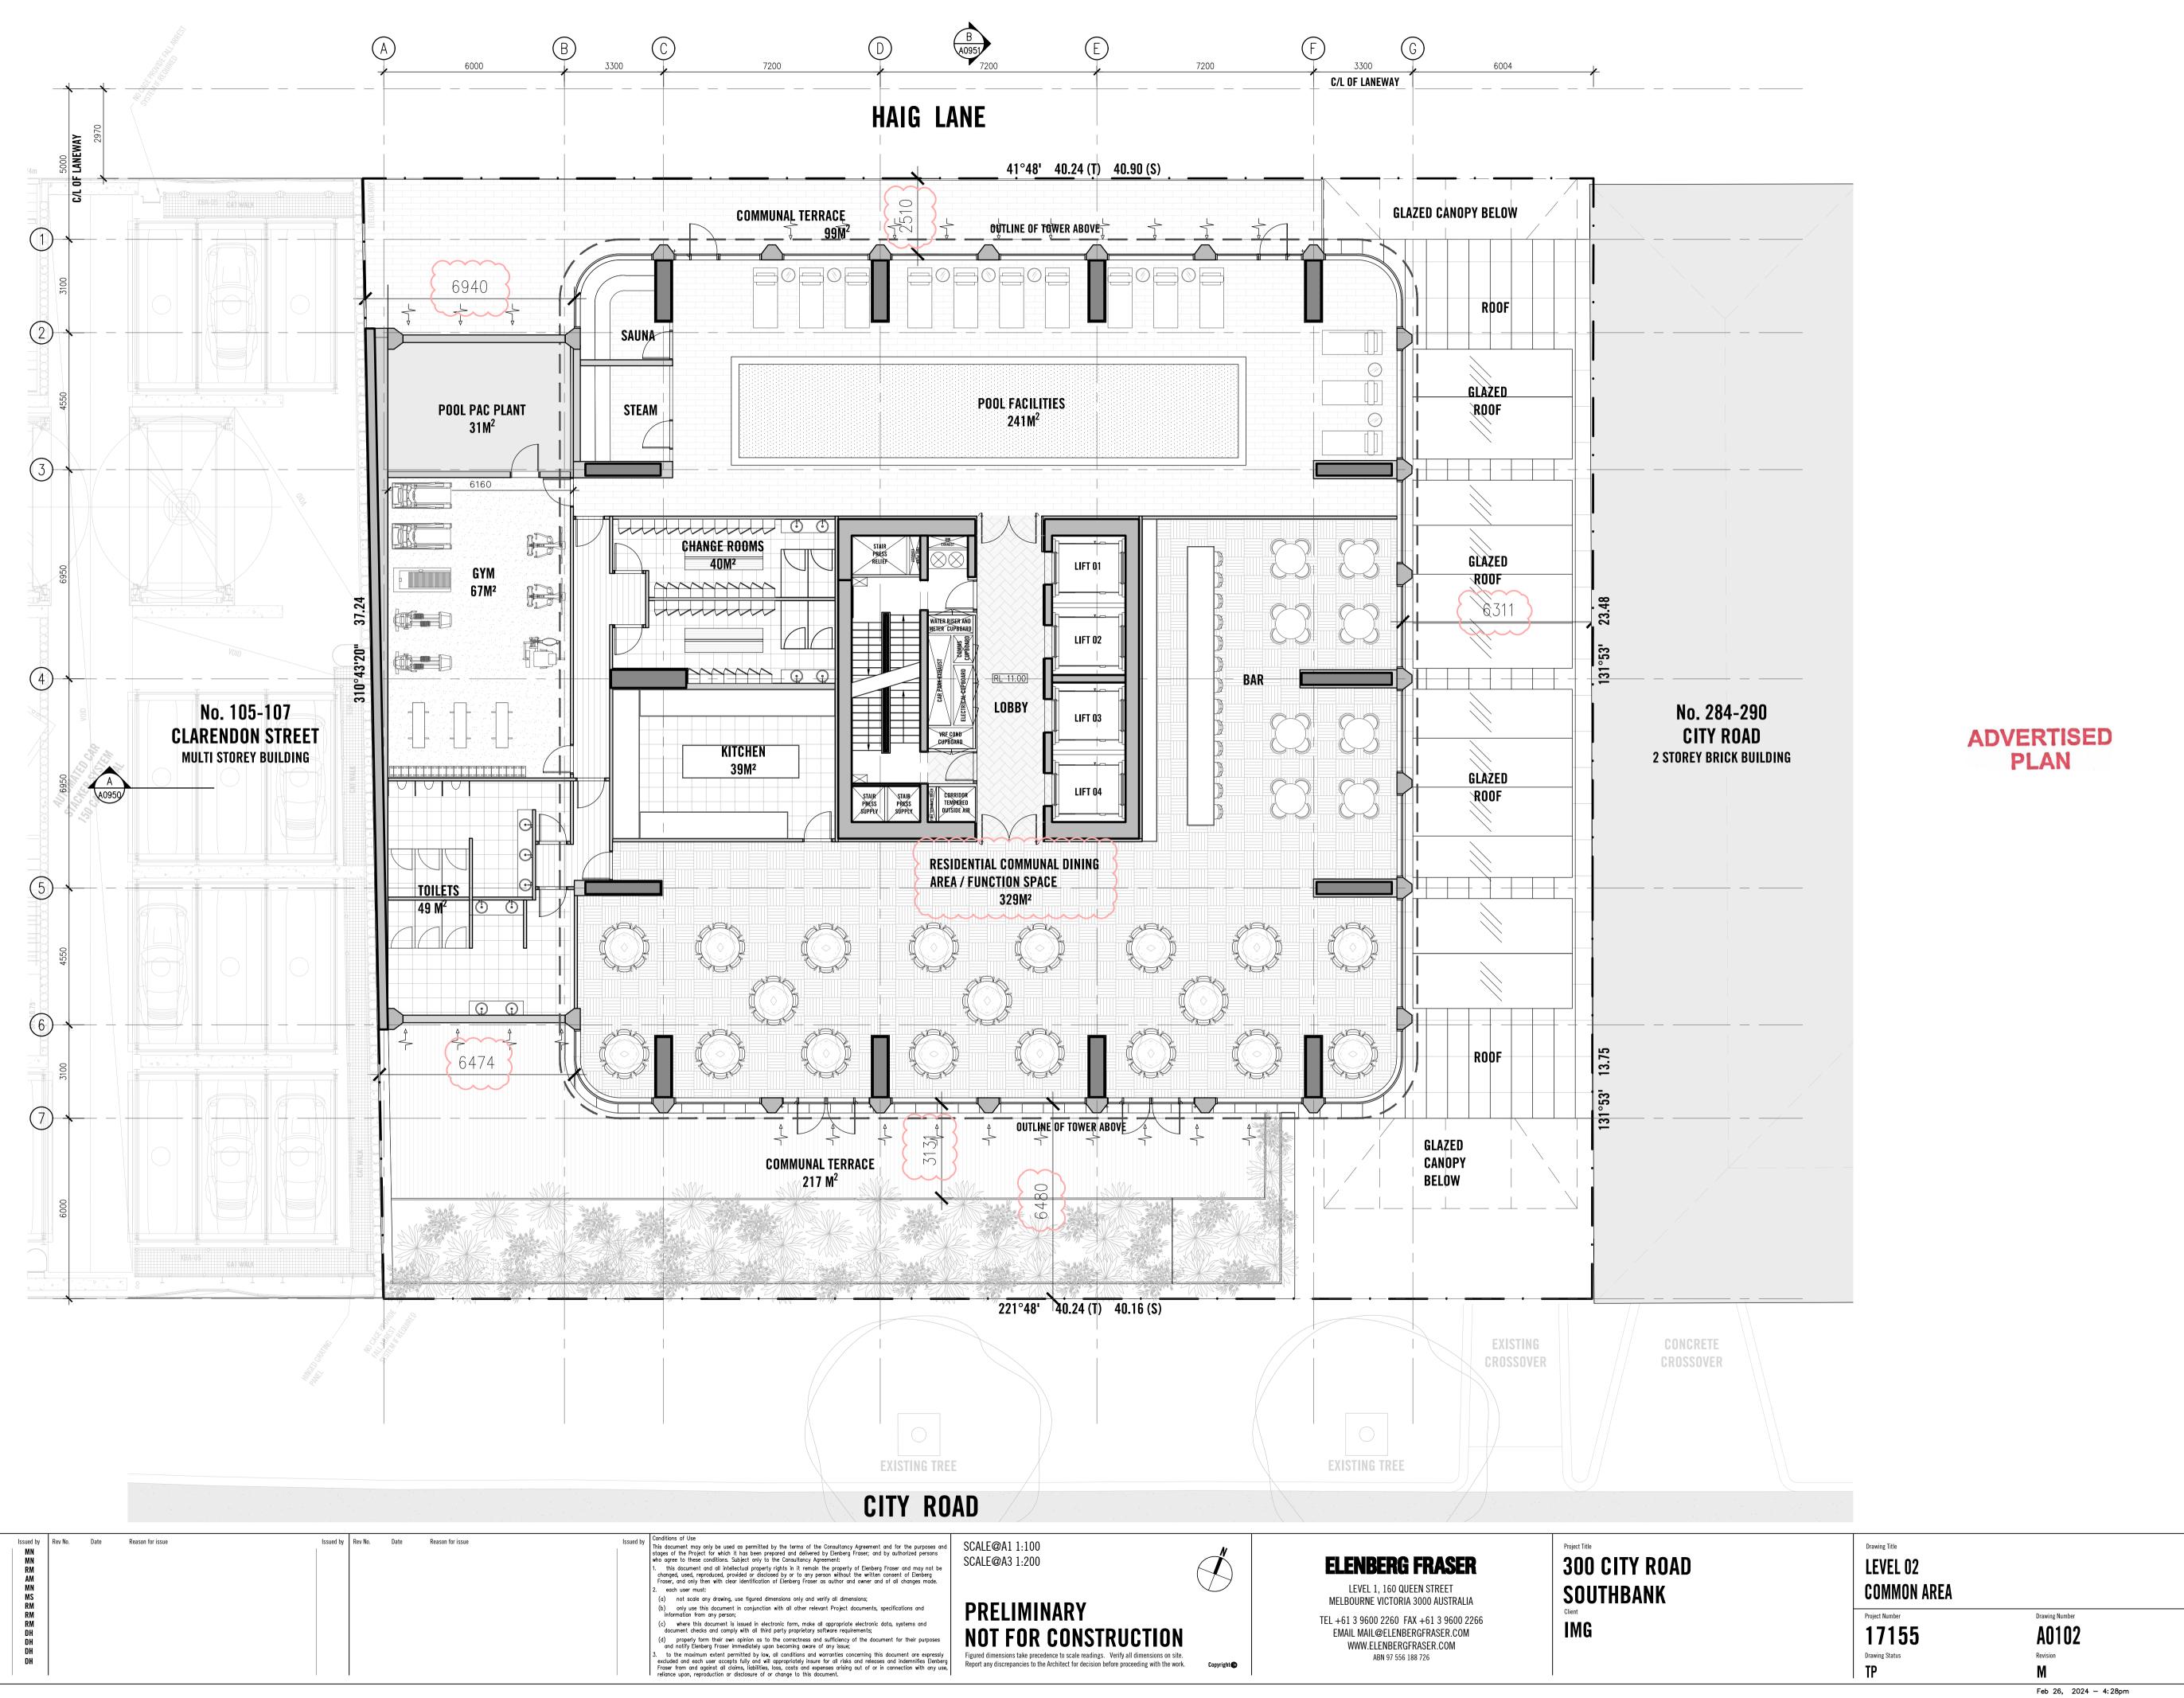

Rev No.	Date	Reason for issue	Issued by	Rev No.	Date	Reason for issue	Issued I	y Rev No.	Date	Reason for issue	ls	ssued by	Con
Α	16.10.19	ISSUED FOR INFORMATION AND COORDINATION	MN										This sta
В	08.11.19	ISSUED FOR INFORMATION AND COORDINATION	MN										who
C	27.11.19	ISSUED FOR TOWN PLANNING	RM										1.
D	03.04.20	ISSUED FOR TOWN PLANNING RFI	AM										F
E	29.05.20	ISSUED FOR TOWN PLANNING RFI	MN										2.
F	11.12.20	ISSUED FOR TOWN PLANNING RFI	MS										(
G	06.05.21	ISSUED FOR TOWN PLANNING RFI	RM										(
H	05.05.22	ISSUED FOR TP ENDORSEMENT – INFO & COORDINATION	RM										
I	05.08.22	ISSUED FOR TP ENDORSEMENT RFI	RM										(
J	02.12.22	ISSUED FOR TP AMENDMENT	DH										,
K	21.11.23	ISSUED FOR TP AMENDMENT	DH										(
L	29.01.24	ISSUED FOR TP AMENDMENT	DH										3.
М	26.02.24	ISSUED FOR TP ENDORSEMENT RFI	DH										e
													Fi
				•				-					10



Rev No.	Date	Reason for issue	Issued by	Rev No.	Date	Reason for issue	Issued by	Rev No.	Date	Reason for issue	Issued	by Conc
Α	16.10.19	ISSUED FOR INFORMATION AND COORDINATION	MN									stag
В	08.11.19	ISSUED FOR INFORMATION AND COORDINATION	MN									who
C	27.11.19	ISSUED FOR TOWN PLANNING	RM									1.
D	03.04.20	ISSUED FOR TOWN PLANNING RFI	AM									Fre
Е	29.05.20	ISSUED FOR TOWN PLANNING RFI	MN									2.
F	11.12.20	ISSUED FOR TOWN PLANNING RFI	MS									(a
G	06.05.21	ISSUED FOR TOWN PLANNING RFI	RM									(b
H	05.05.22	ISSUED FOR TP ENDORSEMENT - INFO & COORDINATION	RM									
I	02.12.22	ISSUED FOR TP AMENDMENT	DH									(c
J	21.11.23	ISSUED FOR TP AMENDMENT	DH									
K	29.01.24	ISSUED FOR TP RFI	DH									(d
L	26.02.24	ISSUED FOR TP RFI	DH									3.
												ex
												Fr

CITY ROAD

Conditions of Use This document may only be used as permitted by the terms of the Consultancy Agreement and for the purposes and stages of the Project for which it has been prepared and delivered by Elenberg Fraser; and by authorized persons who agree to these conditions. Subject only to the Consultancy Agreement: this document and all intellectual property rights in it remain the property of Elenberg Fraser and may not be changed, used, reproduced, provided or disclosed by or to any person without the written consent of Elenberg Fraser, and only then with clear identification of Elenberg Fraser as author and owner and of all changes made. . each user must: (a) not scale any drawing, use figured dimensions only and verify all dimensions;
 (b) only use this document in conjunction with all other relevant Project documents, specifications and information from any person; (c) where this document is issued in electronic form, make all appropriate electronic data, systems and document checks and comply with all third party proprietary software requirements;
 (d) properly form their own opinion as to the correctness and sufficiency of the document for their purposes and notify Elenberg Fraser immediately upon becoming aware of any issue; 3. to the maximum extent permitted by law, all conditions and warranties concerning this document are expressly excluded and each user accepts fully and will appropriately insure for all risks and releases and indemnifies Elenberg Fraser from and against all claims, liabilities, loss, costs and expenses arising out of or in connection with any use, reliance upon, reproduction or disclosure of or change to this document.

SCALE@A1 1:100 SCALE@A3 1:200

PRELIMINARY **NOT FOR CONSTRUCTION** Figured dimensions take precedence to scale readings. Verify all dimensions on site. Report any discrepancies to the Architect for decision before proceeding with the work.

Ť

Copyright 🍘

ELENBERG FRASER

LEVEL 1, 160 QUEEN STREET MELBOURNE VICTORIA 3000 AUSTRALIA TEL +61 3 9600 2260 FAX +61 3 9600 2266 EMAIL MAIL@ELENBERGFRASER.COM WWW.ELENBERGFRASER.COM ABN 97 556 188 726

Project Title IMG




300 CITY ROAD SOUTHBANK

Drawing Title LEVEL 03 - 07 TYPICAL FLOOR PLAN

Project Number 17155 Drawing Status TP

Drawing Number A0103 Revision Feb 26, 2024 – 7:58pm

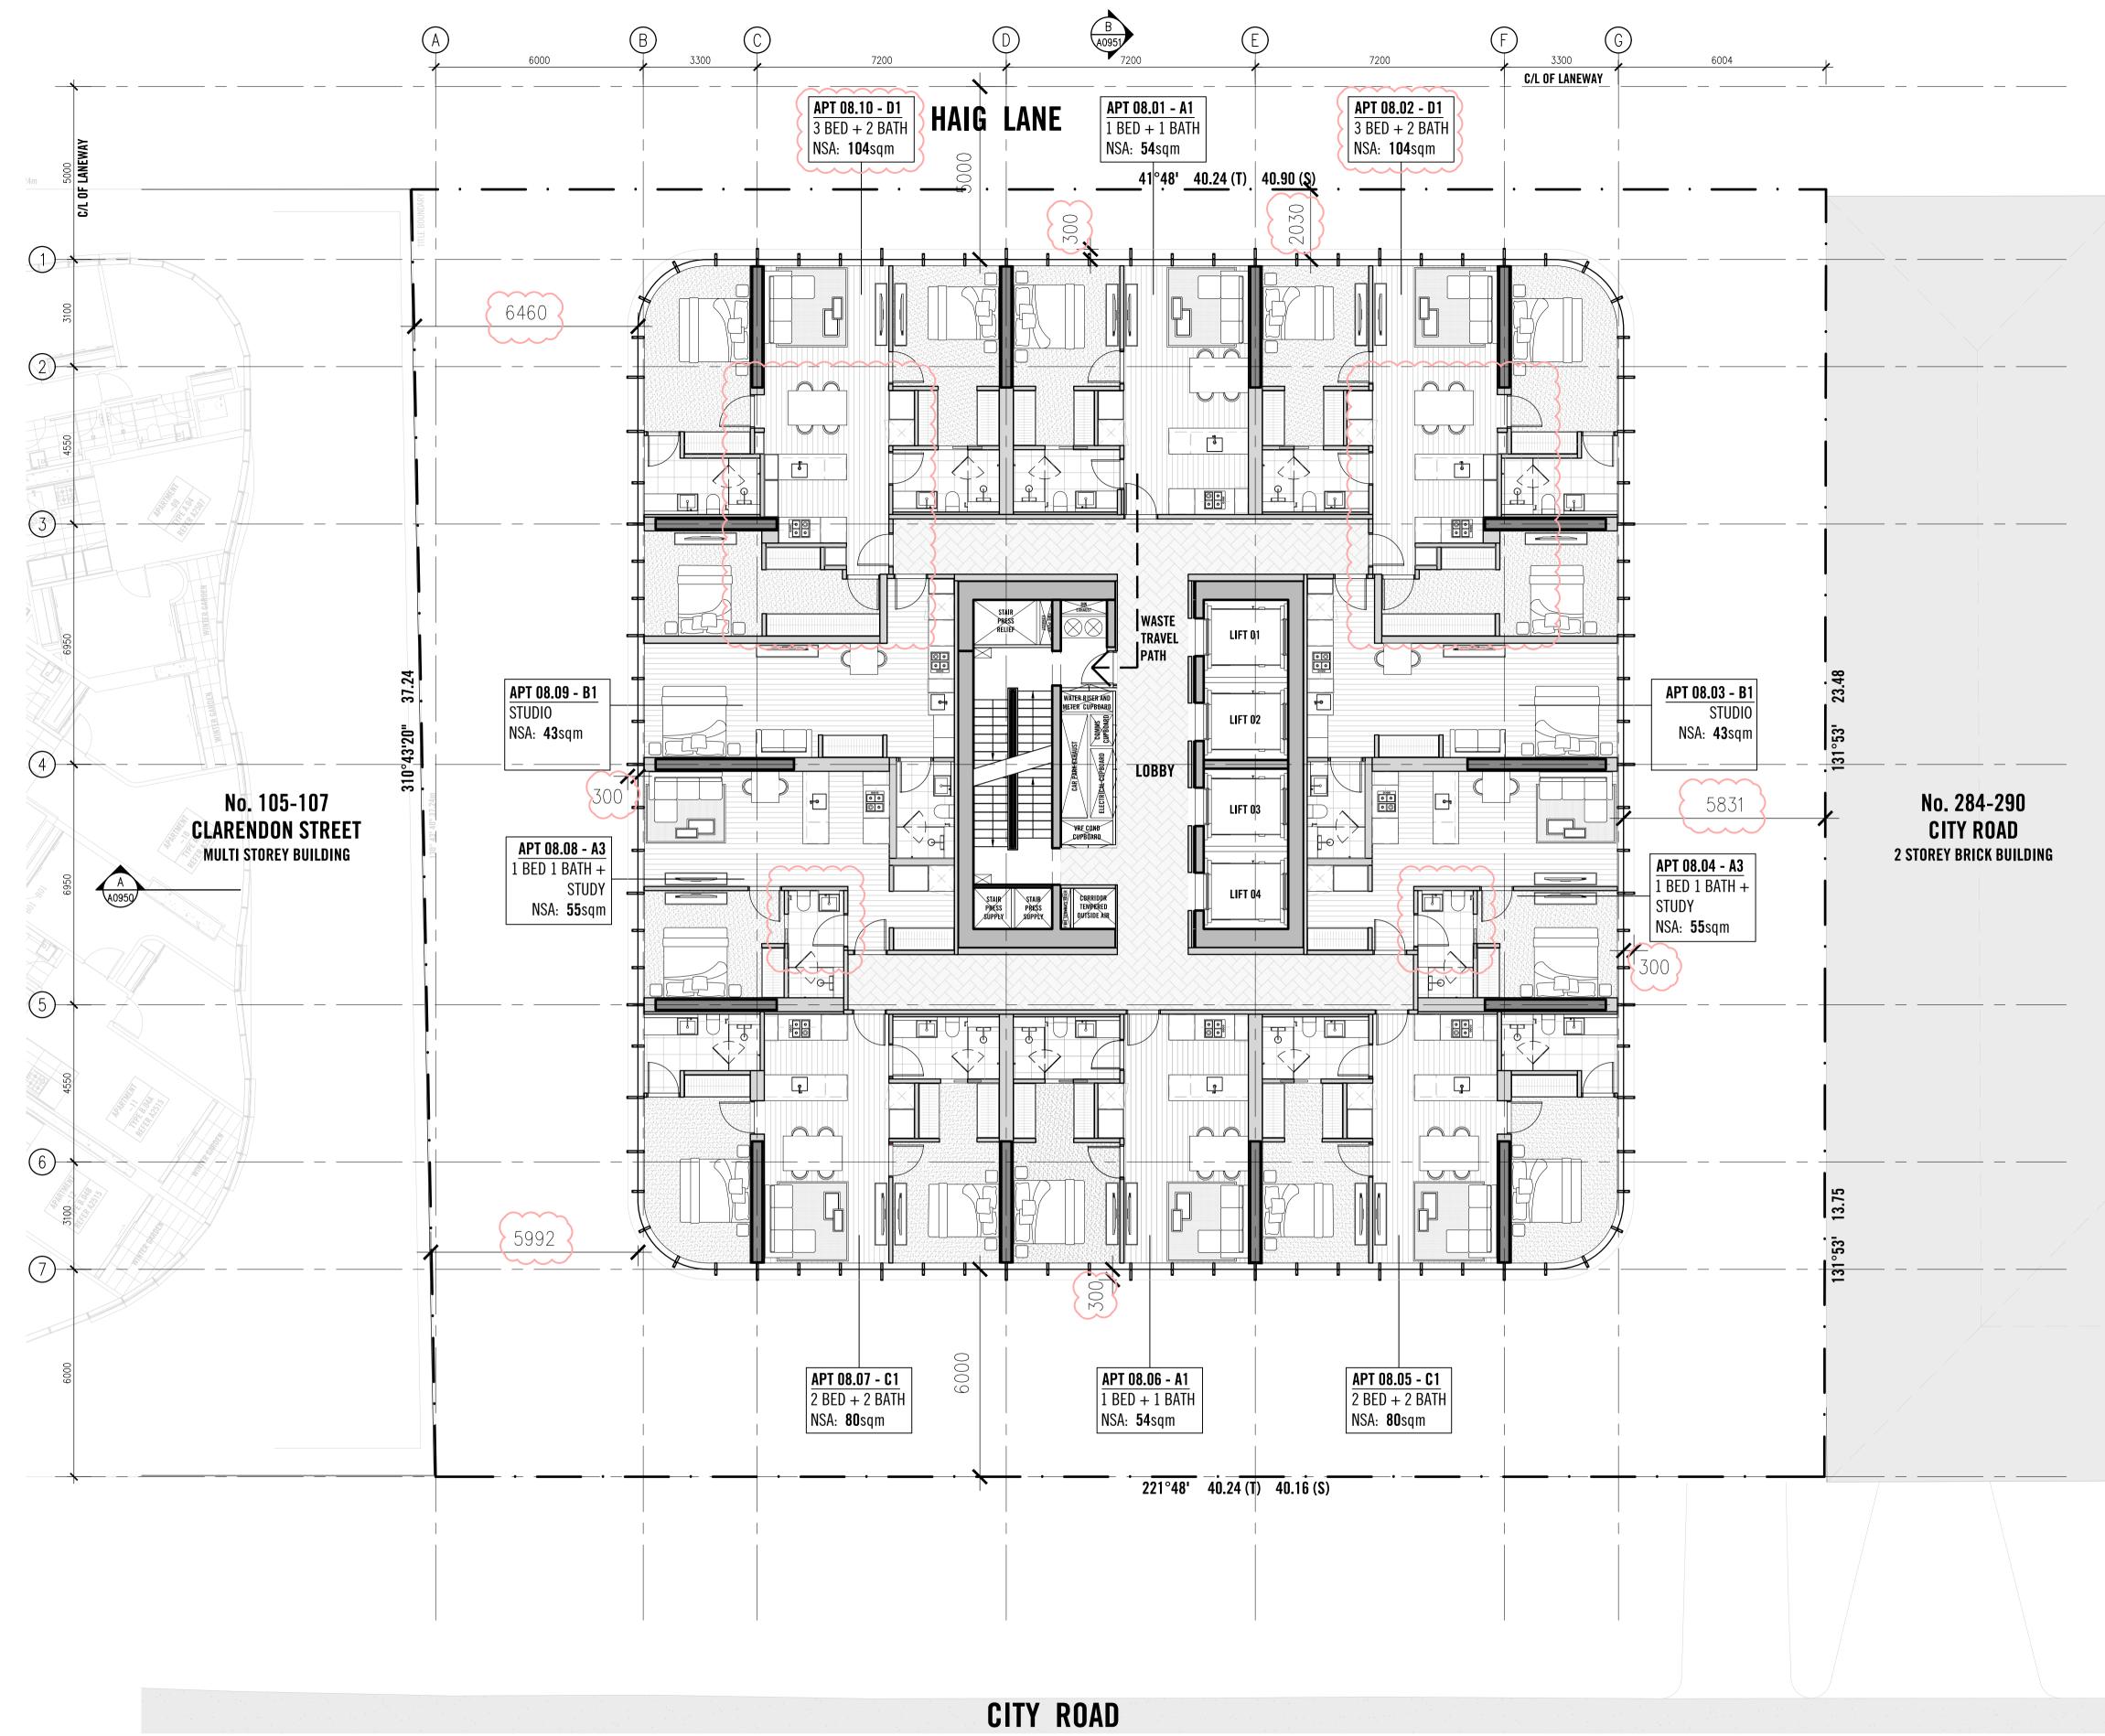

Rev No.	Date	Reason for issue	Issued by	Rev No.	Date	Reason for issue	Issued by	Rev No.	Date	Reason for issue	Issued by	Conditions of Use
A	16.10.19	ISSUED FOR INFORMATION AND COORDINATION	MN									This document may only stages of the Project fo who agree to these con
В	08.11.19	ISSUED FOR INFORMATION AND COORDINATION	MN									1. this document and
U	27.11.19	ISSUED FOR TOWN PLANNING	RM									changed, used, reprod
D	03.04.20	ISSUED FOR TOWN PLANNING RFI	AM									Fraser, and only then
E	29.05.20	ISSUED FOR TOWN PLANNING RFI	MN									2. each user must:
F	11.12.20	ISSUED FOR TOWN PLANNING RFI	MS									(a) not scale any
G	06.05.21	ISSUED FOR TOWN PLANNING RFI	RM									(b) only use this
H	05.05.22	ISSUED FOR TP ENDORSEMENT – INFO & COORDINATION	RM									information from a
I	02.12.22	ISSUED FOR TP AMENDMENT	DH									(c) where this doo
J	20.07.23	ISSUED FOR TP AMENDMENT	DH									document checks a
K	03.08.23	ISSUED FOR TP AMENDMENT	RM									(d) properly form and notify Elenberg
L	21.11.23	ISSUED FOR TP AMENDMENT	DH									, ,
M	29.01.24	ISSUED FOR TP RFI	DH									 to the maximum e excluded and each use
N	26.02.24	ISSUED FOR TP RFI	DH									Fraser from and agair
				1				1				I reliance upon, reprodu

This document may only be used as permitted by the terms of the Consultancy Agreement and for the purposes and stages of the Project for which it has been prepared and delivered by Elenberg Fraser; and by authorized persons who agree to these conditions. Subject only to the Consultancy Agreement: this document and all intellectual property rights in it remains regreated to the contract of the property of Elenberg Fraser and may not be changed, used, reproduced, provided or disclosed by or to any person without the written consent of Elenberg Fraser, and only then with clear identification of Elenberg Fraser as author and owner and of all changes made. . each user must: (a) not scale any drawing, use figured dimensions only and verify all dimensions;
 (b) only use this document in conjunction with all other relevant Project documents, specifications and information from any person; (c) where this document is issued in electronic form, make all appropriate electronic data, systems and document checks and comply with all third party proprietary software requirements;
 (d) properly form their own opinion as to the correctness and sufficiency of the document for their purposes and notify Elenberg Fraser immediately upon becoming aware of any issue;

3. to the maximum extent permitted by law, all conditions and warranties concerning this document are expressly excluded and each user accepts fully and will appropriately insure for all risks and releases and indemnifies Elenberg Fraser from and against all claims, liabilities, loss, costs and expenses arising out of or in connection with any use, reliance upon, reproduction or disclosure of or change to this document.

SCALE@A1 1:100 SCALE@A3 1:200



Ť

Copyright 😋

ELENBERG FRASER

LEVEL 1, 160 QUEEN STREET MELBOURNE VICTORIA 3000 AUSTRALIA TEL +61 3 9600 2260 FAX +61 3 9600 2266 EMAIL MAIL@ELENBERGFRASER.COM WWW.ELENBERGFRASER.COM ABN 97 556 188 726

Project Title IMG






Drawing Title LEVEL 08, 10 - 29 TYPICAL FLOOR PLAN

Project Number 17155 Drawing Status TP

Drawing Number A0108 Revision Feb 26, 2024 – 5:07pm

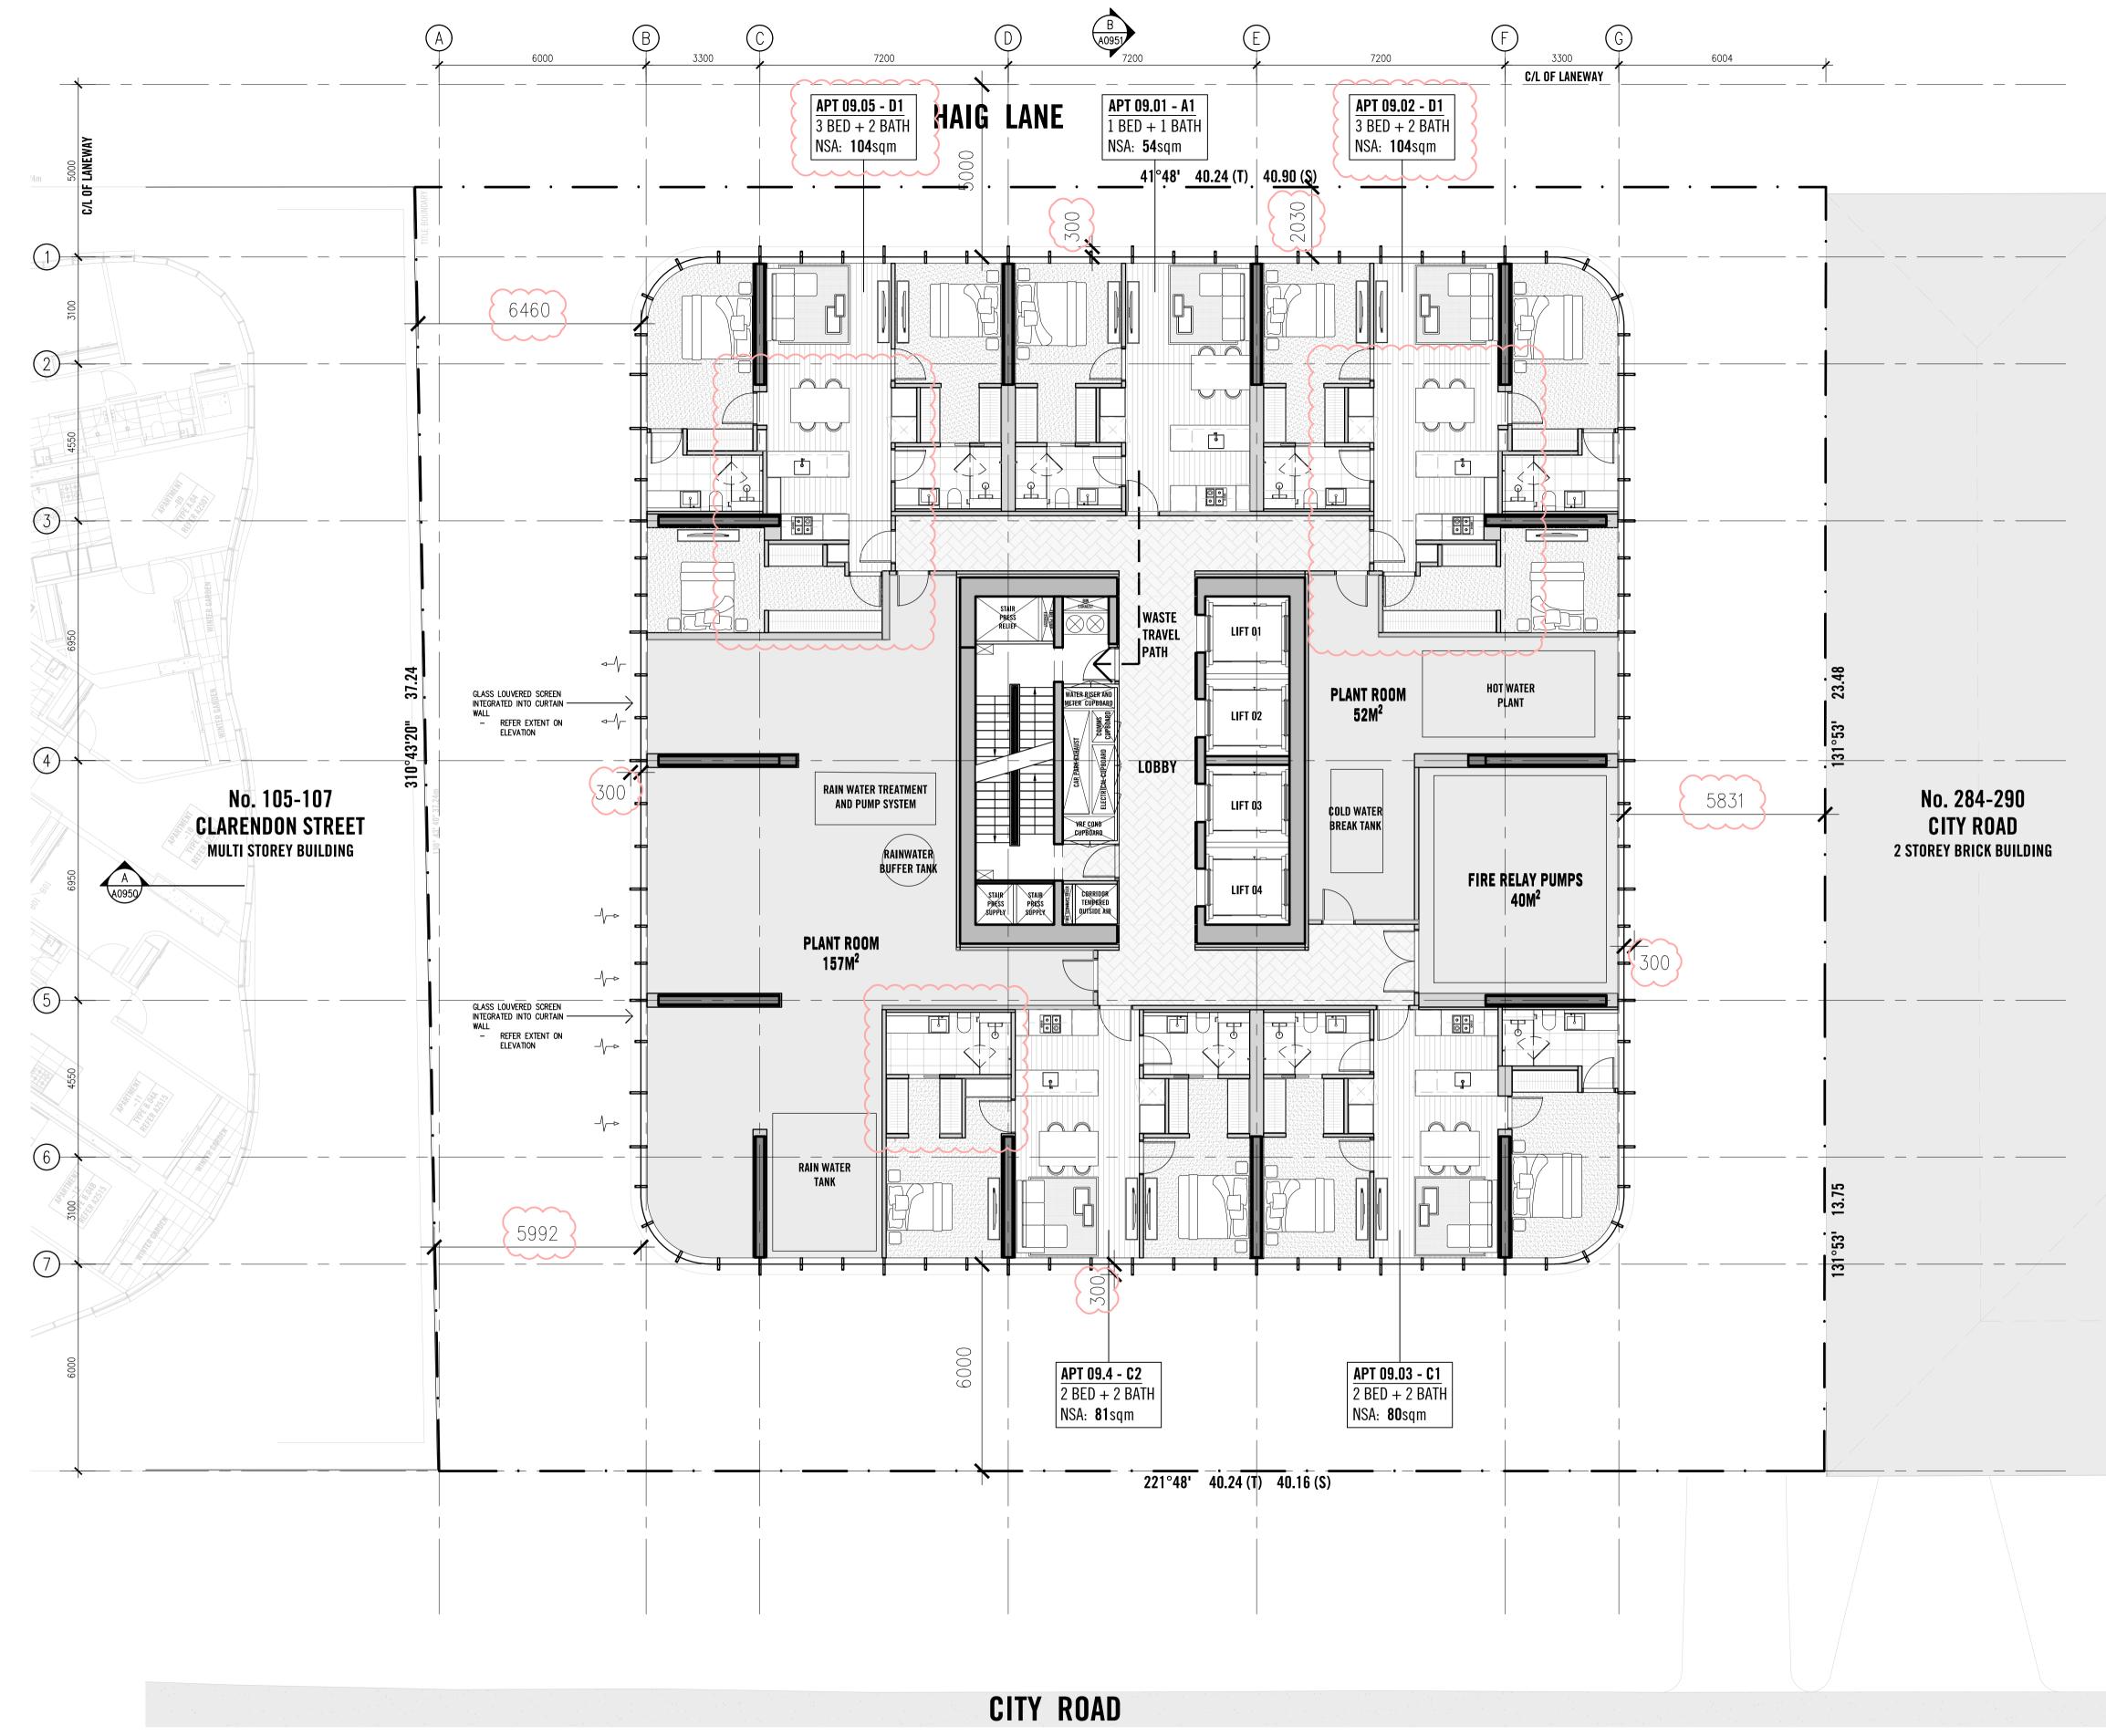

Rev No. A B C	Date 21.11.23 29.01.24 26.02.24	Reason for issue ISSUED FOR TP AMENDMENT ISSUED FOR TP RFI ISSUED FOR TP RFI	Issued by DH DH DH	Rev No.	Date	Reason for issue	Issued by	Rev No.	Date	Reason for issue	issued by	Conditions of Use This document ma stages of the Proj who agree to thes 1. this documen changed, used, r Fraser, and only 2. each user mu
												 each user m (a) not scal (b) only use information f (c) where th document ch
												 (d) properly and notify El 3. to the maxime excluded and excluded and excluded from and Fraser from and reliance upon, r

This document may only be used as permitted by the terms of the Consultancy Agreement and for the purposes and stages of the Project for which it has been prepared and delivered by Elenberg Fraser; and by authorized persons who agree to these conditions. Subject only to the Consultancy Agreement: this document and all intellectual property rights in it remains regreated to the contract of the property of Elenberg Fraser and may not be changed, used, reproduced, provided or disclosed by or to any person without the written consent of Elenberg Fraser, and only then with clear identification of Elenberg Fraser as author and owner and of all changes made. each user must: (a) not scale any drawing, use figured dimensions only and verify all dimensions;
 (b) only use this document in conjunction with all other relevant Project documents, specifications and information from any person; (c) where this document is issued in electronic form, make all appropriate electronic data, systems and document checks and comply with all third party proprietary software requirements;
 (d) properly form their own opinion as to the correctness and sufficiency of the document for their purposes and notify Elenberg Fraser immediately upon becoming aware of any issue;

3. to the maximum extent permitted by law, all conditions and warranties concerning this document are expressly excluded and each user accepts fully and will appropriately insure for all risks and releases and indemnifies Elenberg Fraser from and against all claims, liabilities, loss, costs and expenses arising out of or in connection with any use, reliance upon, reproduction or disclosure of or change to this document.

SCALE@A1 1:100 SCALE@A3 1:200

PRELIMINARY **NOT FOR CONSTRUCTION** Figured dimensions take precedence to scale readings. Verify all dimensions on site. Report any discrepancies to the Architect for decision before proceeding with the work.

Ĩ

Copyright 😋

ELENBERG FRASER

LEVEL 1, 160 QUEEN STREET MELBOURNE VICTORIA 3000 AUSTRALIA TEL +61 3 9600 2260 FAX +61 3 9600 2266 EMAIL MAIL@ELENBERGFRASER.COM WWW.ELENBERGFRASER.COM ABN 97 556 188 726

IMG

Project Title

ADVERTISED PLAN


300 CITY ROAD SOUTHBANK

Drawing Title LEVEL 09 PLANT ROOM FLOOR PLAN Project Number 17155

Drawing Status

TP

Drawing Number A0109 Revision Feb 26, 2024 – 8:11pm

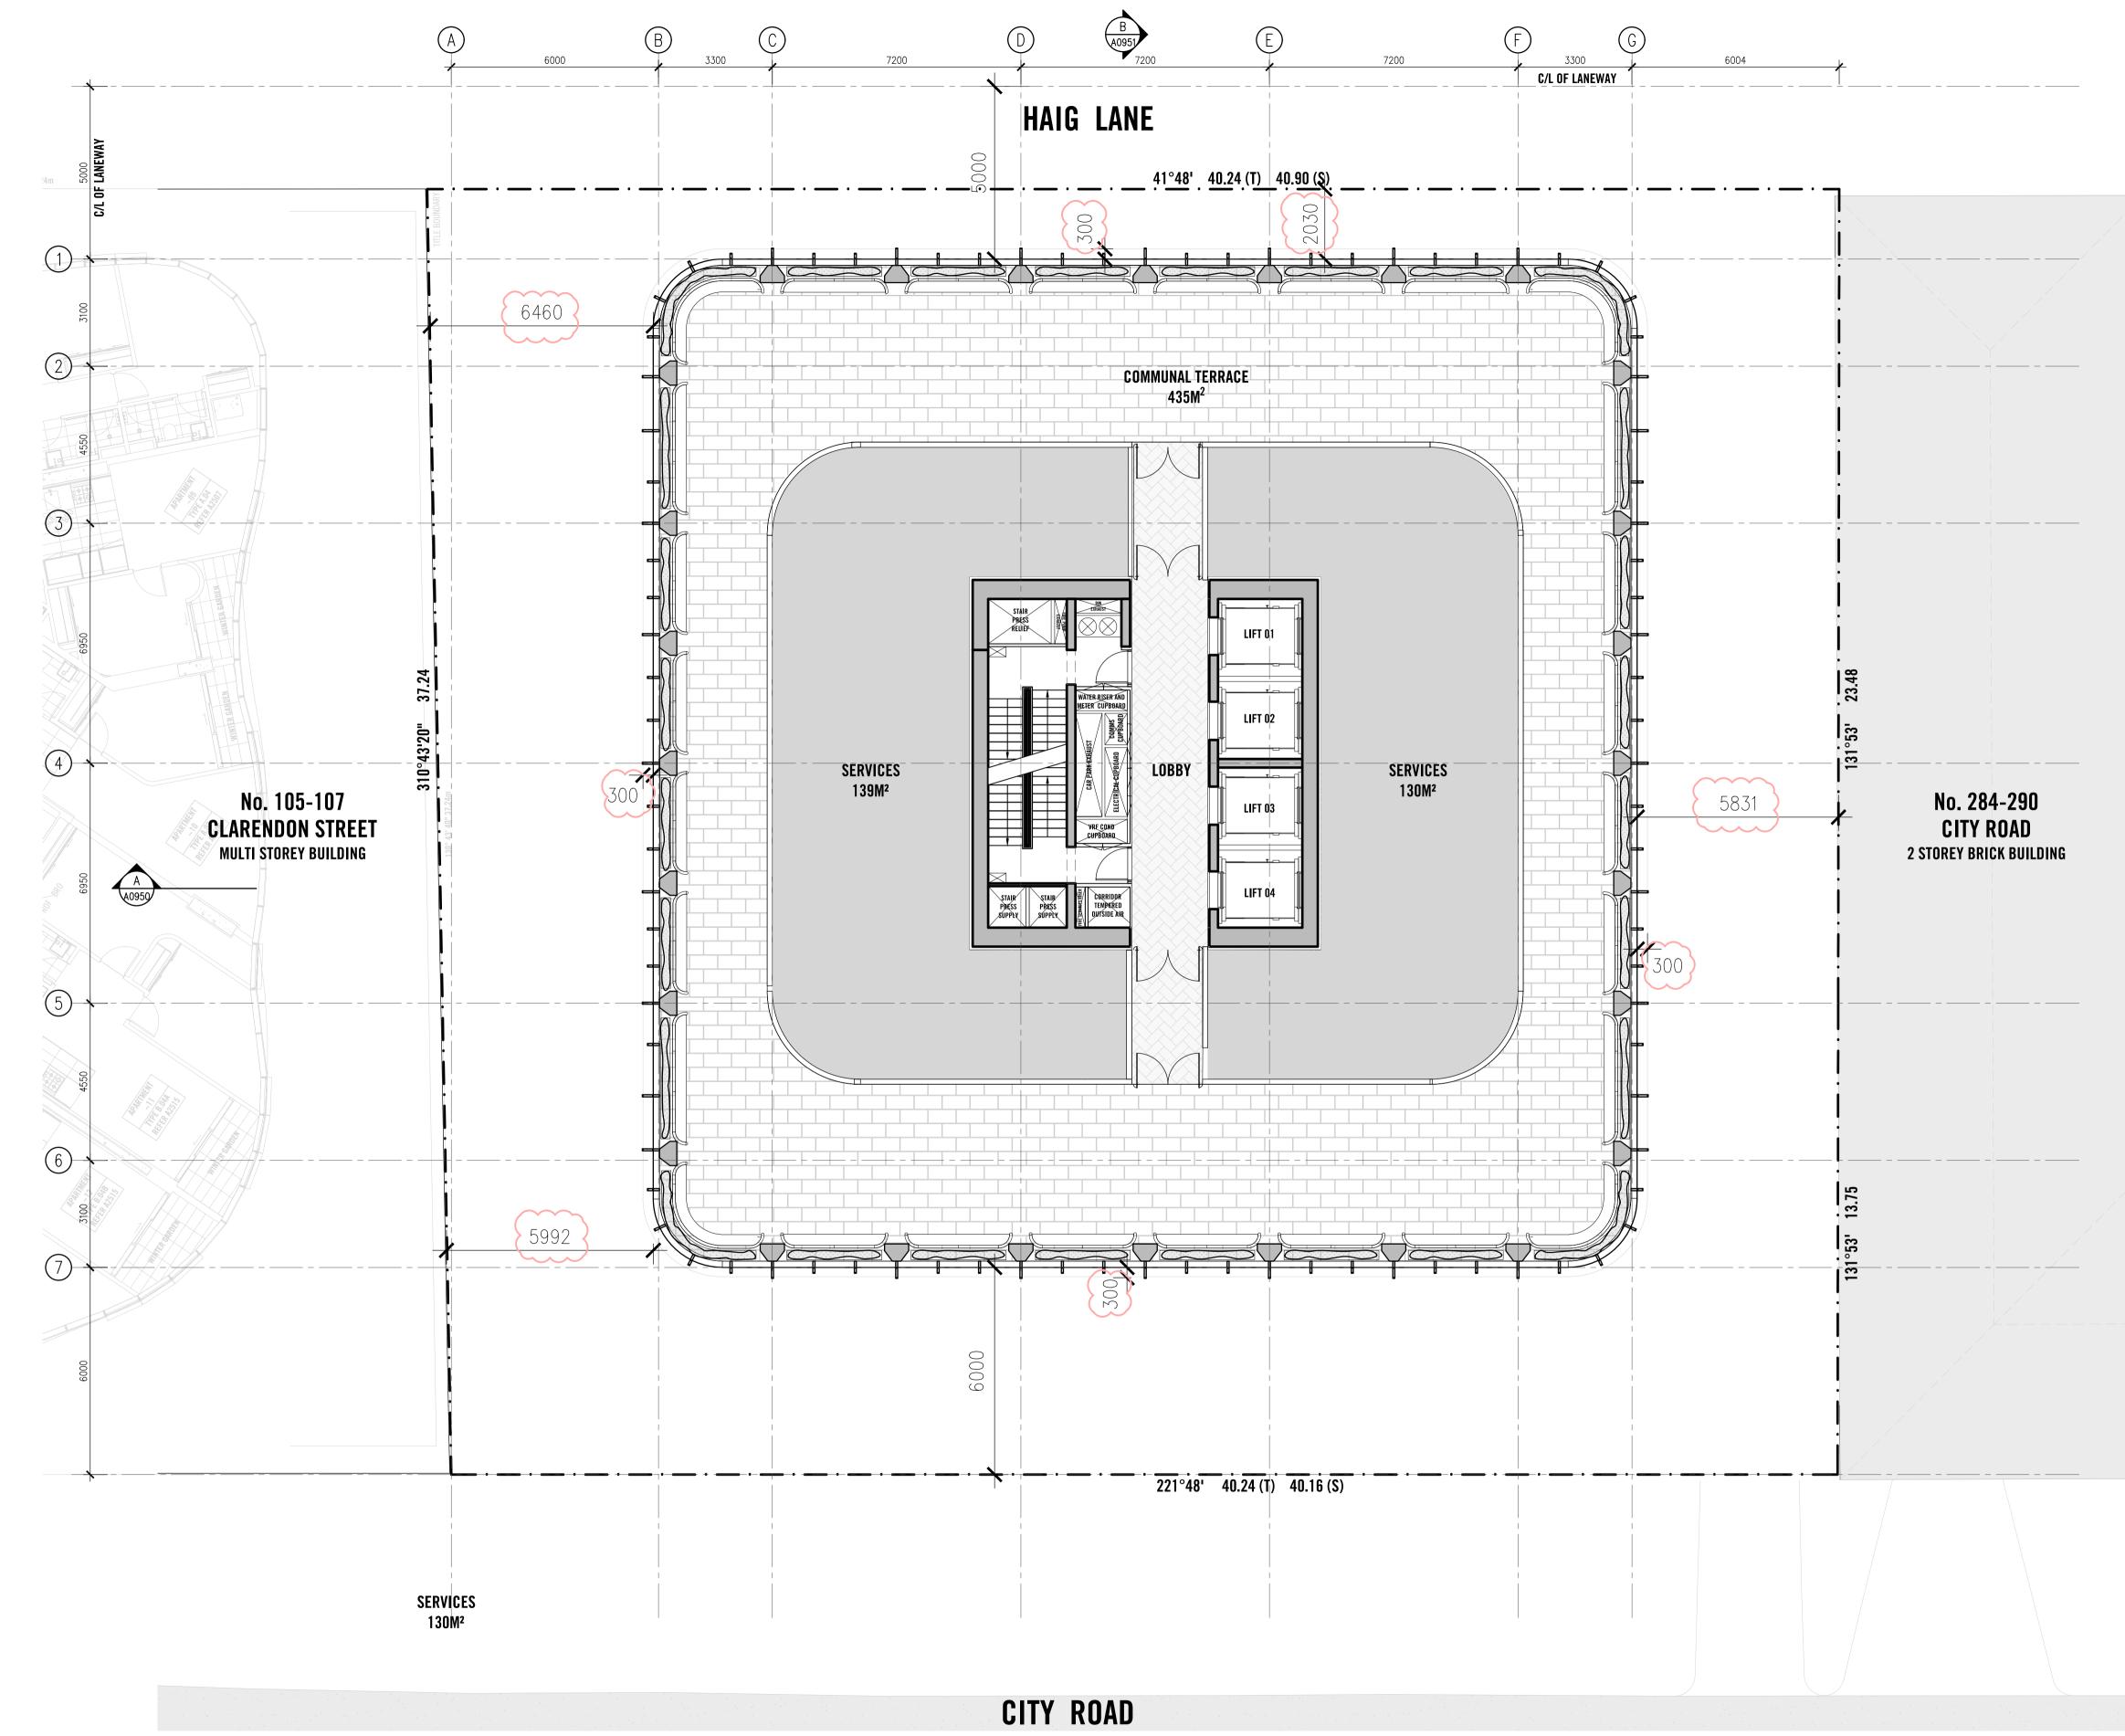

Rev No. A B	Date 02.09.22 29.01.24	Reason for issue ISSUED FOR TP AMENDMENT ISSUED FOR TP RFI	DH	Rev No.	Date	Reason for issue	Issued by	Rev No.	Date	Reason for issue	Issued by
C	26.02.24	ISSUED FOR TP RFI	DH								

onditions of Use Conditions of use Conditions of use This document may only be used as permitted by the terms of the Consultancy Agreement and for the purposes and stages of the Project for which it has been prepared and delivered by Elenberg Fraser; and by authorized persons who agree to these conditions. Subject only to the Consultancy Agreement: 1. this document and all intellectual property rights in it remain the property of Elenberg Fraser and may not be changed, used, reproduced, provided or disclosed by or to any person without the written consent of Elenberg Fraser, and only then with clear identification of Elenberg Fraser as author and owner and of all changes made. each user must: each user must:

 (a) not scale any drawing, use figured dimensions only and verify all dimensions;
 (b) only use this document in conjunction with all other relevant Project documents, specifications and information from any person;
 (c) where this document is issued in electronic form, make all appropriate electronic data, systems and document checks and comply with all third party proprietary software requirements;
 (d) properly form their own opinion as to the correctness and sufficiency of the document for their purposes and notify Elenberg Fraser immediately upon becoming aware of any issue;
 to the maximum extent permitted by law, all conditions and warranties concerning this document are expressly excluded and each user accepts fully and will appropriately nusure for all risks and release and indeminities Elenberg Fraser from and against all claims, liabilities, loss, costs and expenses arising out of or in connection with any use, reliance upon, reproduction or disclosure of or change to this document.

SCALE@A1 1:100 SCALE@A3 1:200



Ť

Copyright 🍘

ELENBERG FRASER

LEVEL 1, 160 QUEEN STREET MELBOURNE VICTORIA 3000 AUSTRALIA TEL +61 3 9600 2260 FAX +61 3 9600 2266 EMAIL MAIL@ELENBERGFRASER.COM WWW.ELENBERGFRASER.COM ABN 97 556 188 726

Project Title IMG




300 CITY ROAD SOUTHBANK

Drawing Title LEVEL 30 **ROOF PLAN** Project Number 17155

Drawing Status

TP

Drawing Number A0130 Revision Feb 26, 2024 – 7:11pm

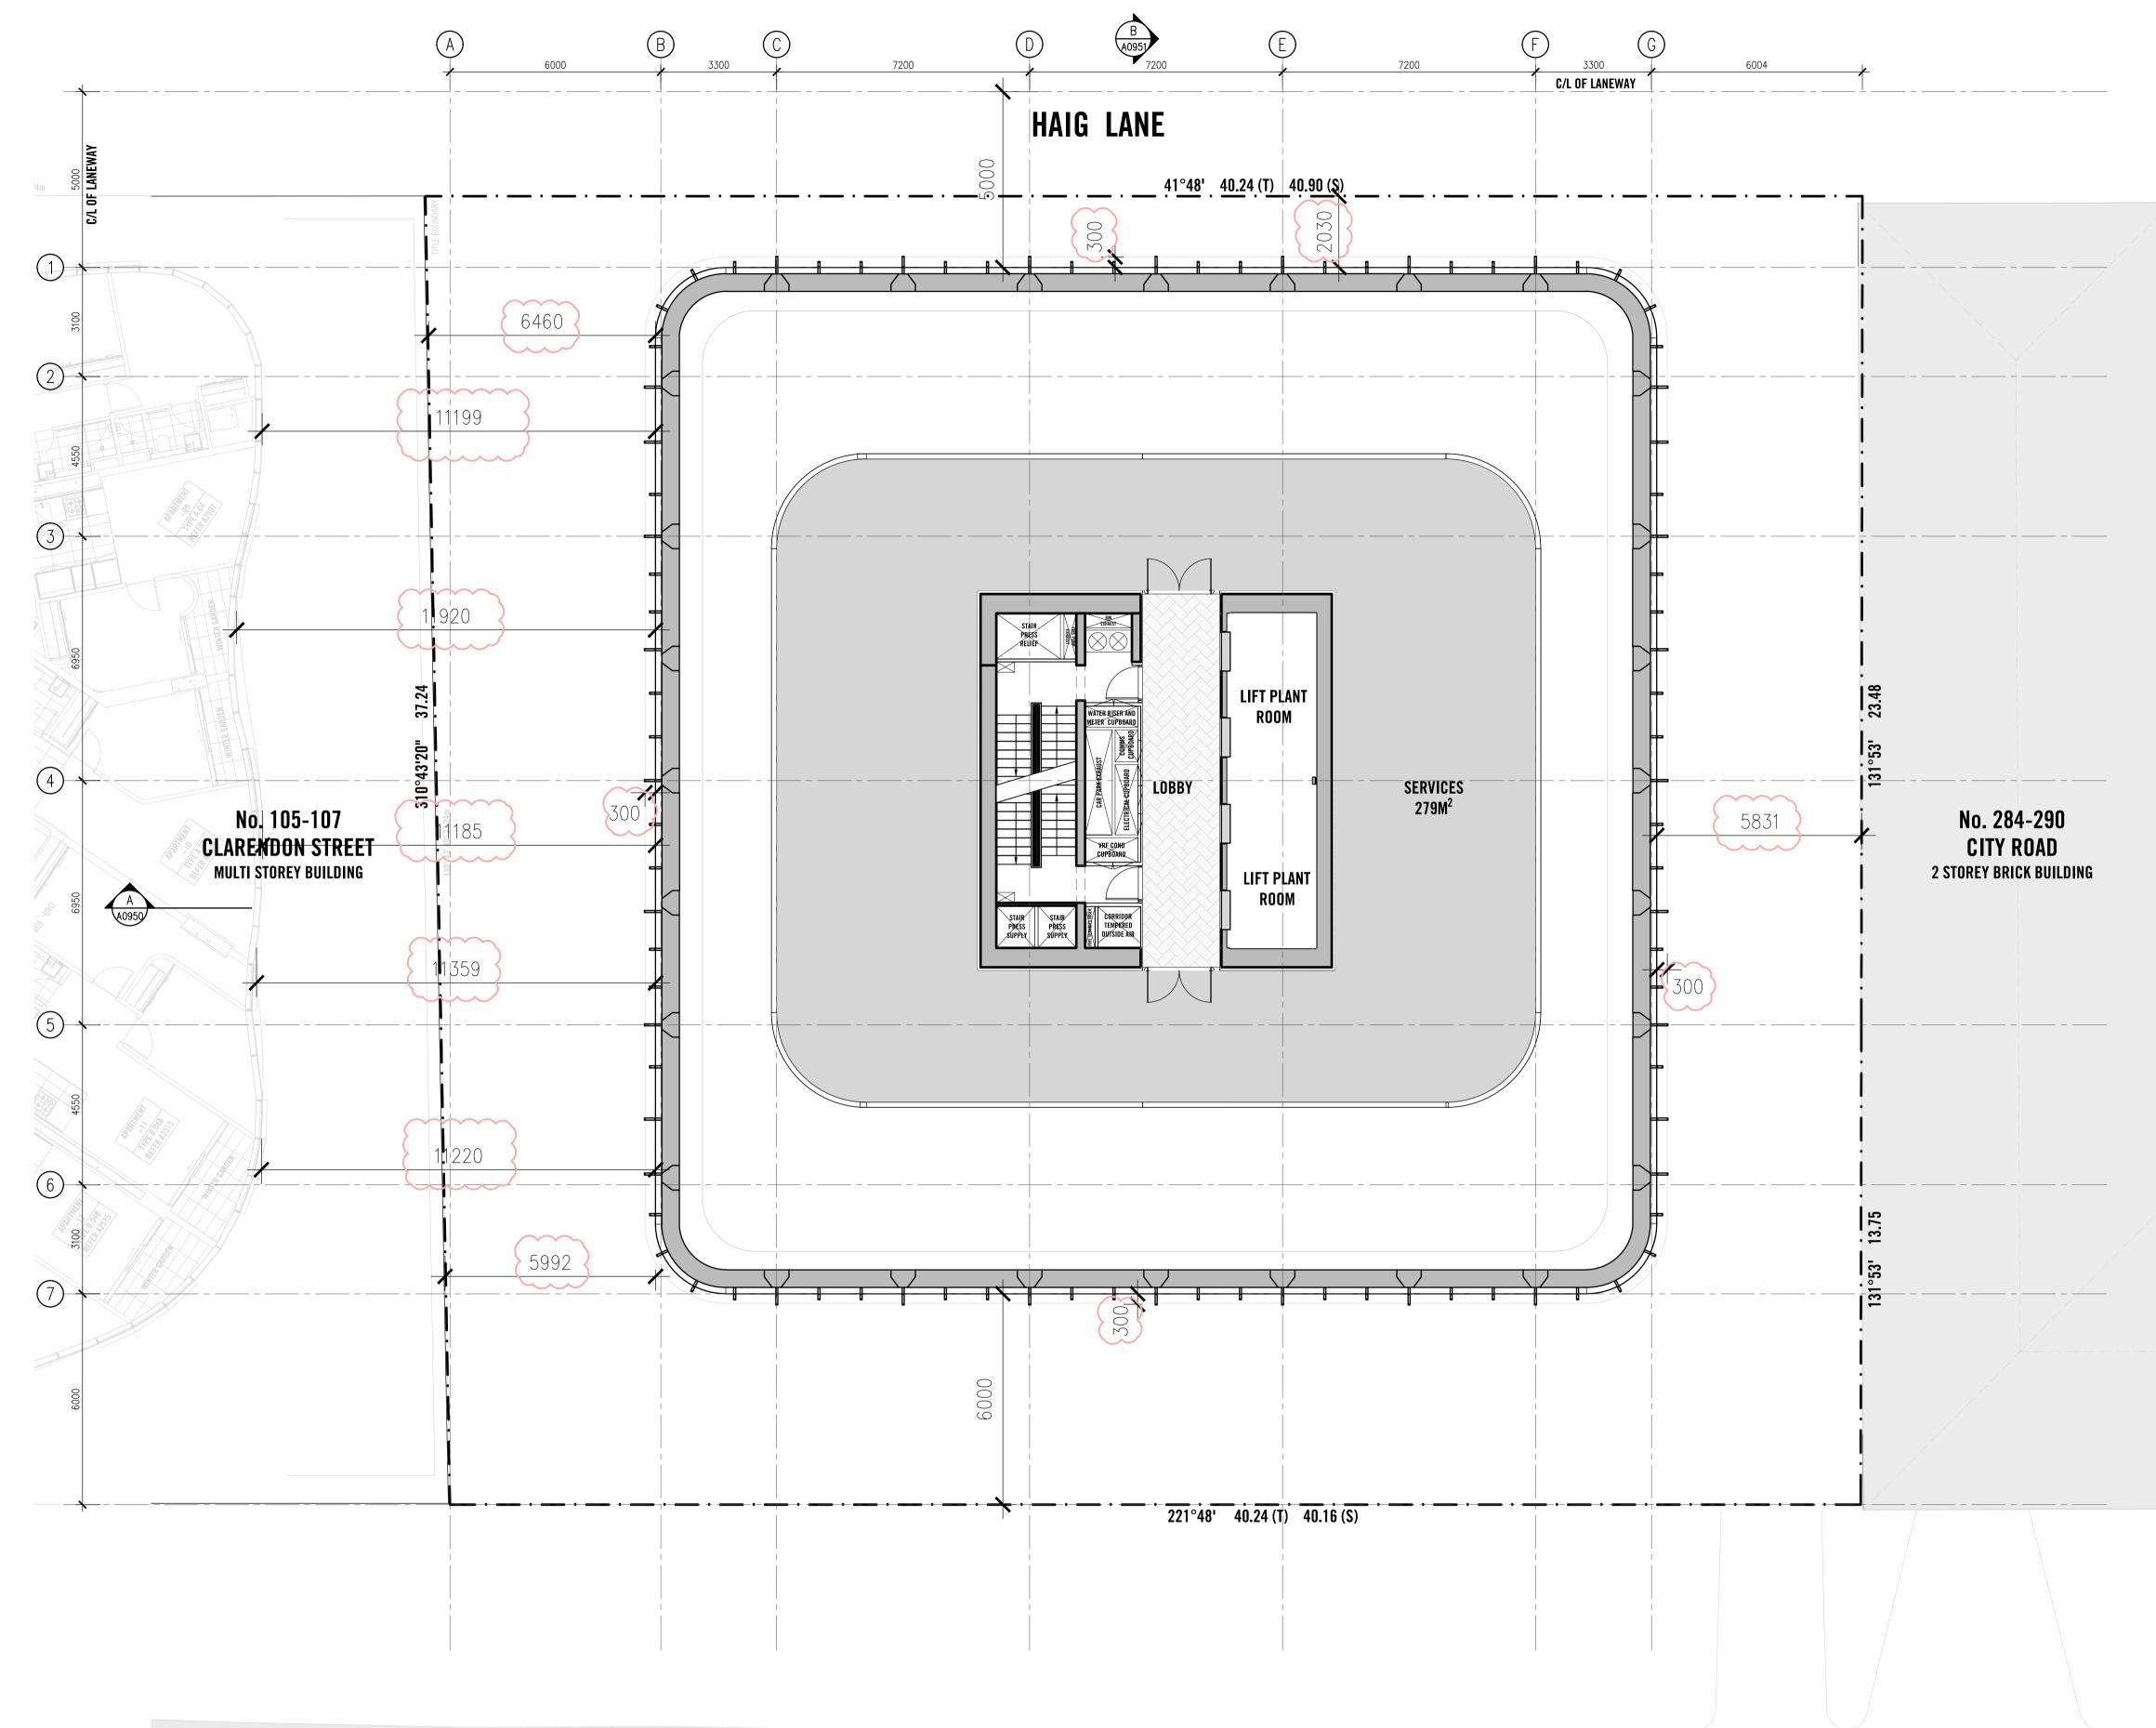

Rev No. A B C	Date 21.11.23 29.01.24 26.02.24	Reason for issue ISSUED FOR TP AMENDMENT ISSUED FOR TP RFI ISSUED FOR TP RFI	Issued by DH DH DH	Rev No.	Date	Reason for issue	Issu	sued by Rev	No. Date	Reason for issue	Issued

CITY ROAD

 Issued by
 Conditions of Use

 This document may only be used as permitted by the terms of the Consultancy Agreement and for the purposes and stages of the Project for which it has been prepared and delivered by Elenberg Fraser; and by authorized persons who agree to these conditions. Subject only to the Consultancy Agreement:

 1.
 this document and all intellectual property rights in it remain the property of Elenberg Fraser and may not be changed, used, reproduced, provided or disclosed by or to any person without the written consent of Elenberg Fraser, and only then with clear identification of Elenberg Fraser as author and owner and of all changes made.

 2.
 each user must:

 (a)
 not scale any drawing, use figured dimensions only and verify all dimensions;

 (b)
 only use this document in conjunction with all other relevant Project documents, specifications and information from any person;

 (c)
 where this document is issued in electronic form, make all appropriate electronic data, systems and document checks and comply with all third party proprietary software requirements;

 (d)
 property form their own opinion as to the correctness and sufficiency of the document for their purposes and notify Elenberg Fraser immediately upon becoming aware of any issue;

 3.
 to the maximum extent permitted by law, all conditions and warranties concerning this document are expressly excluded and each user accepts fully and will appropriately insure for all risks and releases and indemnifies Elenberg Fraser from and against all claims, liabilities, loss, costs and expenses arising out of or in connection with any use, reliance

SCALE@A1 1:100 SCALE@A3 1:200



Ť

Copyright 🍘

ELENBERG FRASER

LEVEL 1, 160 QUEEN STREET MELBOURNE VICTORIA 3000 AUSTRALIA TEL +61 3 9600 2260 FAX +61 3 9600 2266 EMAIL MAIL@ELENBERGFRASER.COM WWW.ELENBERGFRASER.COM ABN 97 556 188 726

Project Title IMG



300 CITY ROAD SOUTHBANK

Drawing Title LEVEL 31 MACHINE ROOM PLAN Project Number 17155


Drawing Status

TP





Rev No.	Date	Reason for issue	Issued by	Rev No.	Date	Reason for issue	Issued	by Rev No.	Date	Reason for issue	Issued by	Conc
Α	16.10.19	ISSUED FOR INFORMATION AND COORDINATION	MN								1	stag
В	08.11.19	ISSUED FOR INFORMATION AND COORDINATION	MN									who
C	27.11.19	ISSUED FOR TOWN PLANNING	RM									1.
D	03.04.20	ISSUED FOR TOWN PLANNING RFI	AM									Fr
E	29.05.20	ISSUED FOR TOWN PLANNING RFI	MN									2.
F	11.12.20	ISSUED FOR TOWN PLANNING RFI	MS									6
G	06.05.21	ISSUED FOR TOWN PLANNING RFI	RM									(t
н	24.06.21	ISSUED FOR TOWN PLANNING RFI	RM									1
I	05.05.22	ISSUED FOR TP ENDORSEMENT – INFO & COORDINATION	RM									(0
J	05.08.22	ISSUED FOR TP ENDORSEMENT RFI	RM								l	1.
K	02.09.22	ISSUED FOR TP AMENDMENT	DH									(^{(c}
L	20.07.23	ISSUED FOR TP AMENDMENT	DH									3
М	21.11.23	ISSUED FOR TP AMENDMENT	DH								1	ex
											1	Fr
								I				

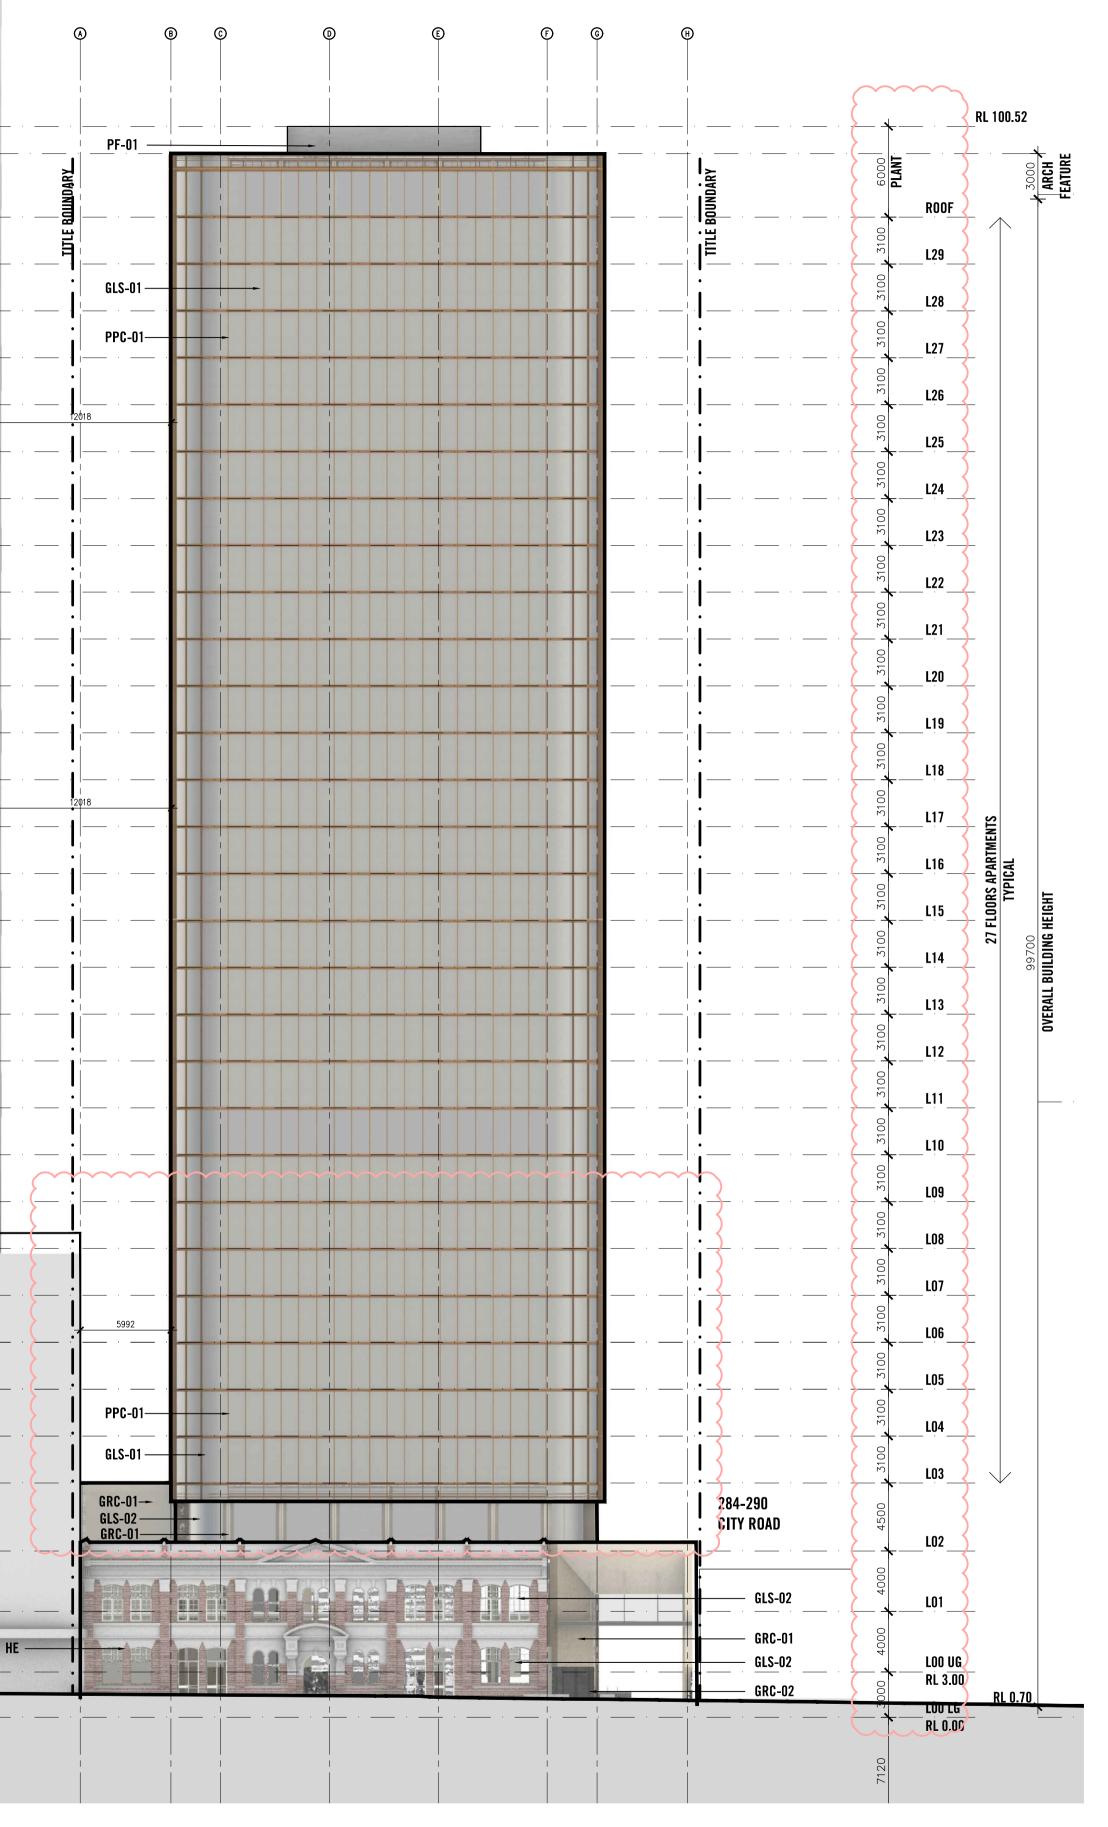

Conditions of Use This document may only be used as permitted by the terms of the Consultancy Agreement and for the purposes and stages of the Project for which it has been prepared and delivered by Elenberg Fraser; and by authorized persons who agree to these conditions. Subject only to the Consultancy Agreement: 1. this document and all intellectual property rights in it remain the property of Elenberg Fraser and may not be changed, used, reproduced, provided or disclosed by or to any person without the written consent of Elenberg Fraser, and only then with clear identification of Elenberg Fraser as author and owner and of all changes made. 2. each user must: (a) not scale any drawing, use figured dimensions only and verify all dimensions; (a) not scale any drawing, use figured dimensions only and verify all dimensions;
(b) only use this document in conjunction with all other relevant Project documents, specifications and information from any person;
(c) where this document is issued in electronic form, make all appropriate electronic data, systems and document checks and comply with all third party proprietary software requirements;
(d) properly form their own opinion as to the correctness and sufficiency of the document for their purposes and notify Elenberg Fraser immediately upon becoming aware of any issue;
3. to the maximum extent permitted by law, all conditions and warranties concerning this document are expressly excluded and each user accepts fully and will appropriately insure for all risks and releases and indemnifies Elenberg Fraser from and against all claims, liabilities, loss, costs and expenses arising out of or in connection with any use, reliance upon, reproduction or disclosure of or change to this document.

SCALE@A1 1:250 SCALE@A3 1:500

PRELIMINARY **NOT FOR CONSTRUCTION** Figured dimensions take precedence to scale readings. Verify all dimensions on site.

Report any discrepancies to the Architect for decision before proceeding with the work.

Copyright 🕲

ELENBERG FRASER LEVEL 1, 160 QUEEN STREET

MELBOURNE VICTORIA 3000 AUSTRALIA TEL +61 3 9600 2260 FAX +61 3 9600 2266 EMAIL MAIL@ELENBERGFRASER.COM WWW.ELENBERGFRASER.COM ABN 97 556 188 726

300 CIT SOUTHE IMG

Project Title





ITY ROAD Ibank	Drawing Title SOUTH ELEVATION CITY ROAD	
	Project Number	Drawing Number
	17155	A0900
	Drawing Status	Revision
	TP	Μ

Nov 27, 2023 - 8:17pm

ADVERTISED PLAN

This copied document to be made available for the sole purpose of enabling its consideration and review as part of a planning process under the Planning and Environment Act 1987. The document must not be used for any purpose which may breach any copyright

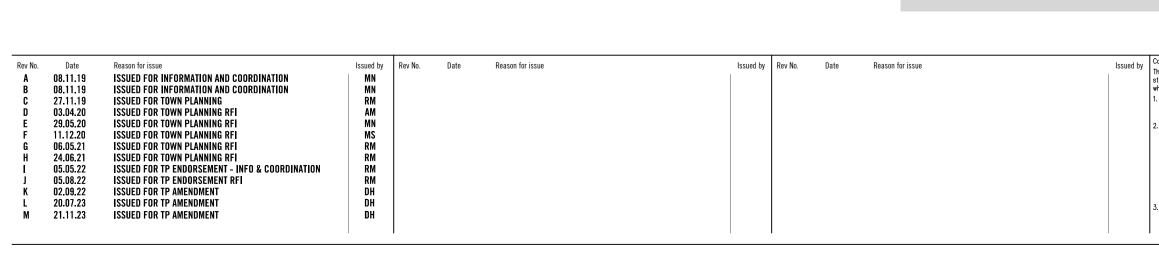

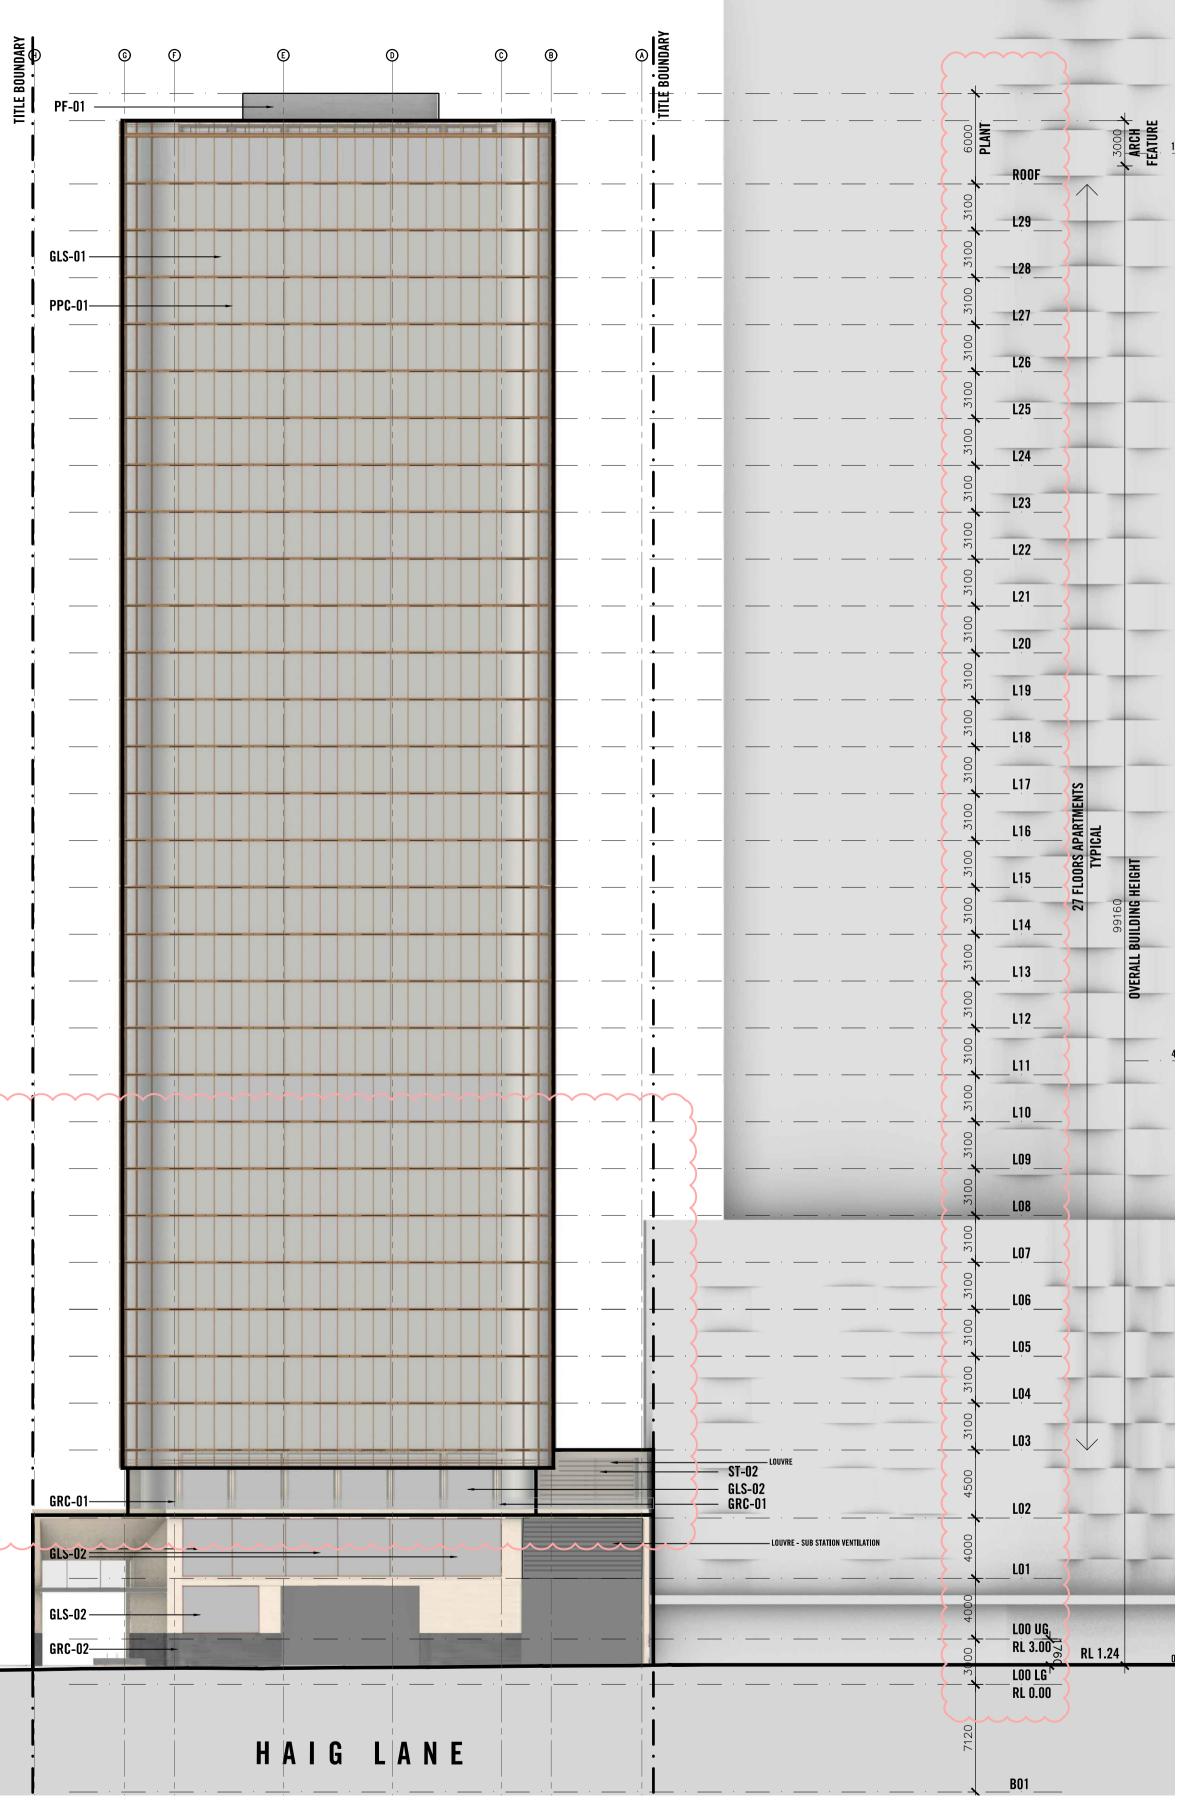

 Issued by
 Conditions of Use

 This document may only be used as permitted by the terms of the Consultancy Agreement and for the purposes and stages of the Project for which it has been prepared and delivered by Elenberg Fraser; and by authorized persons who agree to these conditions. Subject only to the Consultancy Agreement:

 1.
 this document and all intellectual property rights in it remain the property of Elenberg Fraser and may not be changed, used, reproduced, provided or disclosed by or to any person without the written consent of Elenberg Fraser, and only then with clear identification of Elenberg Fraser as author and owner and of all changes made.

 2.
 each user must:

 (a) not scale any drawing, use figured dimensions only and verify all dimensions; (a) not scale any drawing, use figured dimensions only and verify all dimensions;
(b) only use this document in conjunction with all other relevant Project documents, specifications and information from any person;
(c) where this document is issued in electronic form, make all appropriate electronic data, systems and document checks and comply with all third party proprietary software requirements;
(d) properly form their own opinion as to the correctness and sufficiency of the document for their purposes and notify Elenberg Fraser immediately upon becoming aware of any issue;
3. to the maximum extent permitted by law, all conditions and warranties concerning this document are expressly excluded and each user accepts fully and will appropriately insure for all risks and releases and indemnifies Elenberg Fraser from and against all claims, liabilities, loss, costs and expenses arising out of or in connection with any use, reliance upon, reproduction or disclosure of or change to this document.

SCALE@A1 1:250 SCALE@A3 1:500

PRELIMINARY **NOT FOR CONSTRUCTION** Figured dimensions take precedence to scale readings. Verify all dimensions on site. Report any discrepancies to the Architect for decision before proceeding with the work.

Copyright 🕲

ELENBERG FRASER

LEVEL 1, 160 QUEEN STREET MELBOURNE VICTORIA 3000 AUSTRALIA TEL +61 3 9600 2260 FAX +61 3 9600 2266 EMAIL MAIL@ELENBERGFRASER.COM WWW.ELENBERGFRASER.COM ABN 97 556 188 726

IMG

Project Title



 
300 CITY ROAD SOUTHBANK

Drawing Title NORTH ELEVATION HAIG LANE


Project Number 17155 Drawing Status TP

Drawing Number A0901 Revision Nov 27, 2023 - 8:27pm

ADVERTISED PLAN



Rev No.	Date	Reason for issue	Issued by	Rev No.	Date	Reason for issue	Issued	y Rev N	. Date	Reason for issue		Con This
Α	08.11.19	ISSUED FOR INFORMATION AND COORDINATION	MN									stag
В	08.11.19	ISSUED FOR INFORMATION AND COORDINATION	MN									who
C	27.11.19	ISSUED FOR TOWN PLANNING	RM									1.
D	03.04.20	ISSUED FOR TOWN PLANNING RFI	AM									
E	29.05.20	ISSUED FOR TOWN PLANNING RFI	MN									2.
F	11.12.20	ISSUED FOR TOWN PLANNING RFI	MS									6
G	06.05.21	ISSUED FOR TOWN PLANNING RFI	RM									1 à
H	24.06.21	ISSUED FOR TOWN PLANNING RFI	RM									1
I	05.05.22	ISSUED FOR TP ENDORSEMENT - INFO & COORDINATION	RM									(
J	05.08.22	ISSUED FOR TP ENDORSEMENT RFI	RM									1
K	02.09.22	ISSUED FOR TP AMENDMENT	DH) (
L	20.07.23	ISSUED FOR TP AMENDMENT	DH									1
М	21.11.23	ISSUED FOR TP AMENDMENT	DH									l e
												Fr

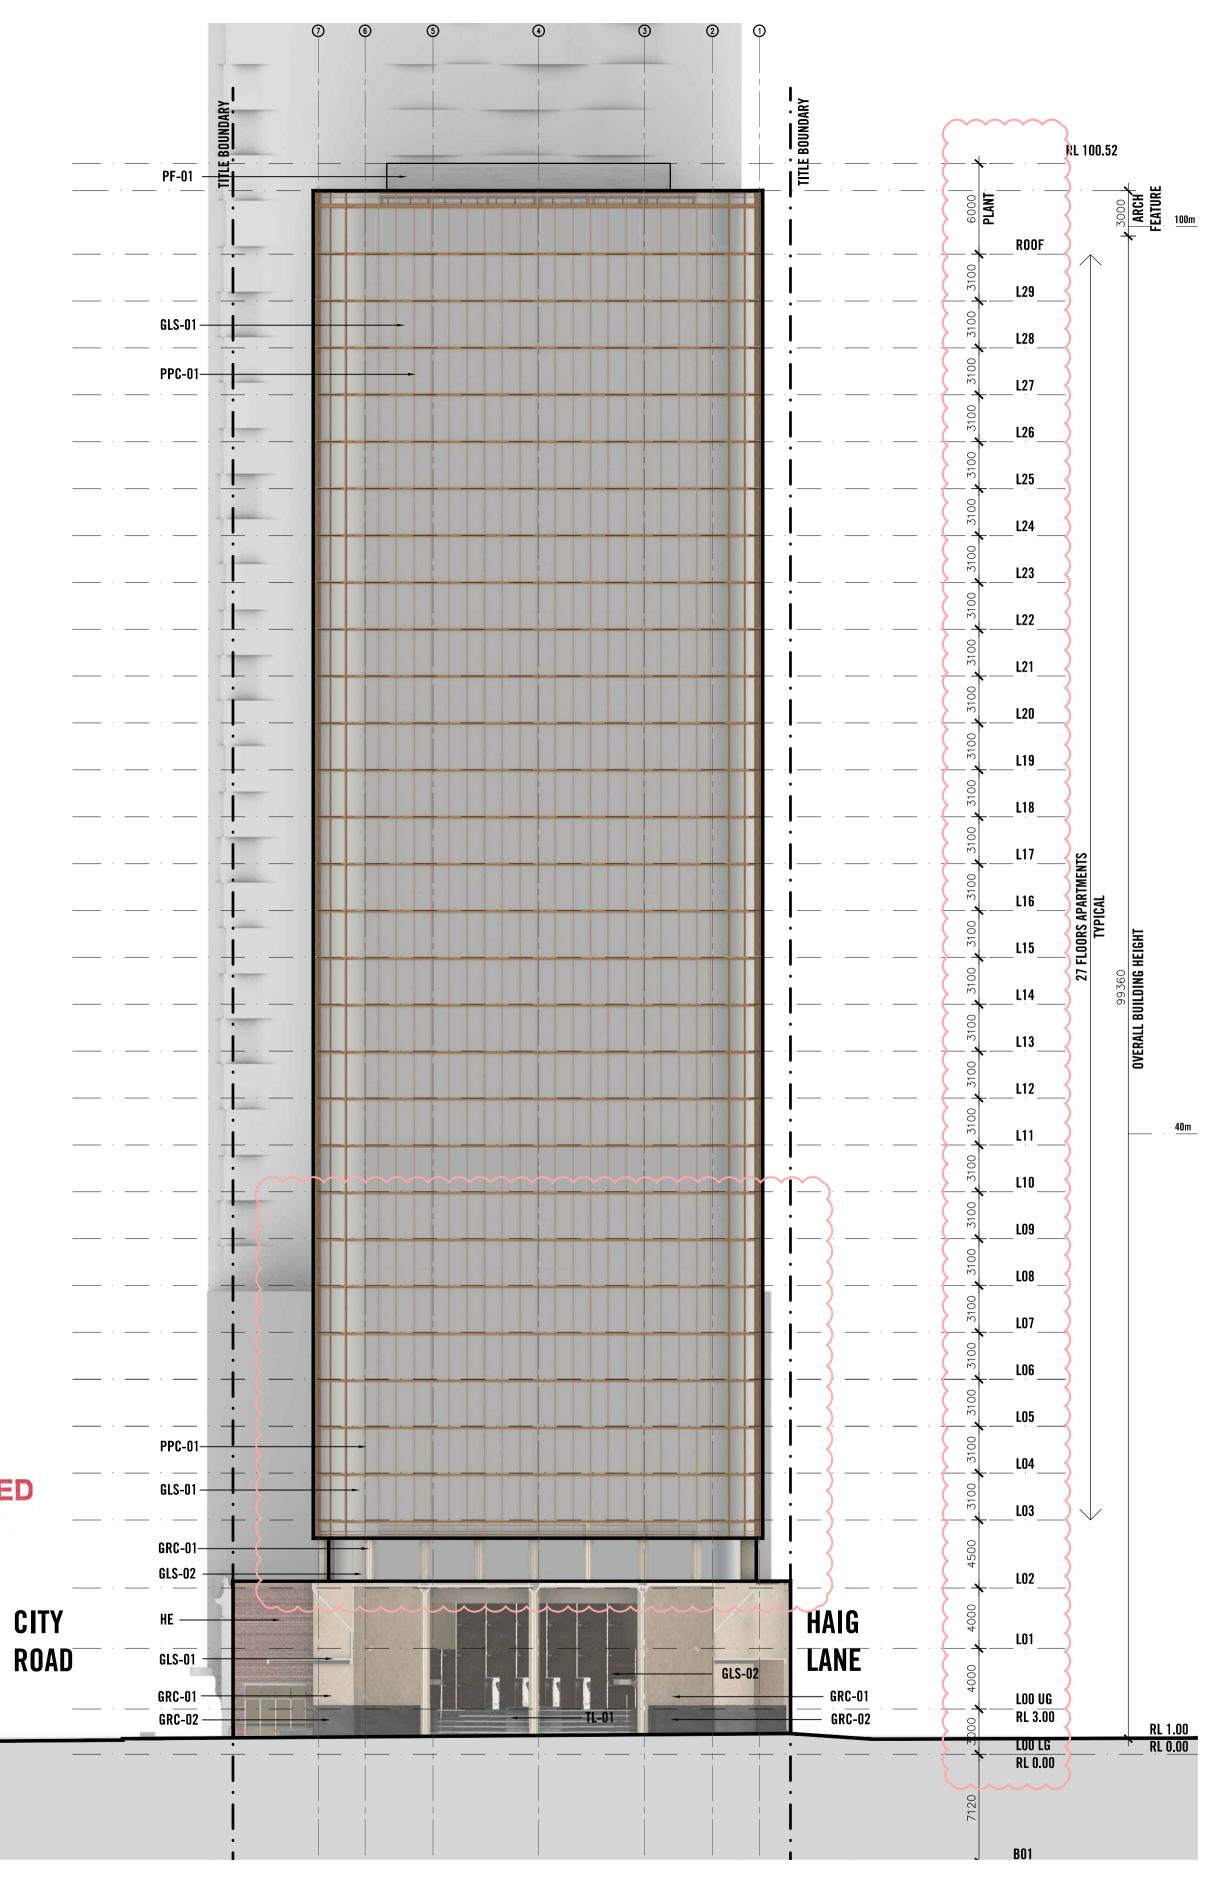


Conditions of Use Conditions of Use This document may only be used as permitted by the terms of the Consultancy Agreement and for the purposes and stages of the Project for which it has been prepared and delivered by Elenberg Fraser; and by authorized persons who agree to these conditions. Subject only to the Consultancy Agreement: 1. this document and all intellectual property rights in it remain the property of Elenberg Fraser and may not be changed, used, reproduced, provided or disclosed by or to any person without the written consent of Elenberg Fraser, and only then with clear identification of Elenberg Fraser as author and owner and of all changes made. 2. each user must: (a) not scale any drawing, use figured dimensions only and verify all dimensions; (b) a conjugate the comparet is conjugate with all other relevant Brainst documents provide that and SCALE@A1 1:250 Project Title **ELENBERG FRASER** 300 CI1 SCALE@A3 1:500 \frown LEVEL 1, 160 QUEEN STREET SOUTHI MELBOURNE VICTORIA 3000 AUSTRALIA (a) not scale any drawing, use figured dimensions only and verify all dimensions;
(b) only use this document in conjunction with all other relevant Project documents, specifications and information from any person;
(c) where this document is issued in electronic form, make all appropriate electronic data, systems and document checks and comply with all third party proprietary software requirements;
(d) properly form their own opinion as to the correctness and sufficiency of the document for their purposes and notify Elenberg Fraser immediately upon becoming aware of any issue;
3. to the maximum extent permitted by law, all conditions and warranties concerning this document are expressly excluded and each user accepts fully and will appropriately insure for all risks and releases and indemnifies Elenberg Fraser from and against all claims, liabilities, loss, costs and expenses arising out of or in connection with any use, reliance upon, reproduction or disclosure of or change to this document. PRELIMINARY Client TEL +61 3 9600 2260 FAX +61 3 9600 2266 IMG **NOT FOR CONSTRUCTION** EMAIL MAIL@ELENBERGFRASER.COM WWW.ELENBERGFRASER.COM Figured dimensions take precedence to scale readings. Verify all dimensions on site. ABN 97 556 188 726 Report any discrepancies to the Architect for decision before proceeding with the work. Copyright 🕲



	Drawing Title		
ITY ROAD	EAST ELEVATION		
IBANK	CLARKE STREET		
	Project Number	Drawing Number	
	17155	A0902	
	Drawing Status	Revision	
	TP	Μ	

ADVERTISED PLAN

Rev No.	Date	Reason for issue	Issued by	Rev No.	Date	Reason for issue	Issued by	Rev No.	Date	Reason for issue	Issued by	Со
Α	08.11.19	ISSUED FOR INFORMATION AND COORDINATION	MN									i str
В	08.11.19	ISSUED FOR INFORMATION AND COORDINATION	MN									wh
C	27.11.19	ISSUED FOR TOWN PLANNING	RM									1.
D	03.04.20	ISSUED FOR TOWN PLANNING RFI	AM									l
E	29.05.20	ISSUED FOR TOWN PLANNING RFI	MN									2.
F	11.12.20	ISSUED FOR TOWN PLANNING RFI	MS									l
G	06.05.21	ISSUED FOR TOWN PLANNING RFI	RM									l
H	24.06.21	ISSUED FOR TOWN PLANNING RFI	RM									l
I	05.05.22	ISSUED FOR TP ENDORSEMENT - INFO & COORDINATION	RM									l
J	05.08.22	ISSUED FOR TP ENDORSEMENT RFI	RM									l
K	02.09.22	ISSUED FOR TP AMENDMENT	DH									l
L	20.07.23	ISSUED FOR TP AMENDMENT	DH									3
М	21.11.23	ISSUED FOR TP AMENDMENT	DH									1
М	21.11.23	ISSUED FOR TP AMENDMENT	DH									

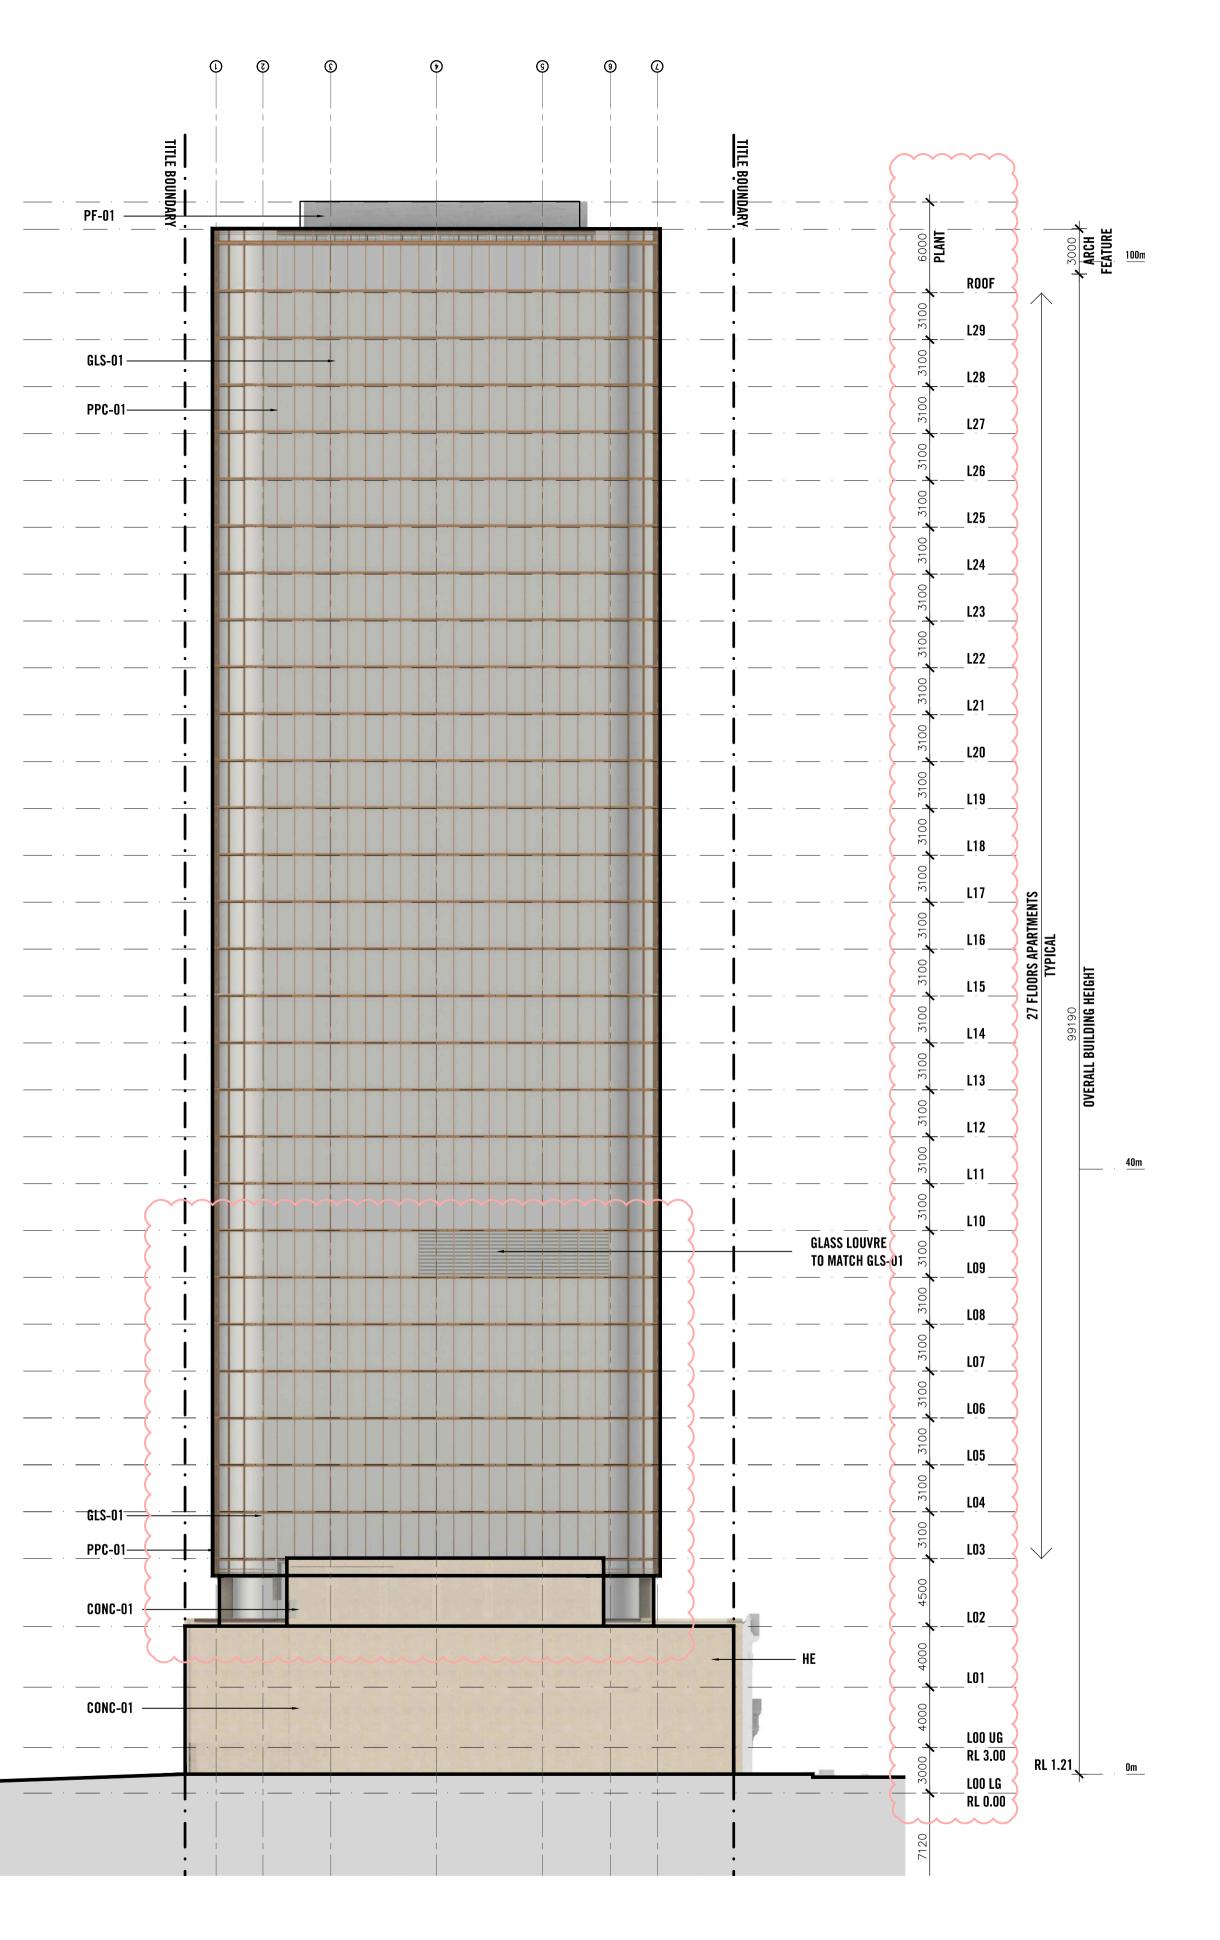

 Conditions of Use
 This document may only be used as permitted by the terms of the Consultancy Agreement and for the purposes and stages of the Project for which it has been prepared and delivered by Elenberg Fraser; and by authorized persons who agree to these conditions. Subject only to the Consultancy Agreement:
 1. this document and all intellectual property rights in it remain the property of Elenberg Fraser and may not be changed, used, reproduced, provided or disclosed by or to any person without the written consent of Elenberg Fraser, and only then with clear identification of Elenberg Fraser as author and owner and of all changes made.
 2. each user must: (a) not scale any drawing, use figured dimensions only and verify all dimensions; (a) not scale any drawing, use figured dimensions only and verify all dimensions;
(b) only use this document in conjunction with all other relevant Project documents, specifications and information from any person;
(c) where this document is issued in electronic form, make all appropriate electronic data, systems and document checks and comply with all third party proprietary software requirements;
(d) properly form their own opinion as to the correctness and sufficiency of the document for their purposes and notify Elenberg Fraser immediately upon becoming aware of any issue;
3. to the maximum extent permitted by law, all conditions and warranties concerning this document are expressly excluded and each user accepts fully and will appropriately insure for all risks and releases and indemnifies Elenberg Fraser from and against all claims, liabilities, loss, costs and expenses arising out of or in connection with any use, reliance upon, reproduction or disclosure of or change to this document.


SCALE@A1 1:250 SCALE@A3 1:500

PRELIMINARY **NOT FOR CONSTRUCTION** Figured dimensions take precedence to scale readings. Verify all dimensions on site. Report any discrepancies to the Architect for decision before proceeding with the work. **ELENBERG FRASER**

LEVEL 1, 160 QUEEN STREET MELBOURNE VICTORIA 3000 AUSTRALIA TEL +61 3 9600 2260 FAX +61 3 9600 2266 EMAIL MAIL@ELENBERGFRASER.COM WWW.ELENBERGFRASER.COM ABN 97 556 188 726



Project Title 300 CITY ROAD SOUTHBANK	Drawing Title WEST ELEVATION			
Client	Project Number 17155 Drawing Status	Drawing Number A0903 Revision		
	TP	Μ		

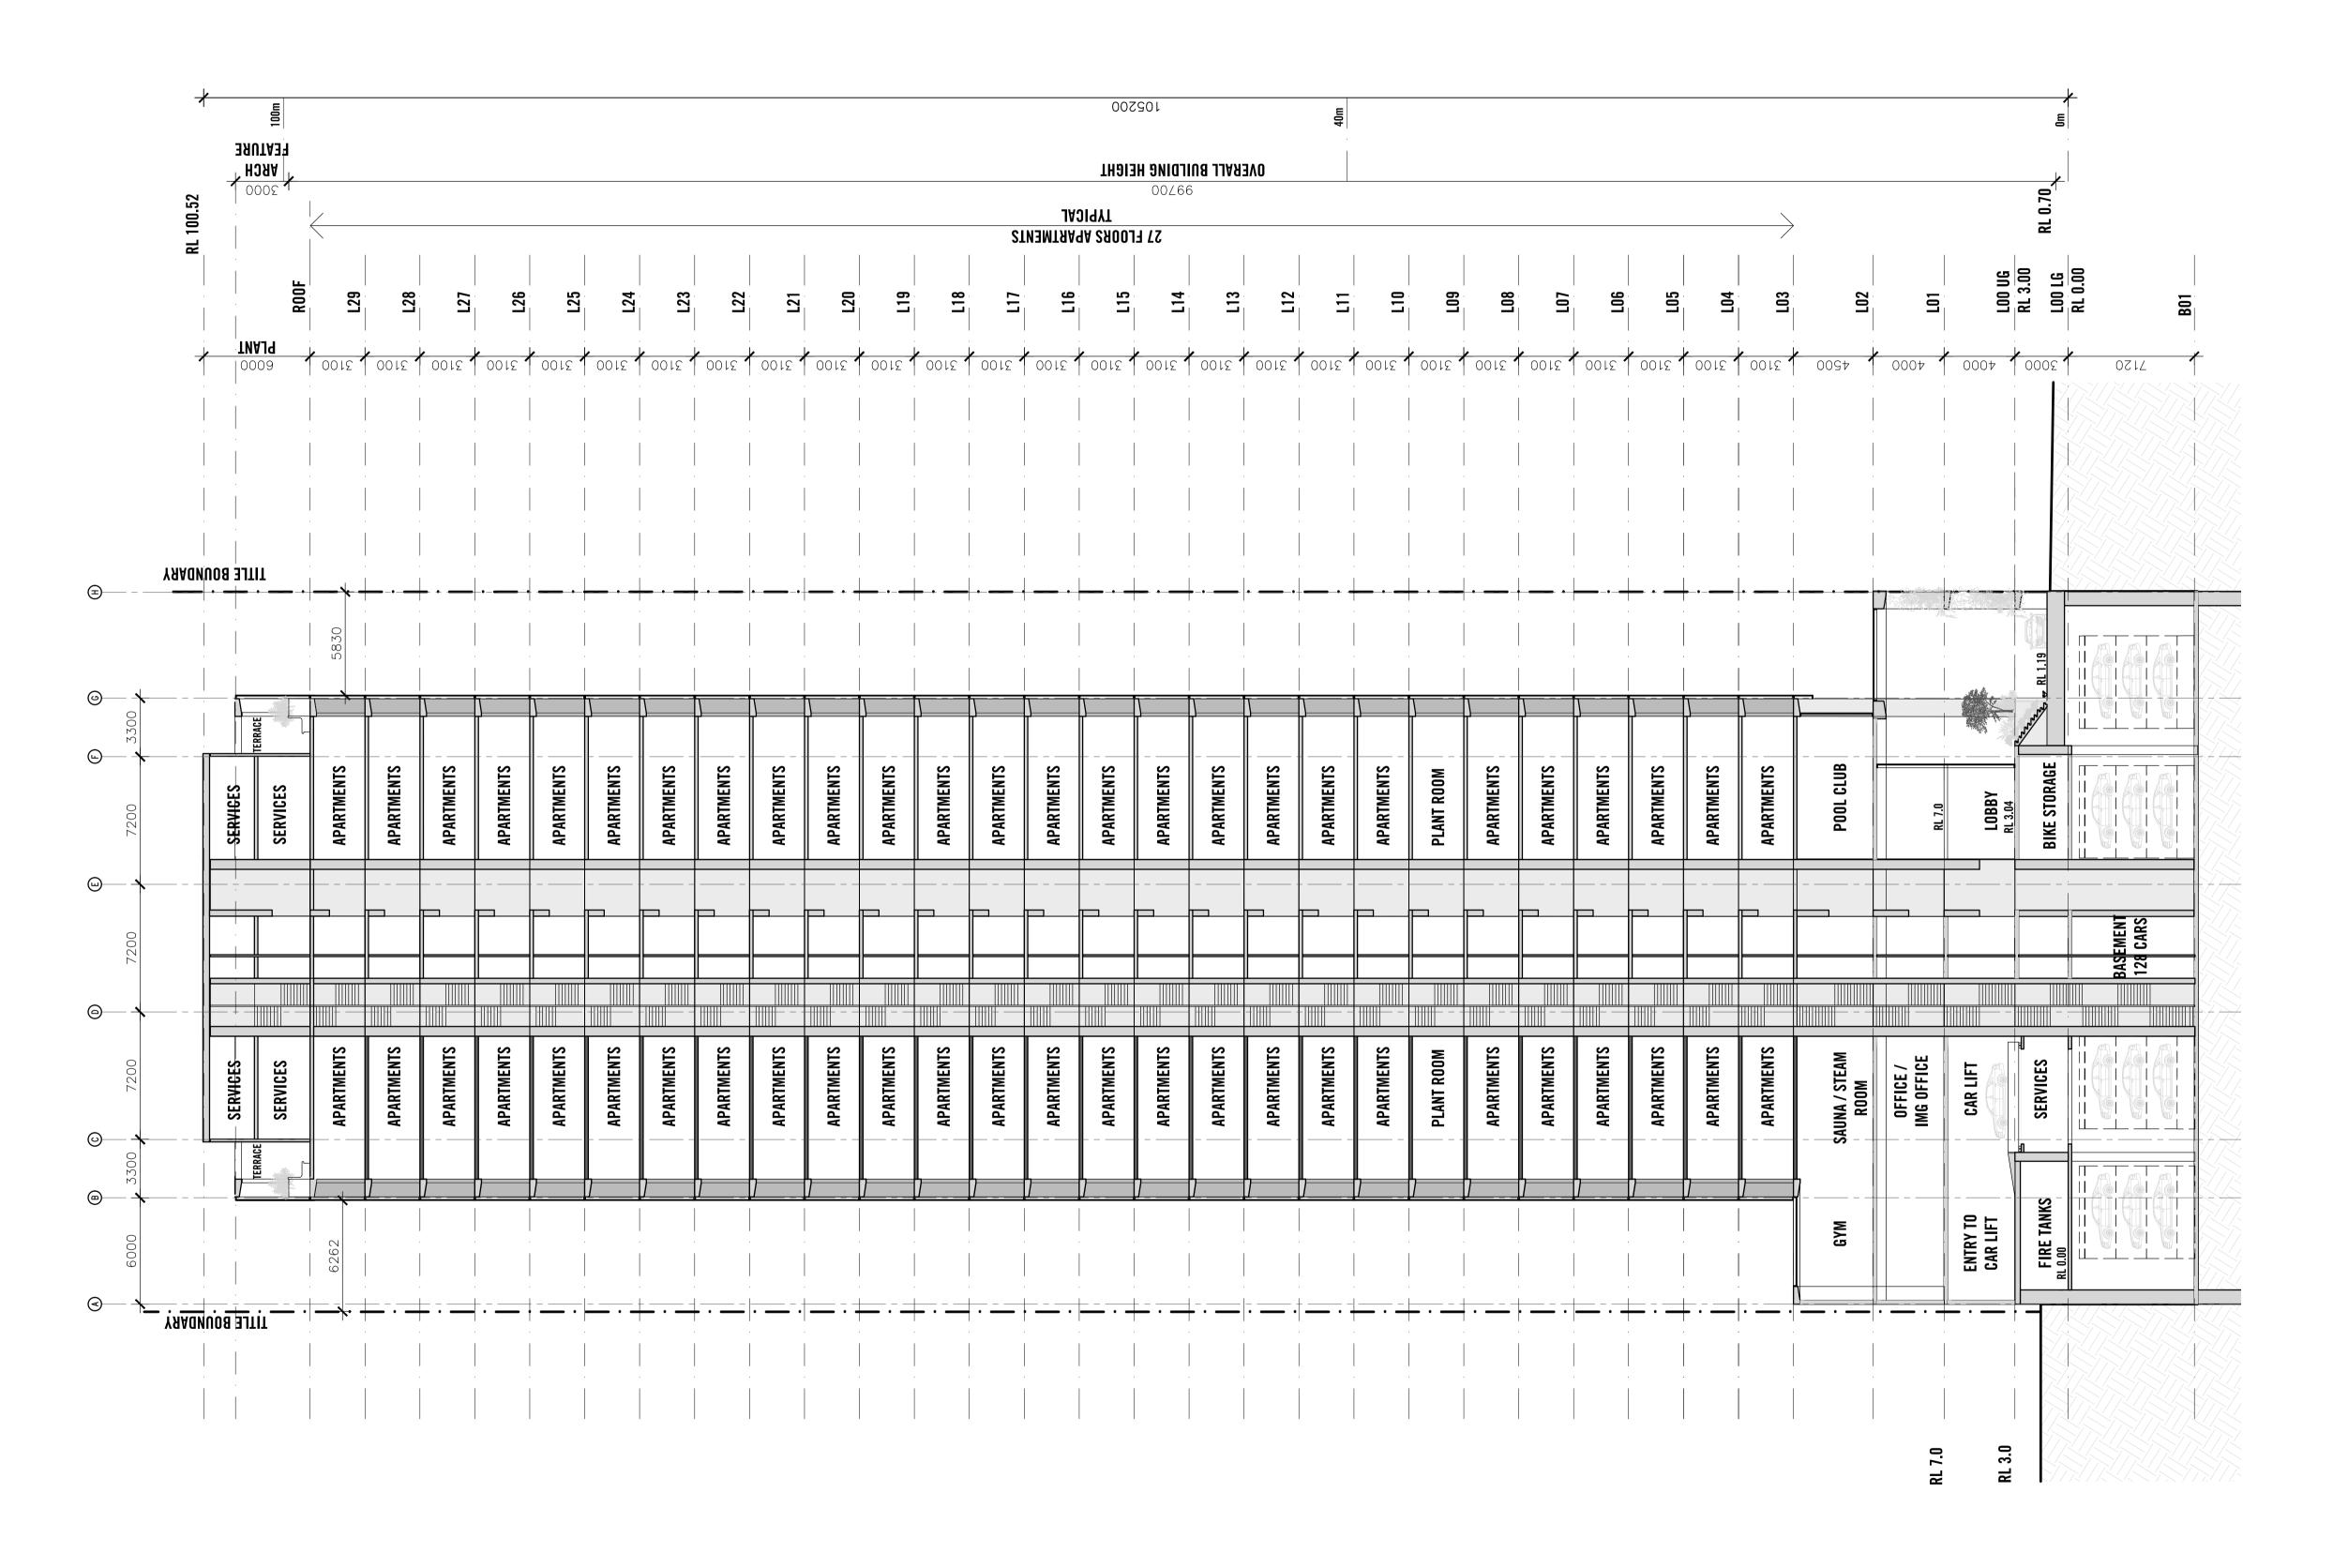

Date	Reason for issue	Issued by	Rev No.	Date	Reason for issue	Issued by	Rev No.	Date	Reason for issue
20.07.23 21.11.23	ISSUED FOR TP AMENDMENT ISSUED FOR TP AMENDMENT	DH Dh							

Rev No.



Issued by Conditions of Use This document may only be used as permitted by the terms of the Consultancy Agreement and for the purposes and stages of the Project for which it has been prepared and delivered by Elenberg Fraser; and by authorized persons who agree to these conditions. Subject only to the Consultancy Agreement: who agree to these conductors, subject only to the consultancy Agreement.

 this document and all intellectual property rights in it remain the property of Elenberg Fraser and may not be changed, used, reproduced, provided or disclosed by or to any person without the written consent of Elenberg Fraser, and only then with clear identification of Elenberg Fraser as author and owner and of all changes made. 2. each user must: (a) not scale any drawing, use figured dimensions only and verify all dimensions; (b) only use this document in conjunction with all other relevant Project documents, specifications and information from any person; information from any person;
(c) where this document is issued in electronic form, make all appropriate electronic data, systems and document checks and comply with all third party proprietary software requirements;
(d) properly form their own opinion as to the correctness and sufficiency of the document for their purposes and notify Elenberg Fraser immediately upon becoming aware of any issue;
3. to the maximum extent permitted by law, all conditions and warranties concerning this document are expressly excluded and each user accepts fully and will appropriately insure for all risks and releases and indemnifies Elenberg Fraser from and against all claims, liabilities, loss, costs and expenses arising out of or in connection with any use, reliance upon, reproduction or disclosure of or change to this document.


SCALE@A1 1:250 SCALE@A3 1:500



ELENBERG FRASER

LEVEL 1, 160 QUEEN STREET MELBOURNE VICTORIA 3000 AUSTRALIA TEL +61 3 9600 2260 FAX +61 3 9600 2266 EMAIL MAIL@ELENBERGFRASER.COM WWW.ELENBERGFRASER.COM ABN 97 556 188 726

Project Title IMG

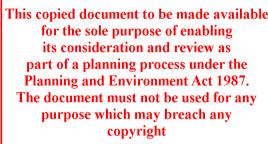


300 CITY ROAD SOUTHBANK

SECTION A-A

Drawing Title

Project Number 17155 Drawing Status TP


Drawing Number A0950 Revision Nov 27, 2023 – 4:01pm

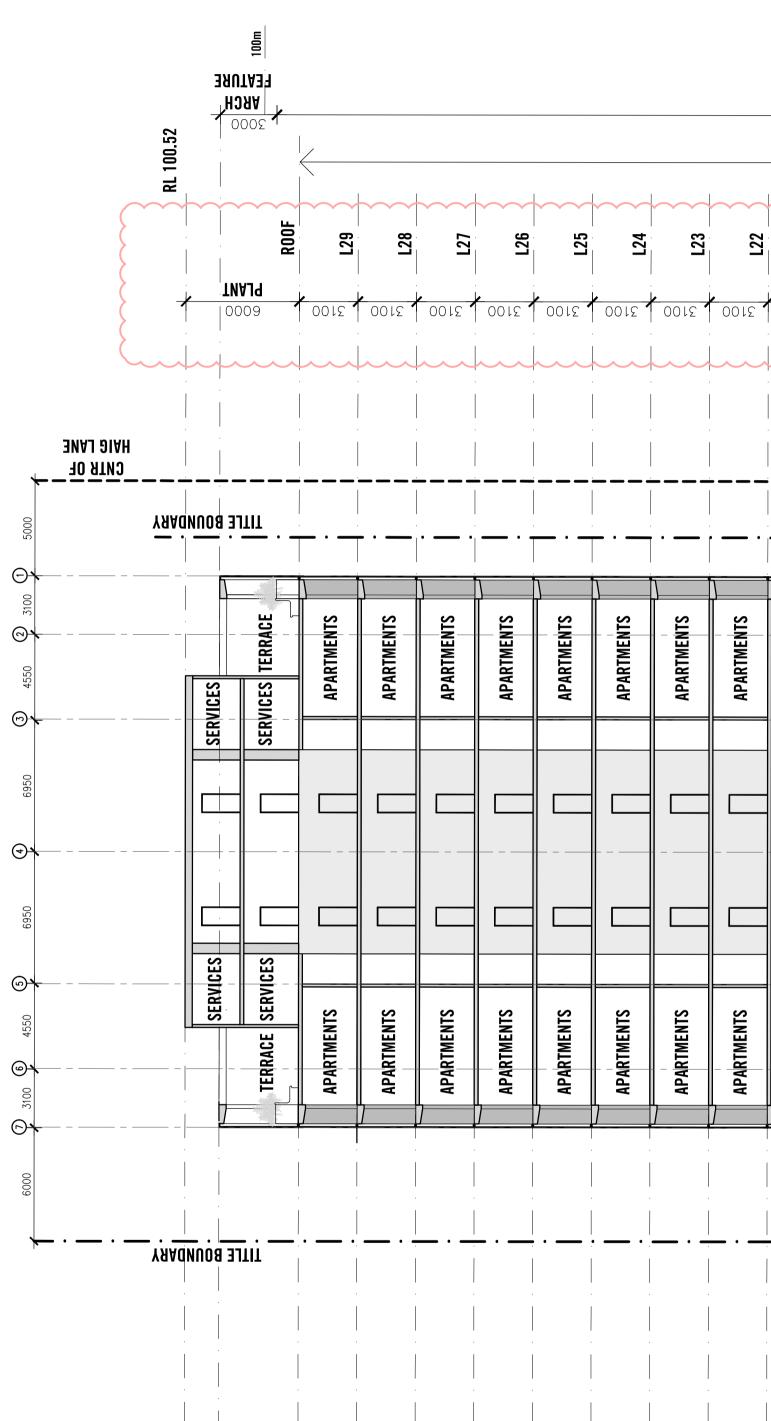


Rev No.	Date	Reason for issue		Rev No.	Date	Reason for issue	Issued by	Rev No.	Date	Reason for issue	Issu	ued by T
A	21.11.23	ISSUED FOR TP AMENDMENT	DH									S W
												1
												2
												3



											40m										
						٦₩	TYPIC	1H 9NIOT 09266		ΟΛΕ											
\rightarrow	~~~~				SI			5 <u>7</u> FI	~~~~		~~~~	~~~~	~~~~	~~~~	~~~~	~~~~		~~~~	\rightarrow	~~~~	
	L21	L20	L19	L18	L17	L16	L15	L14	L13	L12	11	L10	601	801	L07	90T	L05	L04	ro3	L02	Ļ
	2100	2100	2100	2100	0012	0012	0012	2100	2100	2100	2100	2100	2100	2100	2100	2100	2100	2100	2100	+200	2
		~~~										••••	••••	~~~				~~~		·····	
:   								· · · ·		· · ·		$\sum$		~~~~			~~~~	~~~~	~~~	~~~~	
	· _			· ·					• •		_ • _		• •		<u>ияа</u> йио	8 JTIS		· ·			f
	 }					)	)		)	)				\		\		)			
	APARTMENTS	APARTMENTS	APARTMENTS	APARTMENTS	APARTMENTS	APARTMENTS	APARTMENTS	APARTMENTS	APARTMENTS	APARTMENTS	APARTMENTS	<b>APARTMENTS</b>	APARTMENTS	APARTMENTS	APARTMENTS	APARTMENTS	APARTMENTS	APARTMENTS	APARTMENTS	WX	ļ
	API	API	API	API	API	API	API	API	AP/	AP/	AP/	AP	AP/	AP	AP/	AP	APA	APA	APA	РООГ / GYM	T
=		=																			
	s	s	S	S	S	S	S	S			s			s			S			URANT	
=	APARTMENTS	APARTMENTS	APARTMENTS	APARTMENTS	APARTMENTS	APARTMENTS	APARTMENTS	APARTMENTS	APARTMENTS	APARTMENTS	APARTMENTS	APARIMENTS	APARTMENTS	APARTMENTS	APARTMENTS	APARTMENTS	APARTMENTS	APARTMENTS	APARTMENTS	BAR / RESTAURANT	-
	AI	AI	AI	AI	A	AF	AF	AF	AF	AF	PE		<b>AF</b>	AF	AF	<b>AF</b>	AF	AF	¥		
	· · · · · · · · · · · · · · · · · · ·				· · · · · · · · · · · · · · · · · · ·				·     				·     		·     		 	·   		GARDEN TERRACE	
	- • , 	• •	. <b></b> • -	 	•	· ·	• • ;	•	 	<b>- ·</b>	• •			<b></b>	YAAONU VNDARY	SITE BO	•	 •	- •	•	l
					· · · ·	· · ·														+	·

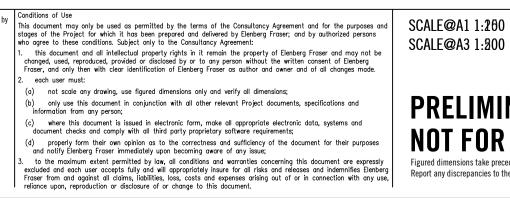

SCALE@A3 1:200

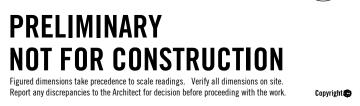


 $\frown$ 

**ELENBERG FRASER** 

LEVEL 1, 160 QUEEN STREET MELBOURNE VICTORIA 3000 AUSTRALIA TEL +61 3 9600 2260 FAX +61 3 9600 2266 EMAIL MAIL@ELENBERGFRASER.COM WWW.ELENBERGFRASER.COM ABN 97 556 188 726

IMG

Project Title

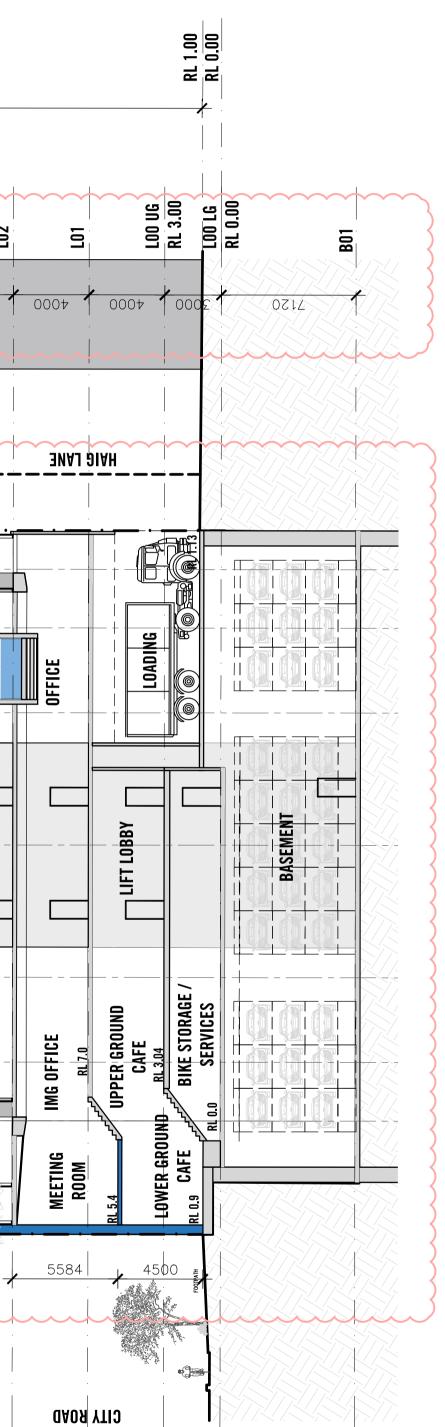

**300 CITY ROAD** SOUTHBANK

Drawing Title **SECTION B-B** 

#### Project Number 17155 Drawing Status TP

Drawing Number A0951 Revision Nov 27, 2023 - 8:58pm



Rev No.	Date	Reason for issue	Issued by	Rev No.	Date	Reason for issue	Issued by	Rev No.	Date	Reason for issue	Issued by	Co
F G H I	11.12.20 06.05.21 05.08.22 23.06.23	ISSUED FOR TOWN PLANNING RFI ISSUED FOR TOWN PLANNING RFI ISSUED FOR TP ENDORSEMENT RFI ISSUED FOR TP ENDORSEMENT RFI	MS RM RM DH									sto wh 1. f 2.
												1
												3. F r





02 3D DETAIL RENDER

Conditions of Use This document may only be used as permitted by the terms of the Consultancy Agreement and for the purposes and stages of the Project for which it has been prepared and delivered by Elenberg Fraser; and by authorized persons who agree to these conditions. Subject only to the Consultancy Agreement: 1. this document and all intellectual property rights in it remain the property of Elenberg Fraser and may not be changed, used, reproduced, provided or disclosed by or to any person without the written consent of Elenberg Fraser, and only then with clear identification of Elenberg Fraser as author and owner and of all changes made. 2. each user must: (a) not scale any drawing use figured dimensions only and verify all dimensions:

(a) not scale any drawing, use figured dimensions only and verify all dimensions;
(b) only use this document in conjunction with all other relevant Project documents, specifications and information from any person;
(c) where this document is issued in electronic form, make all appropriate electronic data, systems and document checks and comply with all third party proprietary software requirements;
(d) properly form their own opinion as to the correctness and sufficiency of the document for their purposes and notify Elenberg Fraser immediately upon becoming aware of any issue;
3. to the maximum extent permitted by law, all conditions and warraties concerning this document are expressly excluded and each user accepts fully and will appropriately insure for all risks and releases and indemnifies Elenberg Fraser from and against all claims, liabilities, loss, costs and expenses arising out of or in connection with any use, reliance upon, reproduction or disclosure of or change to this document.

SCALE@A1 1:100 SCALE@A3 1:200

PRELIMINARY NOT FOR CONSTRUCTION Figured dimensions take precedence to scale readings. Verify all dimensions on site. Report any discrepancies to the Architect for decision before proceeding with the work.

Ĩ

**ELENBERG FRASER** 

LEVEL 1, 160 QUEEN STREET MELBOURNE VICTORIA 3000 AUSTRALIA TEL +61 3 9600 2260 FAX +61 3 9600 2266 EMAIL MAIL@ELENBERGFRASER.COM WWW.ELENBERGFRASER.COM ABN 97 556 188 726 300 C SOUT Client IMG

Project Title

	Drawing Title	
TY ROAD	HERITAGE FACADE	OPENING DETAIL
IBANK		
	Project Number	Drawing Number
	17155	A1102
	Drawing Status	Revision
	TP	I
		Jun 22, 2023 – 7:48pm







Issued by Conditions of Use This document may only be used as permitted by the terms of the Consultancy Agreement and for the purposes and stages of the Project for which it has been prepared and delivered by Elenberg Fraser; and by authorized persons who agree to these conditions. Subject only to the Consultancy Agreement: 1. this document and all intellectual property rights in it remain the property of Elenberg Fraser and may not be changed, used, reproduced, provided or disclosed by or to any person without the written consent of Elenberg Fraser, and only then with clear identification of Elenberg Fraser as author and owner and of all changes made. each user must: (a) not scale any drawing, use figured dimensions only and verify all dimensions;

 (b) only use this document in conjunction with all other relevant Project documents, specifications and information from any person; (c) where this document is issued in electronic form, make all appropriate electronic data, systems and document checks and comply with all third party proprietary software requirements;
(d) properly form their own opinion as to the correctness and sufficiency of the document for their purposes and notify Elenberg Fraser immediately upon becoming aware of any issue;
3. to the maximum extent permitted by law, all conditions and warranties concerning this document are expressly excluded and each user accepts fully and will appropriately insure for all risks and releases and indemnifies Elenberg Fraser from and against all claims, liabilities, loss, costs and expenses arising out of or in connection with any use, reliance upon, reproduction or disclosure of or change to this document.

SCALE@A1 1:100 SCALE@A3 1:200





## **ELENBERG FRASER**

LEVEL 1, 160 QUEEN STREET MELBOURNE VICTORIA 3000 AUSTRALIA TEL +61 3 9600 2260 FAX +61 3 9600 2266 EMAIL MAIL@ELENBERGFRASER.COM WWW.ELENBERGFRASER.COM ABN 97 556 188 726

Project Title 300 SOL Client IMG

3	Drawing Title	
) CITY ROAD	ELEMENTAL DETAIL	
JTHBANK	PORTAL THROUGHL	INK DETAIL
	Project Number	Drawing Number
	17155	A1103
	Drawing Status	Revision
	TP	K
		Nov 27, 2023 - 9:07pm



Rev No.	Date	Reason for issue
-	1.12.20 06.05.21	ISSUED FOR TOWN PLANNING RFI Issued for town planning rfi
-	15.08.22	ISSUED FOR TP ENDORSEMENT RFI
	0.03.23	ISSUED FOR TP ENDORSEMENT RFI
J	23.06.23	ISSUED FOR TP ENDORSEMENT RFI

	This copied document to be made available
	for the sole purpose of enabling
	its consideration and review as
	part of a planning process under the
I	Planning and Environment Act 1987.
I	The document must not be used for any
I	purpose which may breach any
I	copyright

Issued by

Issued by Rev No. Date Reason for issue

RN RN

DH

ev No.	Date	Reason for issue	Issued by



ad by
Conditions of Use
This document may only be used as permitted by the terms of the Consultancy Agreement and for the purposes and swho agree to these conditions. Subject only to the Consultancy Agreement:
1. this document and all intellectual property rights in it remain the property of Elenberg Fraser and may not be changed, used, reproduced, provided or disclosed by or to any person without the writtle consent of Elenberg Fraser and may not be changed, used, terproduced, provided or disclosed by or to any person without the writtle consent of Elenberg Fraser and may not be changed, used, terproduced, provided or disclosed by or to any person without the writtle consent of Elenberg Fraser and may not be changed used, terproduced, provided or disclosed by or to any person without the writtle consent of Elenberg Fraser and may not be changed used, terproduced, provided or disclosed by or to any person.
(a) not scale any drawing, use figured dimensions only and verify all dimensions;
(b) only use this document is issued in electronic form, make all appropriate electronic data, systems and document checks and comply with all third party proprietary software requirements;
(c) where this document is allociency of any issue;
(d) properly form their own opinion as to the correctness and sufficiency of the document for their purposes and notify Elenberg Fraser immediately upon becoming aware of any issue;
(e) to the maximum extent permitted by law, all conditions and warranties concerning this document are expressly excluded and each user accepts fully and will appropriately insure for all risks and releases and indemnifies Elenberg Fraser from on dagoinst all claims, liabilities, loss, costs and expenses arising aut of or in connection with any use, relarce upon, reproduction or disclosure of or change to this document.

**ELENBERG FRASER** 

LEVEL 1, 160 QUEEN STREET MELBOURNE VICTORIA 3000 AUSTRALIA TEL +61 3 9600 2260 FAX +61 3 9600 2266 EMAIL MAIL@ELENBERGFRASER.COM WWW.ELENBERGFRASER.COM ABN 97 556 188 726

Project Title 300 SOUT Client IMG

	Drawing Title	
CITY ROAD	THROUGH LINK CAN	NOPY DETAIL
THBANK		
	Project Number	Drawing Number
	17155	A1104
	Drawing Status	Revision
	TP	J
		Nov 27, 2023 – 9:09pm



01 _

3D DETAIL RENDER

Rev No.	Date	Reason for issue	Issued by	Rev No.	Date	Reason for issue	Issued by	Rev No.	Date	Reason for issue	Issued by	C T
A B C	10.03.23 23.06.23 27.11.23	ISSUED FOR TP ENDORSEMENT RFI ISSUED FOR TP ENDORSEMENT RFI ISSUED FOR TP ENDORSEMENT RFI	DH Dh Dh									s w 1.
												2
												3



^y Conditions of Use This document may only be used as permitted by the terms of the Consultancy Agreement and for the purposes and stages of the Project for which it has been prepared and delivered by Elenberg Fraser; and by authorized persons who agree to these conditions. Subject only to the Consultancy Agreement: 1. this document and all intellectual property rights in it remain the property of Elenberg Fraser and may not be changed, used, reproduced, provided or disclosed by or to any person without the written consent of Elenberg Fraser, and only then with clear identification of Elenberg Fraser as author and owner and of all changes made. 2. each user must: (a) not scale any drawing, use figured dimensions only and verify all dimensions; (b) only use this document in conjunction with all other relevant Project documents, specifications and

(a) not scale any drawing, use figured dimensions only and verify all dimensions;
(b) only use this document in conjunction with all other relevant Project documents, specifications and information from any person;
(c) where this document is issued in electronic form, make all appropriate electronic data, systems and document checks and comply with all third party proprietary software requirements;
(d) properly form their own opinion as to the correctness and sufficiency of the document for their purposes and notify Elenberg Fraser immediately upon becoming aware of any issue;
3. to the maximum extent permitted by law, all conditions and warranties concerning this document are expressly excluded and each user accepts fully and will appropriately insure for all risks and releases and indemnifies Elenberg Fraser from and against all claims, liabilities, loss, costs and expenses arising out of or in connection with any use, reliance upon, reproduction or disclosure of or change to this document.

SCALE@A1 1:100 SCALE@A3 1:200



Figured dimensions take precedence to scale readings. Verify all dimensions on site. Report any discrepancies to the Architect for decision before proceeding with the work. Copyright

Ĩ

**ELENBERG FRASER** 

LEVEL 1, 160 QUEEN STREET MELBOURNE VICTORIA 3000 AUSTRALIA TEL +61 3 9600 2260 FAX +61 3 9600 2266 EMAIL MAIL@ELENBERGFRASER.COM WWW.ELENBERGFRASER.COM ABN 97 556 188 726

IMG

Project Title

**300 CITY ROAD** SOUTHBANK


Drawing Title THROUGH LINK CANNOPY DETAIL

Project Number 17155 Drawing Status TP


Drawing Number A1105 Revision Nov 27, 2023 – 9:15pm



01 3D DETAIL RENDER

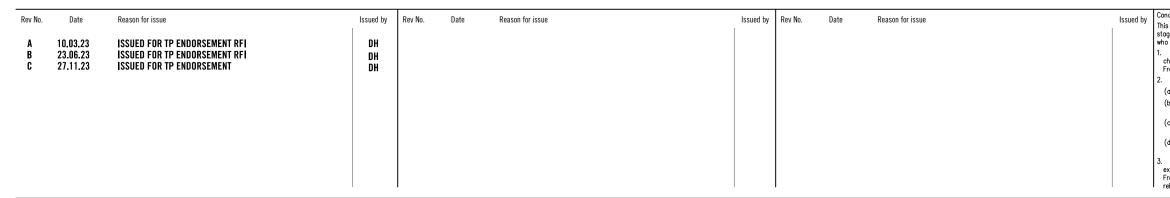



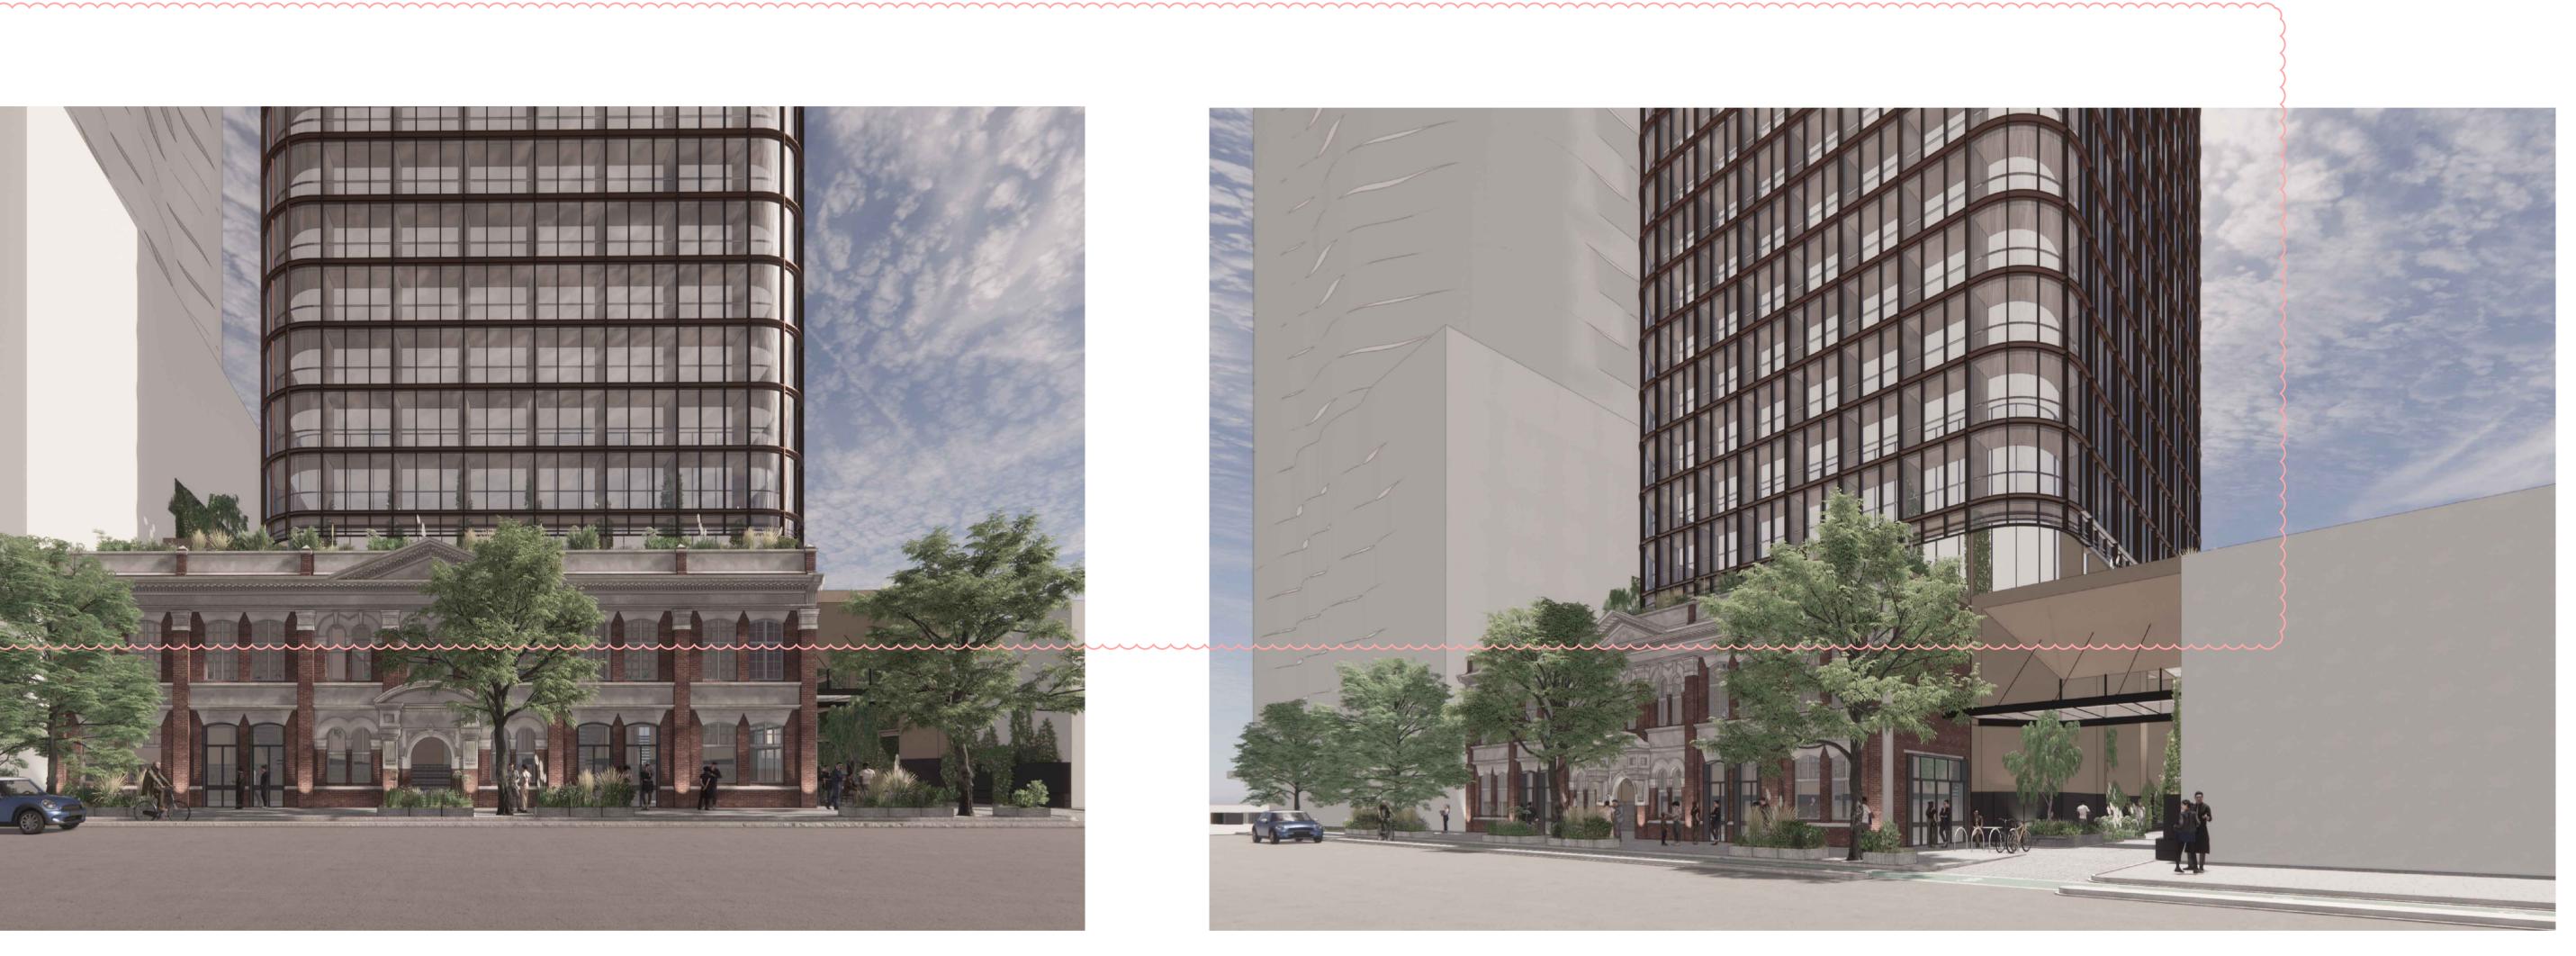

02 3D DETAIL RENDER

 $\bigcirc$ 

This copied document to be made available for the sole purpose of enabling its consideration and review as part of a planning process under the Planning and Environment Act 1987. The document must not be used for any purpose which may breach any copyright

 Issued by
 Conditions of Use

 This document may only be used as permitted by the terms of the Consultancy Agreement and for the purposes and stages of the Project for which it has been prepared and delivered by Elenberg Fraser; and by authorized persons who agree to these conditions. Subject only to the Consultancy Agreement:

 1.
 this document and all intellectual property rights in it remain the property of Elenberg Fraser and may not be changed, used, reproduced, provided or disclosed by or to any person without the written consent of Elenberg Fraser, and only then with clear identification of Elenberg Fraser as author and owner and of all changes made.

 2.
 each user must:

 (a)
 not scale any drawing, use figured dimensions only and verify all dimensions;

 (b)
 only use this document in conjunction with all other relevant Project documents, specifications and

(a) not scale any drawing, use figured dimensions only and verify all dimensions;
(b) only use this document in conjunction with all other relevant Project documents, specifications and information from any person;
(c) where this document is issued in electronic form, make all appropriate electronic data, systems and document checks and comply with all third party proprietary software requirements;
(d) properly form their own opinion as to the correctness and sufficiency of the document for their purposes and notify Elenberg Fraser immediately upon becoming aware of any issue;
3. to the maximum extent permitted by law, all conditions and warranties concerning this document are expressly excluded and each user accepts fully and will appropriately insure for all risks and releases and indemnifies Elenberg Fraser from and against all claims, liabilities, loss, costs and expenses arising out of or in connection with any use, reliance upon, reproduction or disclosure of or change to this document.

SCALE@A1 1:100 SCALE@A3 1:200

PRELIMINARY **NOT FOR CONSTRUCTION** Figured dimensions take precedence to scale readings. Verify all dimensions on site. Report any discrepancies to the Architect for decision before proceeding with the work. Copyright


#### **ELENBERG FRASER**

LEVEL 1, 160 QUEEN STREET MELBOURNE VICTORIA 3000 AUSTRALIA TEL +61 3 9600 2260 FAX +61 3 9600 2266 EMAIL MAIL@ELENBERGFRASER.COM WWW.ELENBERGFRASER.COM ABN 97 556 188 726

300 SOU[.] Client IMG


Project Title


CITY ROAD Thbank	THROUGH LINK CAN	INOPY DETAIL
	Project Number	Drawing Number
	17155	A1106
	Drawing Status	Revision
	TP	C
		Nov 27, 2023 – 9:16pm

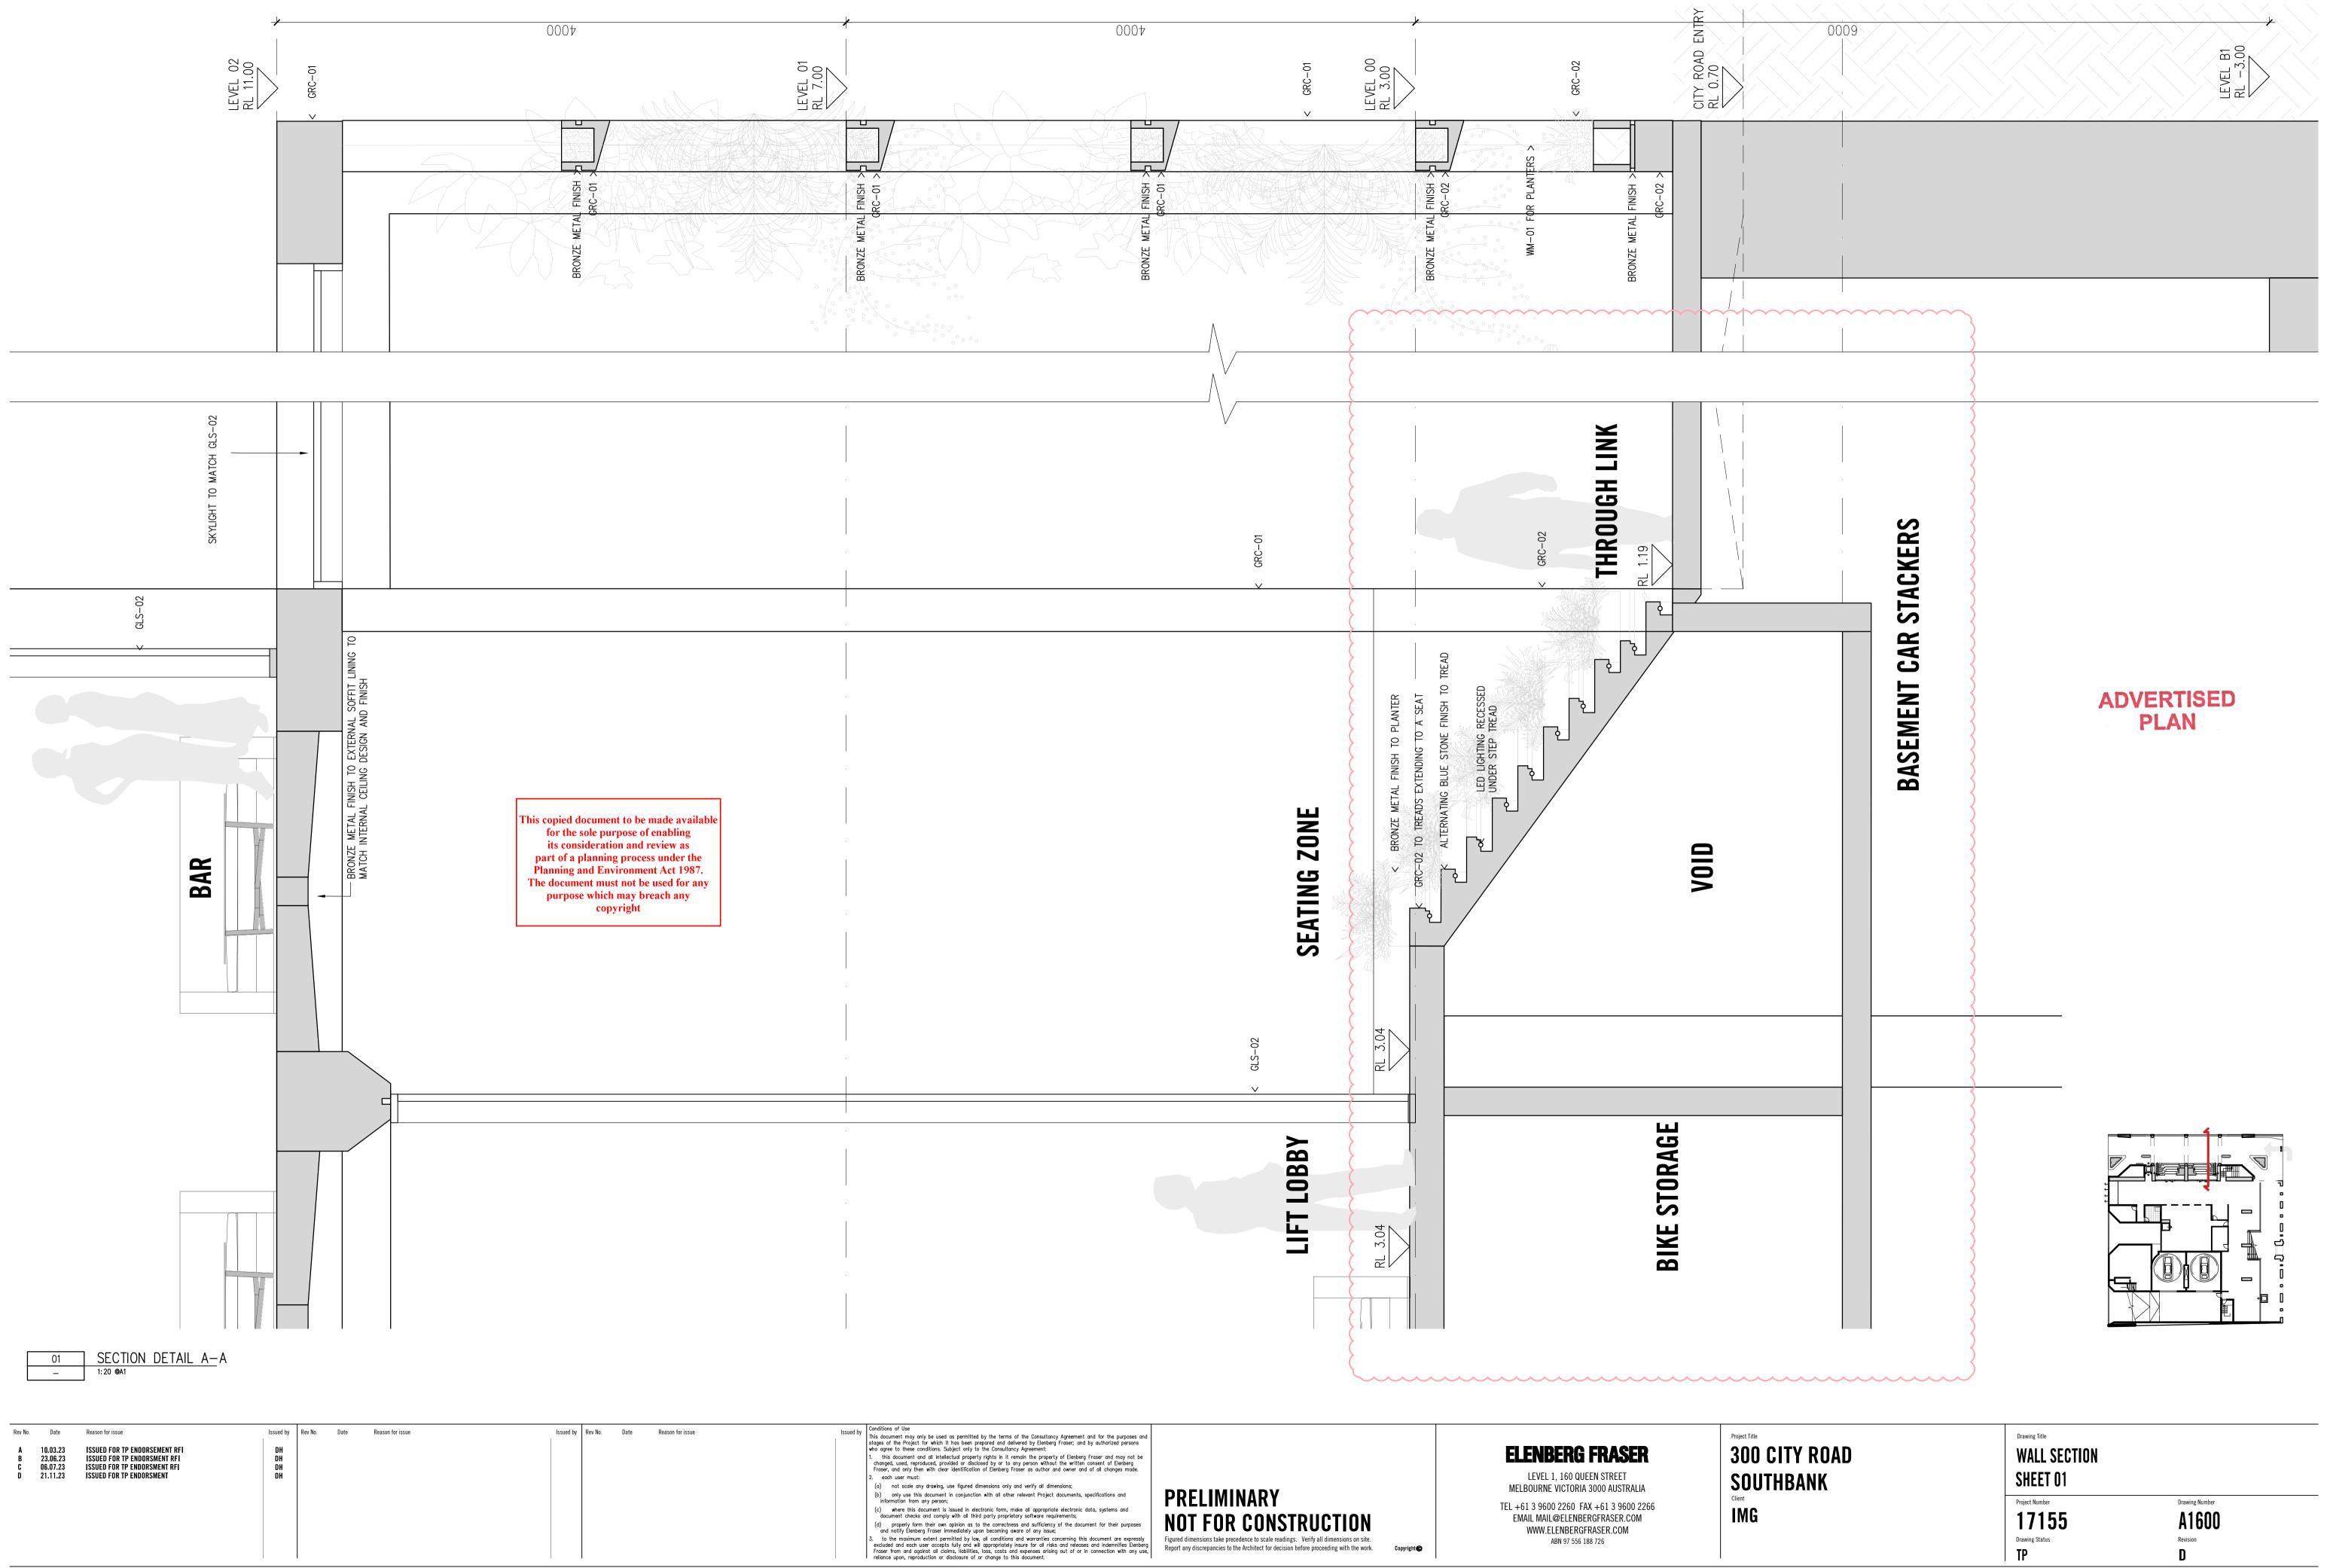

Figured dimensions take precedence to scale readings. Verify all dimensions on site. Report any discrepancies to the Architect for decision before proceeding with the work. WWW.ELENBERGFRASER.COM ABN 97 556 188 726

CITY ROAD Thbank	Drawing Title WALL SECTION SHEET 01		
	Project Number <b>17155</b> Drawing Status <b>TP</b>	Drawing Number A1600 Revision D	

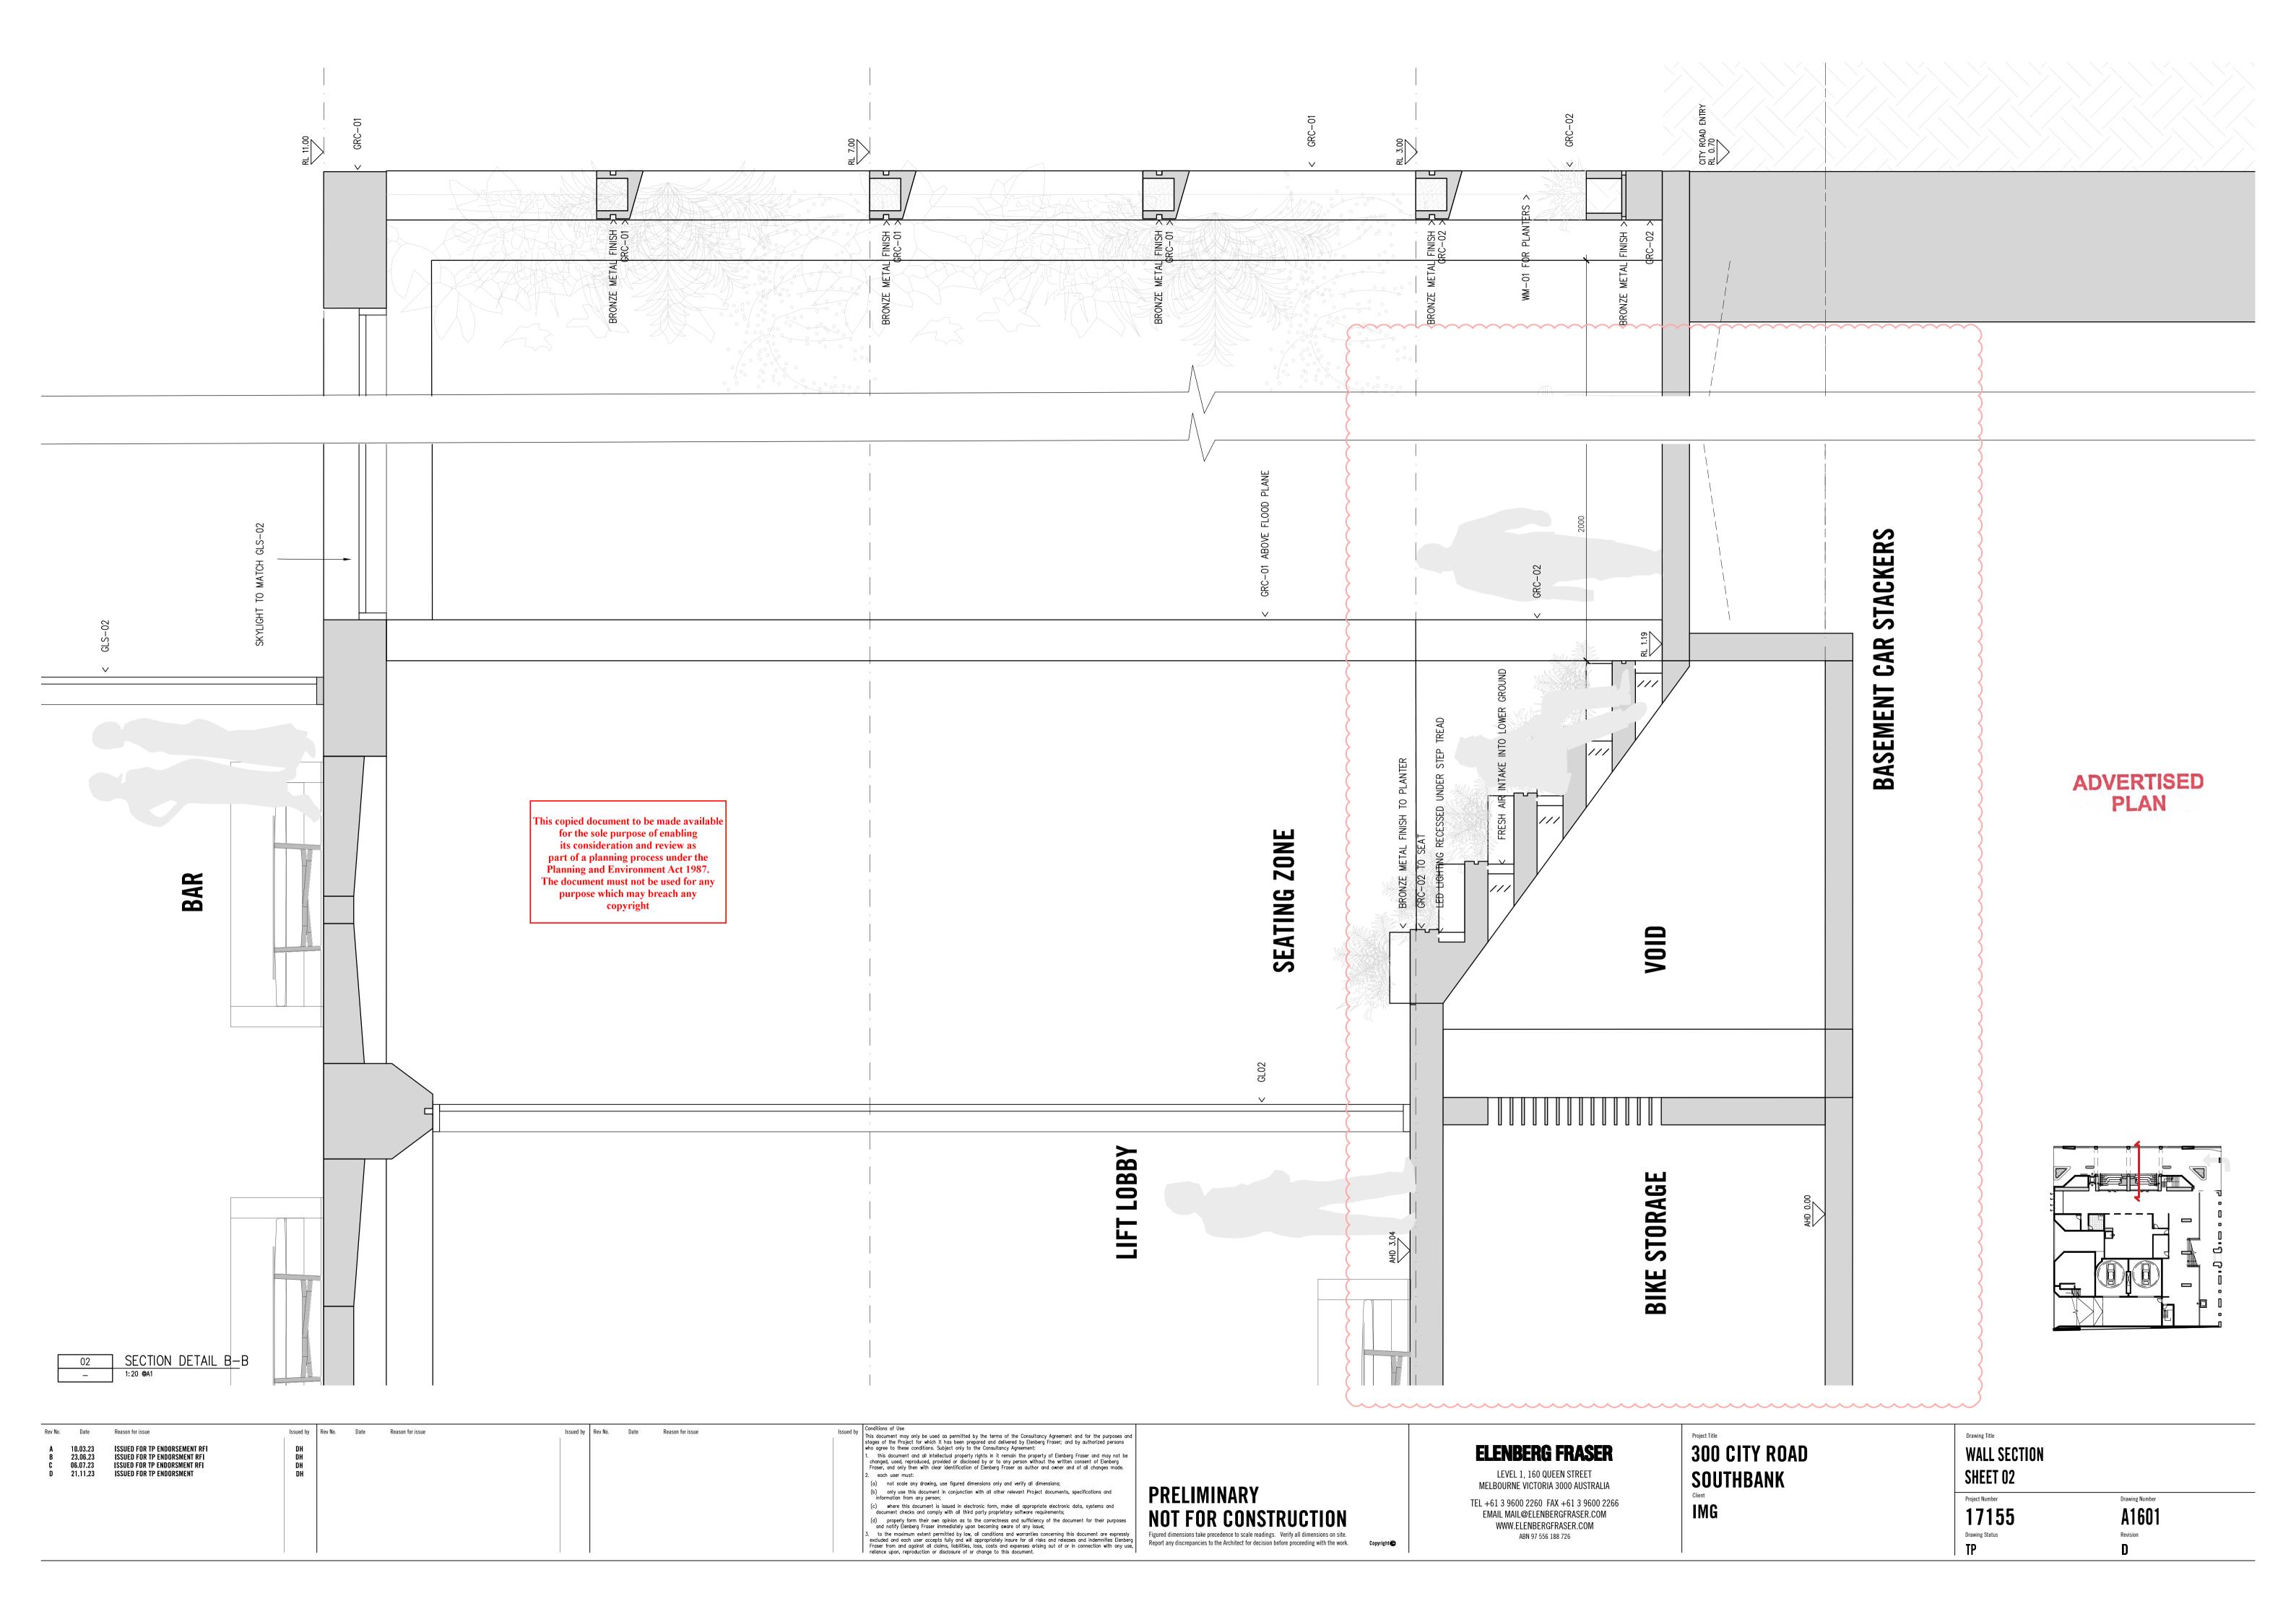

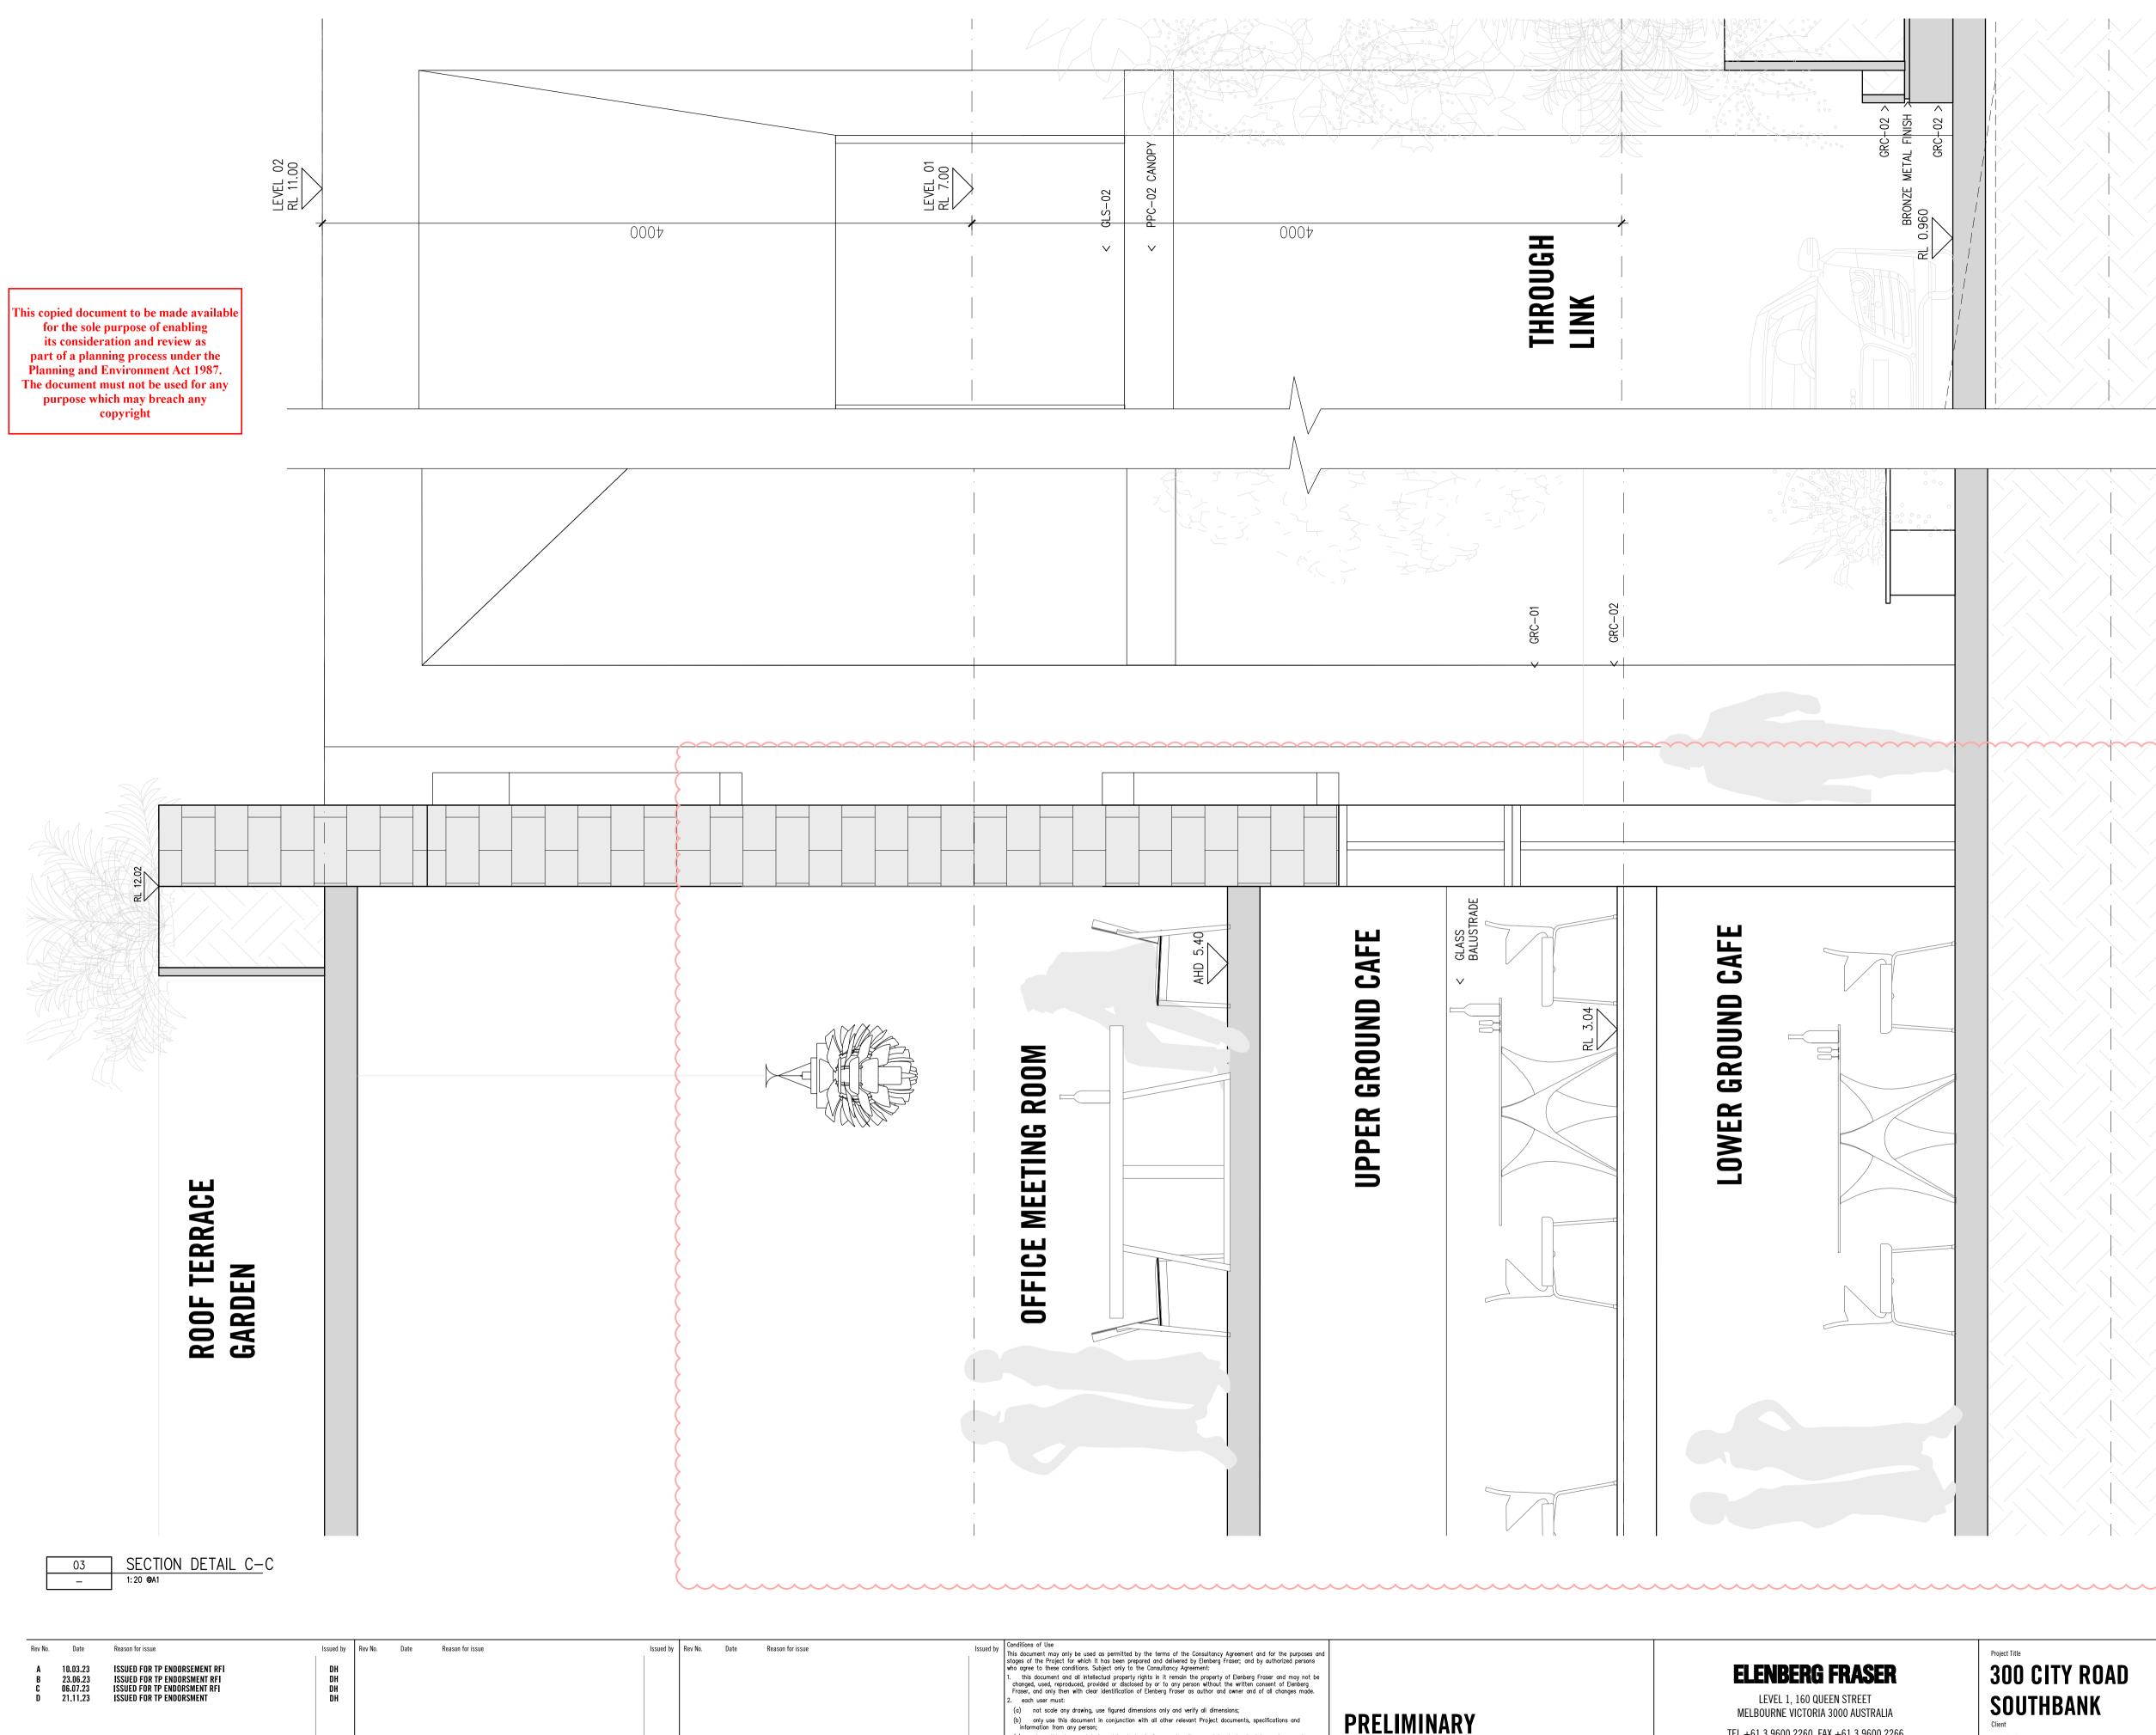


# each user must: (a) not scale any drawing, use figured dimensions only and verify all dimensions; (b) only use this document in conjunction with all other relevant Project documents, specifications and information from any person; (c) where this document is issued in electronic form, make all appropriate electronic data, systems and document checks and comply with all third party proprietary software requirements; (d) properly form their own opinion as to the correctness and sufficiency of the document for their purposes and notify Elenberg Fraser immediately upon becoming aware of any issue; to the maximum extent permitted by low, all conditions and warranties concerning this document are expressly excluded and each user accepts fully and will appropriately insure for all risks and releases and indemifies Elenberg Fraser from and against all claims, liabilities, loss, costs and expenses arising out of or in connection with any use, reliance upon, reproduction or disclosure of or change to this document.

PRELIMINARY **NOT FOR CONSTRUCTION** Figured dimensions take precedence to scale readings. Verify all dimensions on site. Report any discrepancies to the Architect for decision before proceeding with the work.


TEL +61 3 9600 2260 FAX +61 3 9600 2266 EMAIL MAIL@ELENBERGFRASER.COM WWW.ELENBERGFRASER.COM ABN 97 556 188 726


IMG

	Project Number <b>17155</b> Drawing Status <b>TP</b>	Drawing Number A1602 Revision D	
CITY ROAD Thbank	Drawing Title WALL SECTION SHEET 03		

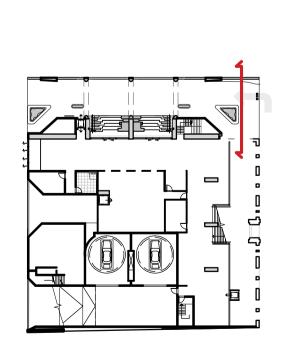



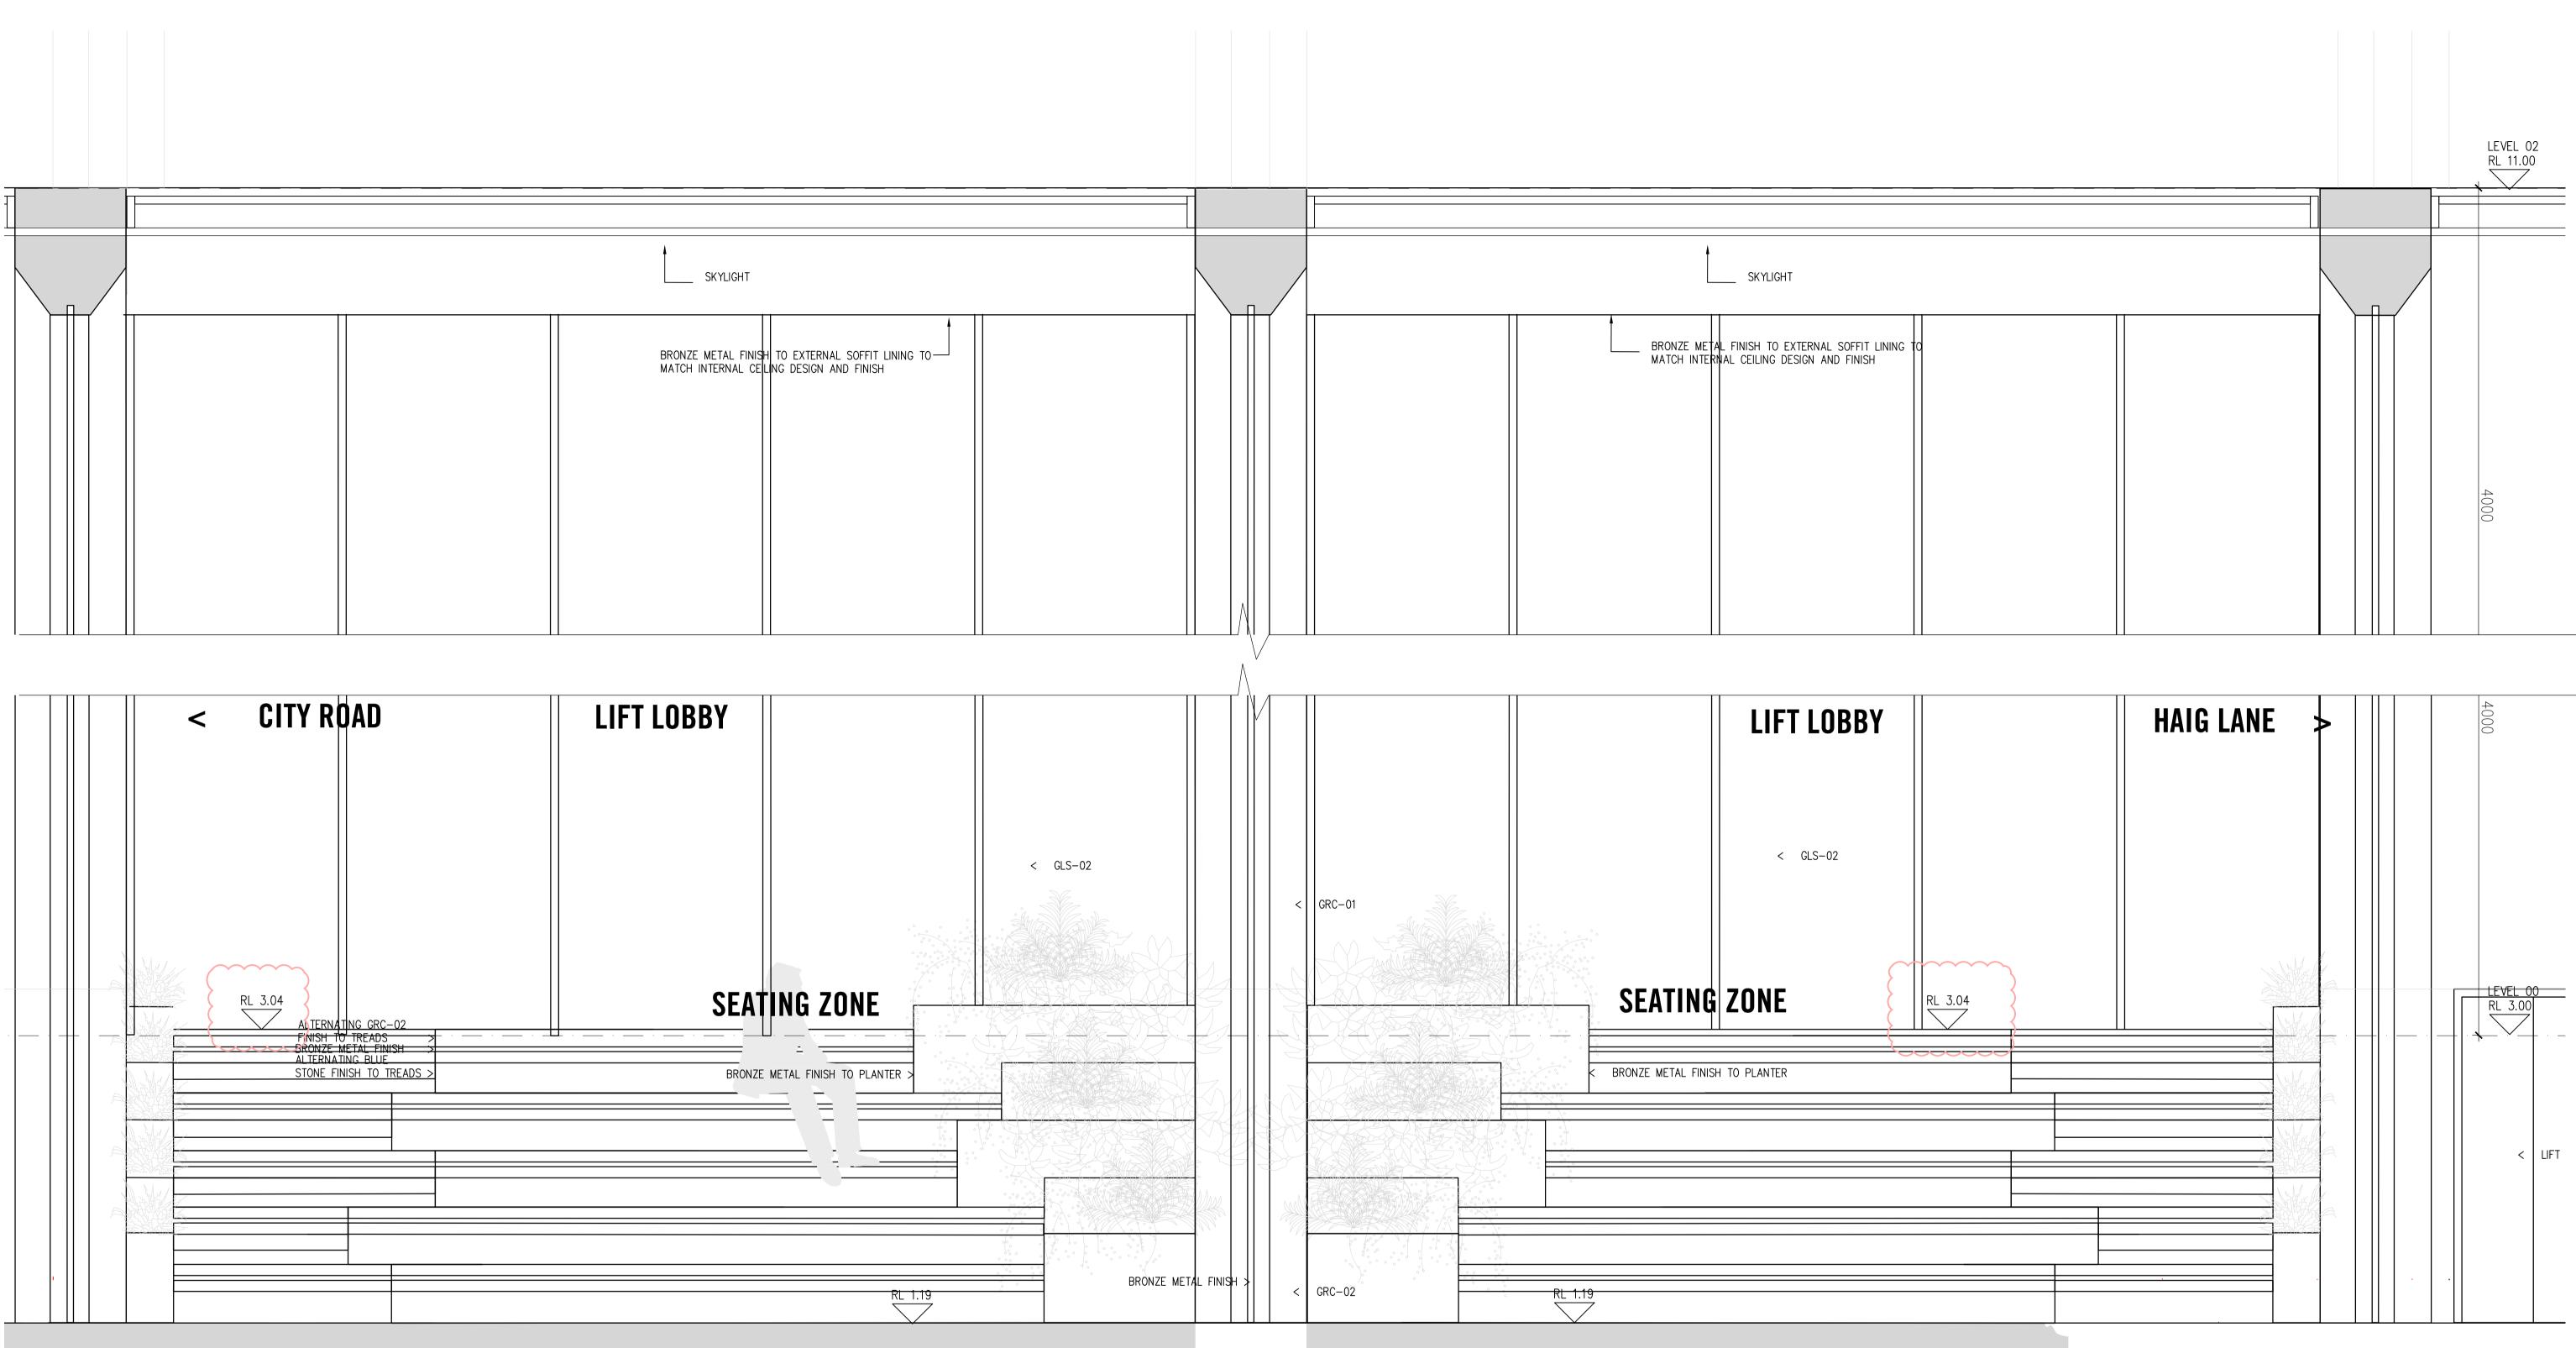

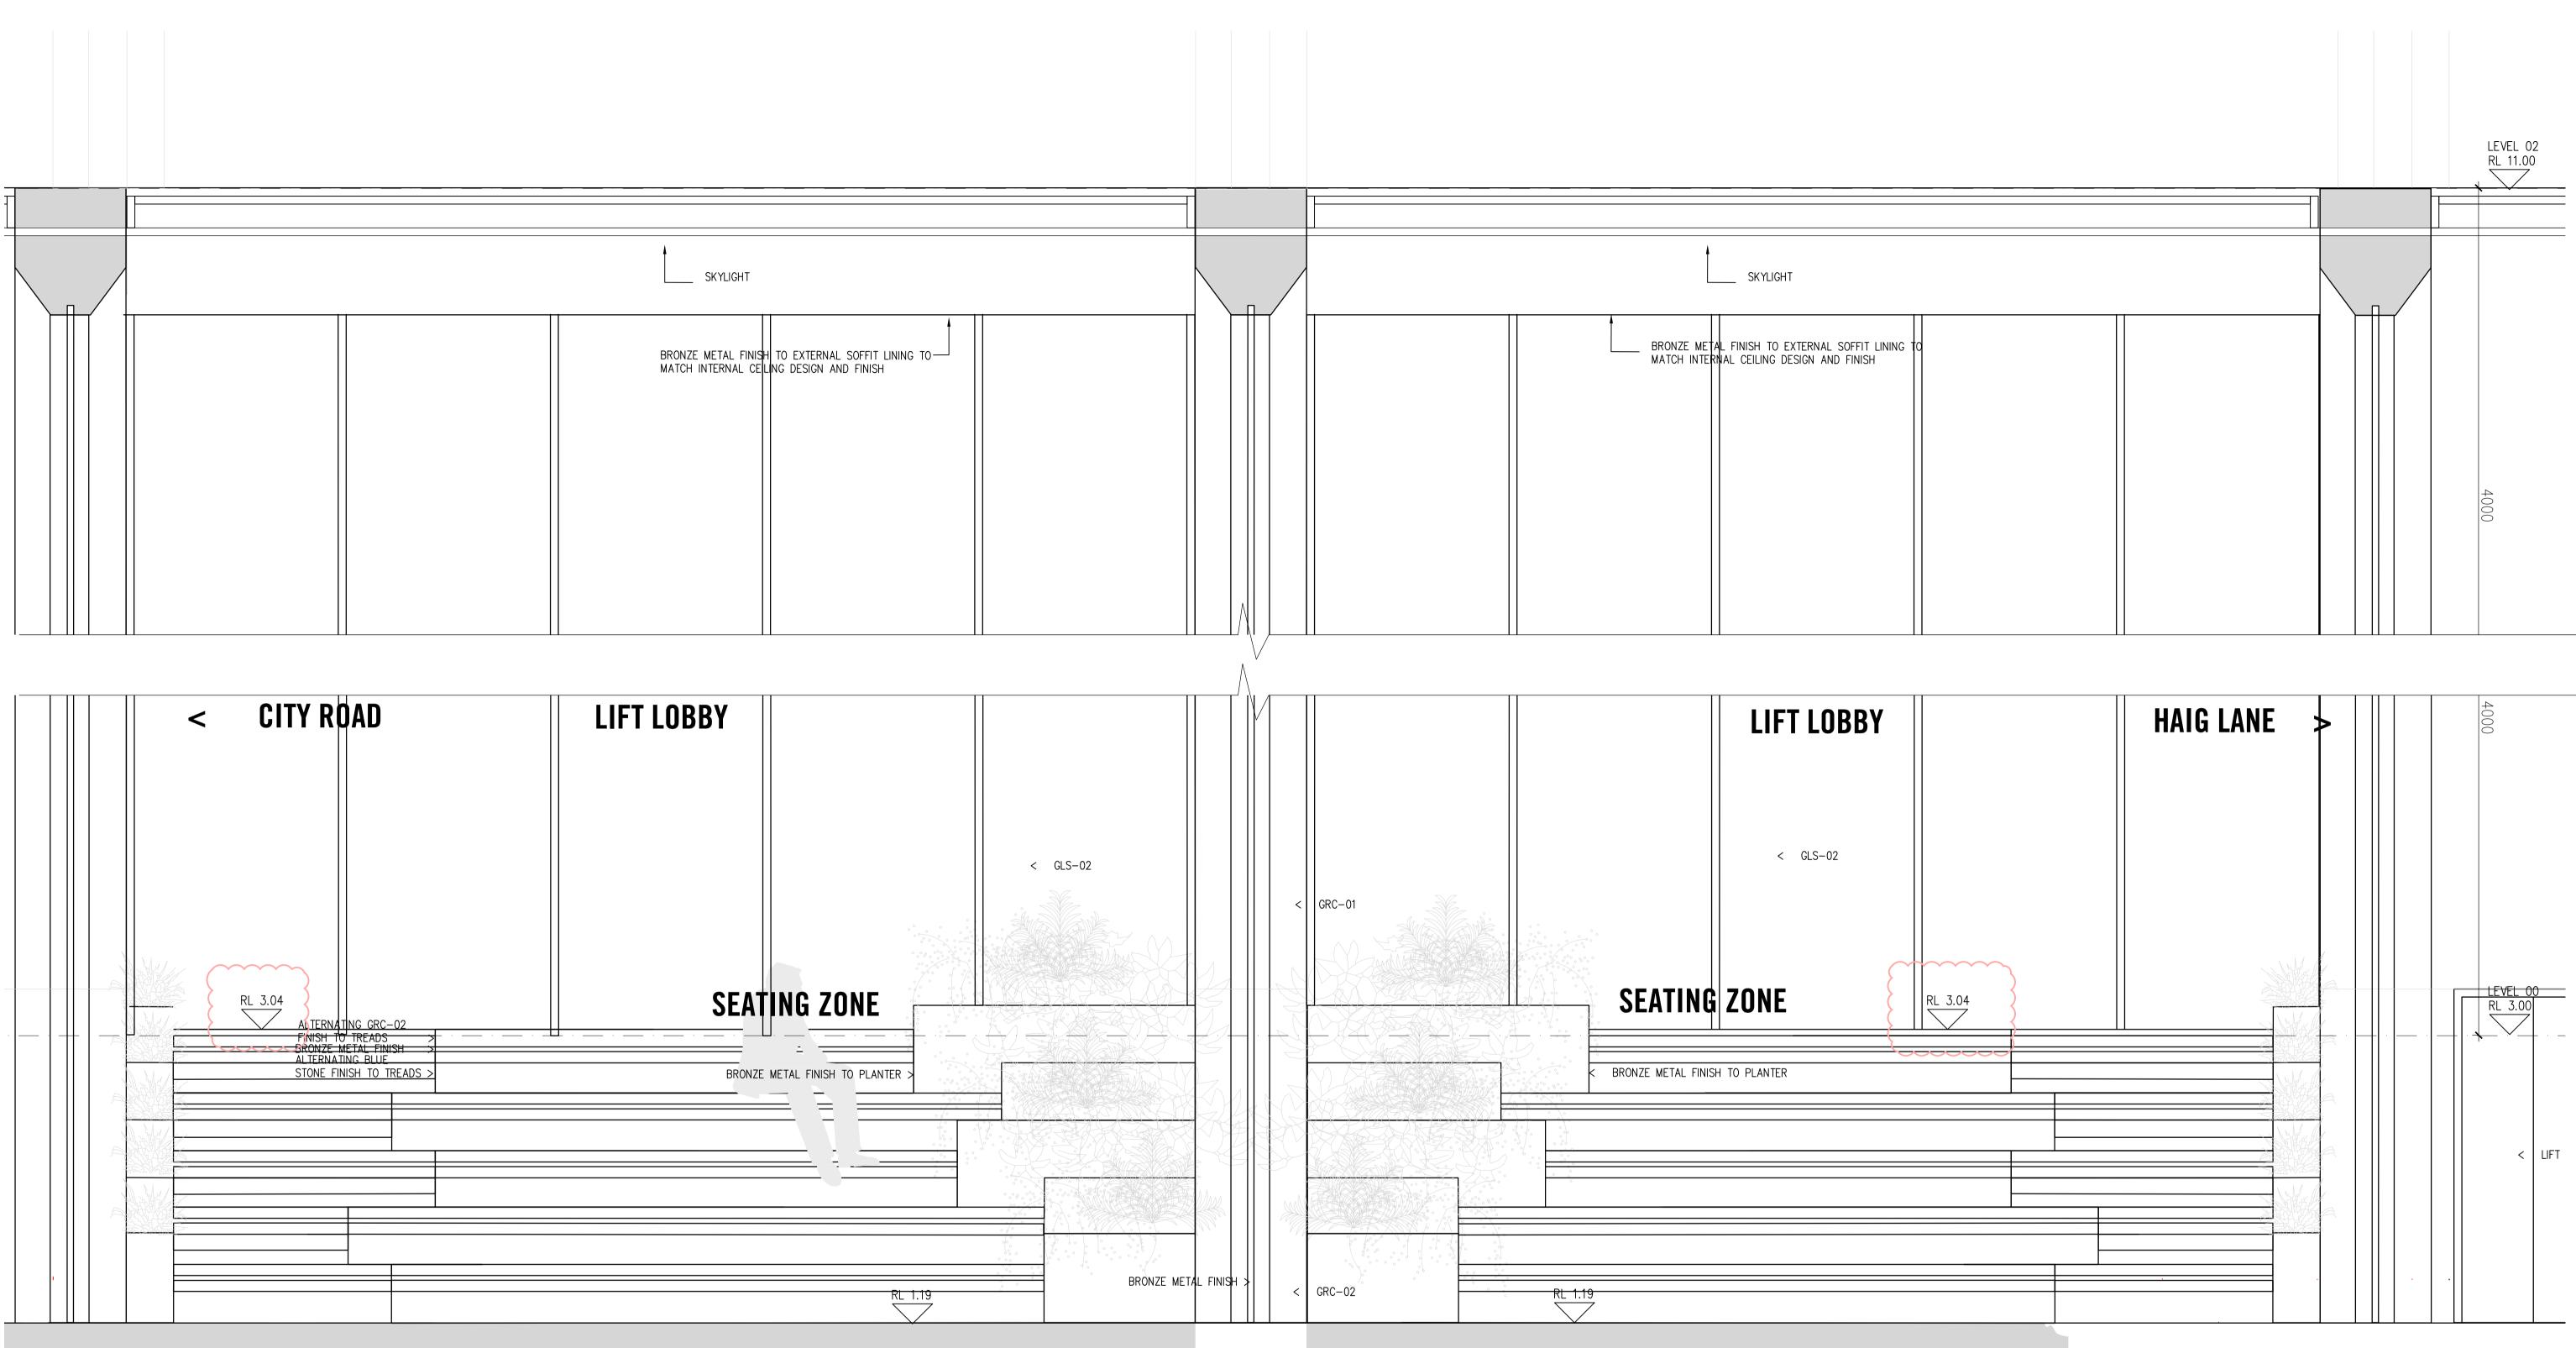

This copied document to be made available
for the sole purpose of enabling
its consideration and review as
part of a planning process under the
Planning and Environment Act 1987.
The document must not be used for any
purpose which may breach any
copyright

SECTION DETAIL D-D 04 1:20 @A1 _

Rev No.	Date	Reason for issue	Issued by	Rev No.	Date	Reason for issue	Issued by	Rev No.	Date	Reason for issue	Issued	by
A B C D	10.03.23 23.06.23 06.07.23 21.11.23	ISSUED FOR TP ENDORSEMENT RFI ISSUED FOR TP ENDORSMENT RFI ISSUED FOR TP ENDORSMENT RFI ISSUED FOR TP ENDORSMENT	DH DH DH DH									



1 by Conditions of Use
This document may only be used as permitted by the terms of the Consultancy Agreement and for the purposes and stages of the Project for which it has been prepared and delivered by Elenberg Fraser; and by authorized persons who agree to these conditions. Subject only to the Consultancy Agreement:

this document and all intellectual property rights in it remain the property of Elenberg Fraser and may not be changed, used, reproduced, provided or disclosed by or to any person without the written consent of Elenberg Fraser, and only then with clear identification of Elenberg Fraser as author and owner and of all changes made.
each user must:

not scale any drawing, use figured dimensions only and verify all dimensions;
only use this document is issued in electronic form, make all appropriate electronic data, systems and document checks and comply with all third party proprietary software requirements;
perperty form their own opinion as to the correctness and sufficiency of the document for their purposes and notify Elenberg Fraser immediately upon becoming aware of any issue;


to the maximum extent permitted by law, all conditions and warranties concerning this document are expressly excluded and each user accepts fully and will appropriately insure for all risks and releases and indemnifies Elenberg Fraser from and against all claims, liabilities, loss, costs and expenses arising out of or in connection with any use, reliance upon, reproduction or disclosure of or change to this document.

PRELIMINARY **NOT FOR CONSTRUCTION** Figured dimensions take precedence to scale readings. Verify all dimensions on site. Report any discrepancies to the Architect for decision before proceeding with the work. **ELENBERG FRASER** 


LEVEL 1, 160 QUEEN STREET MELBOURNE VICTORIA 3000 AUSTRALIA TEL +61 3 9600 2260 FAX +61 3 9600 2266 EMAIL MAIL@ELENBERGFRASER.COM WWW.ELENBERGFRASER.COM ABN 97 556 188 726

300 CITY R( SOUTHBANK IMG

Project Title

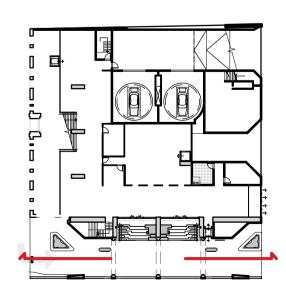

OAD K	WALL SECTION Sheet 04		
	Project Number	Drawing Number	
	17155	A1603	
	Drawing Status	Revision	
	TP	D	

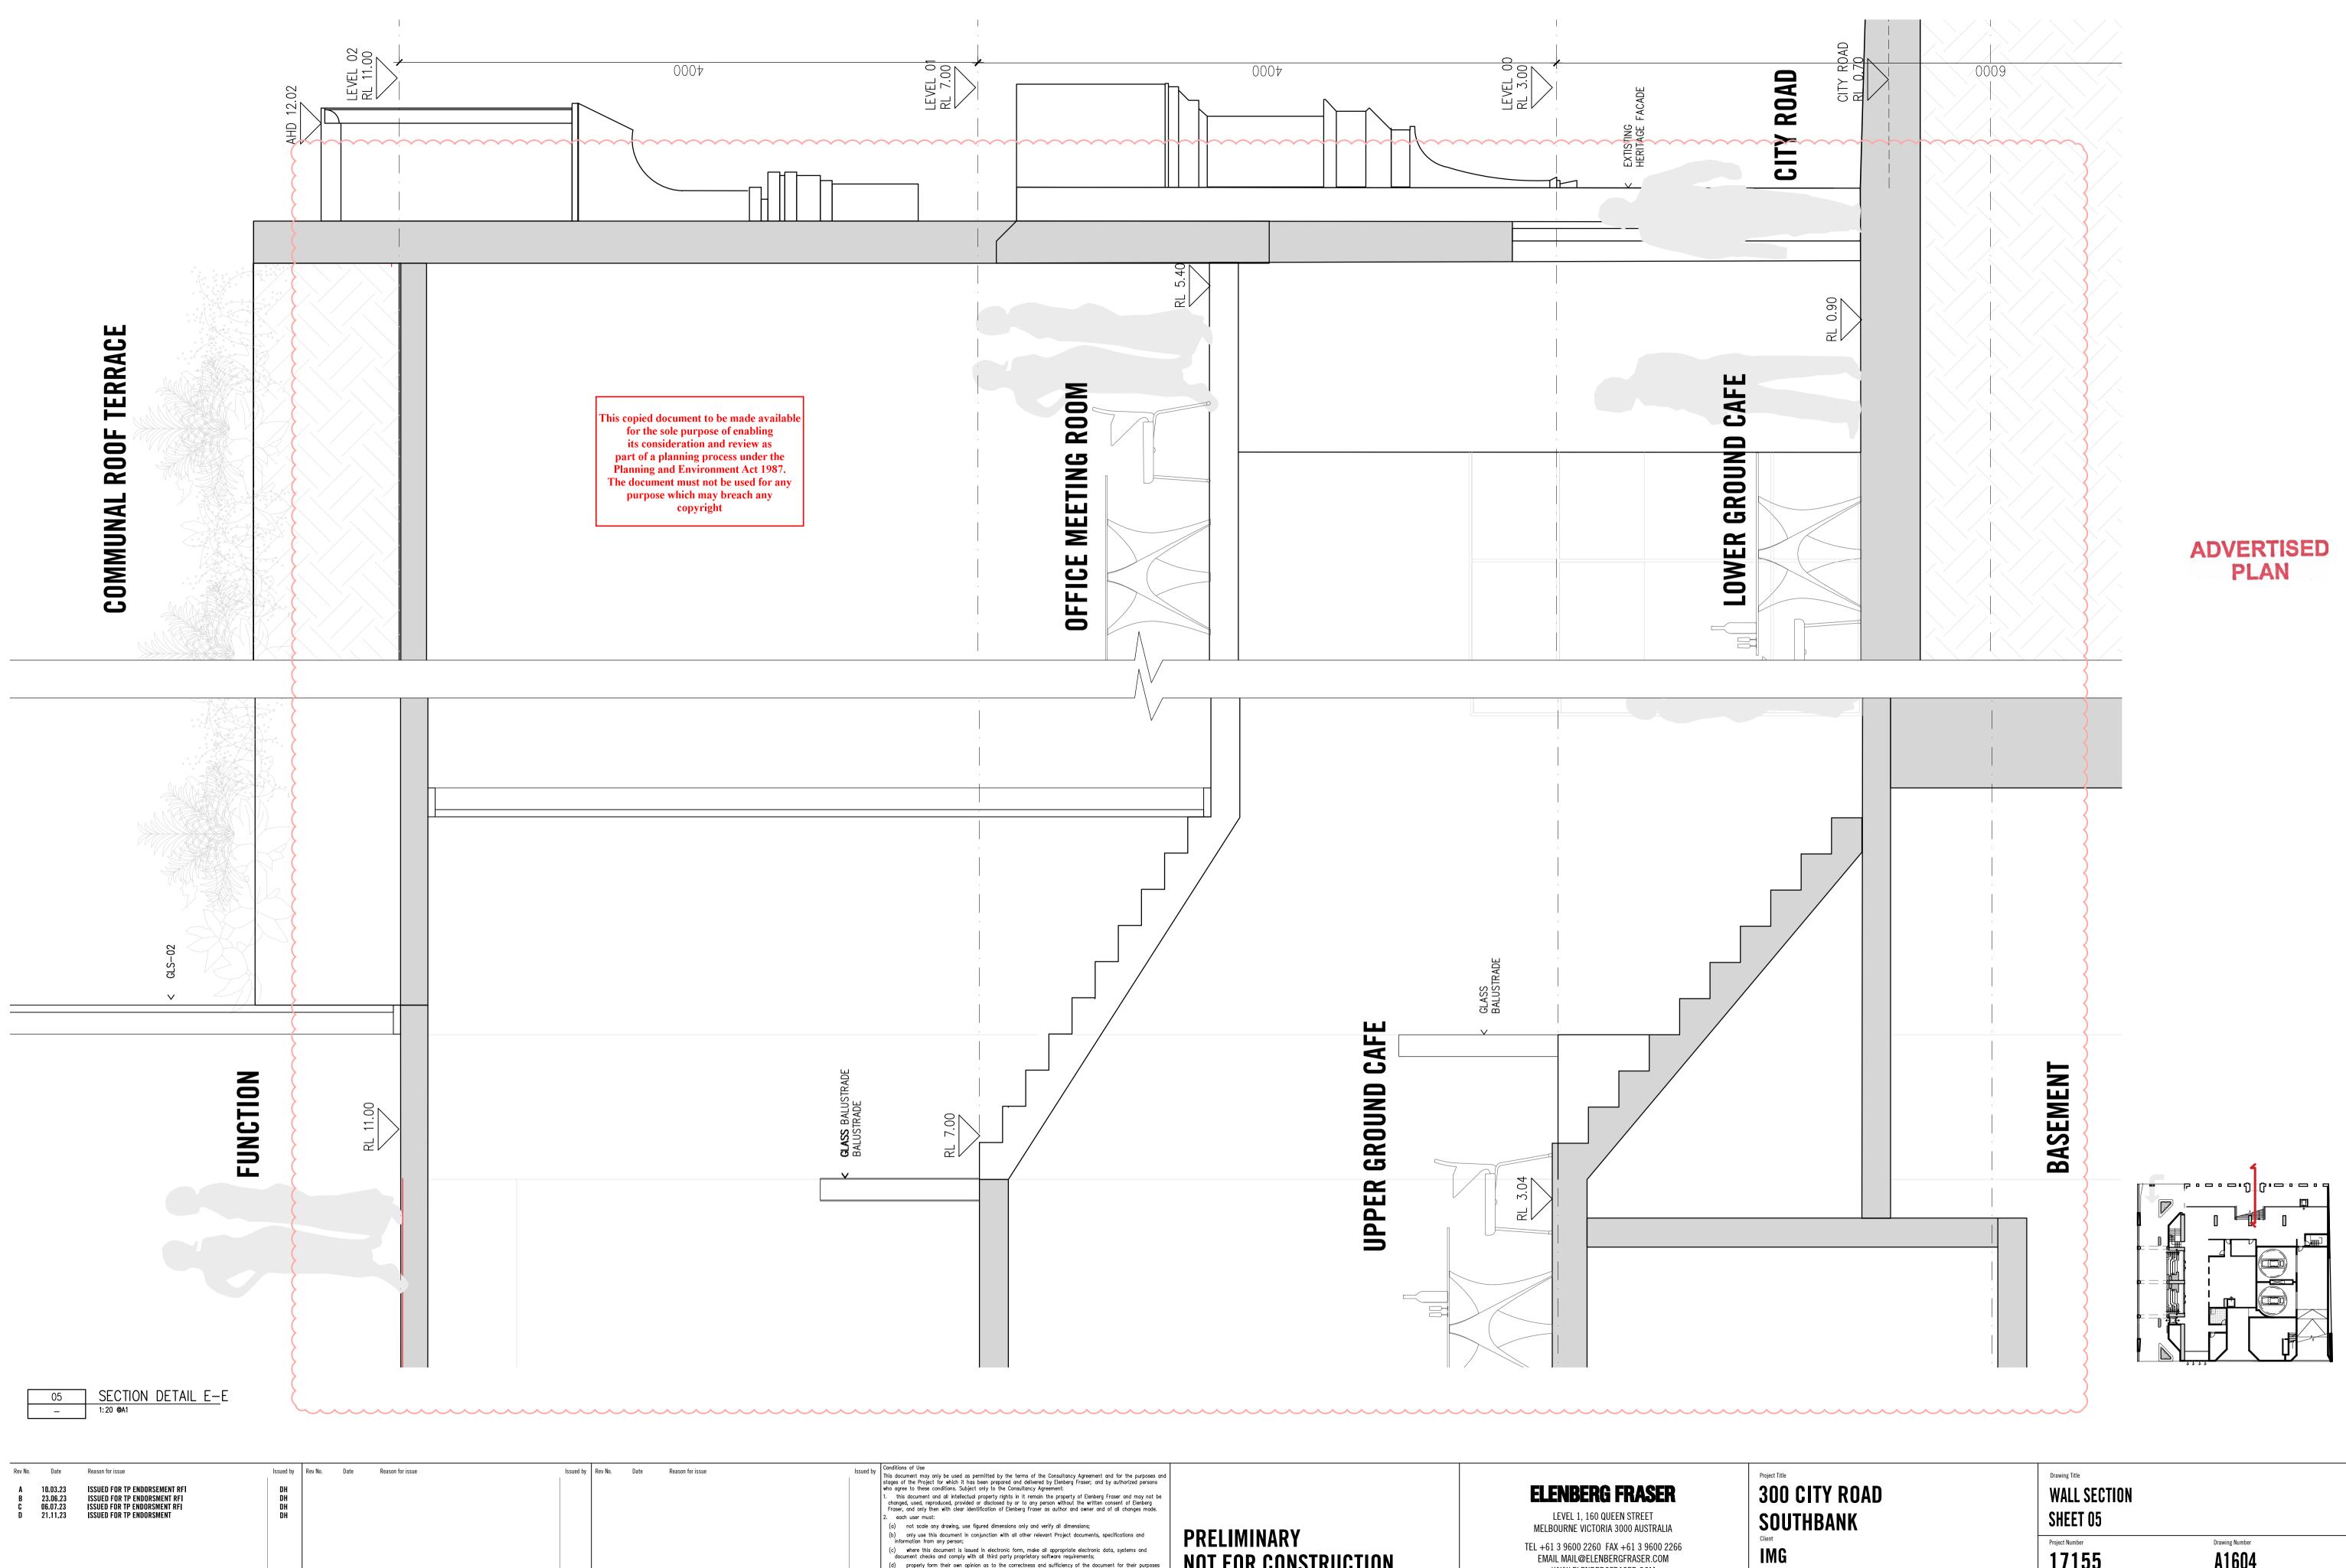

each user must:

 (a) not scale any drawing, use figured dimensions only and verify all dimensions;
 (b) only use this document in conjunction with all other relevant Project documents, specifications and information from any person;
 (c) where this document is issued in electronic form, make all appropriate electronic data, systems and document checks and comply with all third party proprietary software requirements;
 (d) properly form their own opinion as to the correctness and sufficiency of the document for their purposes and notify Elenberg Fraser immediately upon becoming aware of any issue;

 to the maximum extent permitted by low, all conditions and warranties concerning this document are expressly excluded and each user accepts fully and will appropriately insure for all risks and releases and indemifies Elenberg Fraser from and against all claims, liabilities, loss, costs and expenses arising out of or in connection with any use, reliance upon, reproduction or disclosure of or change to this document.


**NOT FOR CONSTRUCTION** Figured dimensions take precedence to scale readings. Verify all dimensions on site. Report any discrepancies to the Architect for decision before proceeding with the work.


WWW.ELENBERGFRASER.COM ABN 97 556 188 726

CITY ROAD Thbank	Drawing Title WALL SECTION SHEET 05	
	Project Number	Drawing Number
	17155	A1604
	Drawing Status	Revision
	ТР	D


RL 12.20	4000 CTAZIN RL 7.00	4000 SB v	LEVEL 00_UG	HAIG LANE BICYCLE ENTRY RL 1.07 LEVEL 00_LG	LIC 0.00
COMMUNAL TERRACE	OFFICE	This copied document to be made available for the sole purpose of enabling its consideration and review as part of a planning process under the Planning and Environment Act 1987. The document must not be used for any purpose which may breach any copyright		RAMP DOWN TO BIKE STORE	
<ul> <li>GLS-02</li> <li>GLS-02</li> </ul>			RL 3.04		
RT 11.00		<b>FOBBRIONGE</b>			
	ADVERTISED PLAN	Lift Lobb		BIKE STORAGE	
3D SECTION DETAIL					

A B C D	05.07.23 23.06.23 06.07.23 21.11.23	ISSUED FOR TP ENDORSEMENT RFI ISSUED FOR TP ENDORSMENT RFI ISSUED FOR TP ENDORSMENT RFI ISSUED FOR TP ENDORSMENT	DH Dh Dh Dh		

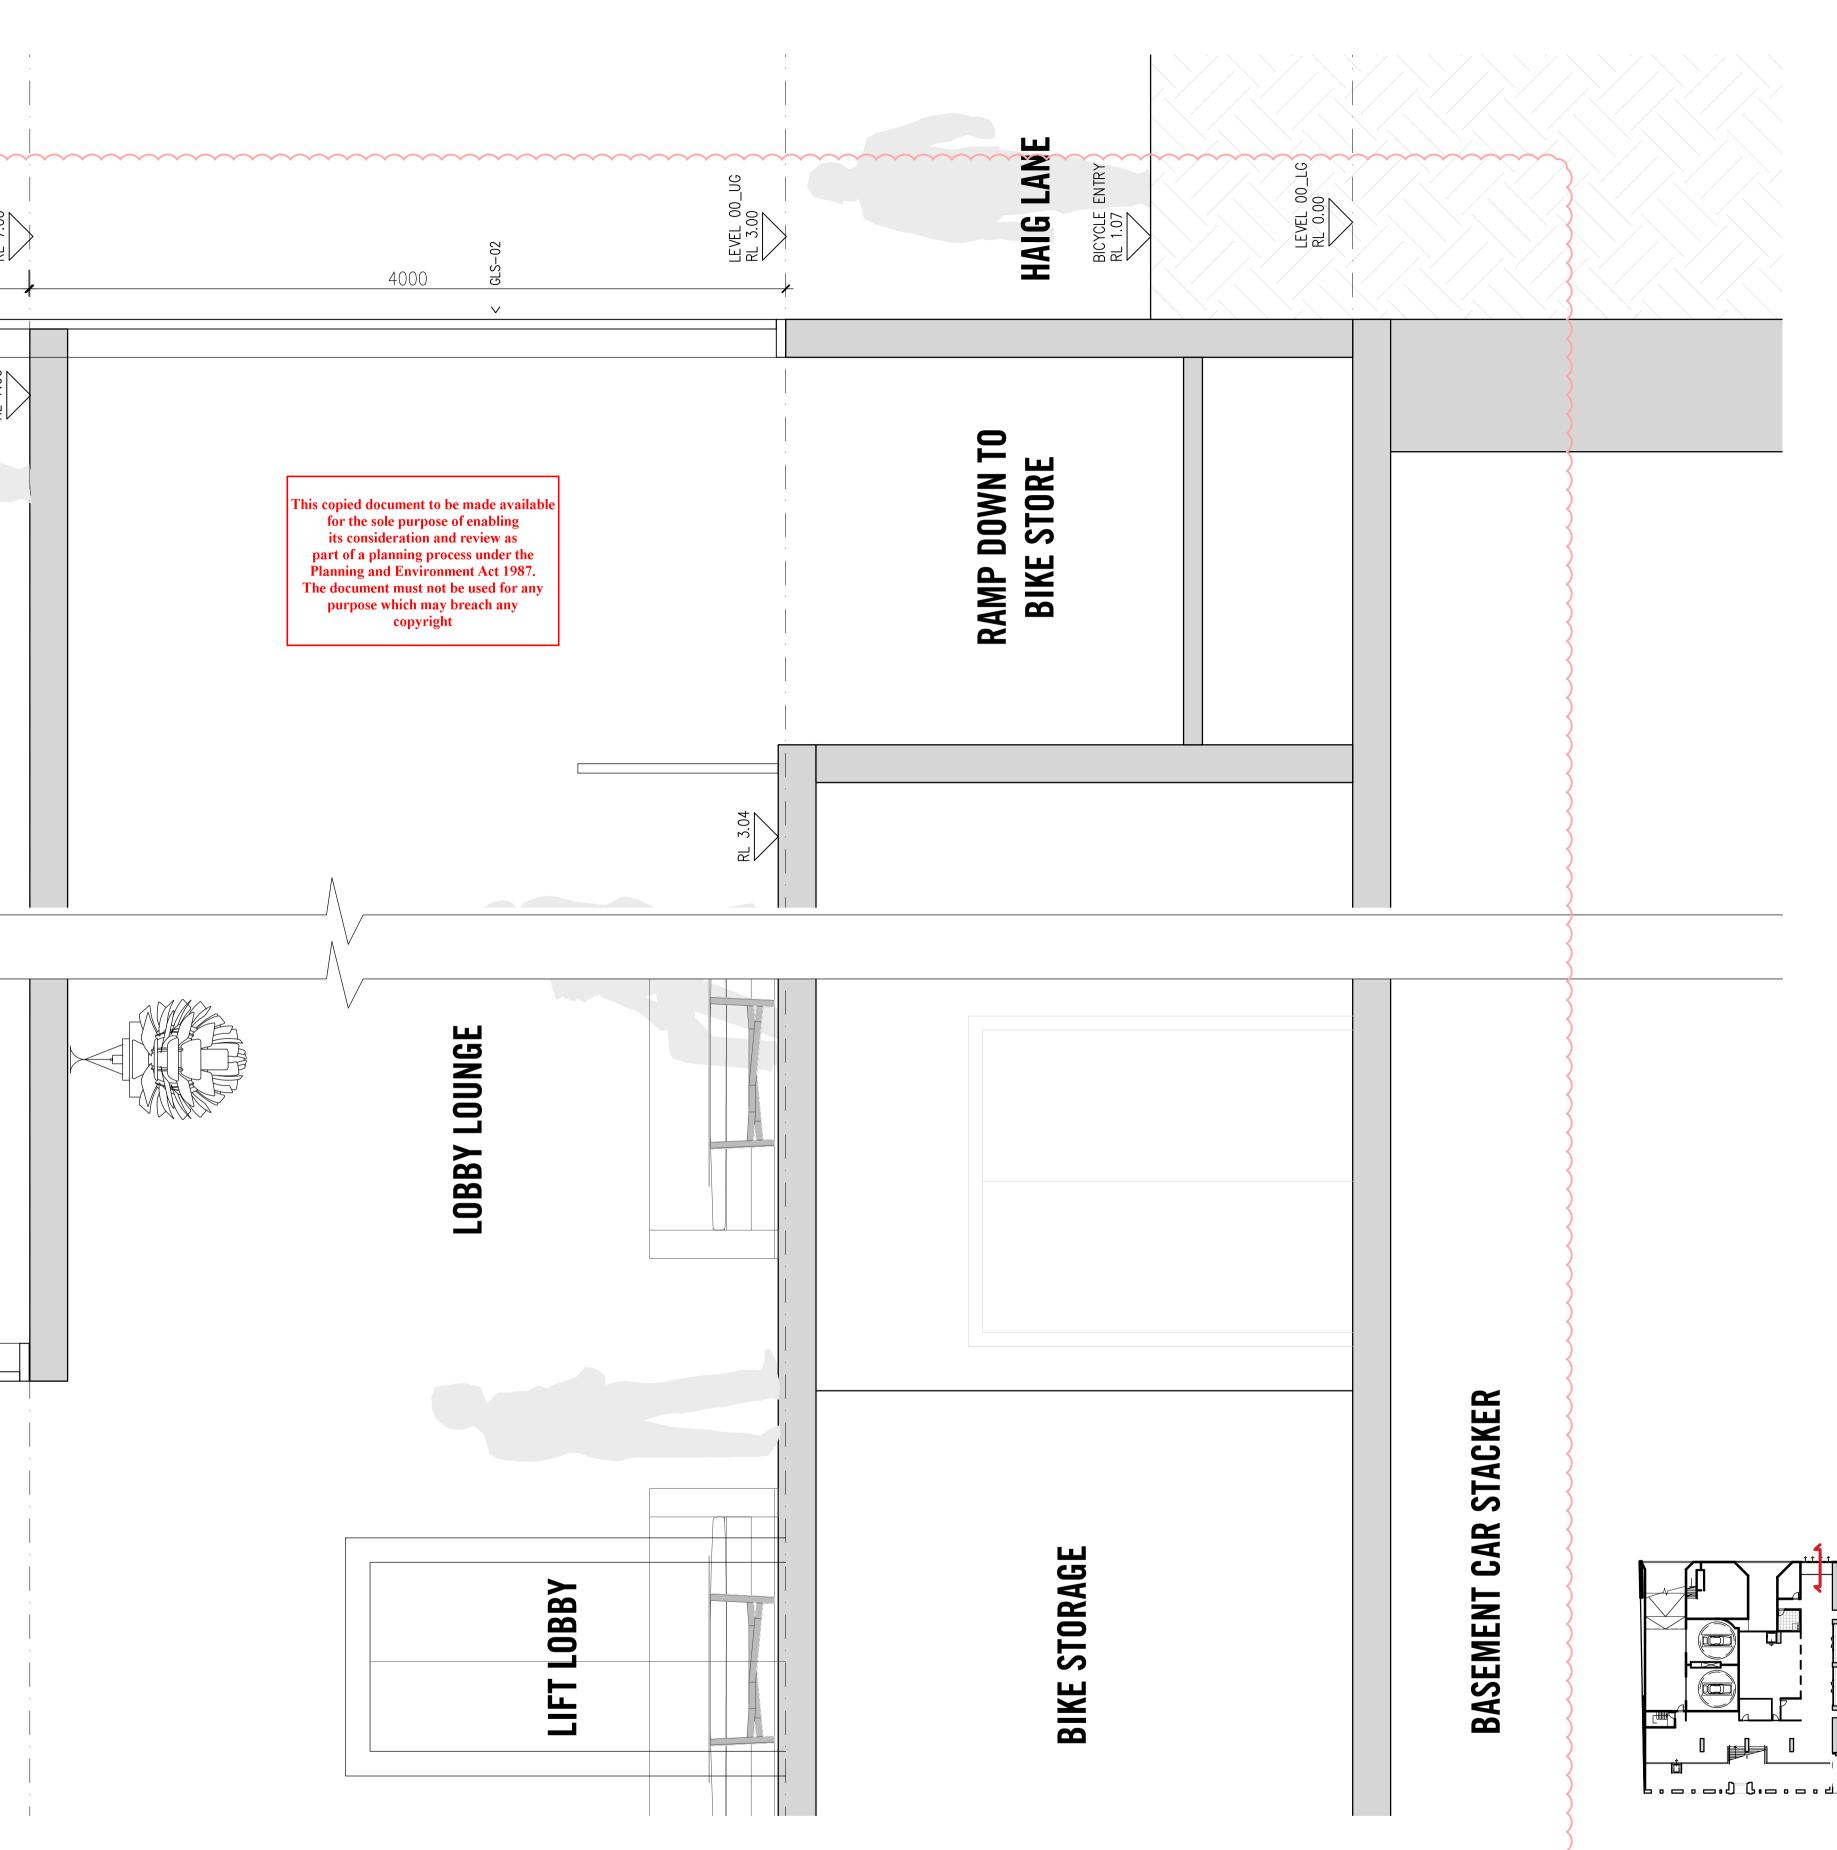


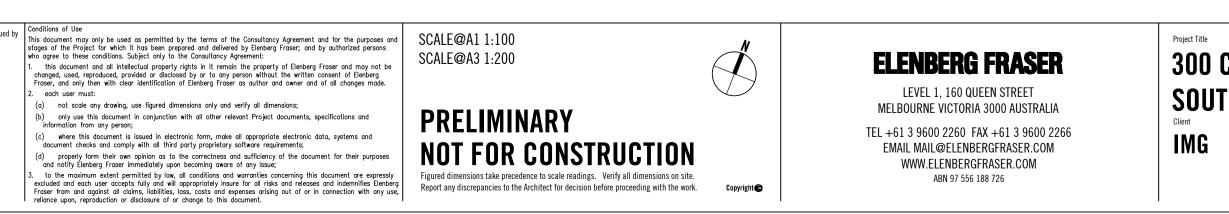


CITY ROAD Thbank	Drawing Title WALL SECTION SHEET 06	
	Project Number <b>17155</b> Drawing Status <b>TP</b>	Drawing Number A1605 Revision D

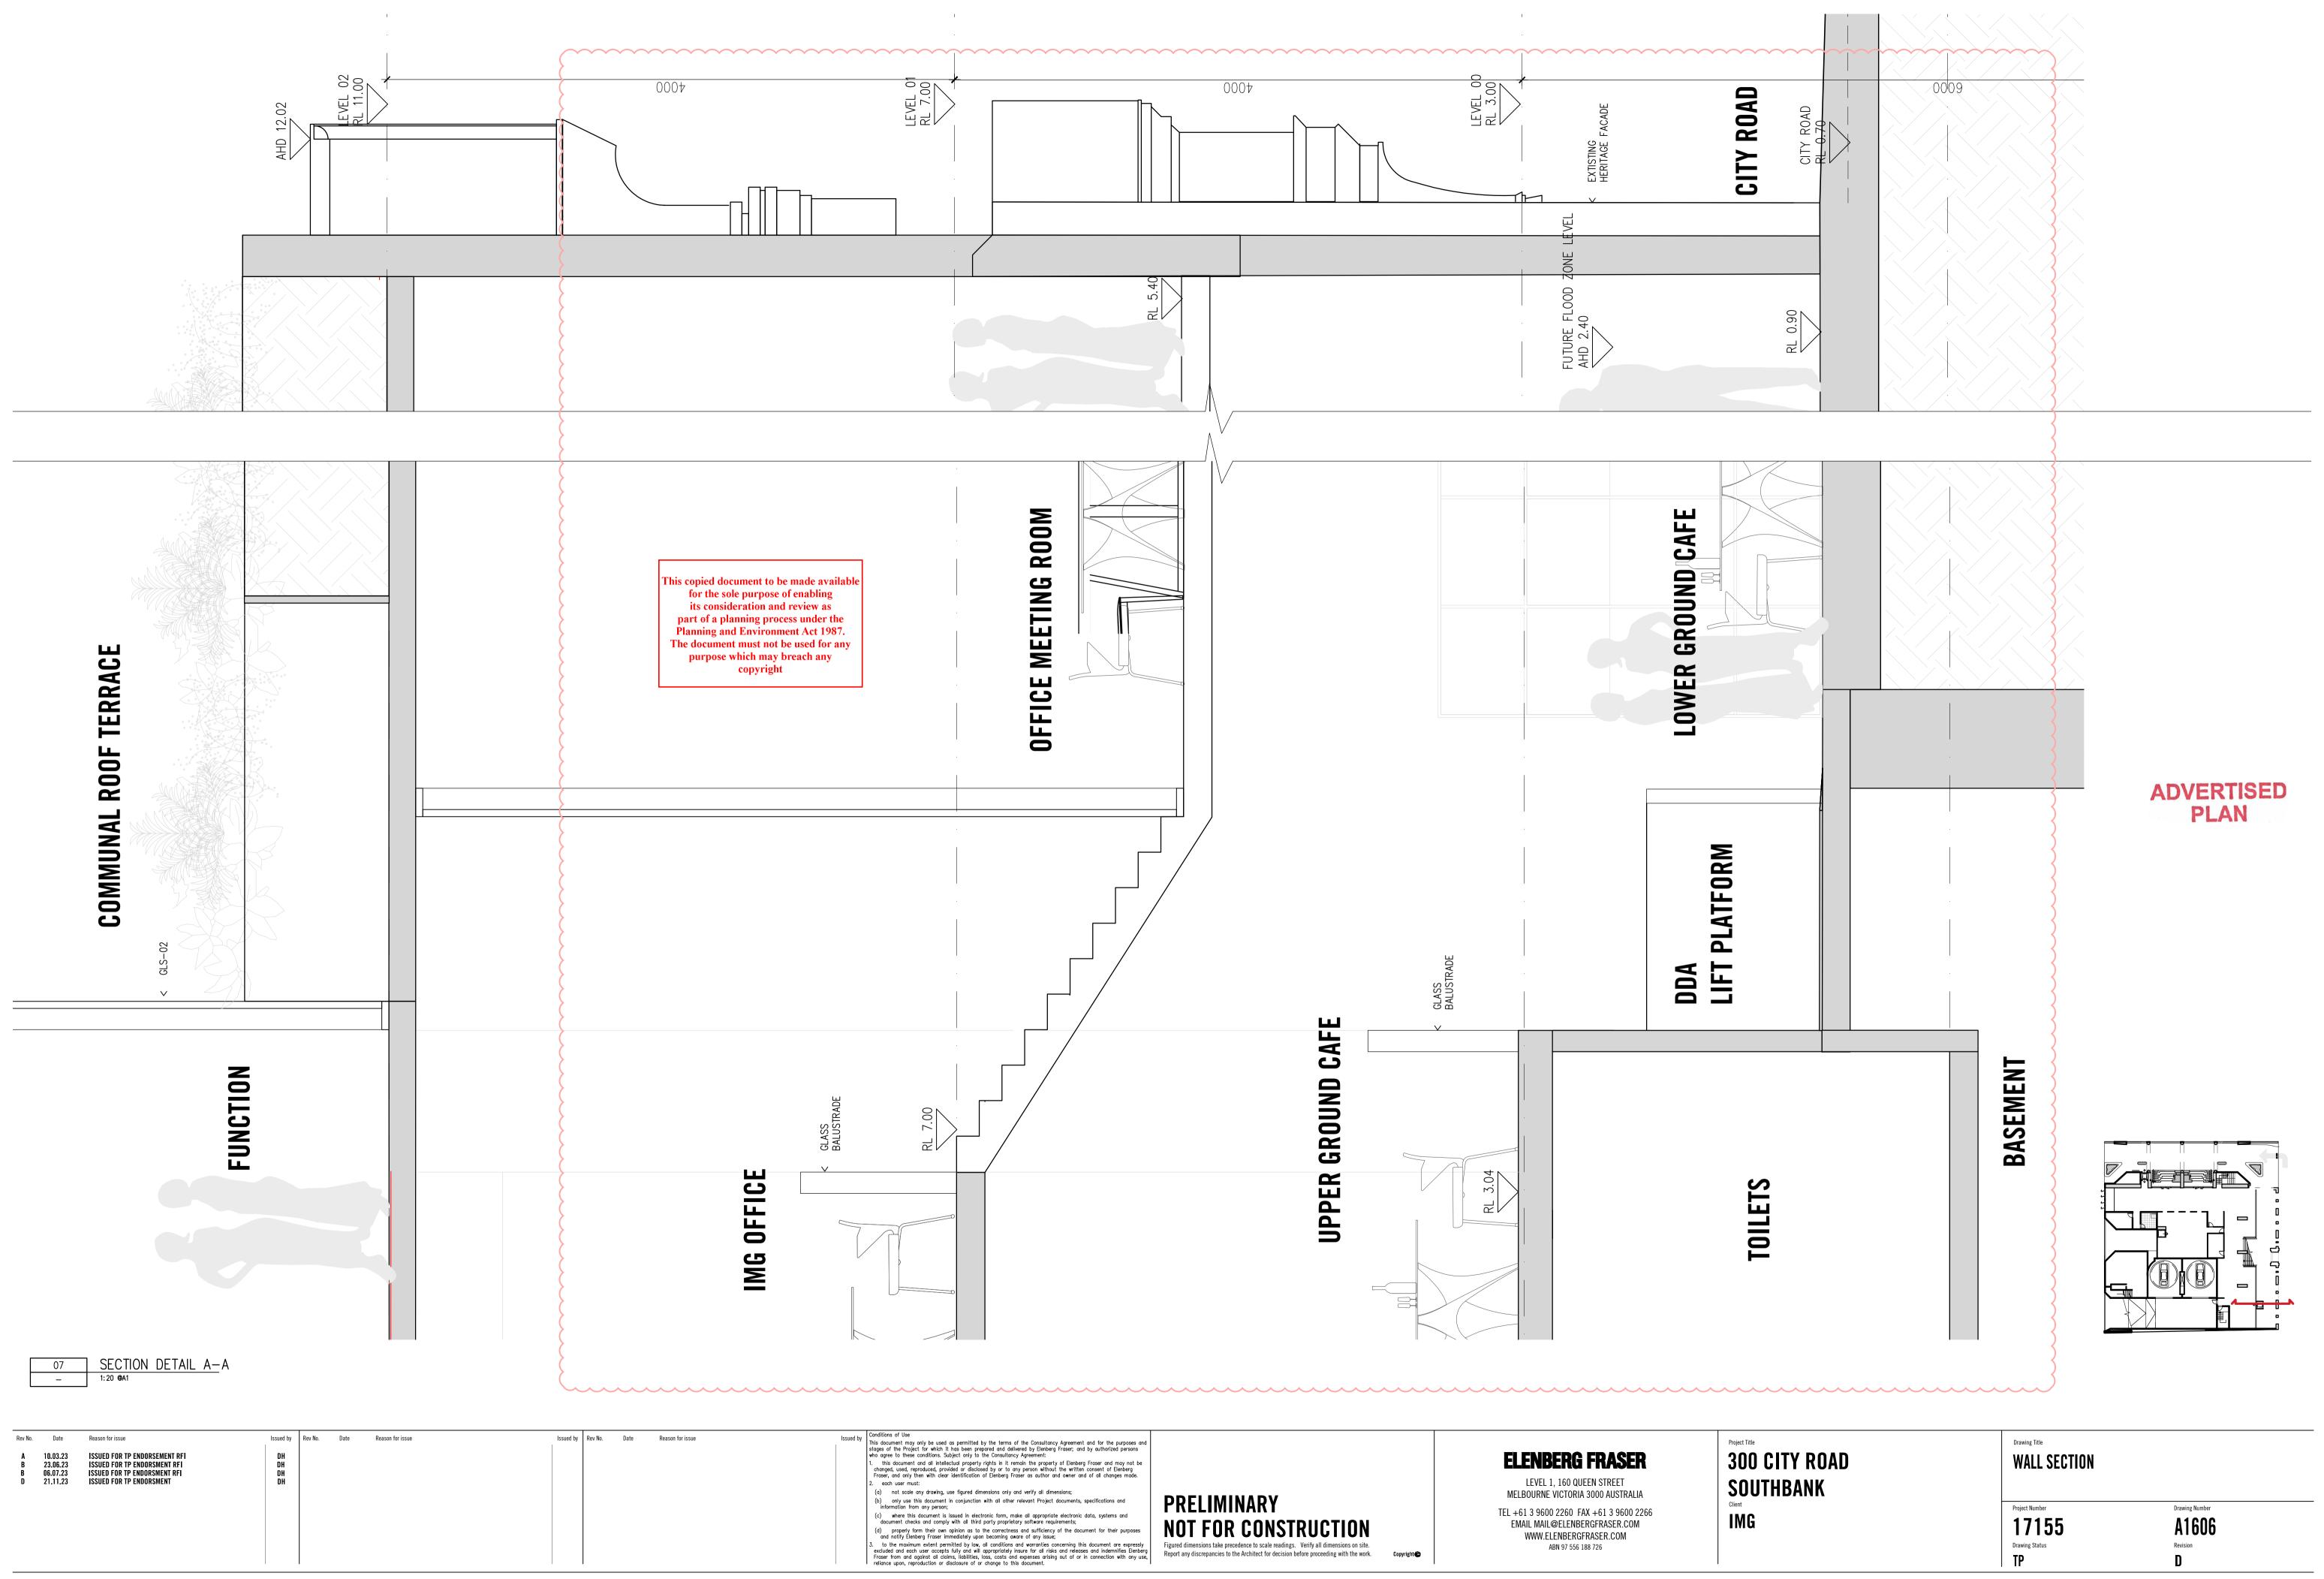



TP	D
Drawing Status	Revision
17155	A1606
Project Number	Drawing Number

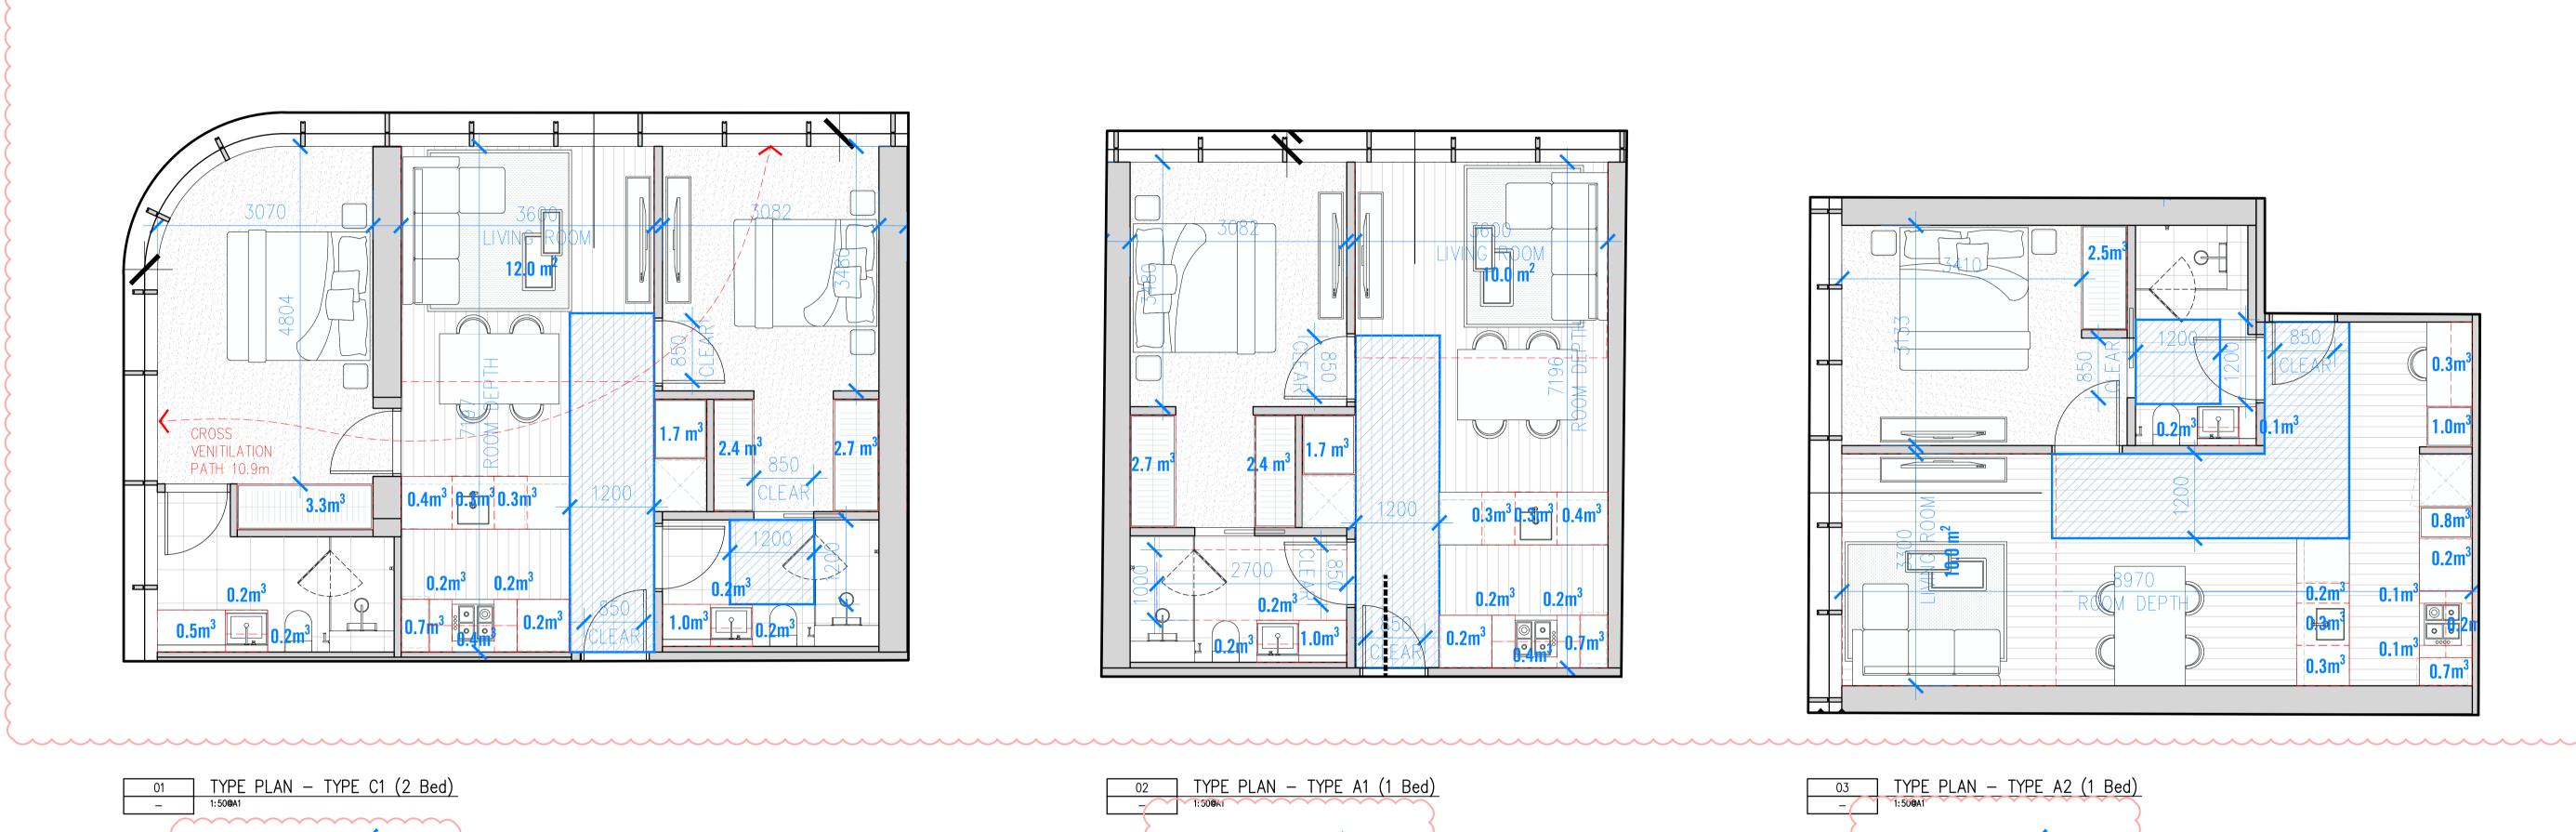


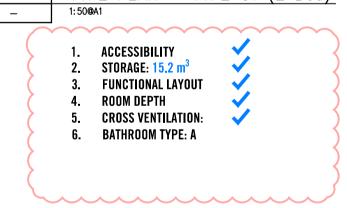





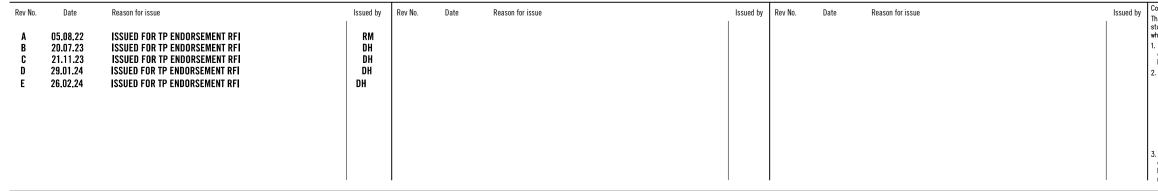


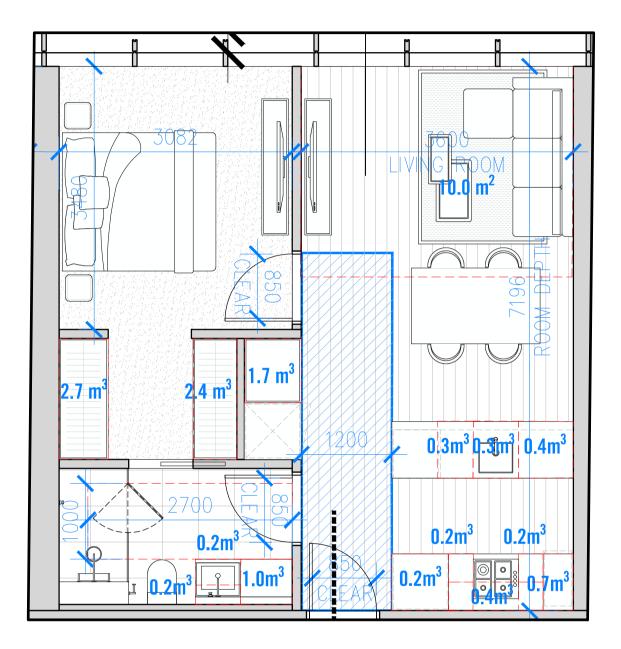

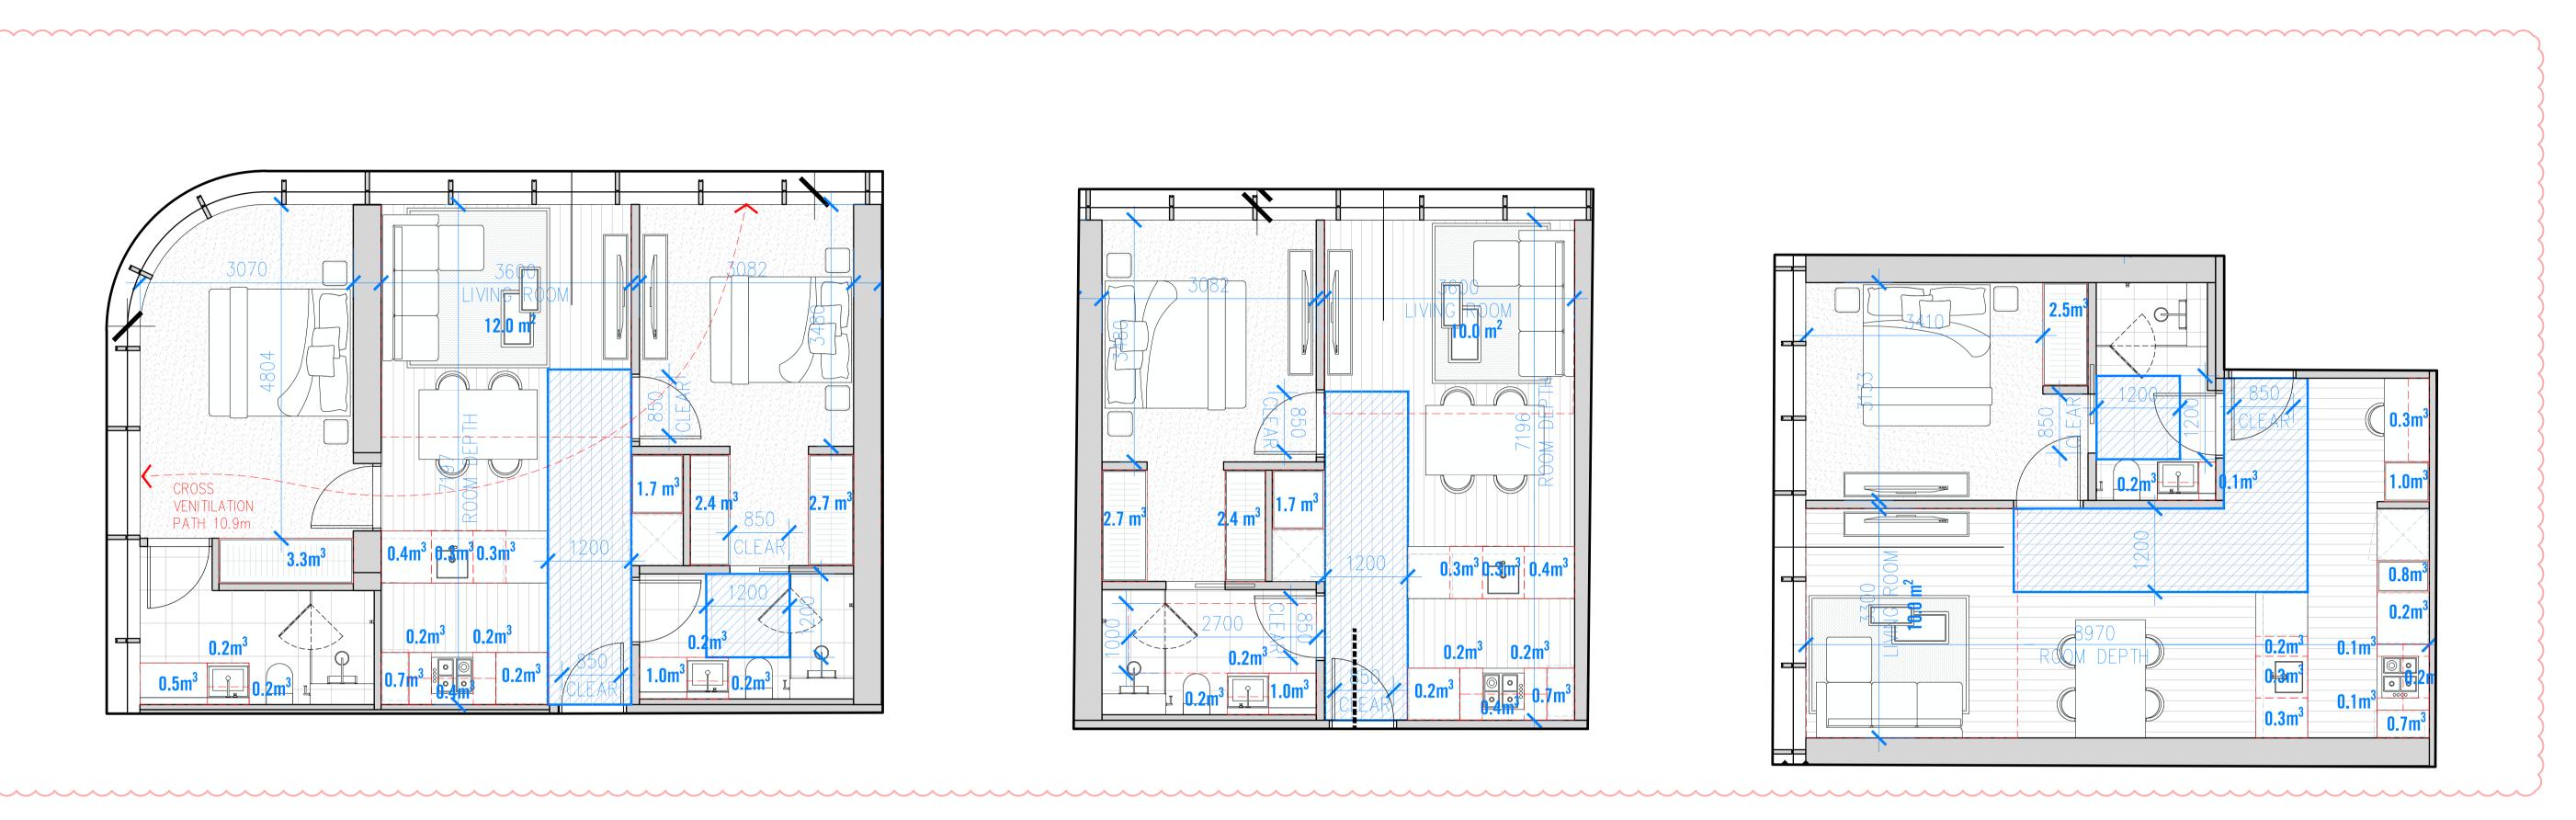

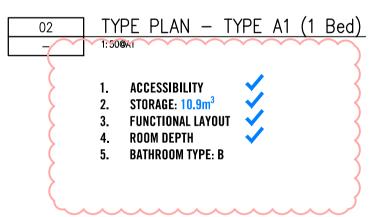

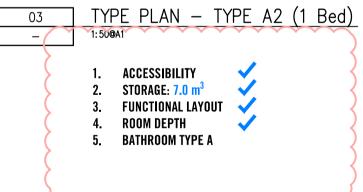

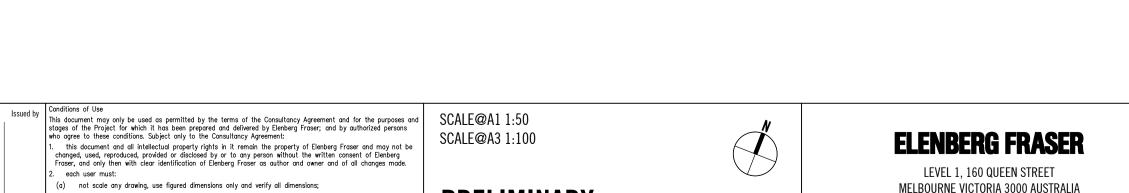

 (b) only use this document in conjunction with all other relevant Project documents, specifications and information from any person; (c) where this document is issued in electronic form, make all appropriate electronic data, systems and document checks and comply with all third party proprietary software requirements;
(d) properly form their own opinion as to the correctness and sufficiency of the document for their purposes and notify Elenberg Fraser immediately upon becoming aware of any issue;
3. to the maximum extent permitted by law, all conditions and warranties concerning this document are expressly excluded and each user accepts fully and will appropriately insure for all risks and releases and indemnifies Elenberg Fraser from and against all claims, liabilities, loss, costs and expenses arising out of or in connection with any use, reliance upon, reproduction or disclosure of or change to this document.


PRELIMINARY **NOT FOR CONSTRUCTION** Figured dimensions take precedence to scale readings. Verify all dimensions on site. Report any discrepancies to the Architect for decision before proceeding with the work. **Copyright**©


MELBOURNE VICTORIA 3000 AUSTRALIA TEL +61 3 9600 2260 FAX +61 3 9600 2266 EMAIL MAIL@ELENBERGFRASER.COM WWW.ELENBERGFRASER.COM ABN 97 556 188 726

IMG

Project Title


·····

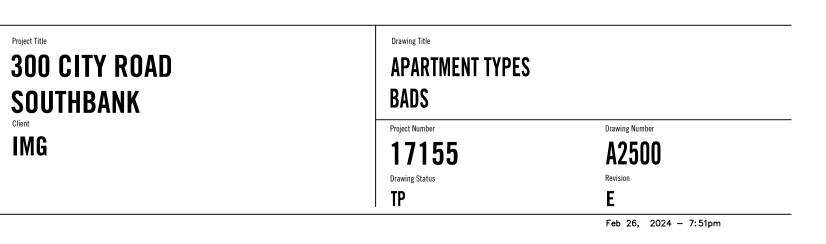

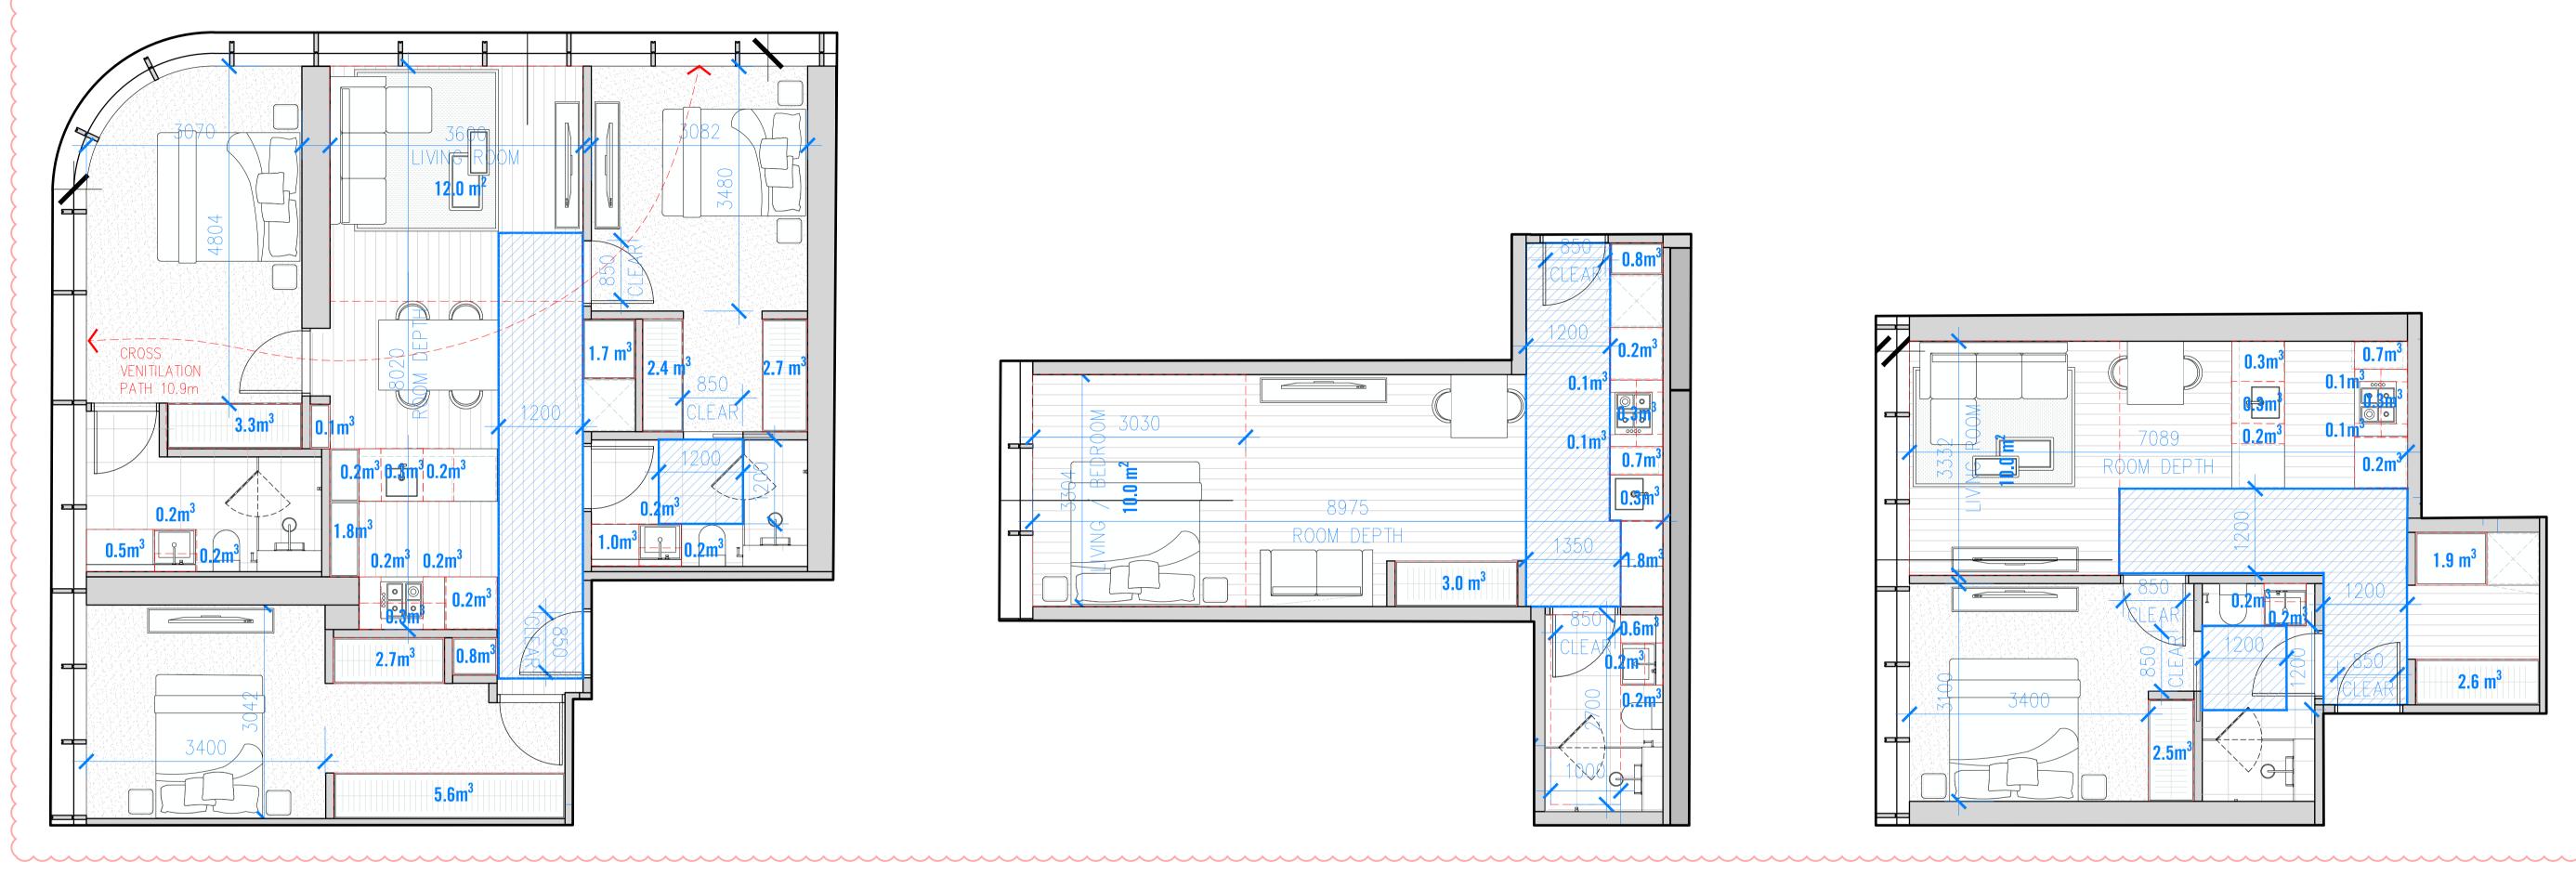



01 TYPE PLAN - TYPE D1 (3 Bed) 1:50@A1 ( -ACCESSIBILITY 1. STORAGE: 25 m³ 2. 3. FUNCTIONAL LAYOUT 🗸 ROOM DEPTH 4 CROSS VENTILATION: 🗸 6. BATHROOM TYPE: A ·····


ADVERTISED PLAN

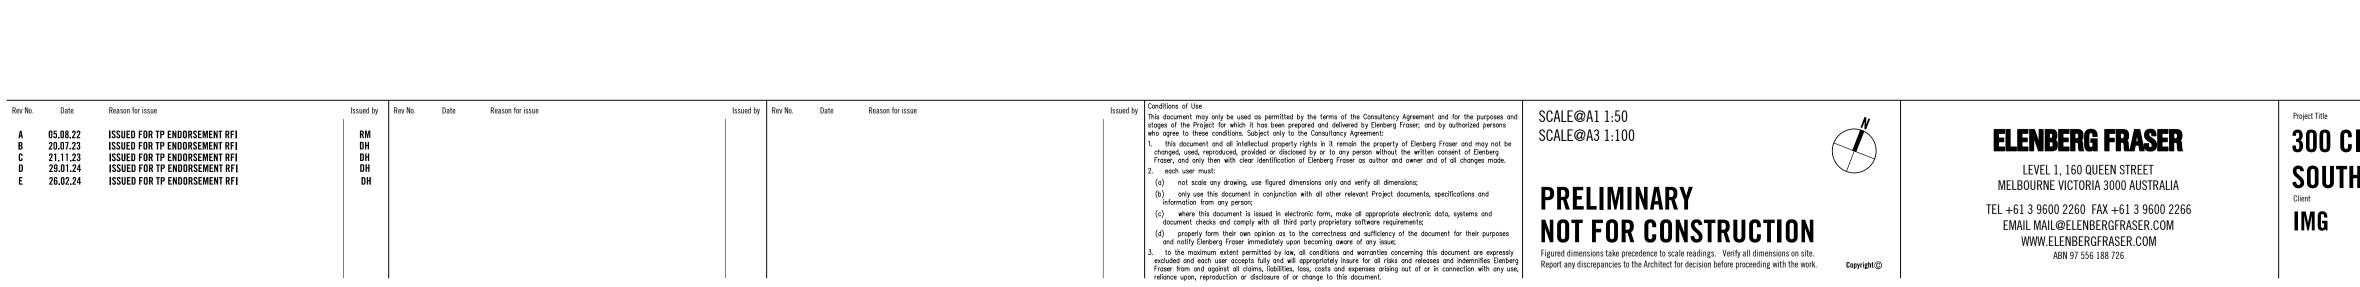


This copied document to be made available for the sole purpose of enabling its consideration and review as part of a planning process under the Planning and Environment Act 1987. The document must not be used for any purpose which may breach any copyright

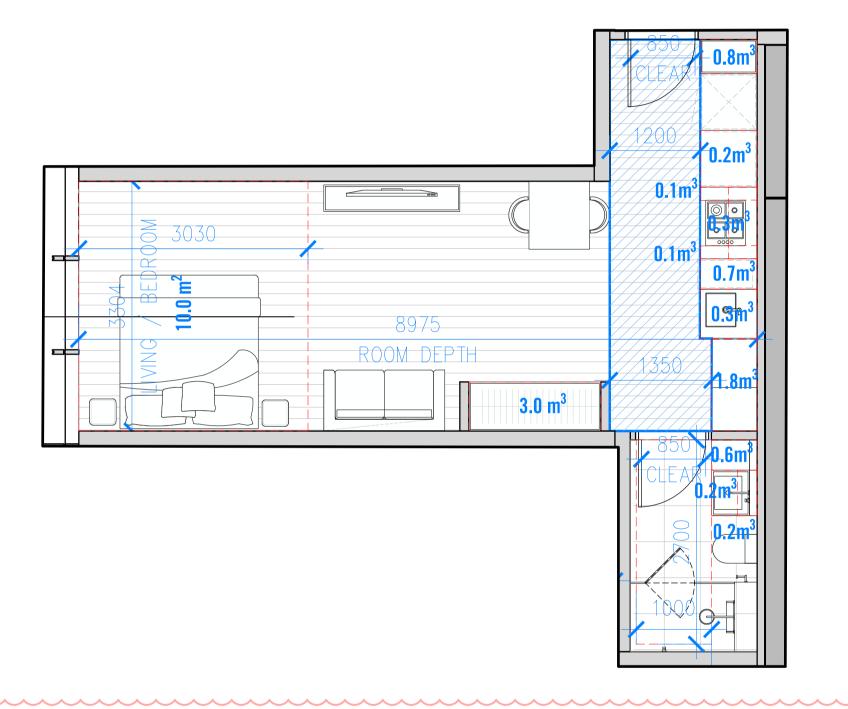

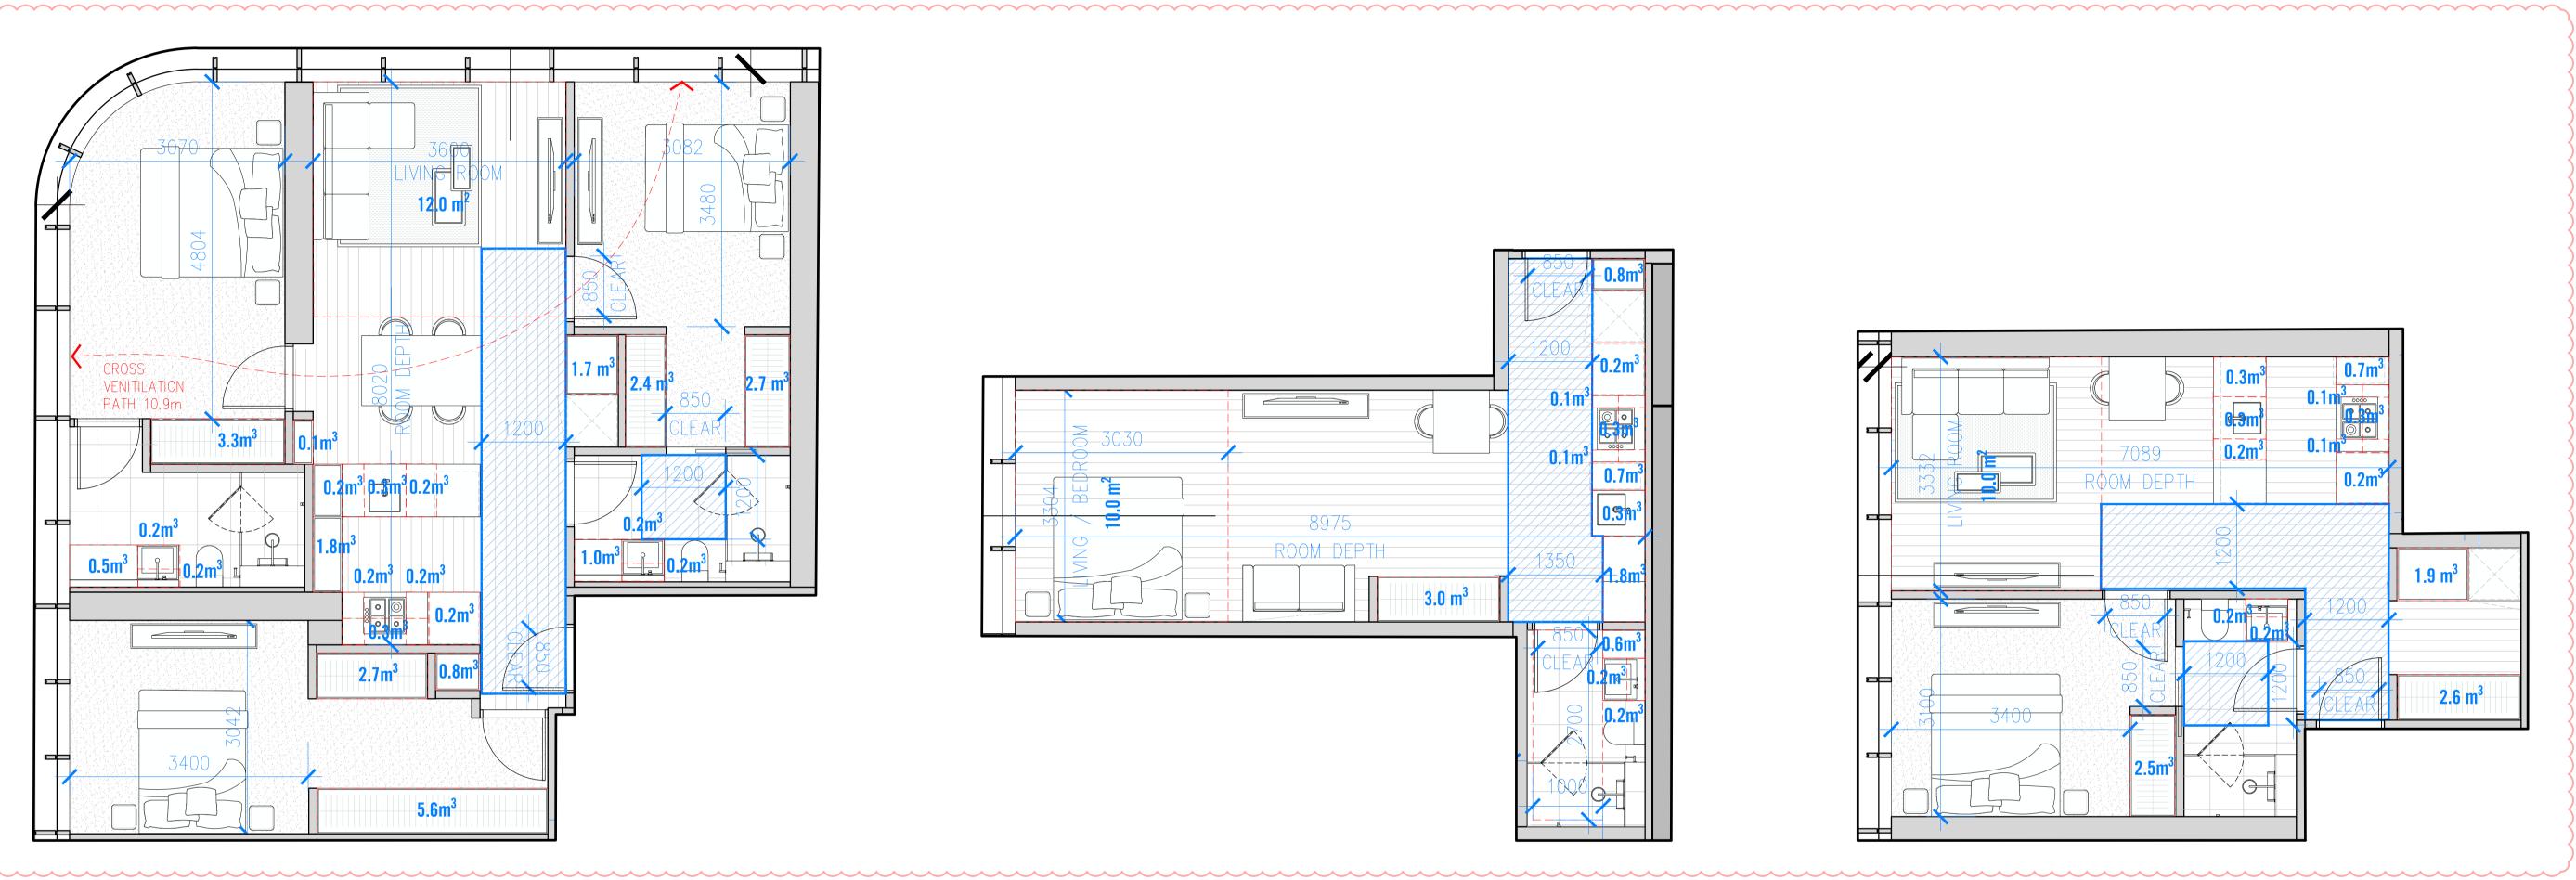

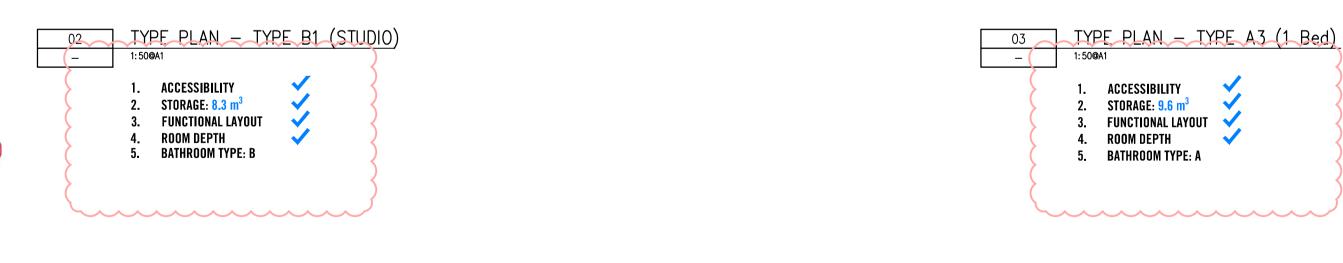



CITY ROAD Thbank	APARTMENT TYPES BADS				
	Project Number	Drawing Number			
	17155	A2501			
	Drawing Status	Revision			
	TP	E			
		Feb 26, 2024 – 7:48pm			

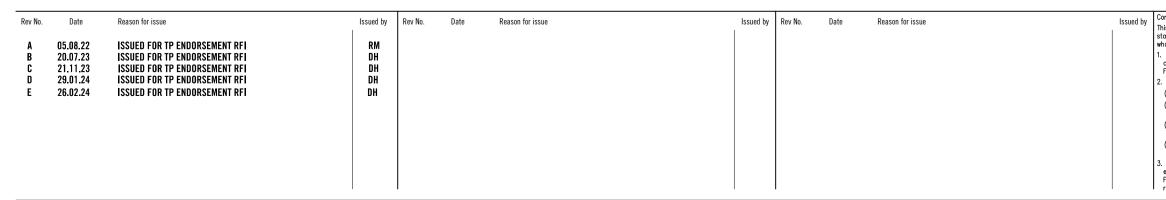

# ADVERTISED PLAN

This copied document to be made available for the sole purpose of enabling its consideration and review as part of a planning process under the Planning and Environment Act 1987. The document must not be used for any purpose which may breach any copyright

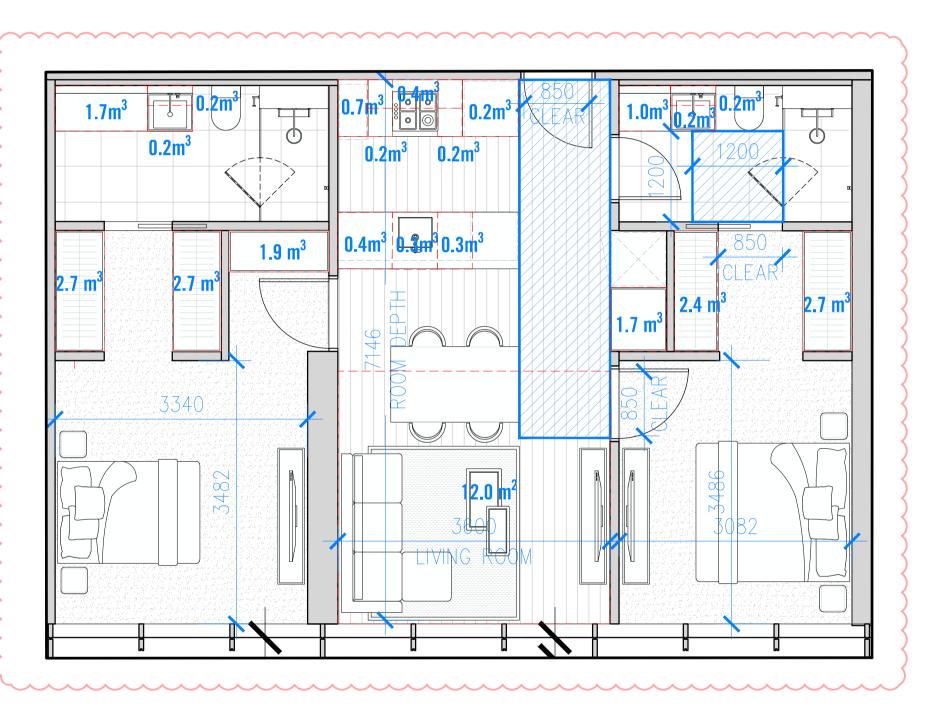

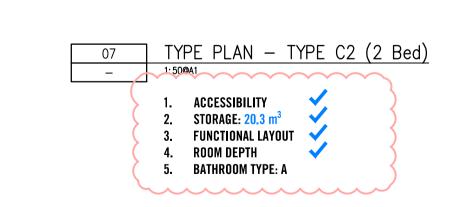

(a) not scale any drawing, use figured dimensions only and verify all dimensions; (b) only use this document in conjunction with all other relevant Project documents, specifications and information from any person;

information from any person;
(c) where this document is issued in electronic form, make all appropriate electronic data, systems and document checks and comply with all third party proprietary software requirements;
(d) properly form their own opinion as to the correctness and sufficiency of the document for their purposes and notify Elenberg Fraser immediately upon becoming aware of any issue;
3. to the maximum extent permitted by law, all conditions and warranties concerning this document are expressly excluded and each user accepts fully and will appropriately insure for all risks and releases and indemnifies Elenberg Fraser from and against all claims, liabilities, loss, costs and expenses arising out of or in connection with any use, reliance upon, reproduction or disclosure of or change to this document.

SCALE@A1 1:50 SCALE@A3 1:100

PRELIMINARY **NOT FOR CONSTRUCTION** Figured dimensions take precedence to scale readings. Verify all dimensions on site. Report any discrepancies to the Architect for decision before proceeding with the work. **Copyright**©

**ELENBERG FRASER** 

LEVEL 1, 160 QUEEN STREET MELBOURNE VICTORIA 3000 AUSTRALIA TEL +61 3 9600 2260 FAX +61 3 9600 2266 EMAIL MAIL@ELENBERGFRASER.COM WWW.ELENBERGFRASER.COM ABN 97 556 188 726

IMG

Project Title

## **300 CITY ROAD** SOUTHBANK

Drawing Title **APARTMENT TYPES** BADS Project Number



Drawing Number A2502 Revision Feb 26, 2024 – 7:52pm