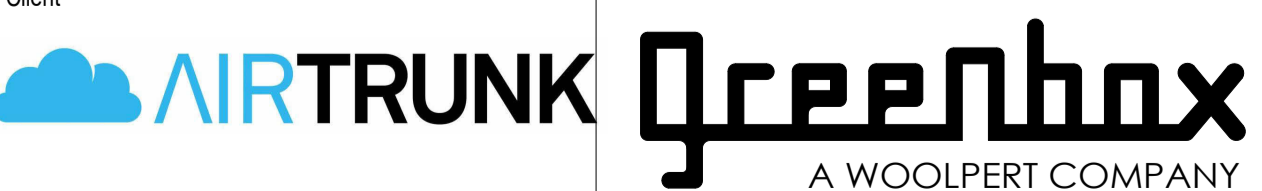


# PROPOSED DATA CENTRE


85 - 95 SHARPS RD, TULLAMARINE, VIC, 3043

## PLANNING PERMIT APPLICATION


DRAWING NO.	DRAWING TITLE	REV
DA000	COVER SHEET	1 (S)
DA001	LOCALITY/CONTEXT PLAN/ SITE ANALYSIS	E
DA002	DEMOLITION PLAN	D
DA010	OVERALL SITE PLAN	(S)
DA011	OVERALL LEVEL 1 PLAN	(S)
DA012	OVERALL LEVEL 2 PLAN	(S)
DA013	OVERALL LEVEL 3 PLAN	(S)
DA014	OVERALL LEVEL 4 PLAN	D
DA015	OVERALL LEVEL 5 PLAN	D
DA016	OVERALL LEVEL 6 PLAN (LOWER ROOF)	(S)
DA017	SITE PAVING DIAGRAM	(S)
DA020	SITE ELEVATION	D
DA021	SITE SECTION	(S)
DA022	SITE SECTION	(S)
DA023	BUILDING SECTION	(S)
DA024	BUILDING SECTION	(S)
DA040	ISO VIEWS	D
DA050	PART A LEVEL 1	D
DA051	PART A LEVEL 2 (ROOF)	E
DA052	PART A LEVEL 3	E
DA053	PART B LEVEL 1	D
DA054	PART B LEVEL 2 (ROOF) (TYPICAL)	E
DA055	PART B LEVEL 3 (ROOF)	E
DA056	PART B LEVEL 4	(S)
DA057	PART C LEVEL 1	(S)
DA058	PART C LEVEL 2 (ROOF) (TYPICAL)	D
DA059	PART C LEVEL 3 (ROOF)	E
DA060	PART C LEVEL 4	E
DA061	SECURITY GUARD KIOSK DETAILS	D
DA062	SUBSTATION AND 1 DETAILS	(S)
DA063	JEKUNA USE DETAILS	(S)
DA064	PUMP ROOM DETAILS	D



AD	Issue	Date	Description	Notes	Key Plan	Project Manager	Client		<ul style="list-style-type: none"> <li>Use written dimensions only</li> <li>Do not scale from drawing</li> <li>Contractors shall confirm all dimensions on-site prior to commencing any work or producing any shop drawings</li> <li>All materials to be used in accordance with the manufacturer's specifications and instructions and shall comply with the relevant Australian Standards</li> <li>Copyright of this drawing and design remain the property of Greenbox Architecture Pty Ltd</li> <li>Nominated Architect - Gerard Page; NSW reg No. 7247; Vic reg No. 17954; QLD reg No. 4536</li> </ul>	Client	EMKC	Scale	Sheet	Scale Bar
	A	31.07.2024	FOR DA								Construction Manager	Project Status <b>DA SUBMISSION</b>	Project PROPOSED DATA CENTRE 85-95 Sharps Road Tullamarine VIC 3043	Drawn By HL



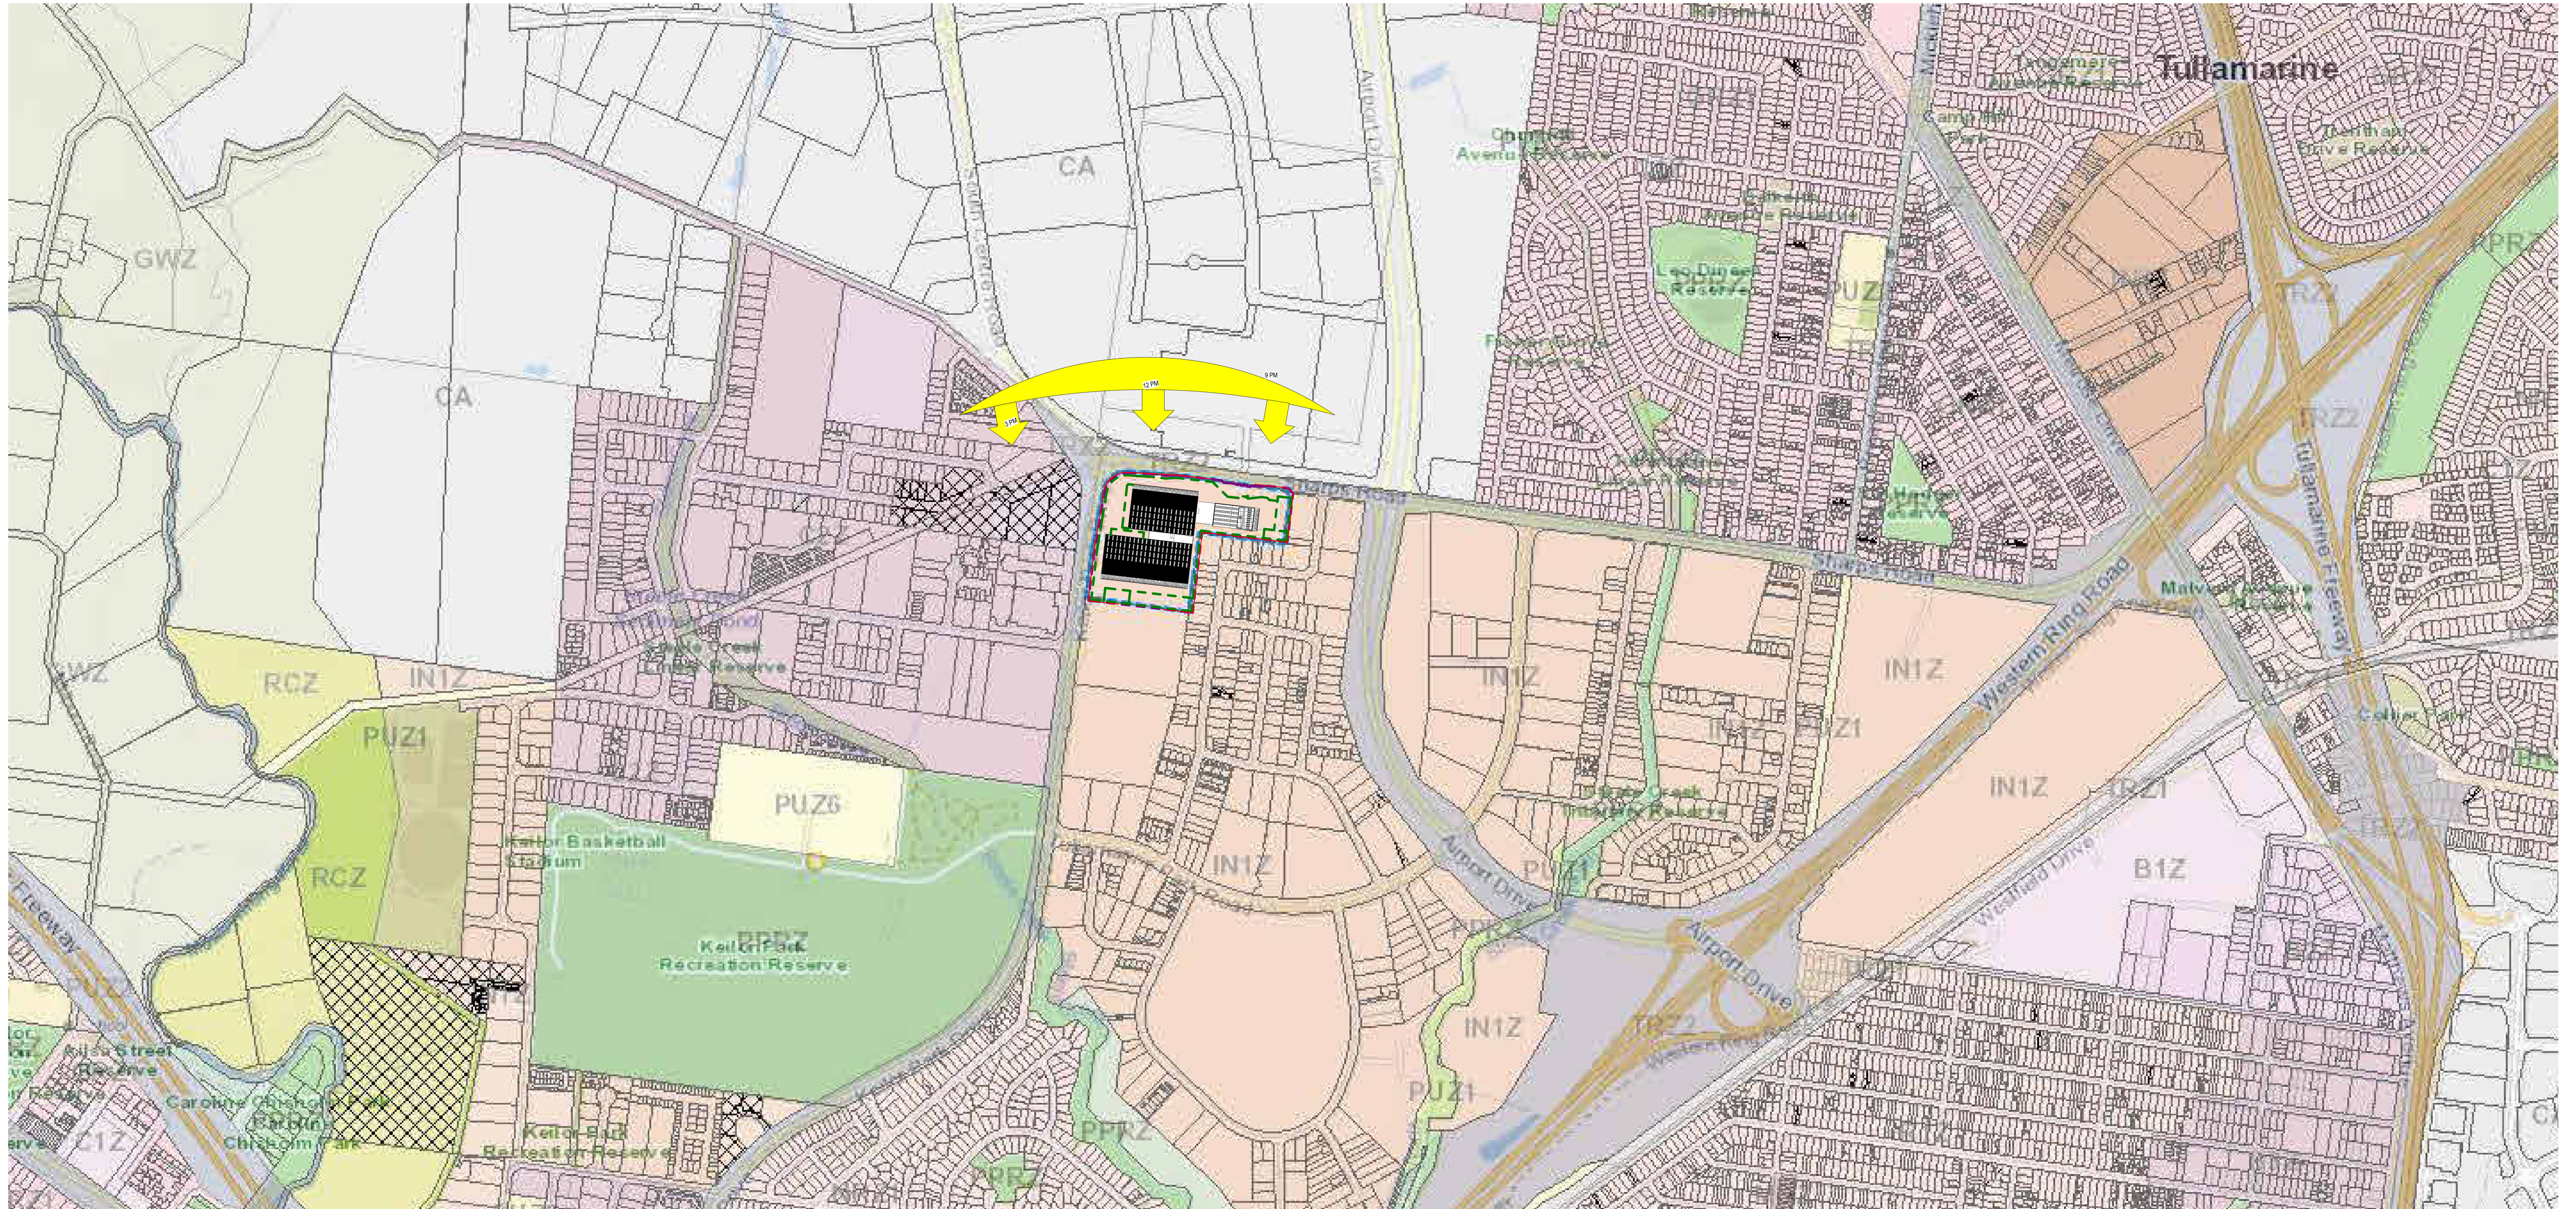


1 DA - SITE ANALYSIS  
1:5000

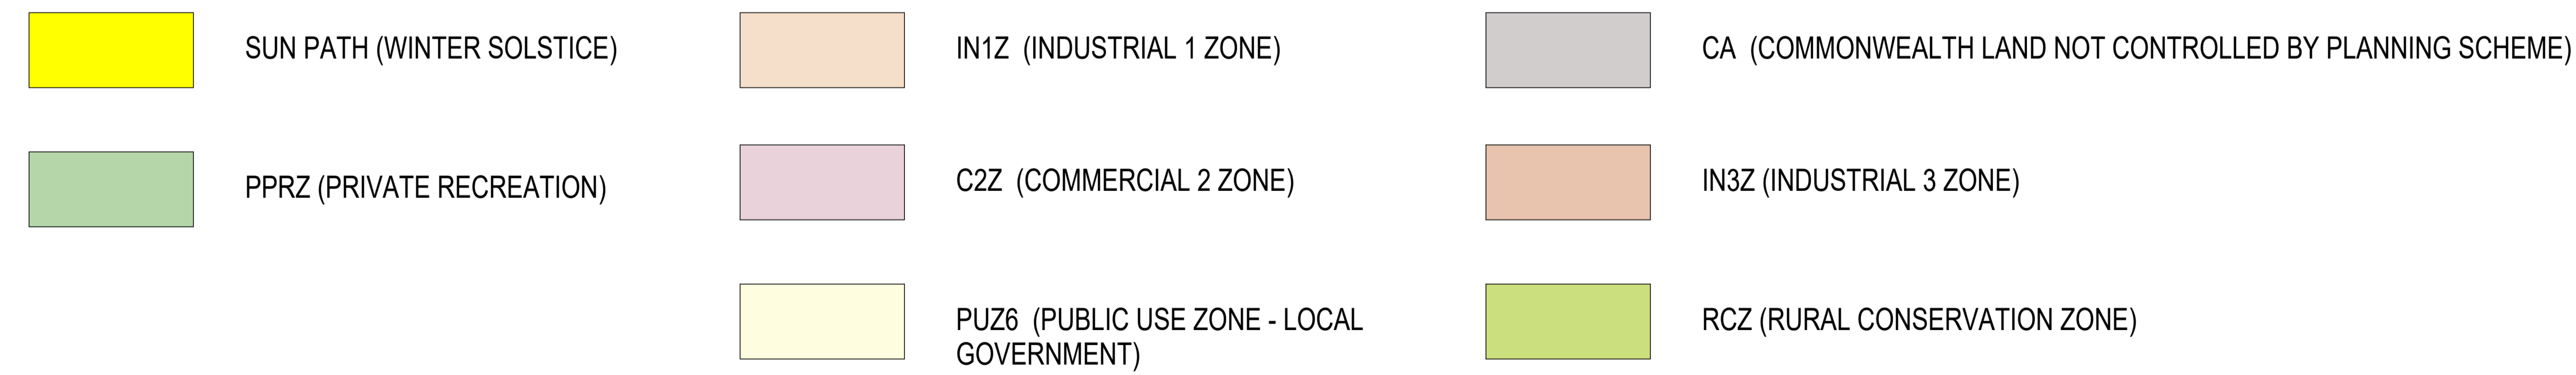


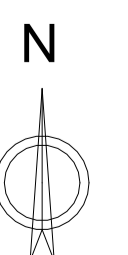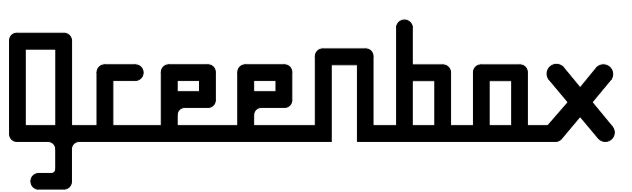



 N	Issue A Date 31.07.2024 Description FOR DA	Notes	Key Plan	Project Manager	Client	 +61 2 8069 8000 LEVEL 22 68 PITT STREET SYDNEY NSW 2000 AUSTRALIA GREENBOX ARCHITECTURE PTY LTD ABN: 79 139 779 098 ISO 9001 CERTIFIED QUALITY SYSTEM	• Use written dimensions only • Do not scale from drawing • Contractors shall confirm all dimensions on-site prior to commencing any work or producing any shop drawings • All materials to be used in accordance with the manufacturer's specifications and instructions and shall comply with the relevant Australian Standards • Copyright of this drawing and design remain the property of Greenbox Architecture Pty Ltd • Nominated Architect - Gerard Page, NSW reg No. 7247, Vic reg No. 17954, QLD reg No. 4538	Client EMKC	Scale As indicated Sheet N.T.S. Scale Bar Drawn By AN Checked By DK/SFI Approved By AD Job Number 240004	Project PROPOSED DATA CENTRE 85-86 Sharps Road Tullamarine VIC 3043	Drawing Title LOCALITY CONTEXT PLAN/ SITE ANALYSIS Drawing Number DA001 Issue E
	Issue B Date 21.08.2024 Description FOR DA							Issue C Date 26.08.2024 Description FOR DA	Issue D Date 28.08.2024 Description FOR DA	Issue E Date 03.09.2024 Description FOR DA	Construction Manager

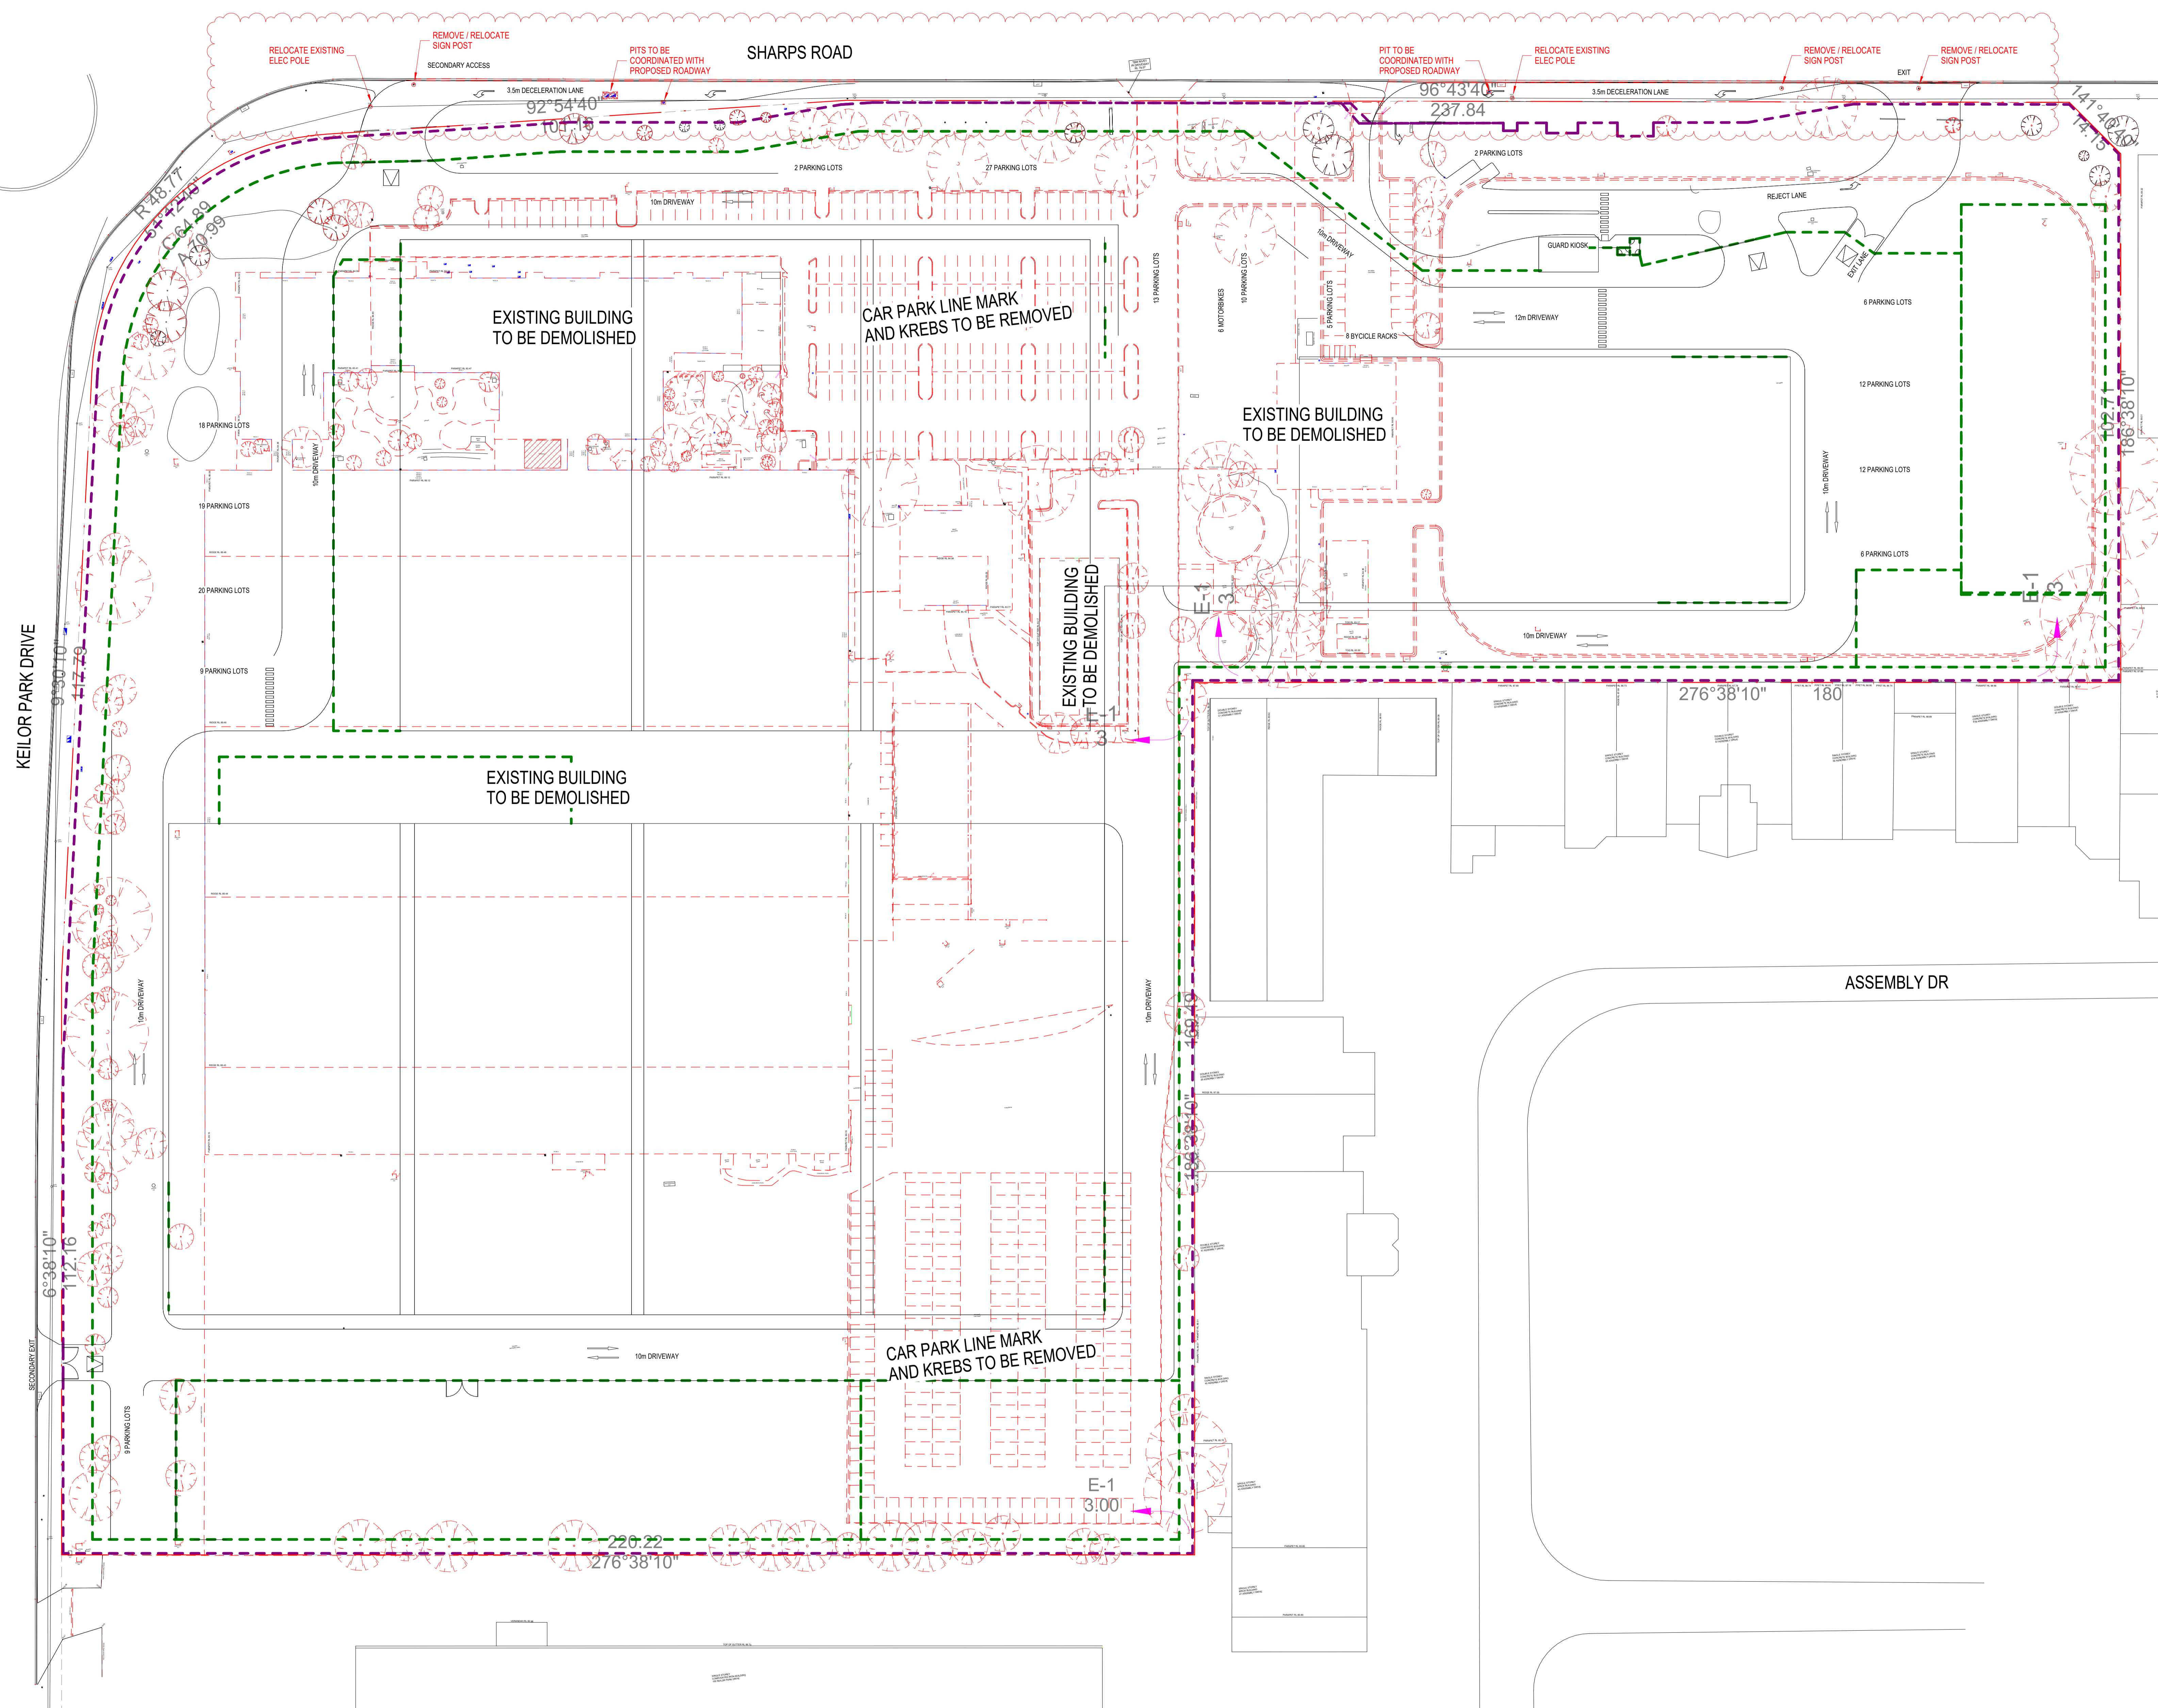

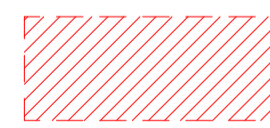


**LEGEND**

-  DEMOLISHED ELEMENTS ARE SHOWN IN RED
-  EXISTING TREES TO BE RETAINED
-  EXISTING TREES TO BE REMOVED

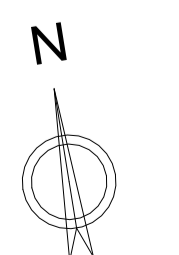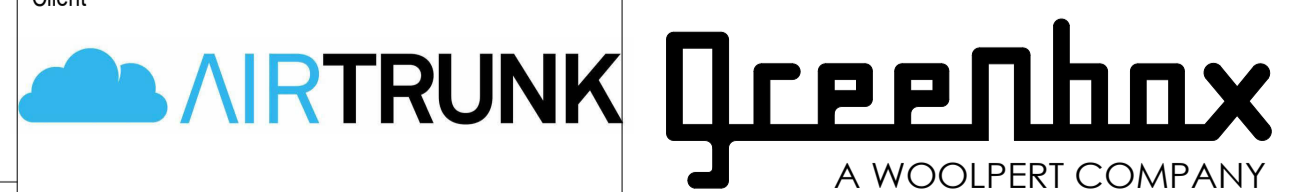	<b>Issue</b> A 31.07.2024 FOR DA B 21.08.2024 FOR DA C 28.08.2024 FOR DA D 03.09.2024 FOR DA E 18.12.2024 FOR DA	<b>Date</b> 31.07.2024 21.08.2024 28.08.2024 03.09.2024 18.12.2024	<b>Description</b> FOR DA FOR DA FOR DA FOR DA FOR DA	<b>Notes</b>	<b>Key Plan</b>	<b>Project Manager</b>	<b>Client</b>  AIRTRUNK Greenbox A WOOLPERT COMPANY	<ul style="list-style-type: none"> <li>• Use written dimensions only</li> <li>• Do not scale from drawing</li> <li>• Contractors shall confirm all dimensions on-site prior to commencing any work or producing any shop drawings</li> <li>• All materials to be used in accordance with the manufacturer's specifications and instructions and shall comply with the relevant Australian Standards</li> <li>• Copyright of this drawing and design remain the property of Greenbox Architecture Pty Ltd</li> <li>• Nominated Architect - Gerard Page; NSW reg No. 7247; Vic reg No. 17854; QLD reg no. 4538</li> </ul>	<b>Client</b> EMKC	<b>Scale</b> 1:500	<b>Sheet</b> 1:500	<b>Scale Bar</b> 0 5 10 15 25m	<b>Project</b> PROPOSED DATA CENTRE 85-86 Sharps Road Tullahoma VIC 3043	<b>Checked By</b> DK/SFI	<b>Drawing Title</b> DEMOLITION PLAN	<b>Approved By</b> AD	<b>Drawing Number</b> 240004	<b>Issue</b> DA005 G
	<b>Construction Manager</b>	+61 2 8069 8600 LEVEL 22 68 PITT STREET SYDNEY NSW 2000 AUSTRALIA	GREENBOX ARCHITECTURE PTY LTD ABN: 79 139 779 098 ISO 9001 CERTIFIED QUALITY SYSTEM	<b>Job Number</b> 240004	<b>Issue</b> DA005 G													



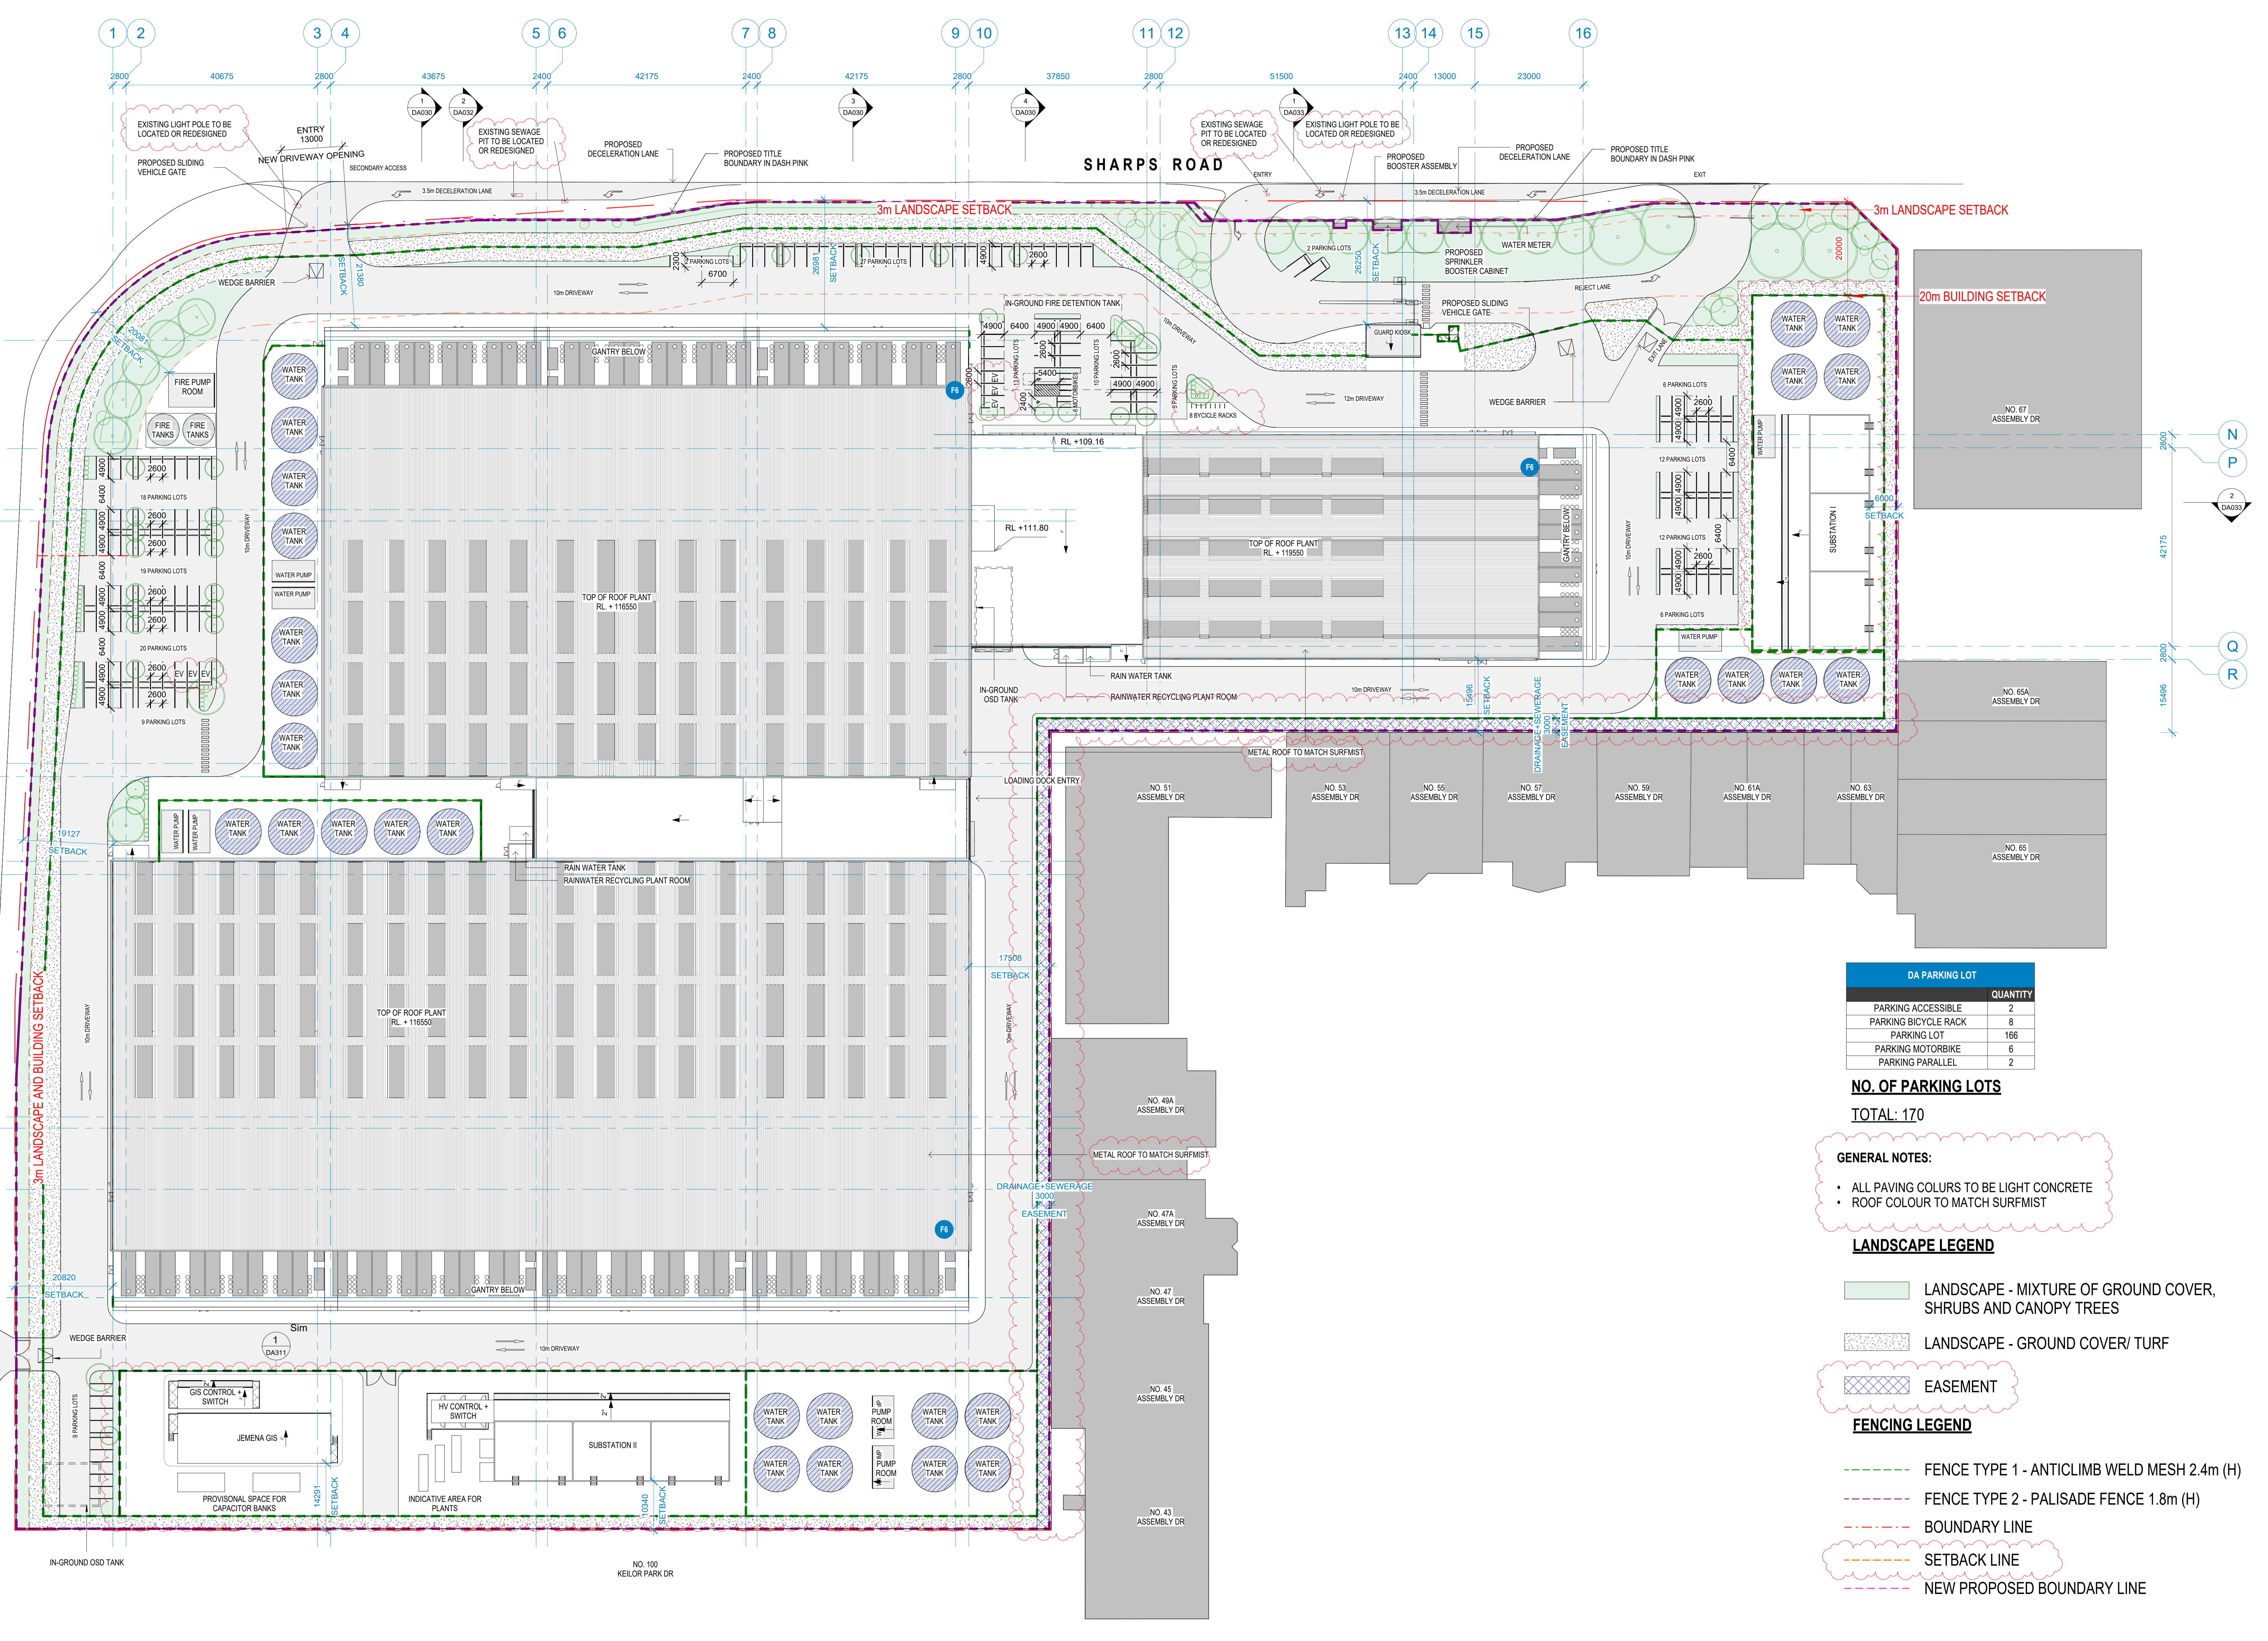

DA PARKING LOT	QUANTITY
PARKING ACCESSIBLE	2
PARKING BICYCLE RACK	8
PARKING MOTORBIKE	168
PARKING PARALLEL	2

**NO. OF PARKING LOTS**  
TOTAL: 170

**GENERAL NOTES:**

- ALL PAVING COLOURS TO BE LIGHT CONCRETE
- ROOF COLOUR TO MATCH SURFMIST

**LANDSCAPE LEGEND**

- LANDSCAPE - MIXTURE OF GROUND COVER, SHRUBS AND CANOPY TREES
- LANDSCAPE - GROUND COVER/ TURF

**FENCING LEGEND**

- FENCE TYPE 1 - ANTICLIMB WELD MESH 2.4m (H)
- FENCE TYPE 2 - PALISADE FENCE 1.8m (H)
- BOUNDARY LINE
- SETBACK LINE
- NEW PROPOSED BOUNDARY LINE

Issue	Date	Description
A	31.07.2024	FOR DA
B	21.08.2024	FOR DA
C	26.08.2024	FOR DA
D	28.08.2024	FOR DA
G	18.12.2024	FOR DA

Notes	Key Plan

Project Manager	Client

**AIRTRUNK Greenbox**  
A WOOLPERT COMPANY


+61 2 8069 8600  
LEVEL 22  
68 PITT STREET  
SYDNEY NSW 2000 AUSTRALIA

GREENBOX ARCHITECTURE PTY LTD  
ABN: 79 139 779 098  
ISO 9001 CERTIFIED QUALITY SYSTEM

• Use written dimensions only  
• Do not scale from drawing  
• Contractors shall confirm all dimensions on-site prior to commencing any work or producing any shop drawings  
• All materials to be used in accordance with the manufacturer's specifications and instructions and shall comply with the relevant Australian Standards  
• Copyright of this drawing and design remain the property of Greenbox Architecture Pty Ltd  
• Nominated Architect - Gerard Page, NSW reg No. 7247, Vic reg No. 17954, QLD reg no. 4538

Client	Scale	Sheet	Scale Bar
EMKC	1:500	1:500	0 5 10 15 25m
Project: PROPOSED DATA CENTRE 85-86 Sharps Road Tullahoma VIC 3043	Checked By: DK/SFI Approved By: AD	Drawing Title: OVERALL SITE PLAN	Drawing Number: DA010
Job Number: 240004	Issue: G		



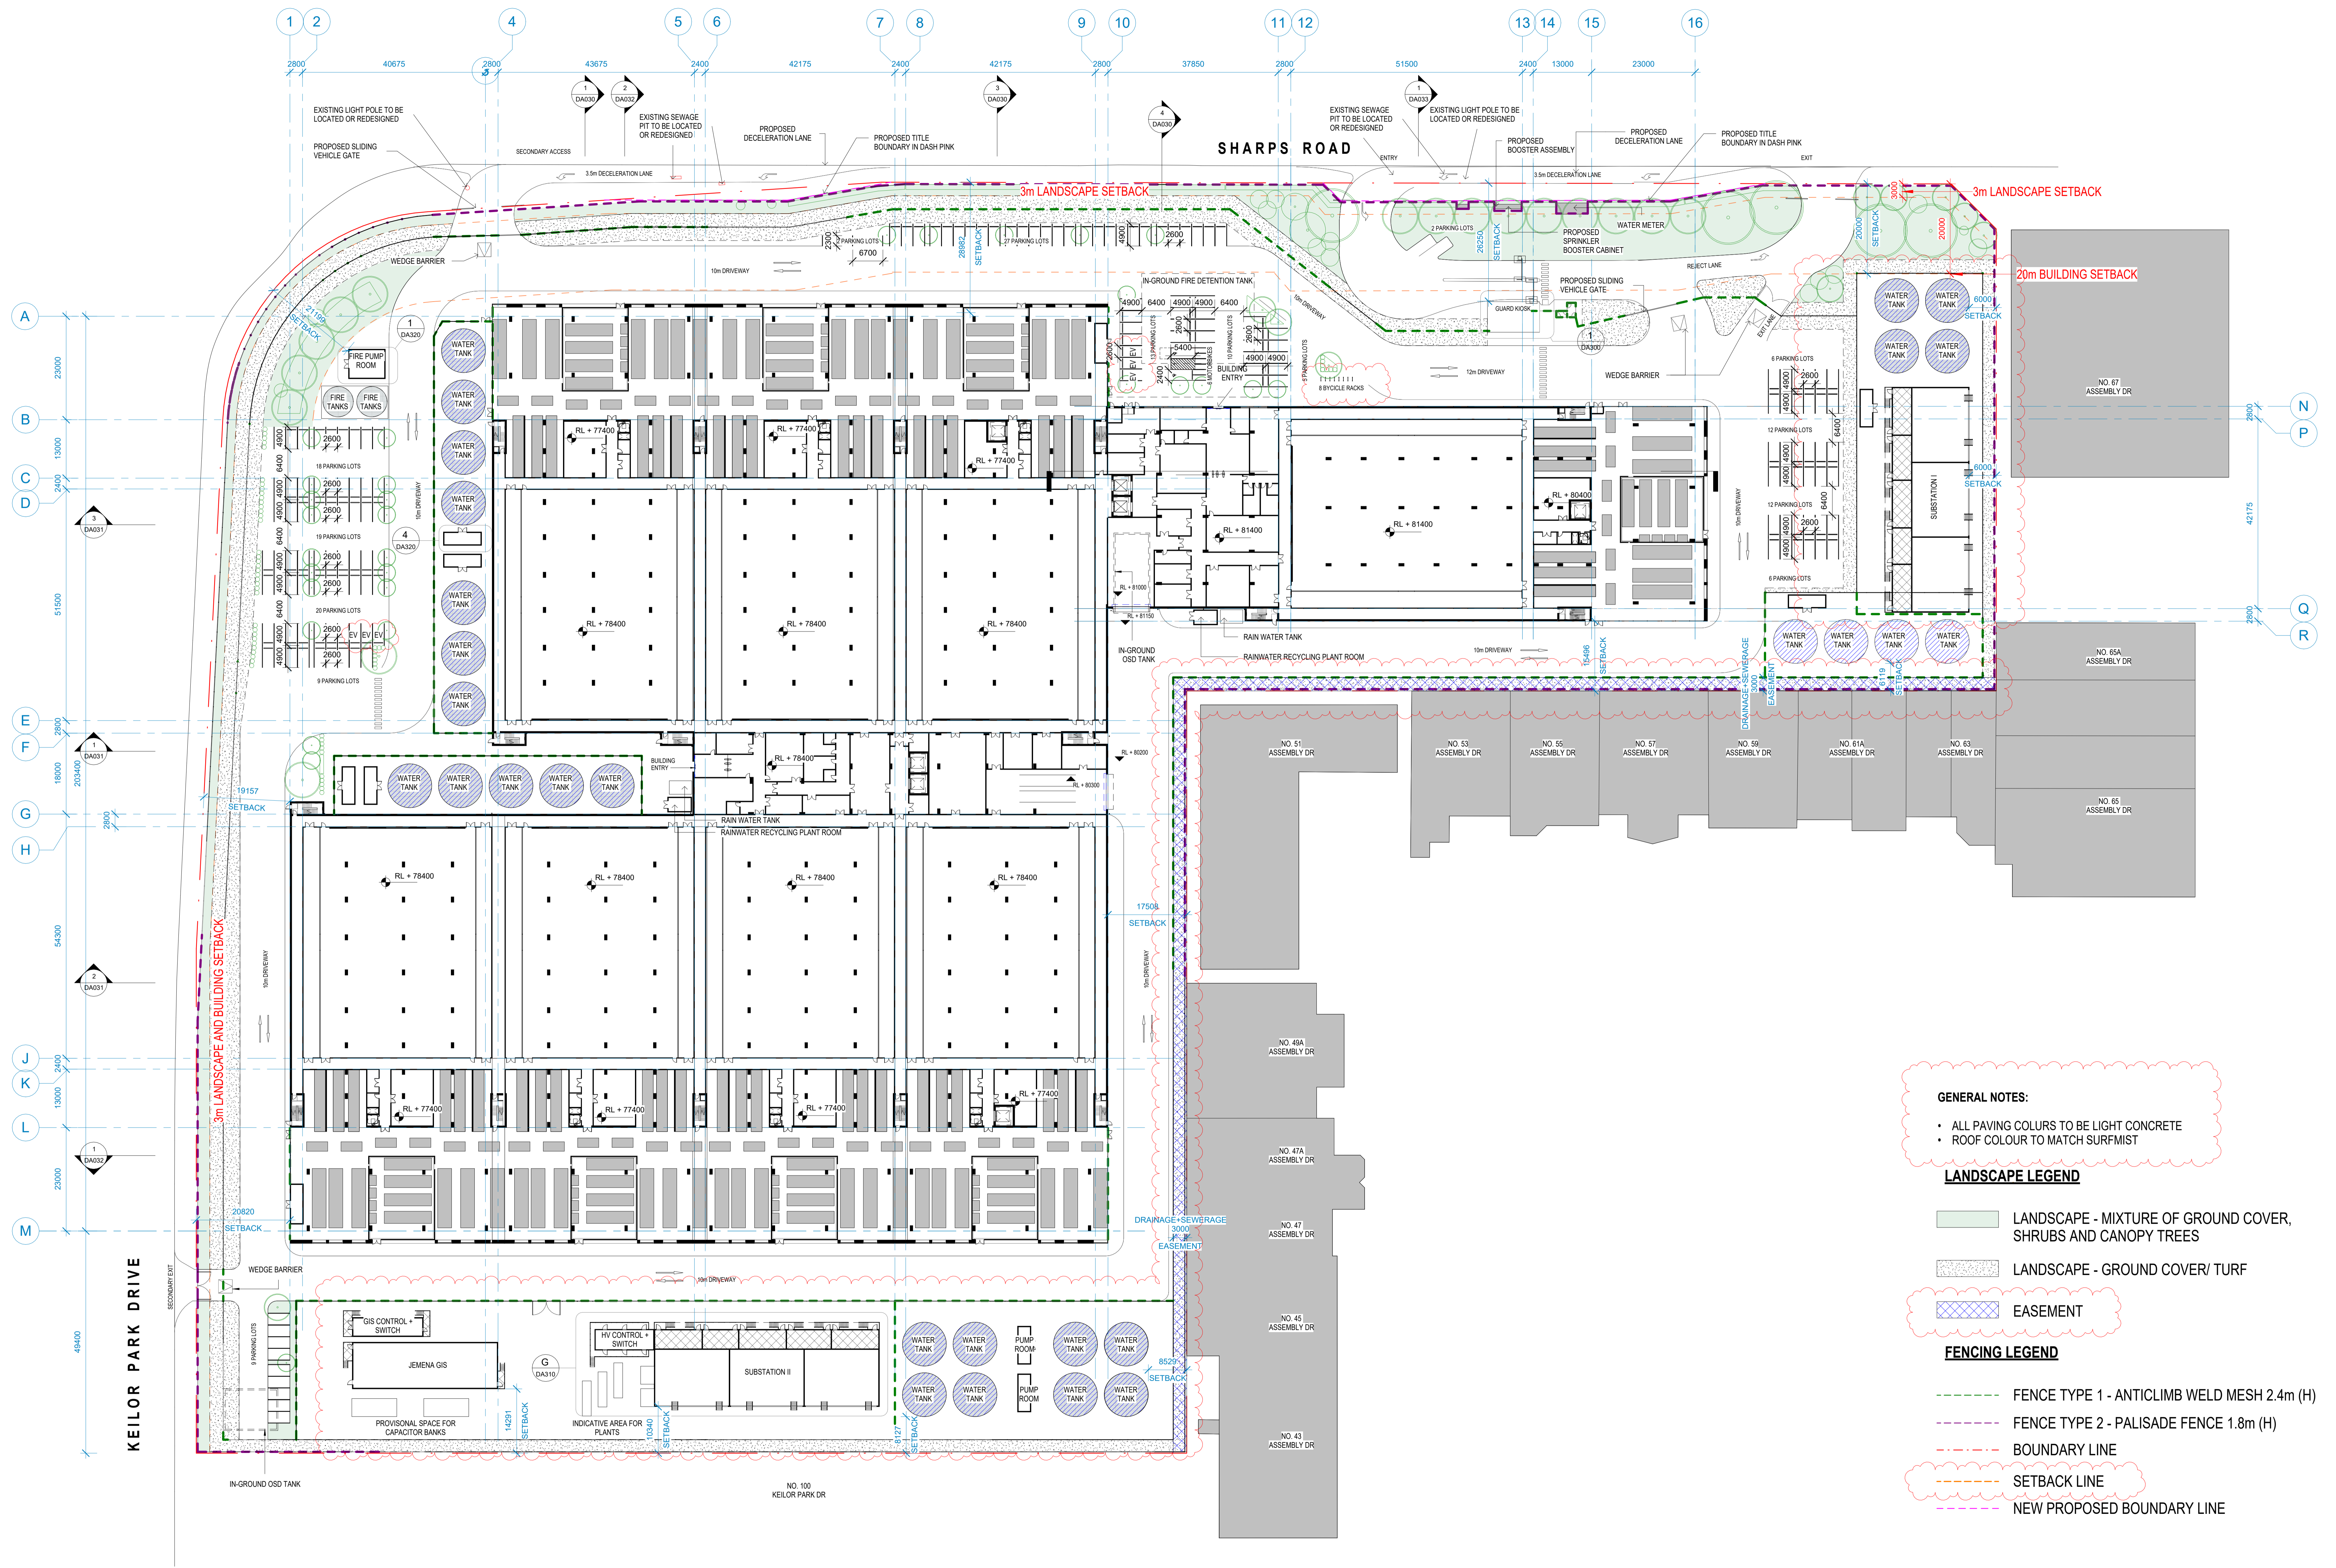

**GENERAL NOTES:**

- ALL PAVING COLOURS TO BE LIGHT CONCRETE
- ROOF COLOUR TO MATCH SURFMIST

**LANDSCAPE LEGEND**

- LANDSCAPE - MIXTURE OF GROUND COVER, SHRUBS AND CANOPY TREES
- LANDSCAPE - GROUND COVER/TURF
- EASEMENT

**FENCING LEGEND**

- FENCE TYPE 1 - ANTICLIMB WELD MESH 2.4m (H)
- FENCE TYPE 2 - PALISADE FENCE 1.8m (H)
- BOUNDARY LINE
- SETBACK LINE
- NEW PROPOSED BOUNDARY LINE

Issue	Date	Description
A	31.07.2024	FOR DA
B	21.08.2024	FOR DA
C	26.08.2024	FOR DA
D	28.08.2024	FOR DA
E	18.12.2024	FOR DA

Notes	Key Plan

Project Manager	Client
Construction Manager	

**AIRTRUNK Greenbox**  
A WOOLPERT COMPANY


+61 2 8069 8600  
LEVEL 22  
68 PITT STREET  
SYDNEY NSW 2000 AUSTRALIA

GREENBOX ARCHITECTURE PTY LTD  
ABN: 79 139 779 098  
ISO 9001 CERTIFIED QUALITY SYSTEM

• Use written dimensions only  
• Do not scale from drawing  
• Contractors shall confirm all dimensions on-site prior to commencing any work or producing any shop drawings  
• All materials to be used in accordance with the manufacturer's specifications and instructions and shall comply with the relevant Australian Standards  
• Copyright of this drawing and design remain the property of Greenbox Architecture Pty Ltd  
• Nominated Architect - Gerard Page, NSW reg No. 7247, Vic reg No. 17964, QLD reg No. 4538

Client	Scale	Sheet	Scale Bar
EMKC	1:500	1:500	0 5 10 15 25m
Project	Checked By	Drawing Title	
PROPOSED DATA CENTRE	DK/SFI	OVERALL LEVEL 1 PLAN	
85-86 Sharps Road Tullahoma VIC 3043	Approved By	Drawing Number	Issue
	AD	240004	DA011 G



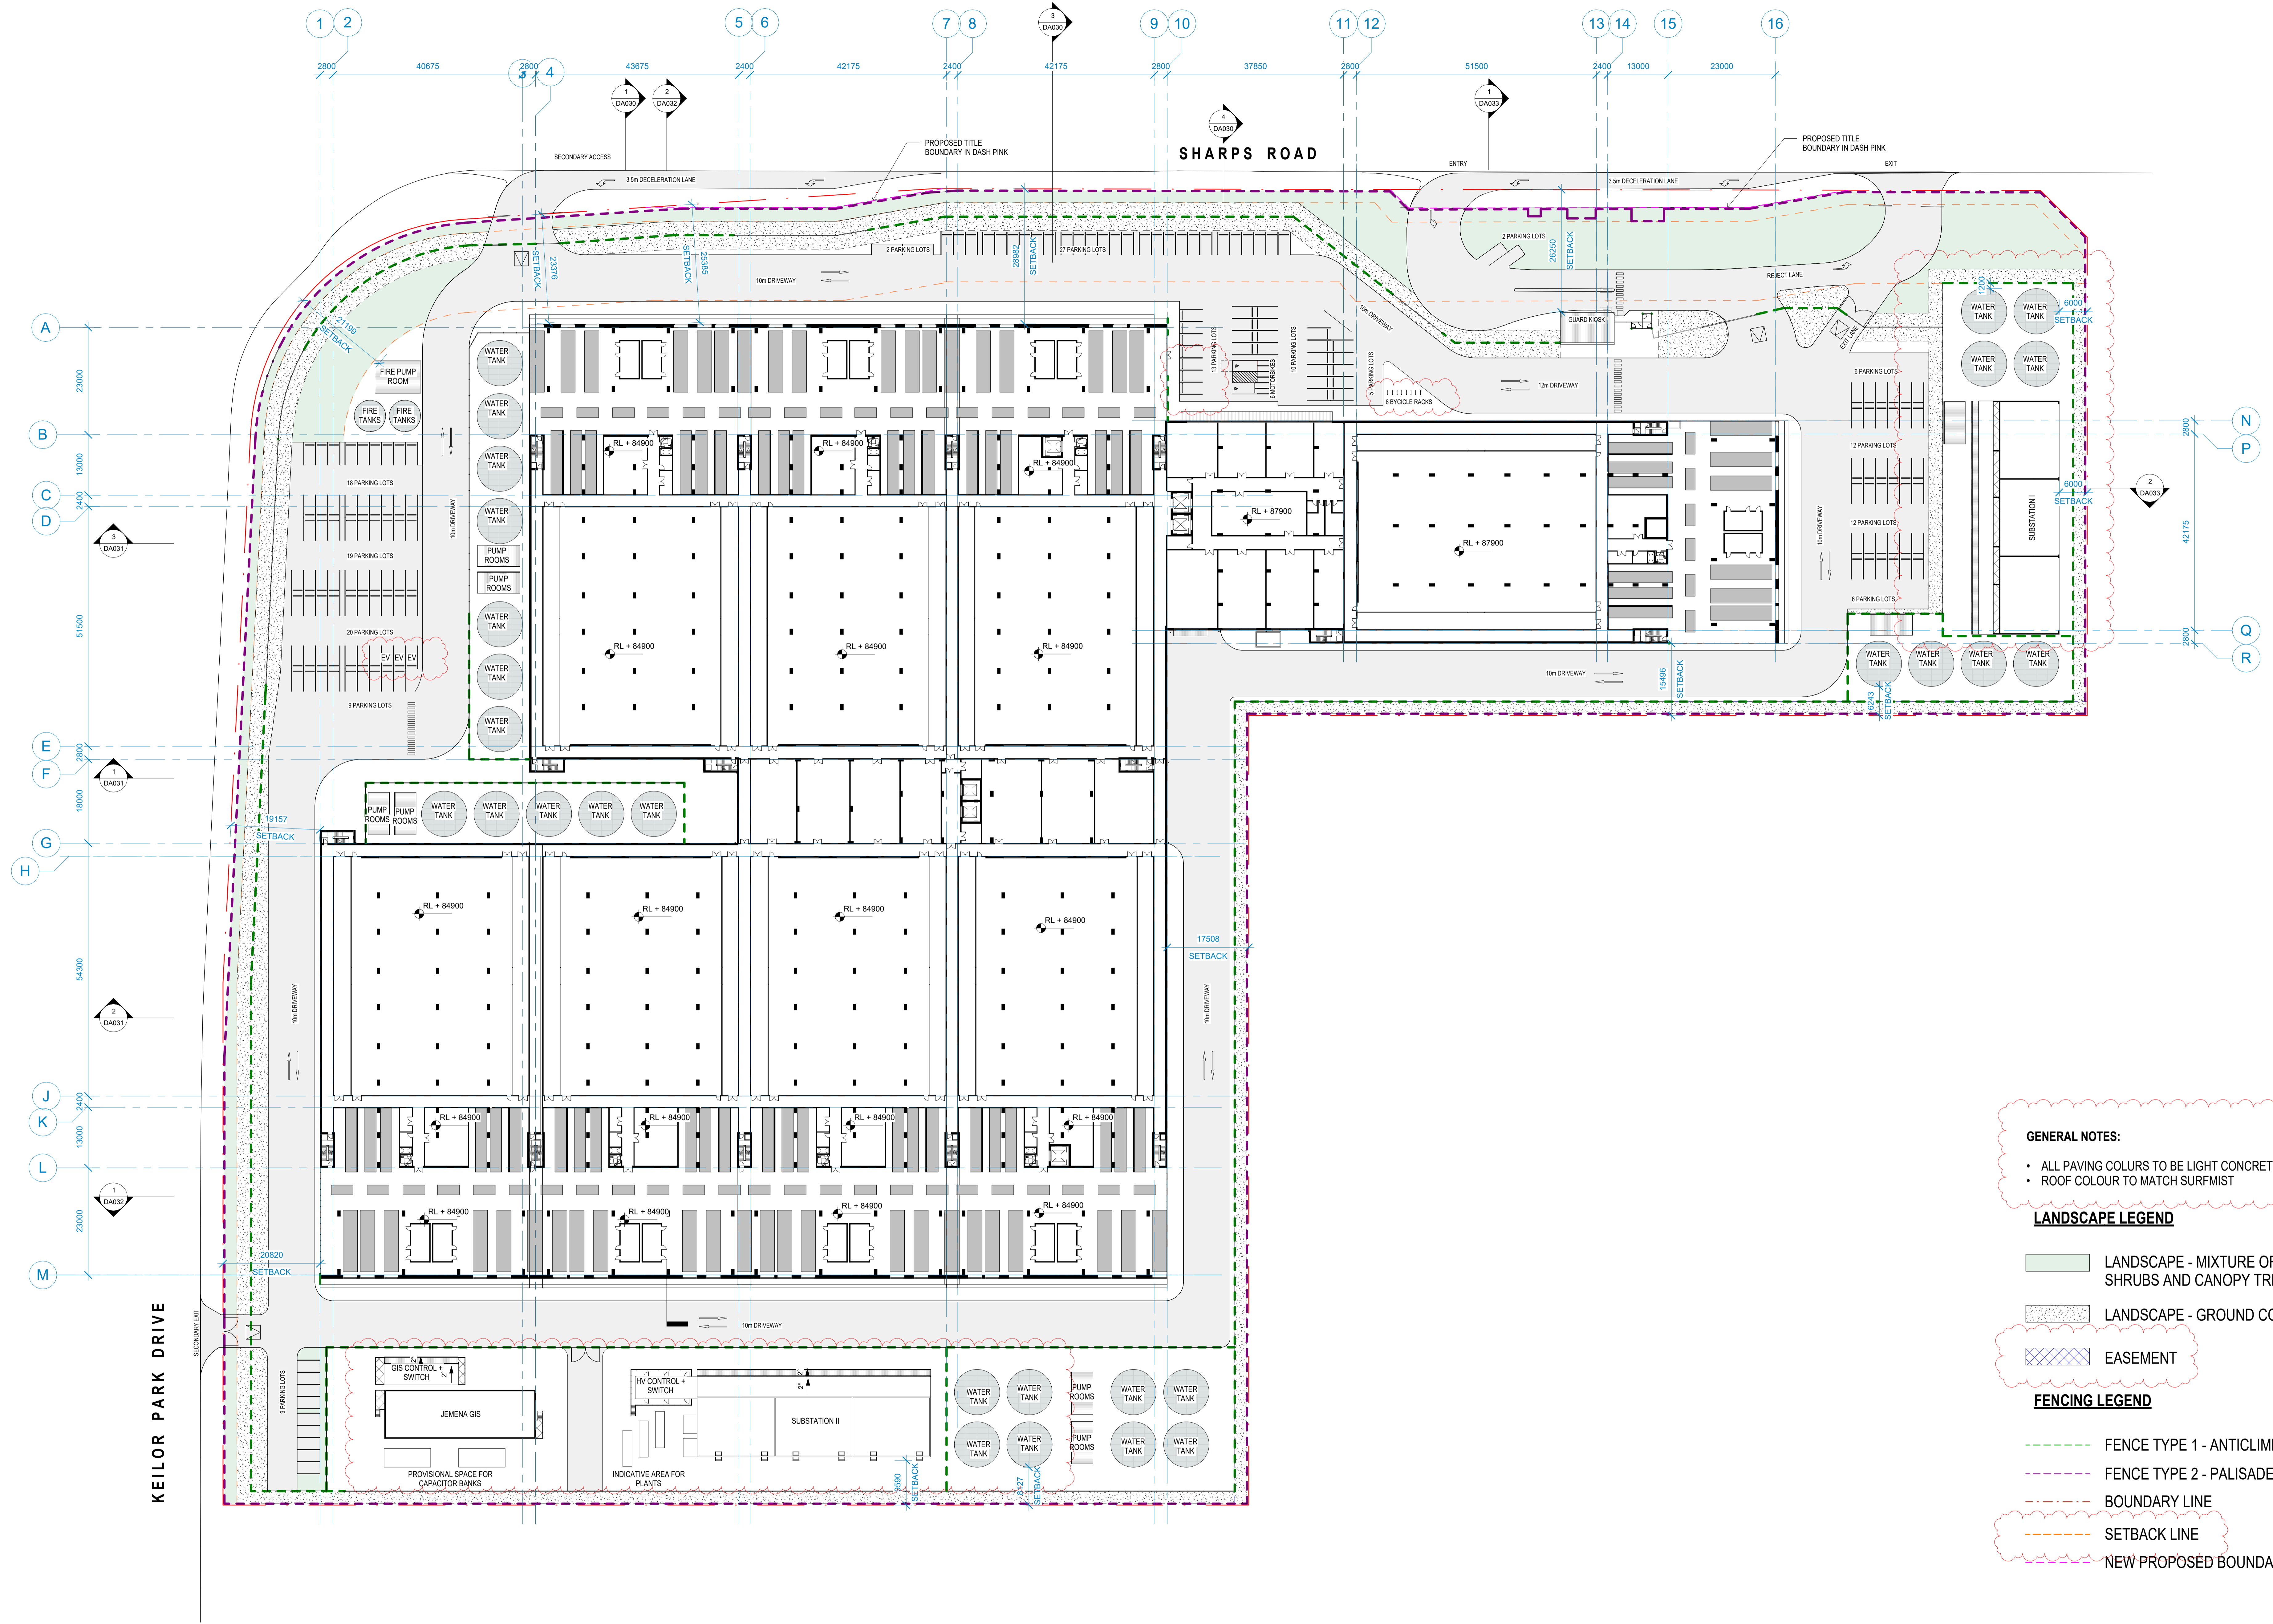

**GENERAL NOTES:**

- ALL PAVING COLURS TO BE LIGHT CONCRETE
- ROOF COLOUR TO MATCH SURFMIST

**LANDSCAPE LEGEND**


- LANDSCAPE - MIXTURE OF GROUND COVER, SHRUBS AND CANOPY TREES
- LANDSCAPE - GROUND COVER/ TURF
- EASEMENT

**FENCING LEGEND**




- FENCE TYPE 1 - ANTICLIMB WELD MESH 2.4m (H)
- FENCE TYPE 2 - PALISADE FENCE 1.8m (H)
- BOUNDARY LINE
- SETBACK LINE
- NEW PROPOSED BOUNDARY LINE

	Issue	Date	Description	Notes	Key Plan	Project Manager	Client		<ul style="list-style-type: none"> <li>• Use written dimensions only</li> <li>• Do not scale from drawing</li> <li>• Contractors shall confirm all dimensions on-site prior to commencing any work or producing any shop drawings</li> <li>• All materials to be used in accordance with the manufacturer's specifications and instructions and shall comply with the relevant Australian Standards</li> <li>• Copyright of this drawing and design remain the property of Greenbox Architecture Pty Ltd</li> <li>• Nominated Architect - Gerard Page, NSW reg No. 7247, Vic reg No. 17954, QLD reg No. 4538</li> </ul>	Client EMKC	Scale 1:500	Sheet 1:500	Scale Bar 0 5 10 15 25m																		
	A	31.07.2024	FOR DA																												
	B	21.08.2024	FOR DA																												
	C	26.08.2024	FOR DA																												
	D	28.08.2024	FOR DA																												
E	18.12.2024	FOR DA																													
<table border="1"> <tr> <td>Construction Manager</td> <td>Project</td> <td>PROPOSED DATA CENTRE</td> <td>Checked By</td> <td>DK/SFI</td> <td>Drawing Title</td> <td>OVERALL LEVEL 2 PLAN</td> </tr> <tr> <td></td> <td>Approved By</td> <td>AD</td> <td>Job Number</td> <td>240004</td> <td>Drawing Number</td> <td>DA012</td> </tr> <tr> <td></td> <td></td> <td></td> <td>Issue</td> <td></td> <td></td> <td>G</td> </tr> </table>											Construction Manager	Project	PROPOSED DATA CENTRE	Checked By	DK/SFI	Drawing Title	OVERALL LEVEL 2 PLAN		Approved By	AD	Job Number	240004	Drawing Number	DA012				Issue			G
Construction Manager	Project	PROPOSED DATA CENTRE	Checked By	DK/SFI	Drawing Title	OVERALL LEVEL 2 PLAN																									
	Approved By	AD	Job Number	240004	Drawing Number	DA012																									
			Issue			G																									

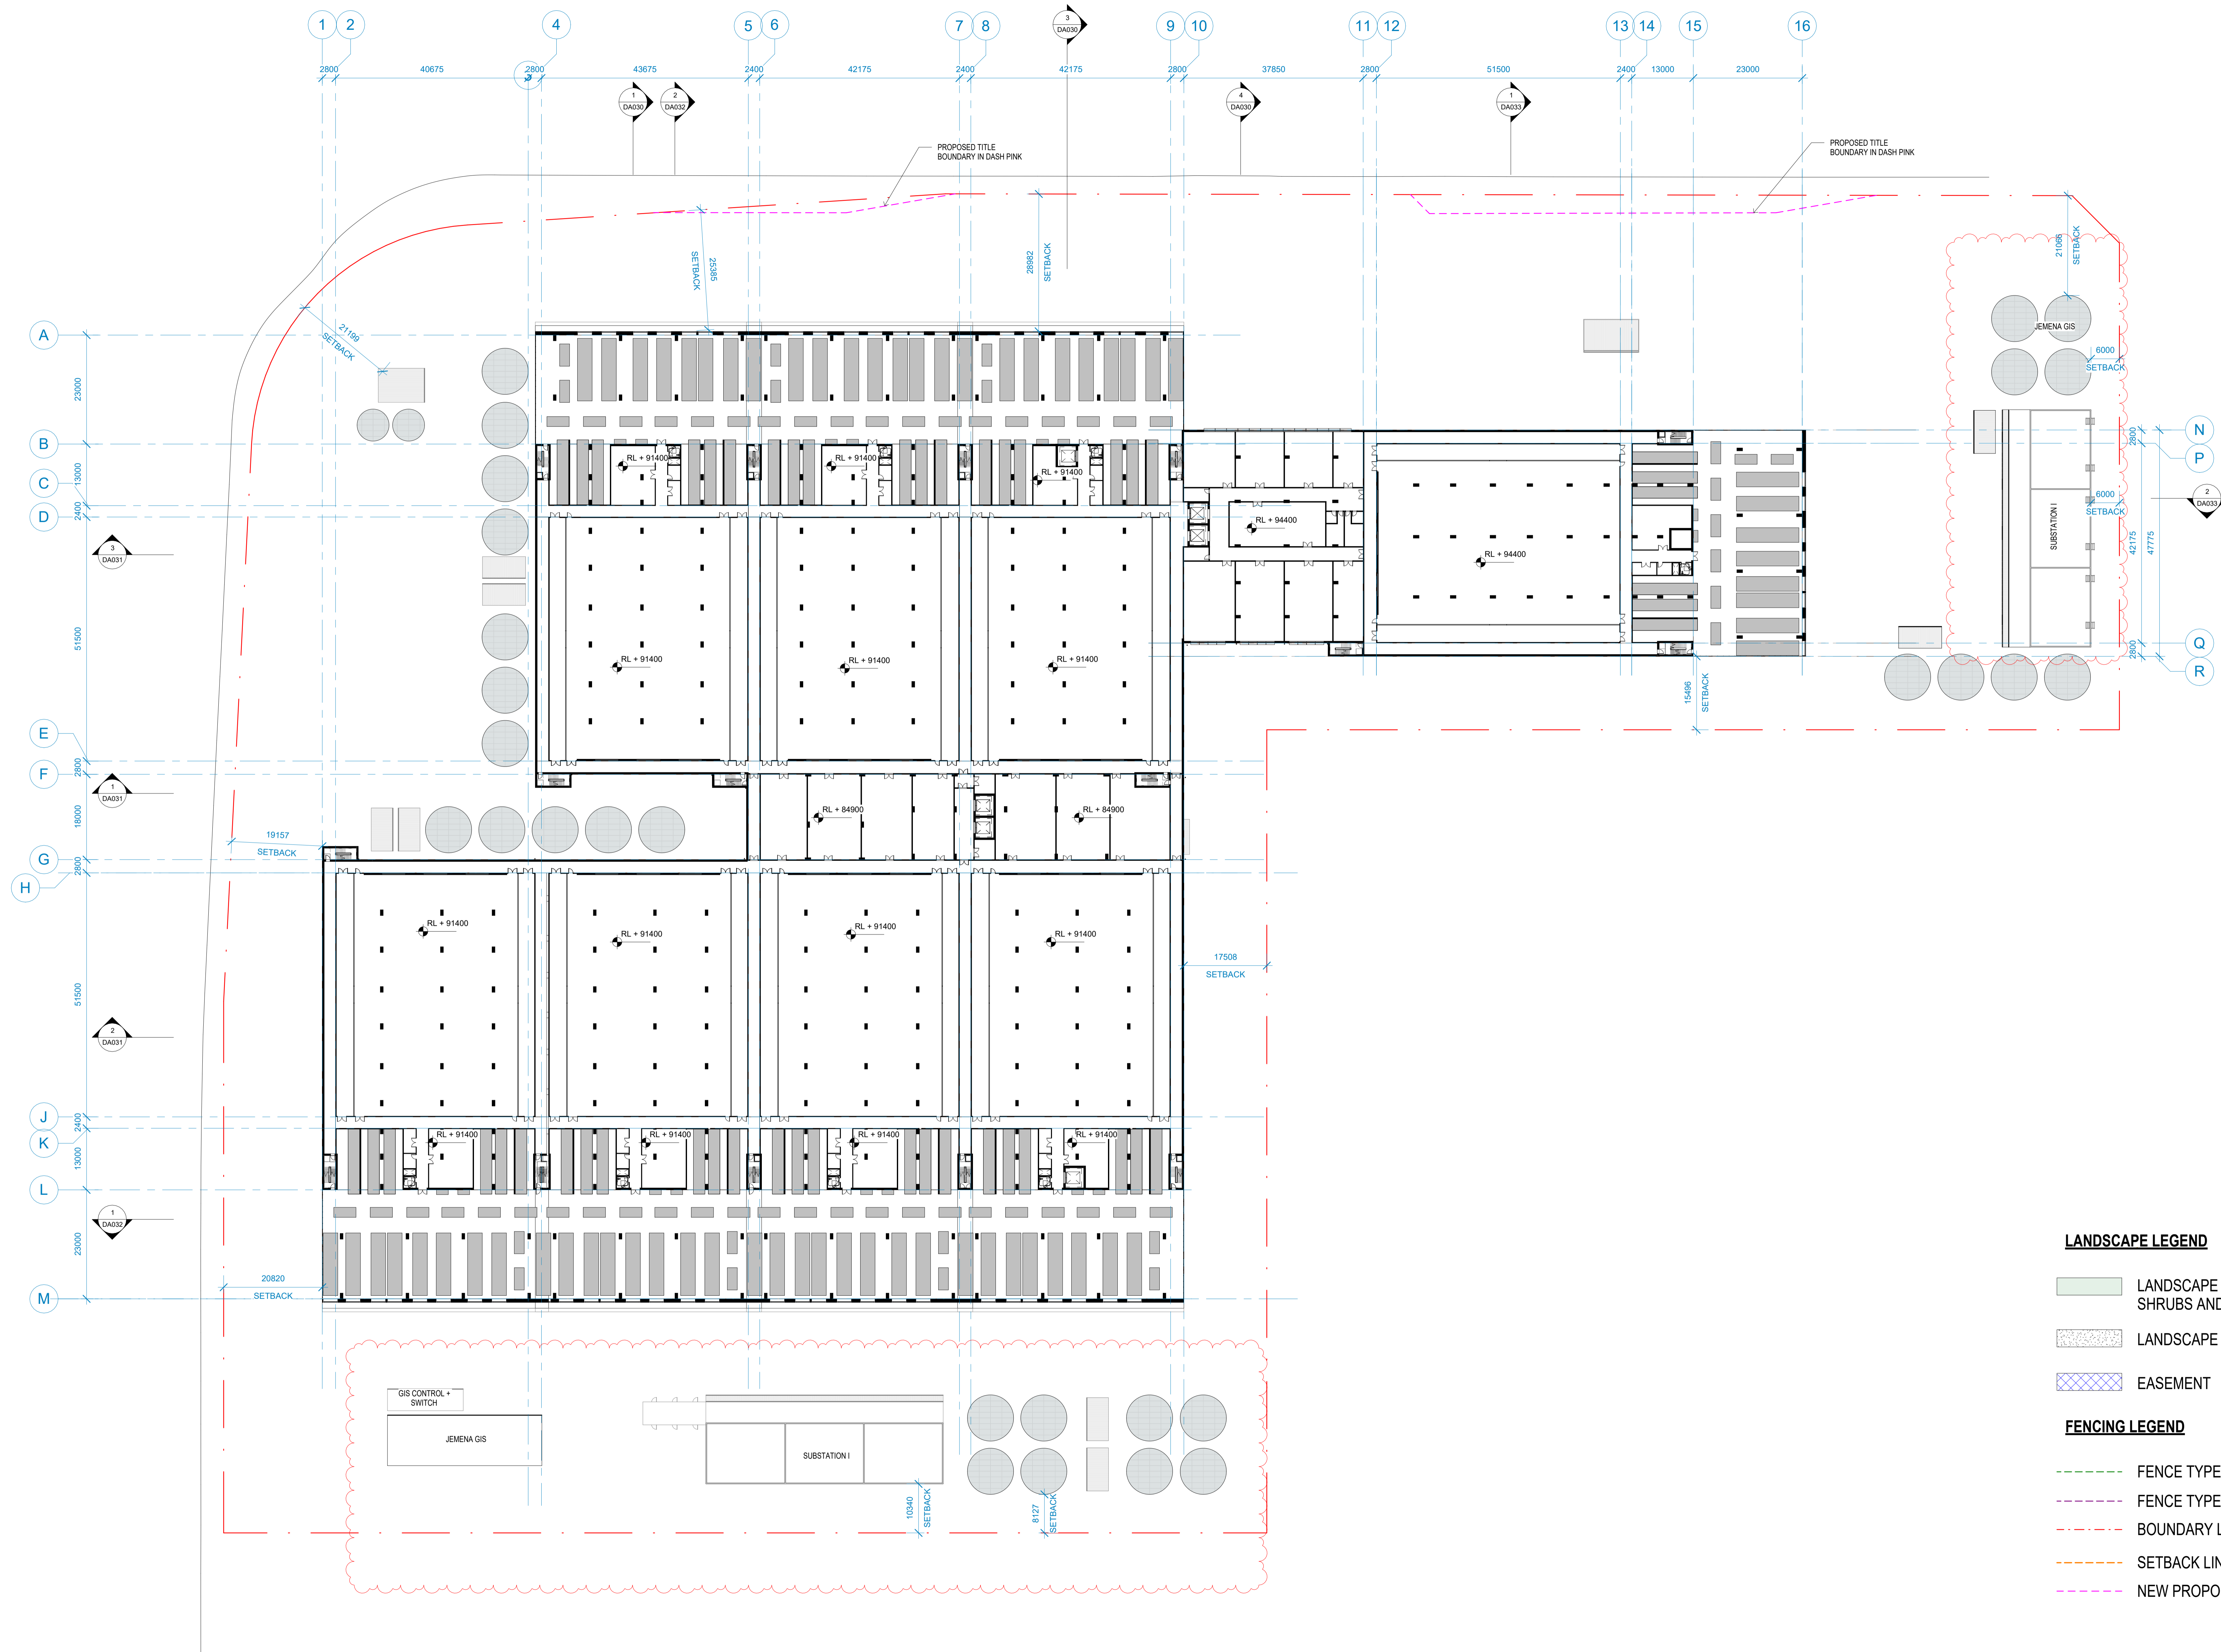









**LANDSCAPE LEGEND**

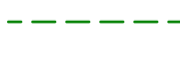-  LANDSCAPE - MIXTURE OF GROUND COVER, SHRUBS AND CANOPY TREES
-  LANDSCAPE - GROUND COVER/ TURF
-  EASEMENT

**FENCING LEGEND**

-  FENCE TYPE 1 - ANTICLIMB WELD MESH 2.4m (H)
-  FENCE TYPE 2 - PALISADE FENCE 1.8m (H)
-  BOUNDARY LINE
-  SETBACK LINE
-  NEW PROPOSED BOUNDARY LINE

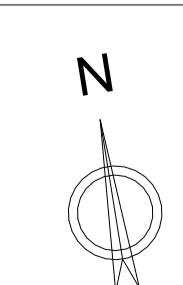

Issue	Date	Description
A	31.07.2024	FOR DA
B	21.08.2024	FOR DA
C	26.08.2024	FOR DA
D	28.08.2024	FOR DA
G	18.12.2024	FOR DA

Notes

Key Plan

Project Manager

Client



+61 2 8069 8600  
LEVEL 22  
68 PITT STREET  
SYDNEY NSW 2000 AUSTRALIA

GREENBOX ARCHITECTURE PTY LTD  
ABN: 79 139 779 098  
ISO 9001 CERTIFIED QUALITY SYSTEM

• Use written dimensions only  
• Do not scale from drawing  
• Contractors shall confirm all dimensions on-site prior to commencing any work or producing any shop drawings  
• All materials to be used in accordance with the manufacturer's specifications and instructions and shall comply with the relevant Australian Standards  
• Copyright of this drawing and design remain the property of Greenbox Architecture Pty Ltd  
• Nominated Architect - Gerard Page, NSW reg No. 7247, Vic reg No. 17954, QLD reg No. 4538

Client

EMKC


Project  
PROPOSED DATA CENTRE  
85-86 Sharps Road  
Tullahoma VIC 3043

Scale


1:500  
1:500  
Checked By  
DK/SFI  
Approved By  
AD  
Job Number  
240004

Sheet  
Scale Bar  
0 5 10 15 25m  
Project Scale  
DA SUBMISSION  
Drawing Title  
OVERALL LEVEL 3 PLAN  
Drawing Number  
DA013  
Issue  
G



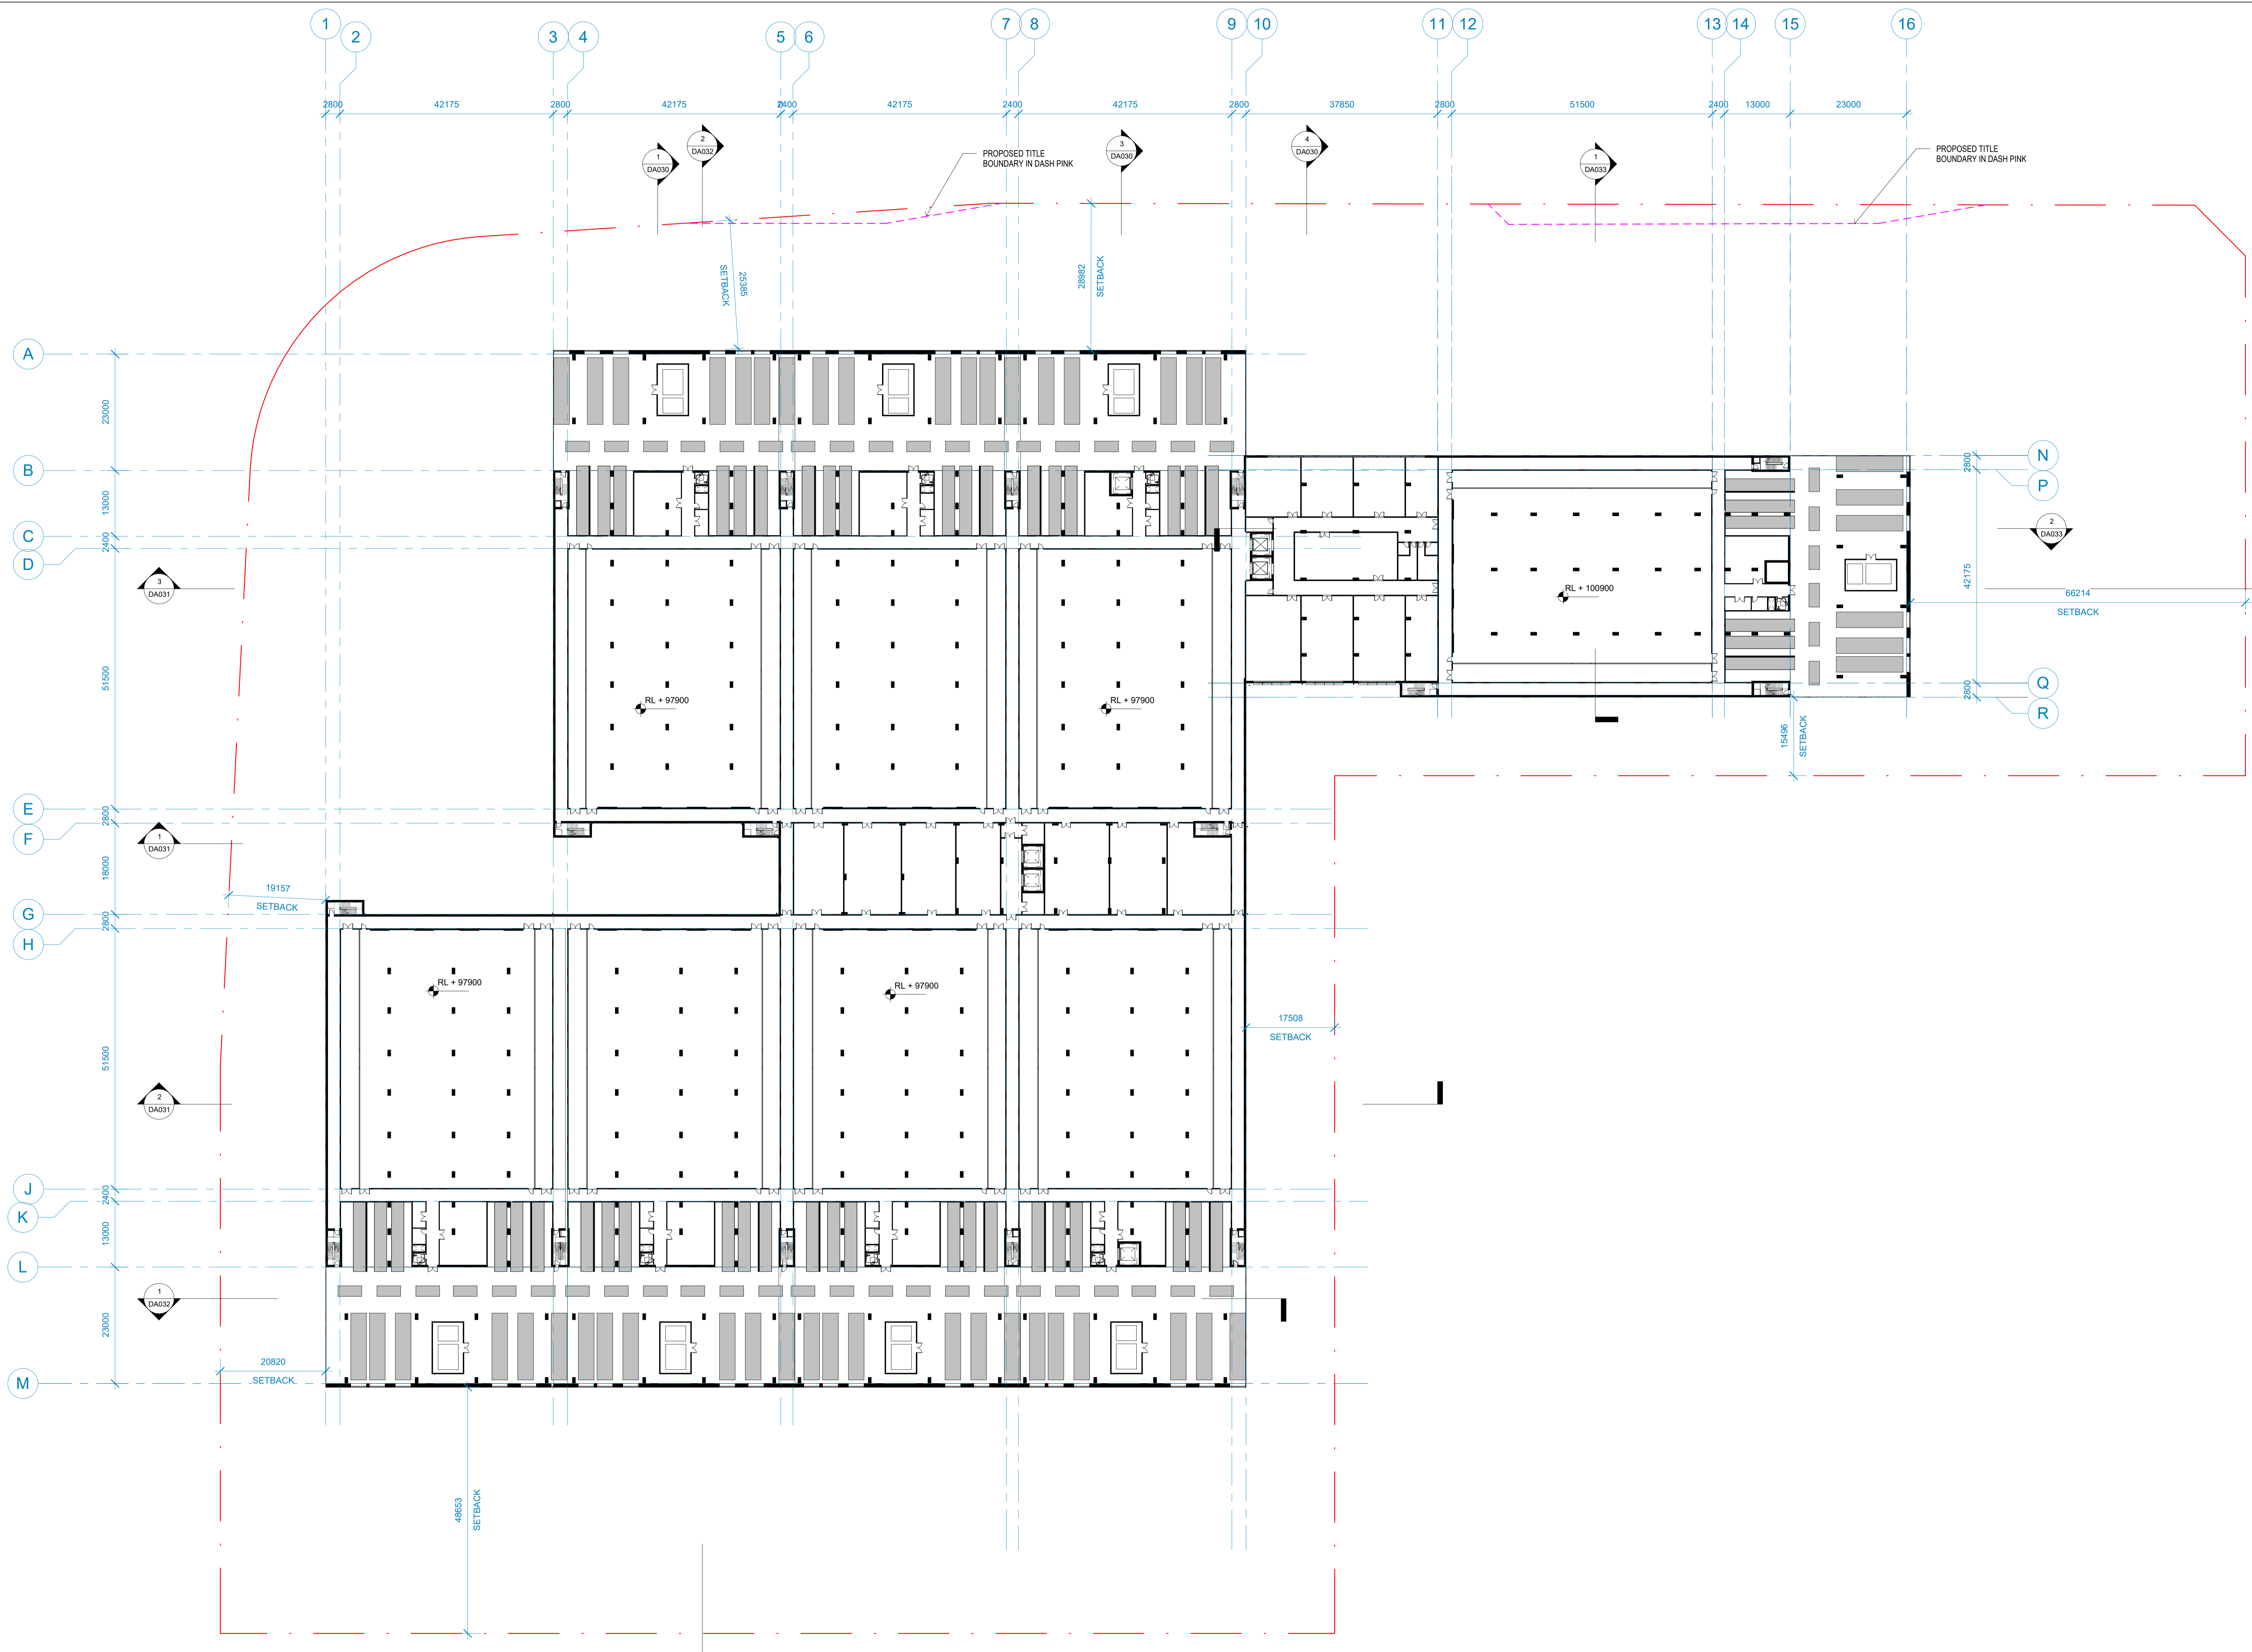

1 LEVEL 4  
1:500

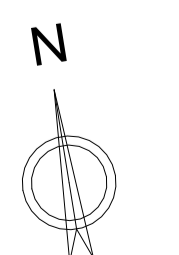

Issue	Date	Description
A	31.07.2024	FOR DA
B	21.08.2024	FOR DA
C	26.08.2024	FOR DA
D	28.08.2024	FOR DA

Notes

Key Plan

Project Manager

Client

Construction Manager



+61 2 8069 8600  
LEVEL 22  
68 PITT STREET  
SYDNEY NSW 2000 AUSTRALIA

GREENBOX ARCHITECTURE PTY LTD  
ABN: 79 139 779 098  
ISO 9001 CERTIFIED QUALITY SYSTEM

- Use written dimensions only
- Do not scale from drawing
- Contractors shall confirm all dimensions on-site prior to commencing any work or producing any shop drawings
- All materials to be used in accordance with the manufacturer's specifications and instructions and shall comply with the relevant Australian Standards
- Copyright of this drawing and design remain the property of Greenbox Architecture Pty Ltd
- Nominated Architect - Gerard Page; NSW reg No. 7247; Vic reg No. 17954; QLD reg No. 4538

Client  
EMKC

Project  
PROPOSED DATA CENTRE  
85-86 Sharps Road  
Tullahoma VIC 3043

Scale  
1:500

Checked By  
DK/SFI

Job Number  
240004

Sheet

Approved By  
AD


Drawing Number  
DA014

Scale Bar  
1:500  
0 5 10 15 25m


Project Status  
Drawing Title  
OVERALL LEVEL 4 PLAN

Issue  
D



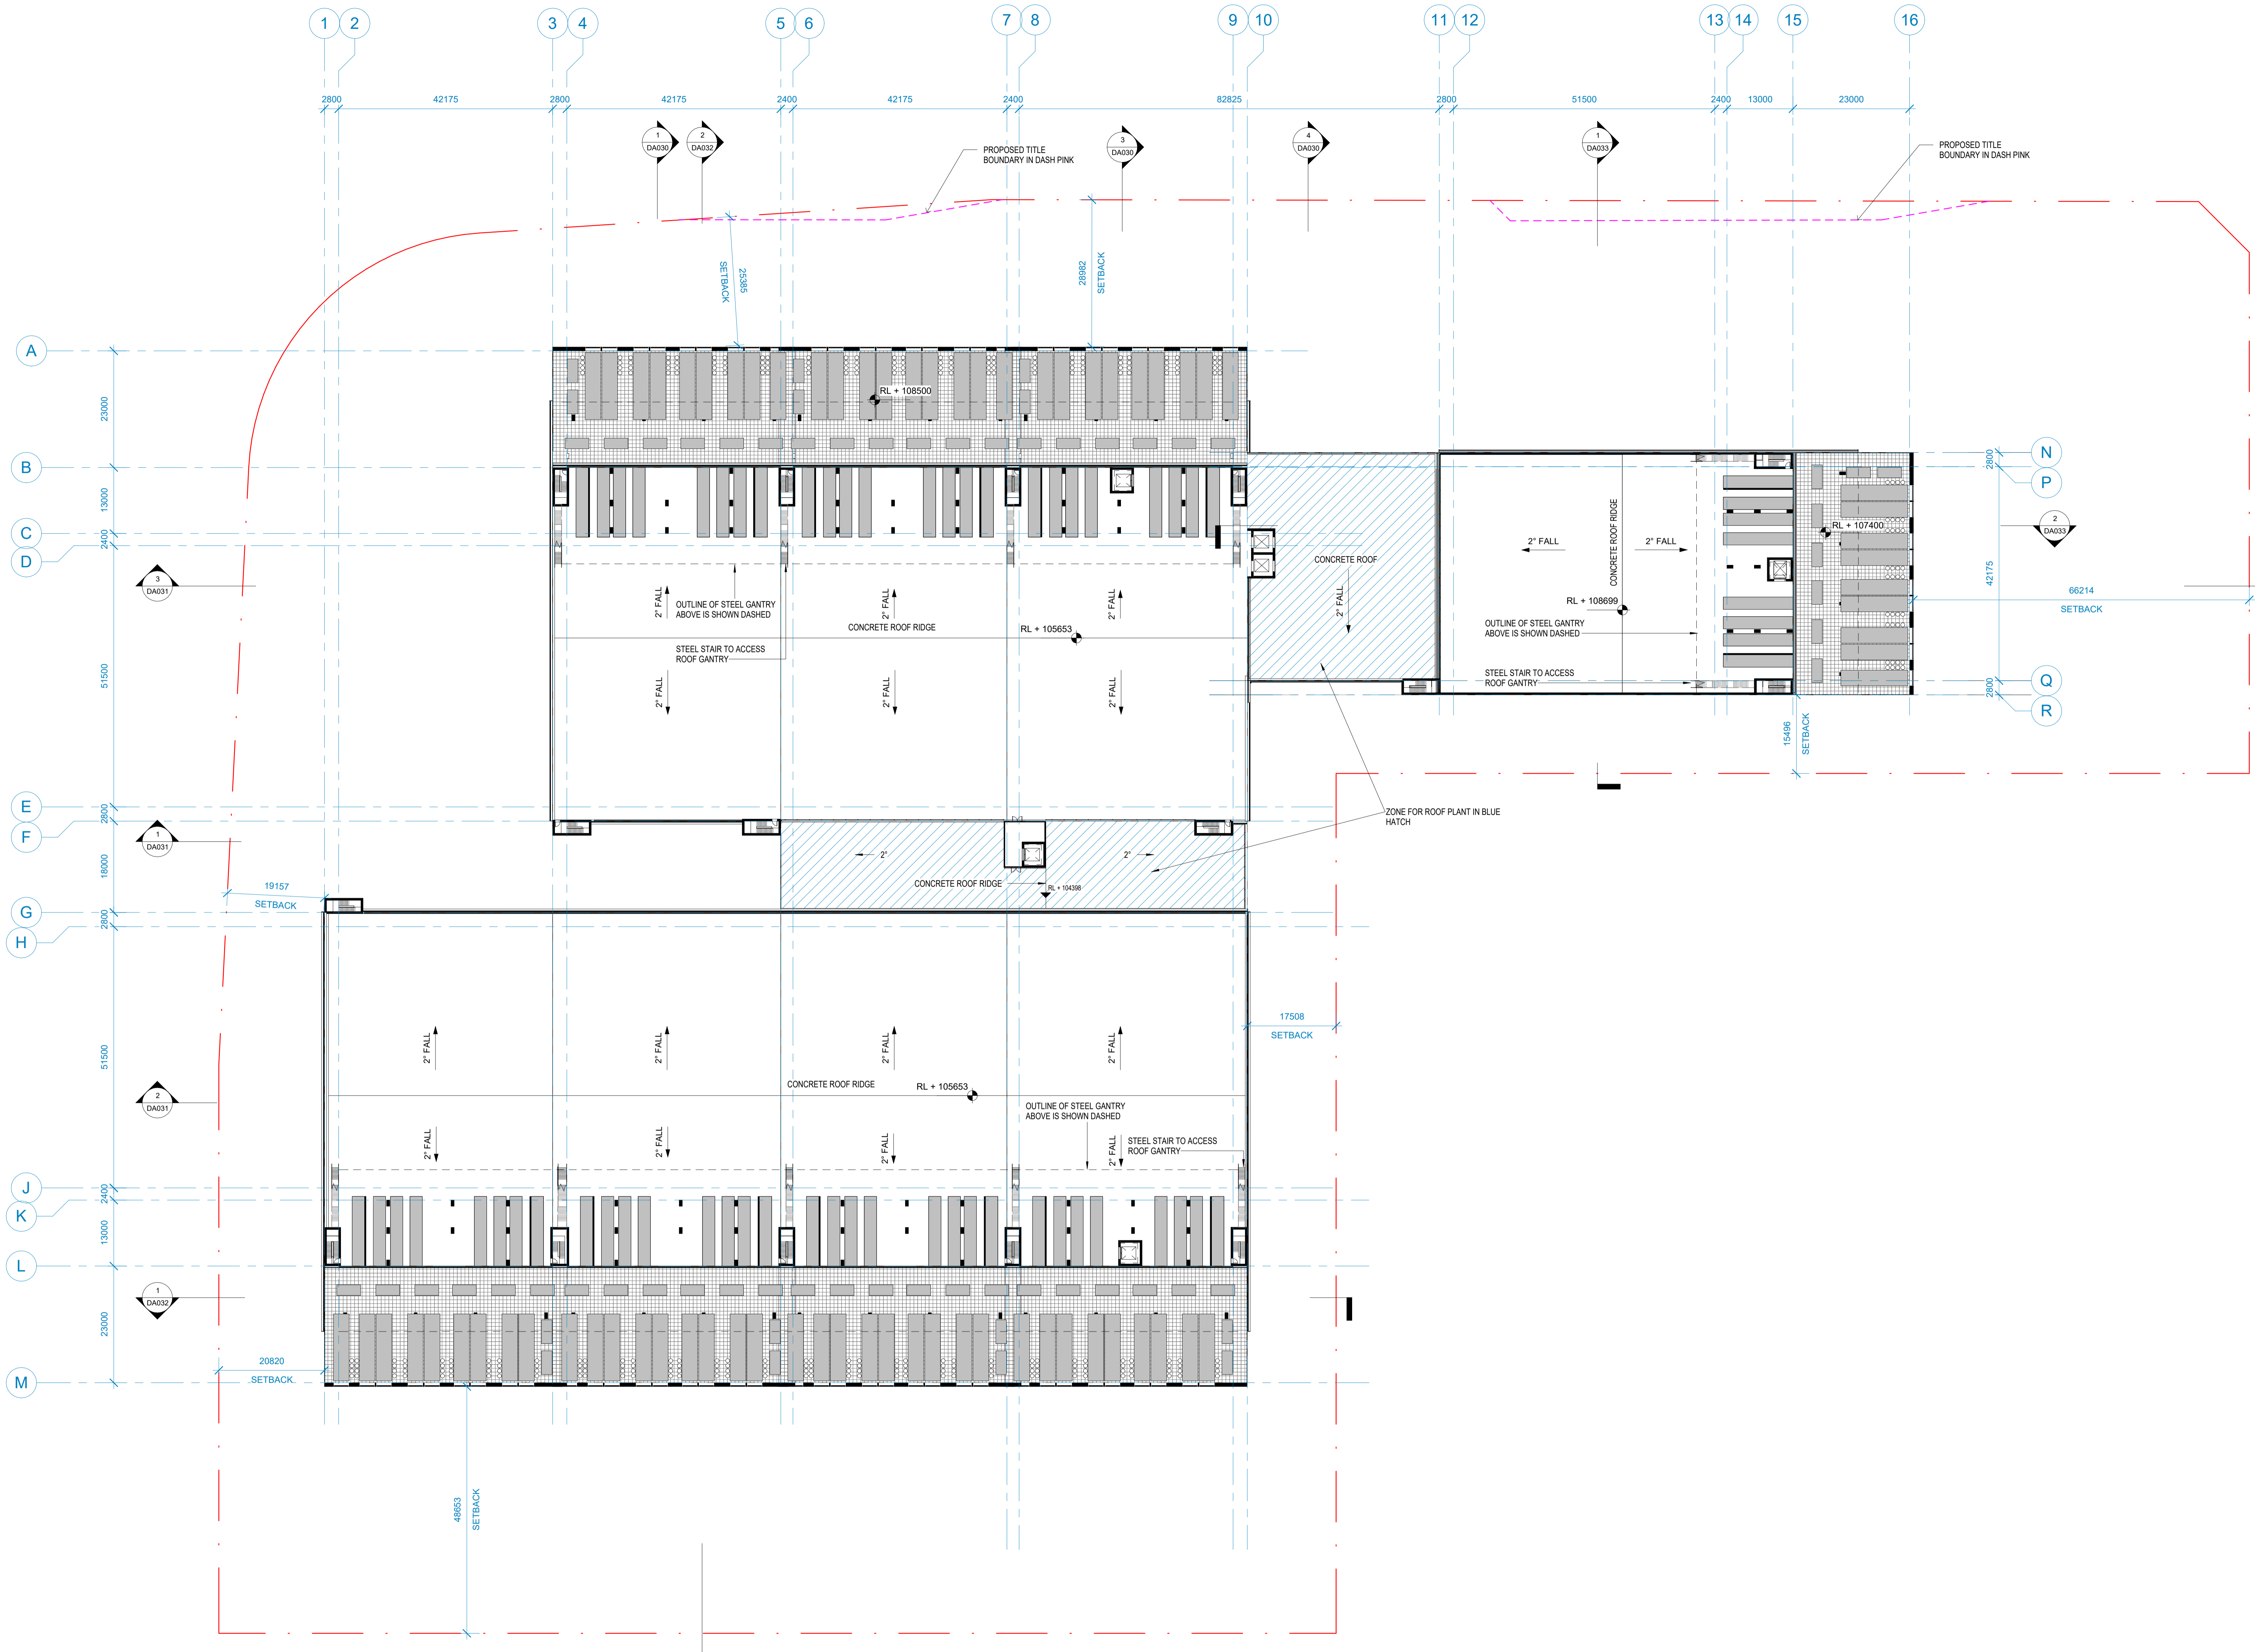

1 LEVEL 5 ROOF  
1:500

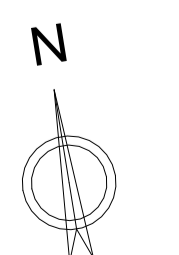

Issue	Date	Description
A	31.07.2024	FOR DA
B	21.08.2024	FOR DA
C	26.08.2024	FOR DA
D	28.08.2024	FOR DA

Notes

Key Plan

Project Manager

Client

Construction Manager



+61 2 8069 8600  
LEVEL 22  
68 PITT STREET  
SYDNEY NSW 2000 AUSTRALIA

GREENBOX ARCHITECTURE PTY LTD  
ABN: 79 139 779 098  
ISO 9001 CERTIFIED QUALITY SYSTEM


- Use written dimensions only
- Do not scale from drawing
- Contractors shall confirm all dimensions on-site prior to commencing any work or producing any shop drawings
- All materials to be used in accordance with the manufacturer's specifications and instructions and shall comply with the relevant Australian Standards
- Copyright of this drawing and design remain the property of Greenbox Architecture Pty Ltd
- Nominated Architect - Gerard Page; NSW reg No. 7247; Vic reg No. 17864; QLD reg No. 4538

Client  
EMKC

Project  
PROPOSED DATA CENTRE  
85-86 Sharps Road  
Tullamarine VIC 3043

Scale	Sheet	Scale Bar	Project Status
1:500		0 5 10 15 25m	
Drawn By HLJZ			Project Status
Checked By DK/SFI			Drawing Title <b>OVERALL LEVEL 5 PLAN</b>
Approved By AD			Drawing Number DA015
Job Number 240004			Issue D






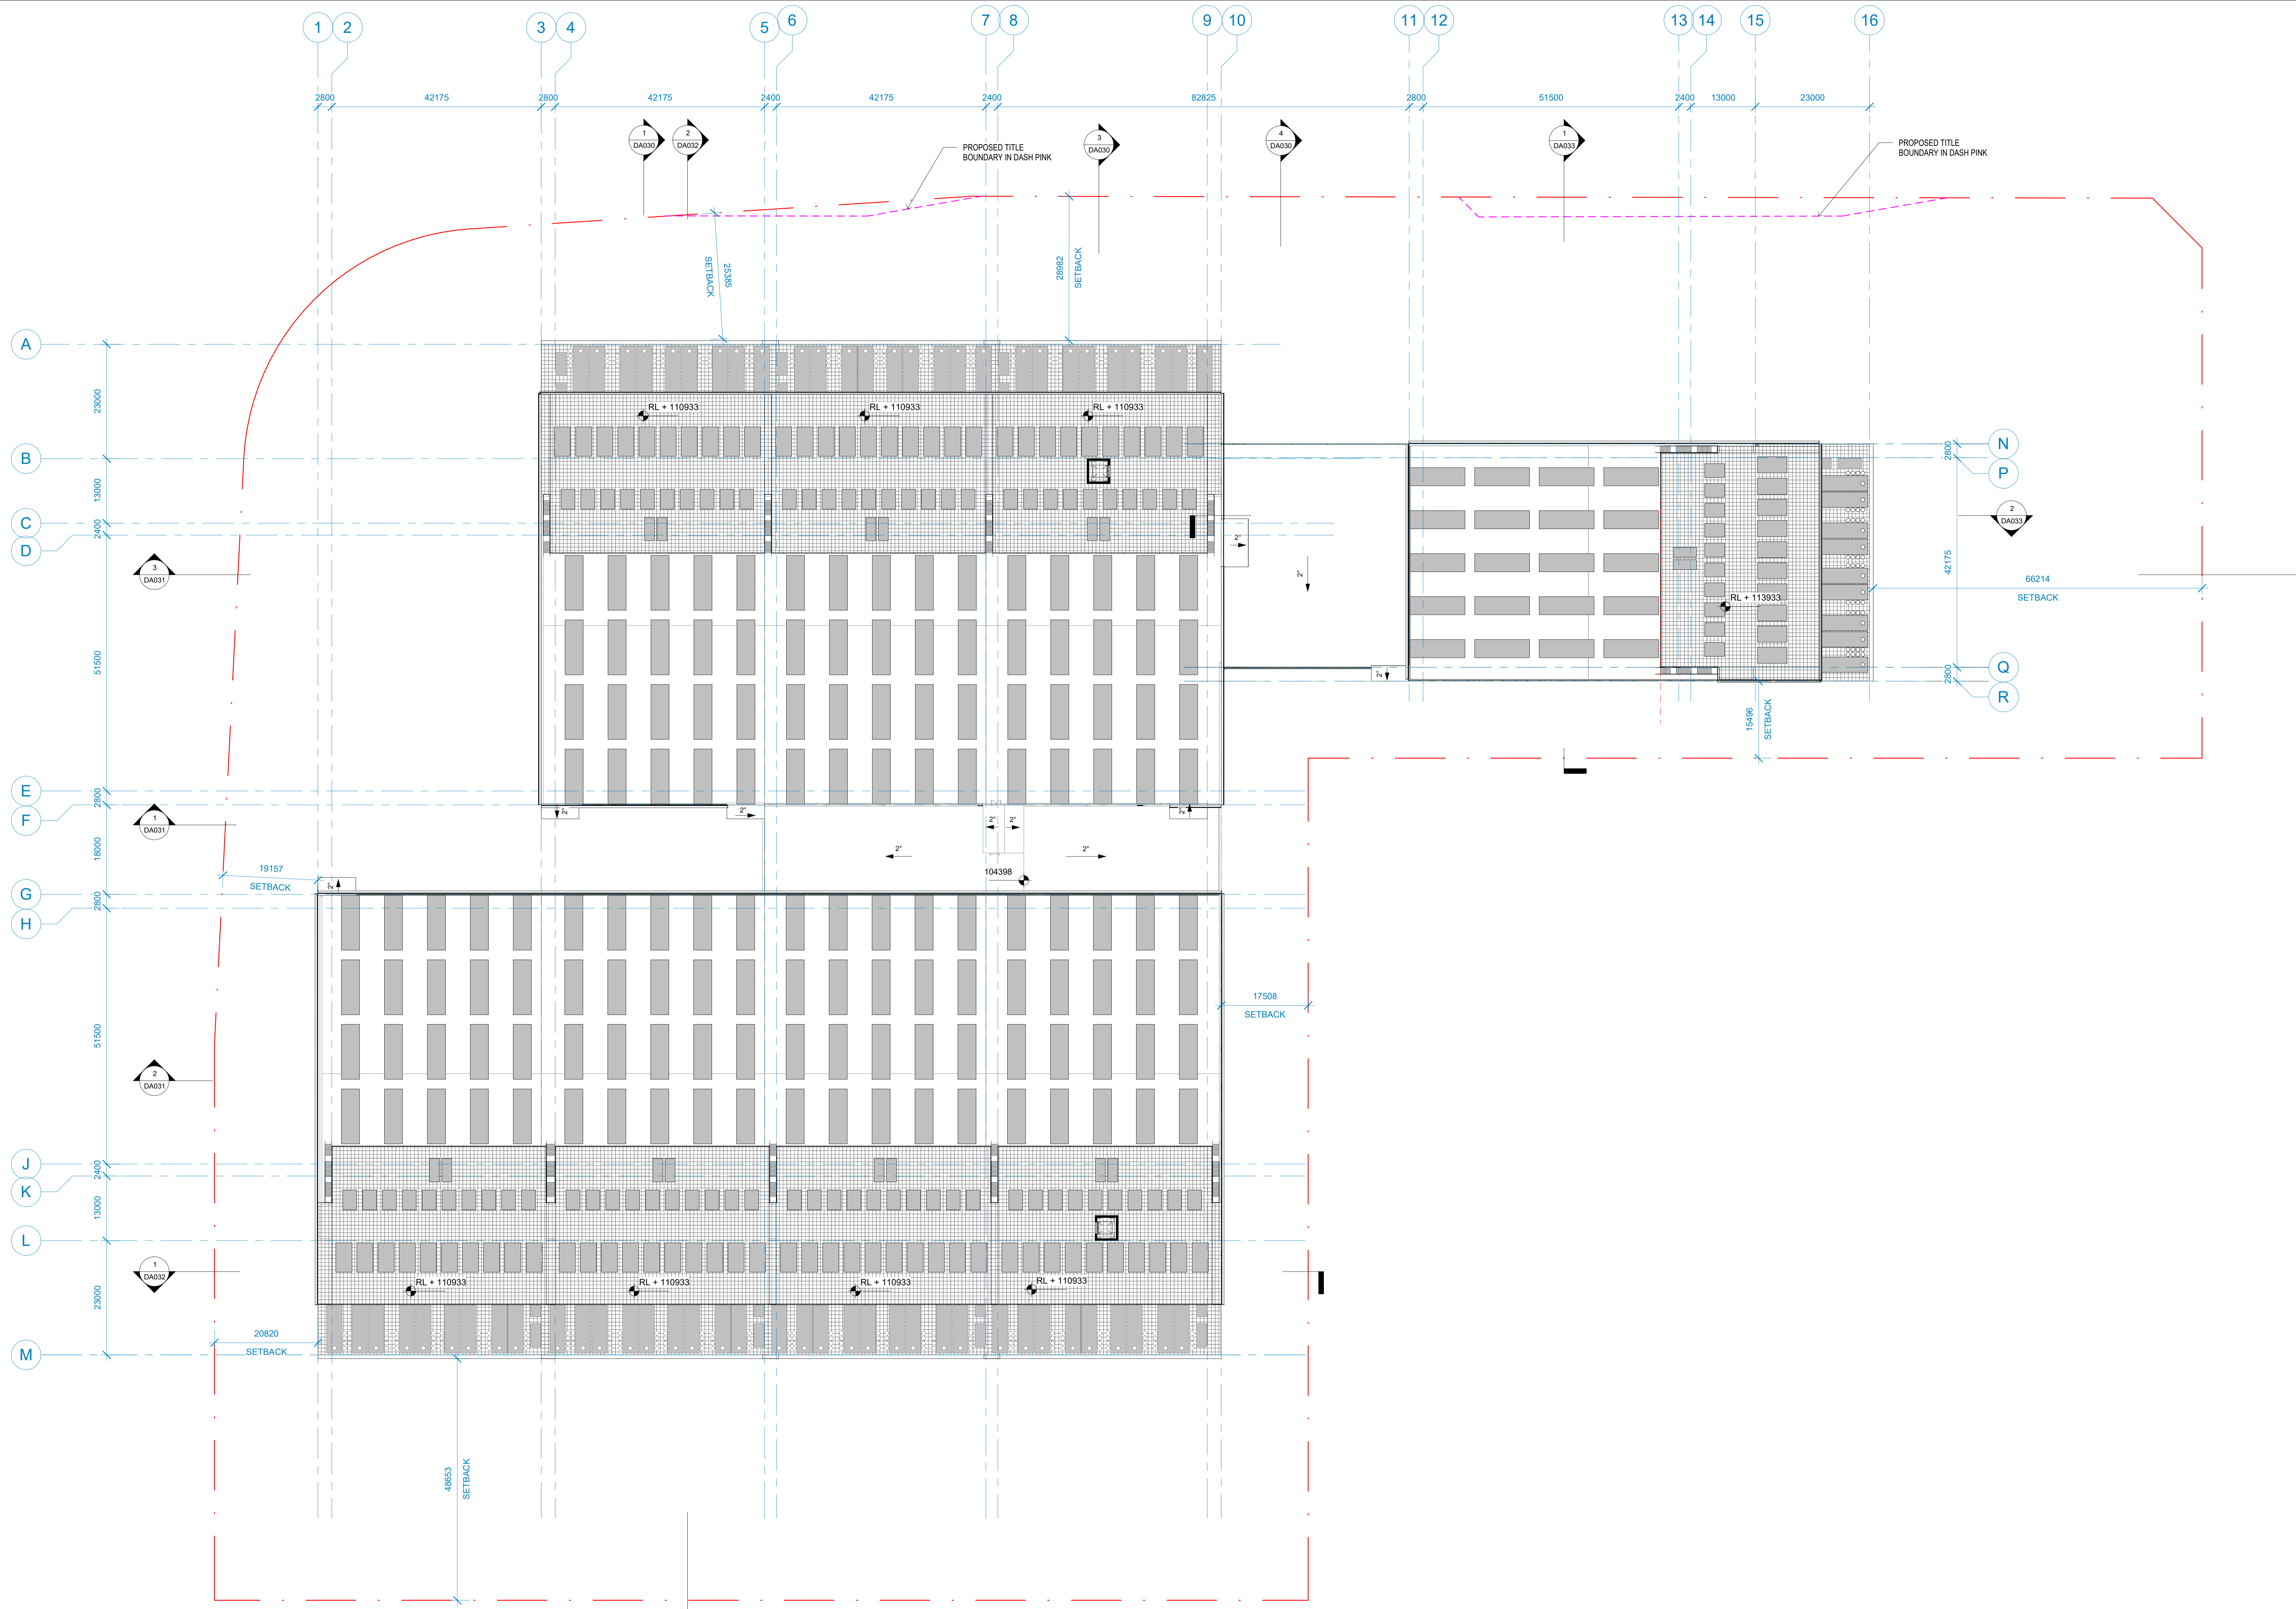

1 LEVEL 6  
1:500

	<b>Issue</b> A 31.07.2024 FOR DA B 21.08.2024 FOR DA C 26.08.2024 FOR DA D 28.08.2024 FOR DA	<b>Date</b> 31.07.2024 21.08.2024 26.08.2024 28.08.2024	<b>Description</b> FOR DA FOR DA FOR DA FOR DA	Notes	Key Plan	Project Manager	Client	 +61 2 8069 8030 LEVEL 22 68 PITT STREET SYDNEY NSW 2000 AUSTRALIA	GREENBOX ARCHITECTURE PTY LTD ABN: 79 139 779 098 ISO 9001 CERTIFIED QUALITY SYSTEM	• Use written dimensions only • Do not scale from drawing • Contractors shall confirm all dimensions on-site prior to commencing any work or producing any shop drawings • All materials to be used in accordance with the manufacturer's specifications and instructions and shall comply with the relevant Australian Standards • Copyright of this drawing and design remain the property of Greenbox Architecture Pty Ltd • Nominated Architect - Gerard Page; NSW reg No. 7247; Vic reg No. 17954; QLD reg No. 4538	Client EMKC	Scale 1:500	Sheet 1:500	Scale Bar 0 5 10 15 25m	Project Status Proposed Data Centre	Drawing Title OVERALL LEVEL 6 PLAN (LOWER ROOF)	Drawing Number DA016	Issue D
	AD	<b>Notes</b>	<b>Key Plan</b>								<b>Project Manager</b>	<b>Client</b>	Checked By DK/SFI	Approved By AD	Job Number 240004	Issue D		



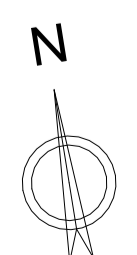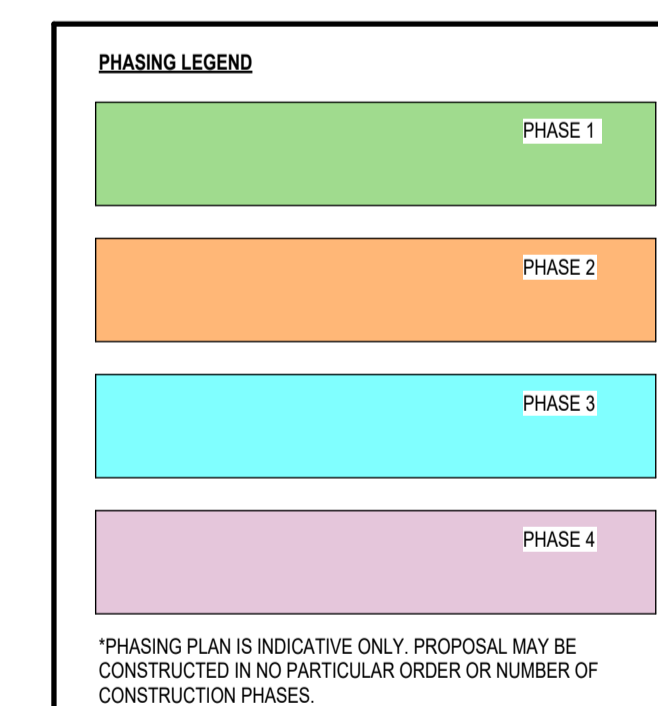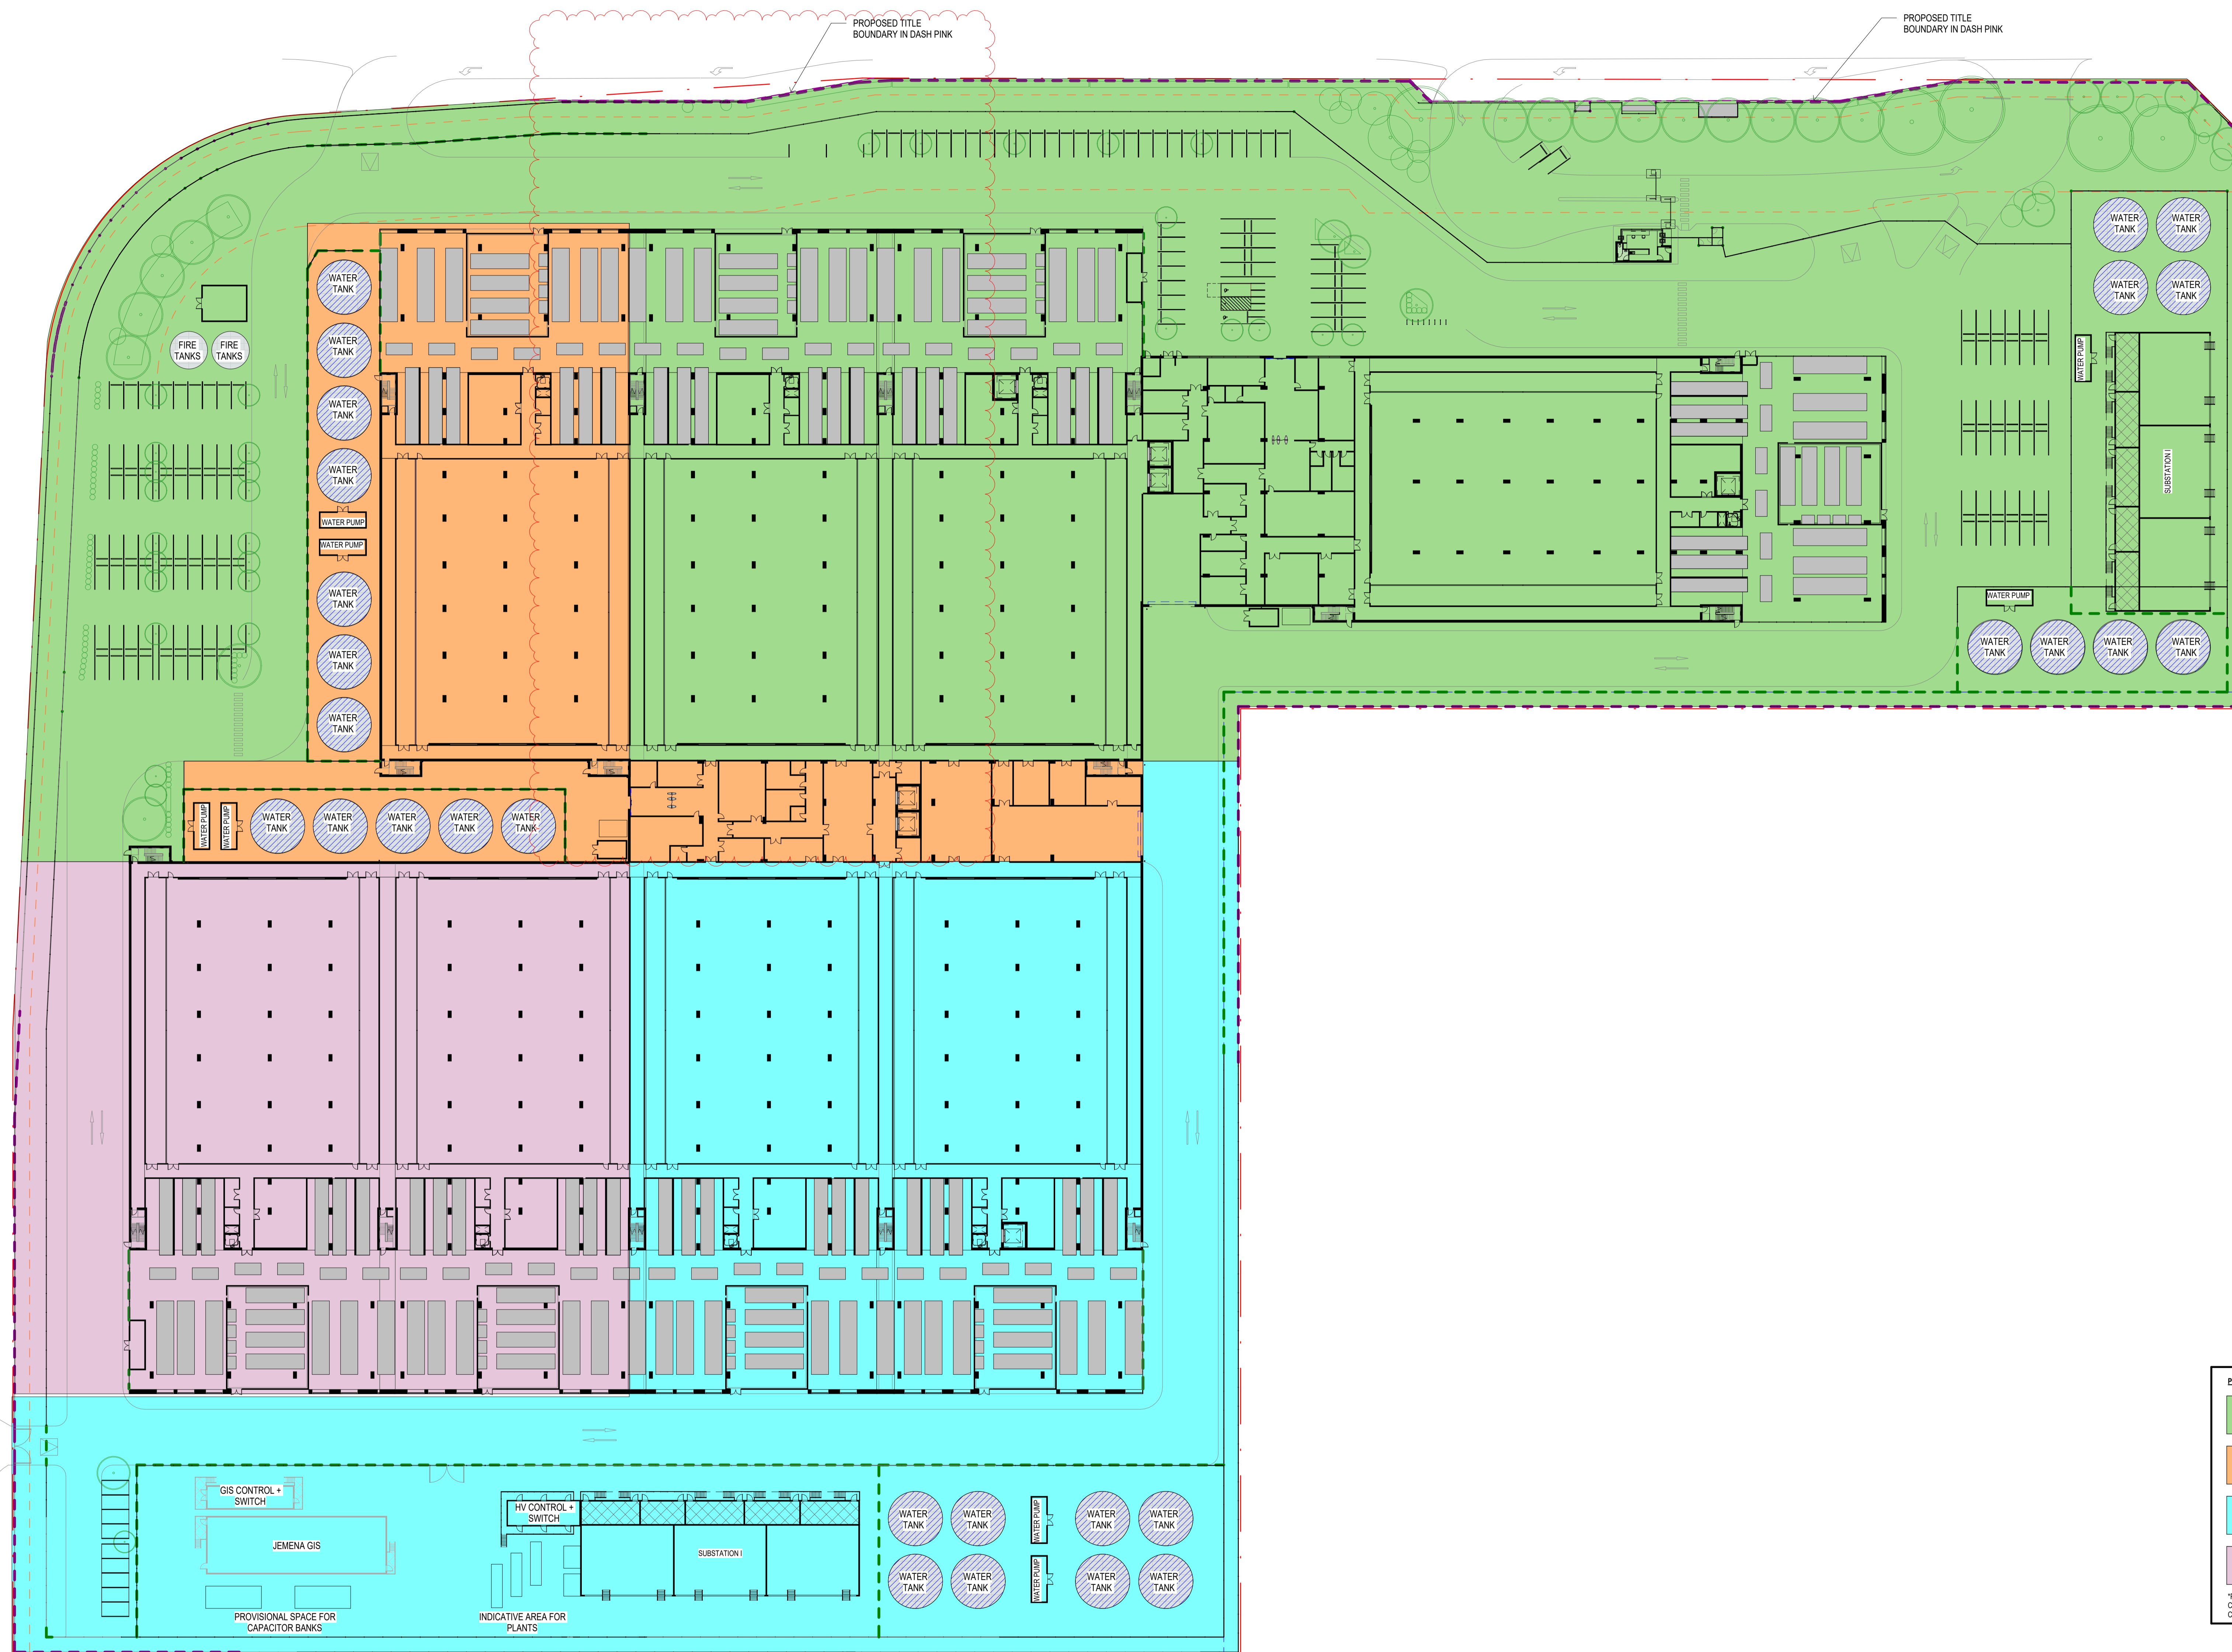

Issue	Date	Description
B	21.08.2024	FOR DA
C	28.08.2024	FOR DA
D	28.08.2024	FOR DA
G	18.12.2024	FOR DA

Notes

Key Plan

Project Manager

Client



+61 2 8069 8000  
LEVEL 22  
68 PITT STREET  
SYDNEY NSW 2000 AUSTRALIA

GREENBOX ARCHITECTURE PTY LTD  
ABN: 79 139 779 098  
ISO 9001 CERTIFIED QUALITY SYSTEM

- Use written dimensions only
- Do not scale from drawing
- Contractors shall confirm all dimensions on-site prior to commencing any work or producing any shop drawings
- All materials to be used in accordance with the manufacturer's specifications and instructions and shall comply with the relevant Australian Standards
- Copyright of this drawing and design remain the property of Greenbox Architecture Pty Ltd
- Nominated Architect - Gerard Page; NSW reg No. 7247; Vic reg No. 17954; QLD reg no. 4538

Client

EMKC

Project

PROPOSED DATA CENTRE

85-86 Sharn Road  
Tullahoma VIC 3043

Job Number

240004

Scale

As indicated

Sheet

1/500

Scale Bar

0 5 10 15 25m

Drawn By

HL

Project Status

DA SUBMISSION

Checked By

DK/SFI

Approved By

AD

Drawing Title

SITE PHASING DIAGRAM

Drawing Number

DA018


Issue

G




1 EAST ELEVATION

1:500

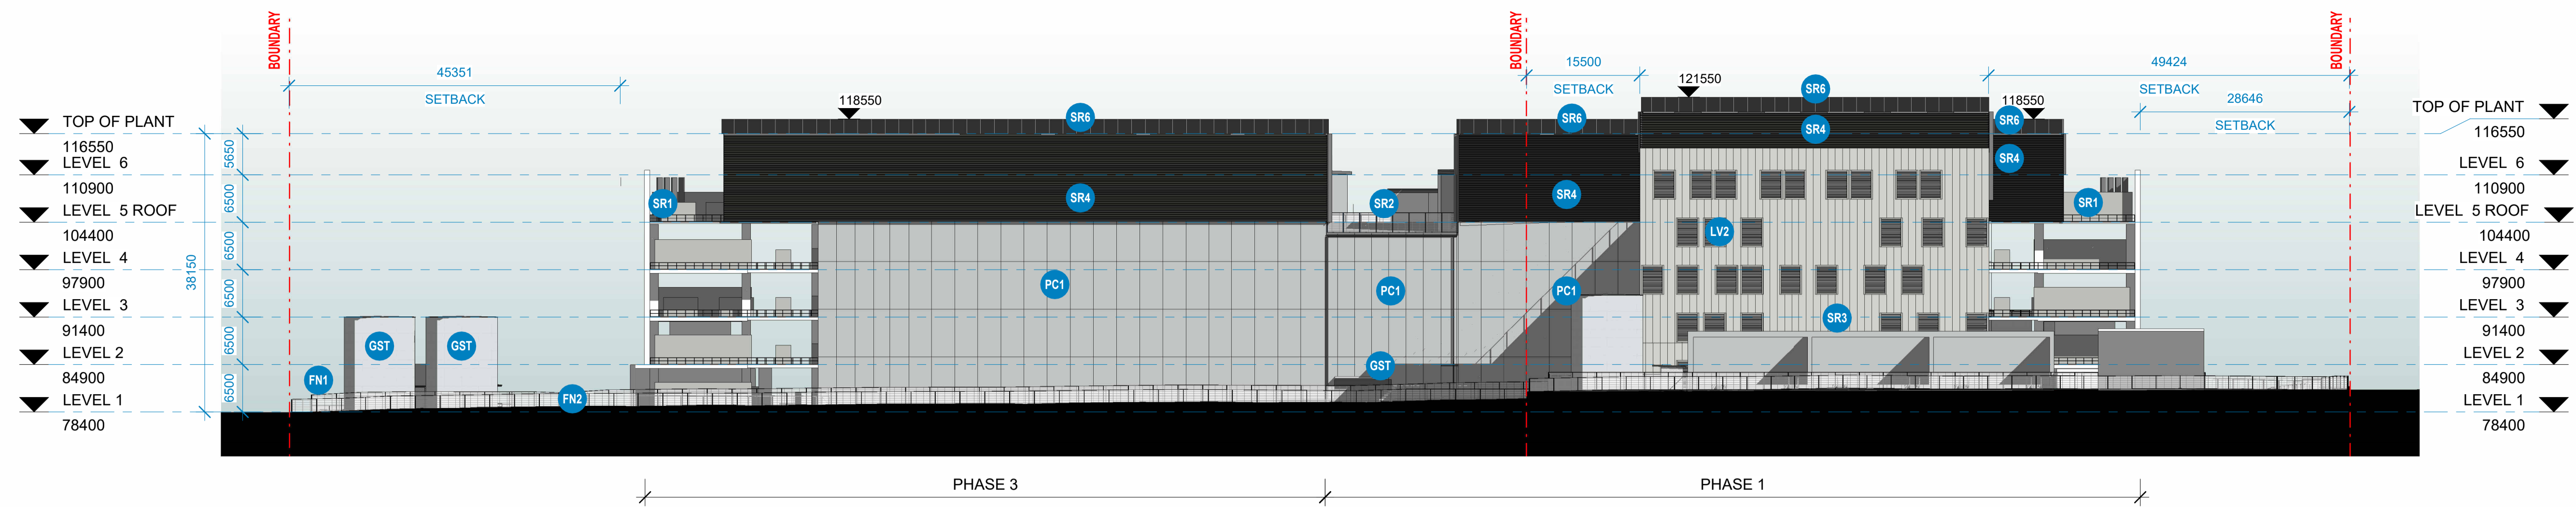


2 NORTH ELEVATION

1:500

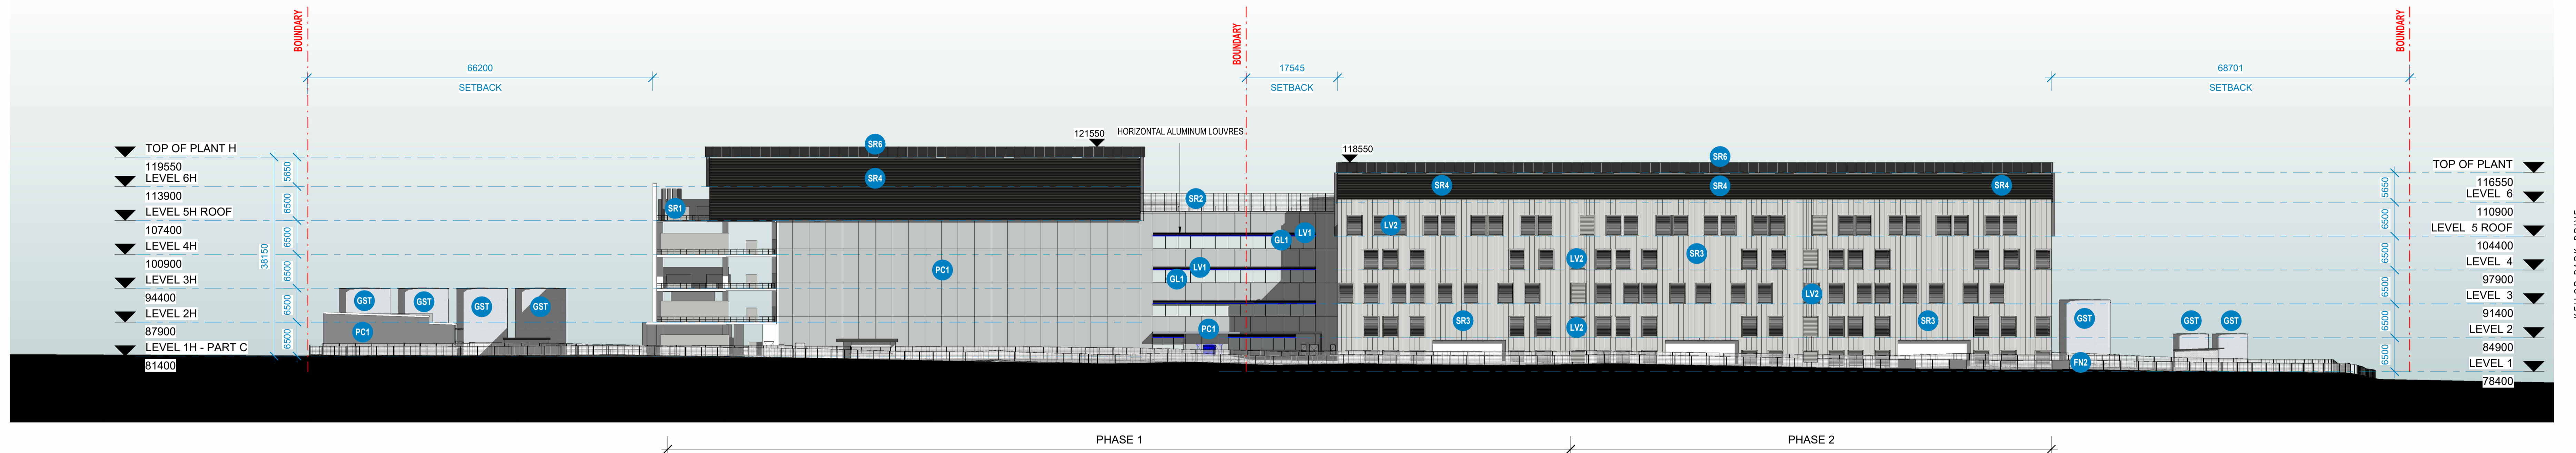

3 WEST ELEVATION

1:500

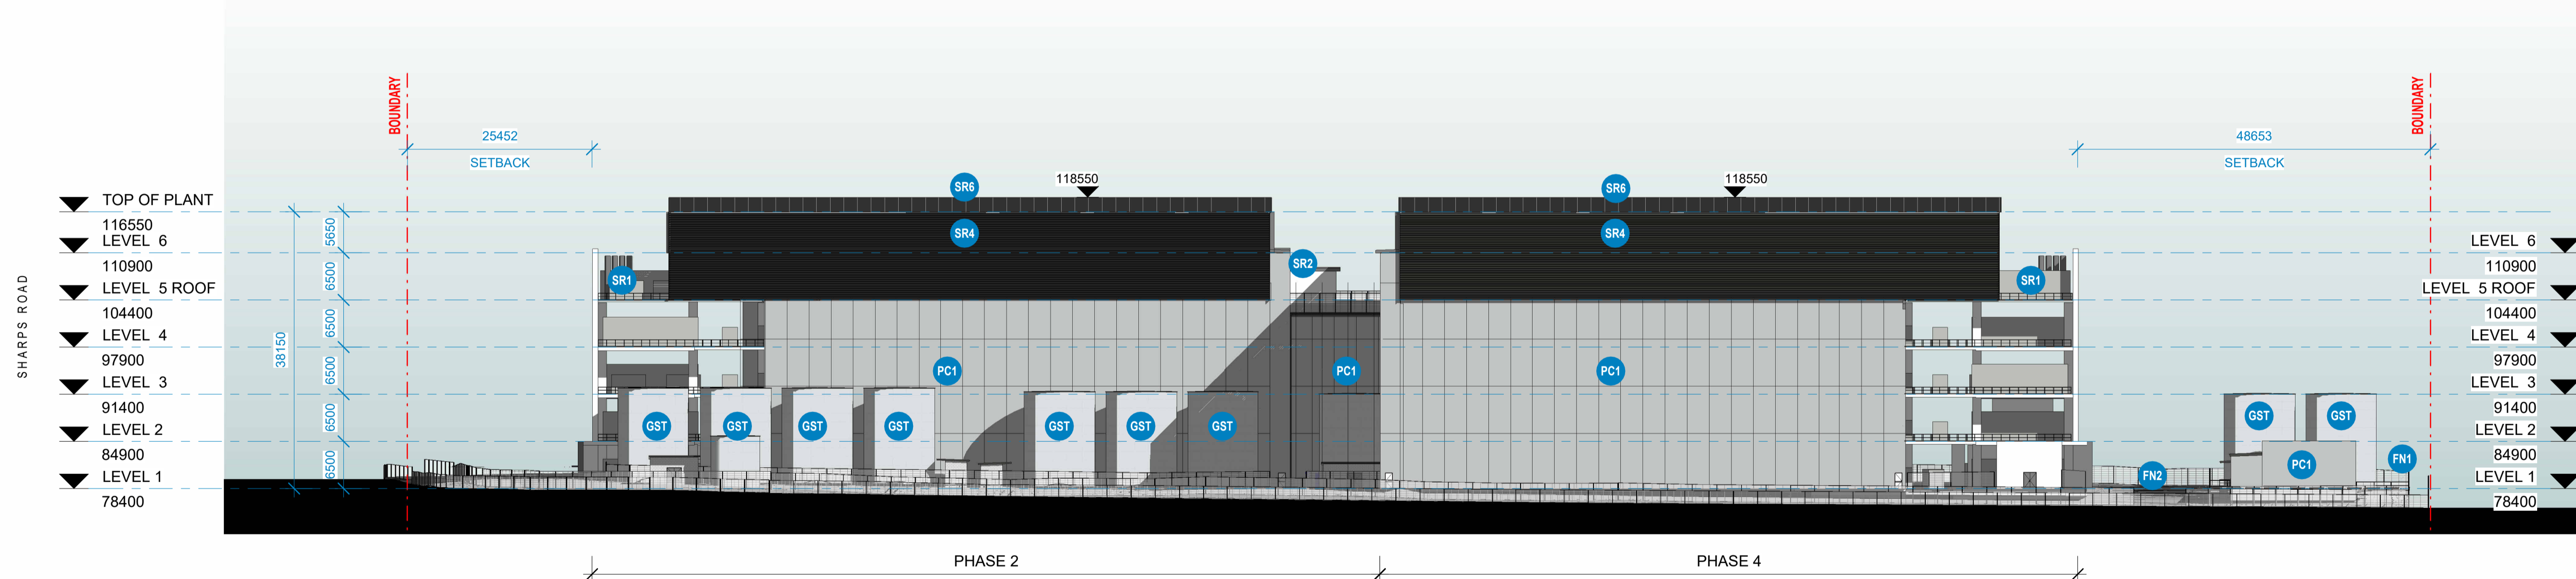

4 SOUTH ELEVATION

1:500



Issue	Date	Description
A	31.07.2024	FOR DA
B	21.08.2024	FOR DA
D	28.08.2024	FOR DA

Notes

Key Plan

Project Manager

Client

Construction Manager

**Greenbox**

+61 2 8069 8600  
LEVEL 22  
68 PITT STREET  
SYDNEY NSW 2000 AUSTRALIA

GREENBOX ARCHITECTURE PTY LTD  
ABN: 79 139 778 098  
ISO 9001 CERTIFIED QUALITY SYSTEM

• Use written dimensions only  
• Do not scale from drawing  
• Contractors shall confirm all dimensions on-site prior to commencing any work or producing any shop drawings  
• All materials to be used in accordance with the manufacturer's specifications and instructions and shall comply with the relevant Australian Standards  
• Copyright of this drawing and design remain the property of Greenbox Architecture Pty Ltd  
• Nominated Architect - Gerard Page; NSW reg No. 7247; Vic reg No. 17964; QLD reg No. 4538

Client  
EMKC

Project  
PROPOSED DATA CENTRE  
85-86 Sharps Road  
Tullahoma VIC 3043

Checked By  
DK/SFI  
Approved By  
AD  
Job Number  
240004

Scale  
1:500

Sheet  
1:500

Drawing Number  
DA020

Scale Bar  
0 5 10 15 25m


Project Status  
FOR COORDINATION

Drawing Title  
SITE ELEVATION


Issue  
D




1 DA - SITE SECTION\_NS 01  
1:500

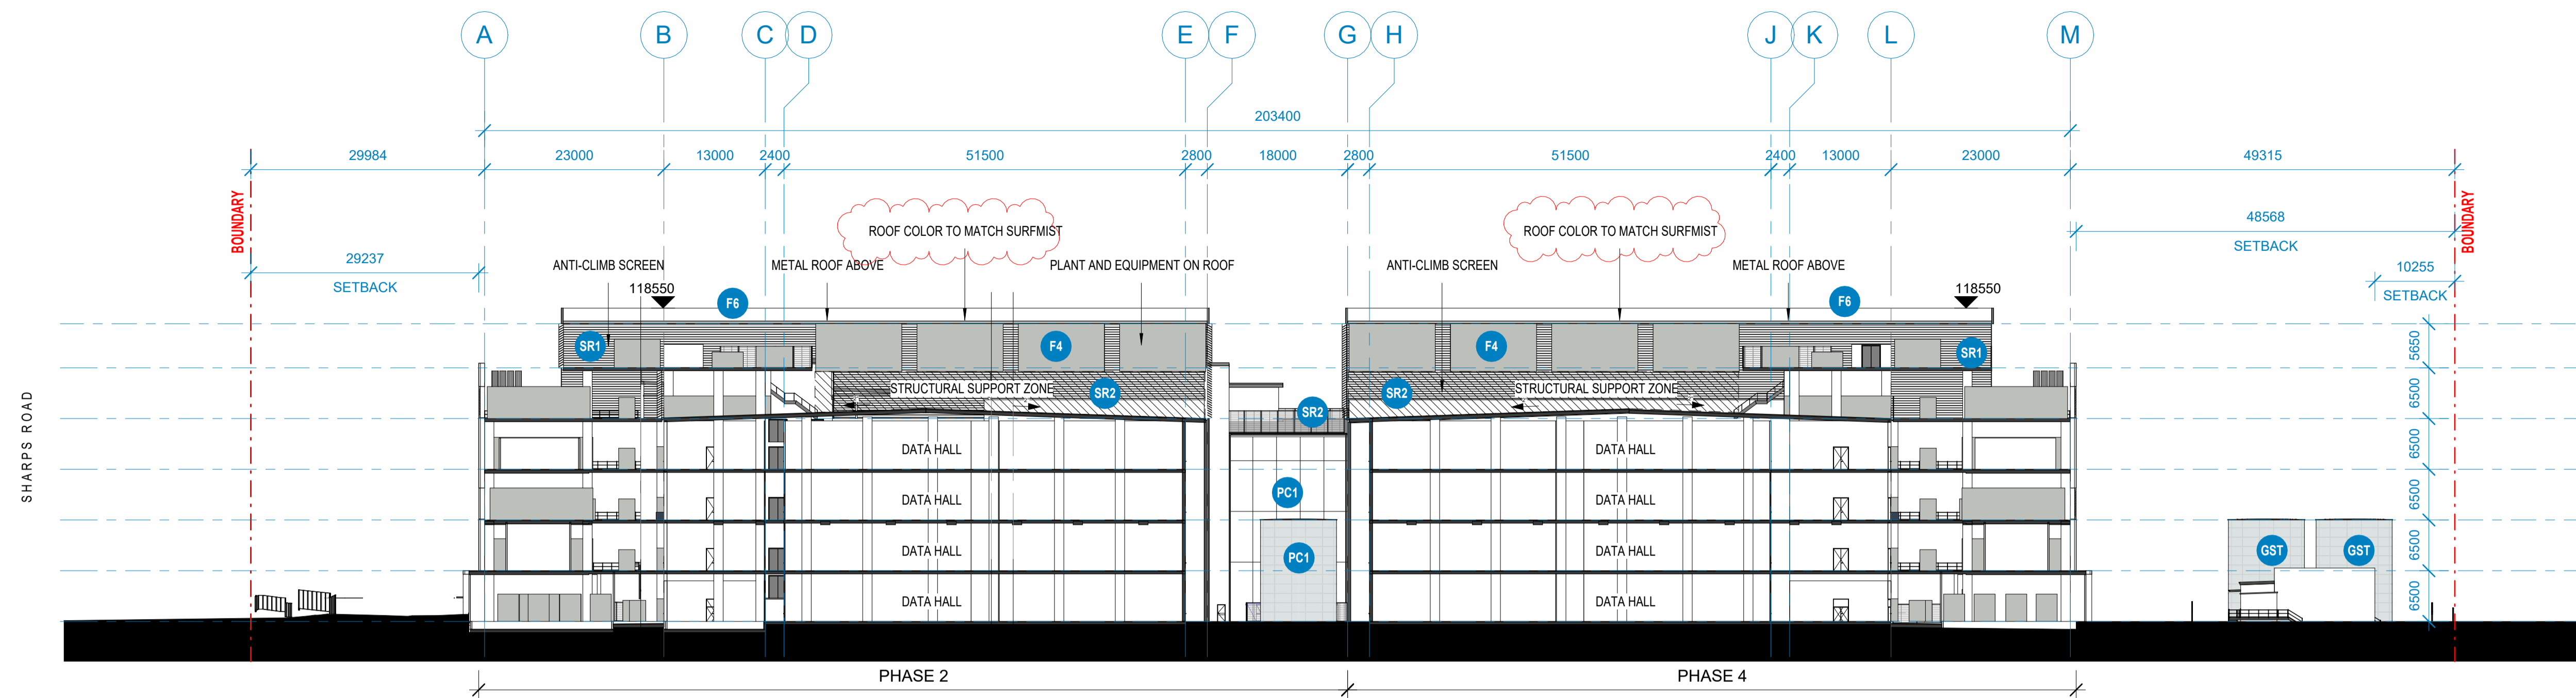

3 DA - SITE SECTION\_NS 02  
1:500

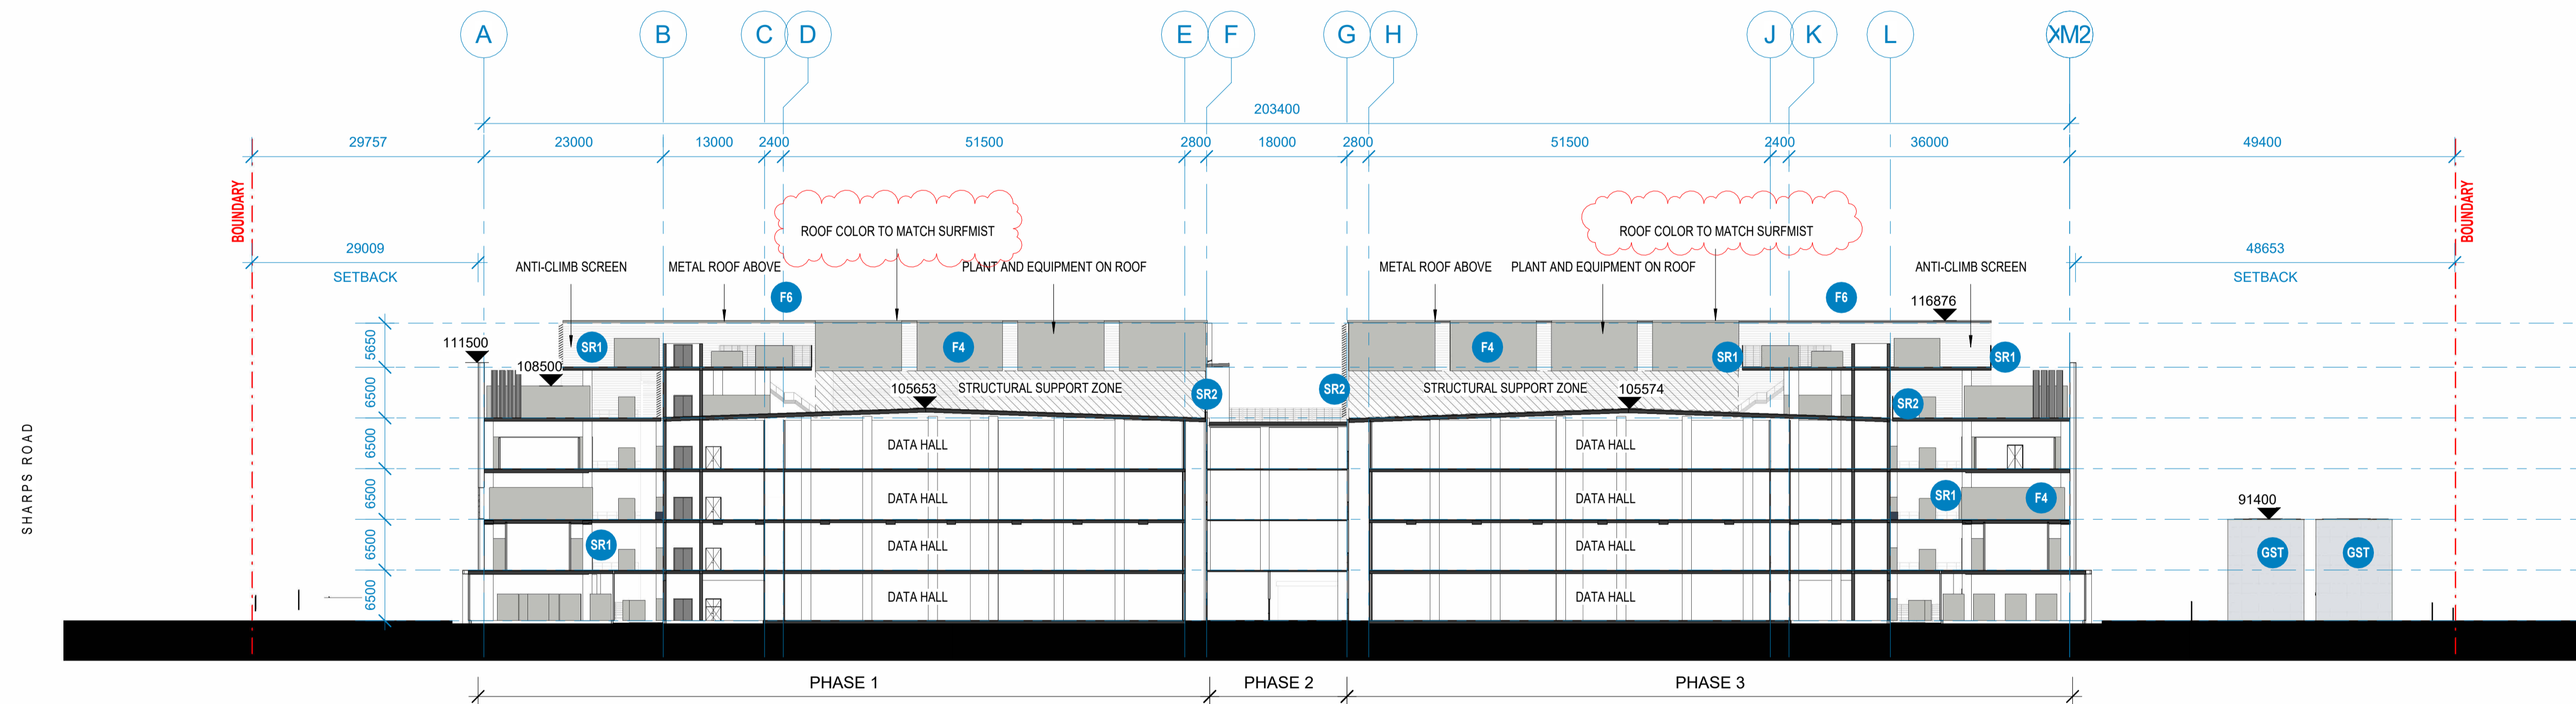

4 DA - SITE SECTION\_NS 03  
1:500

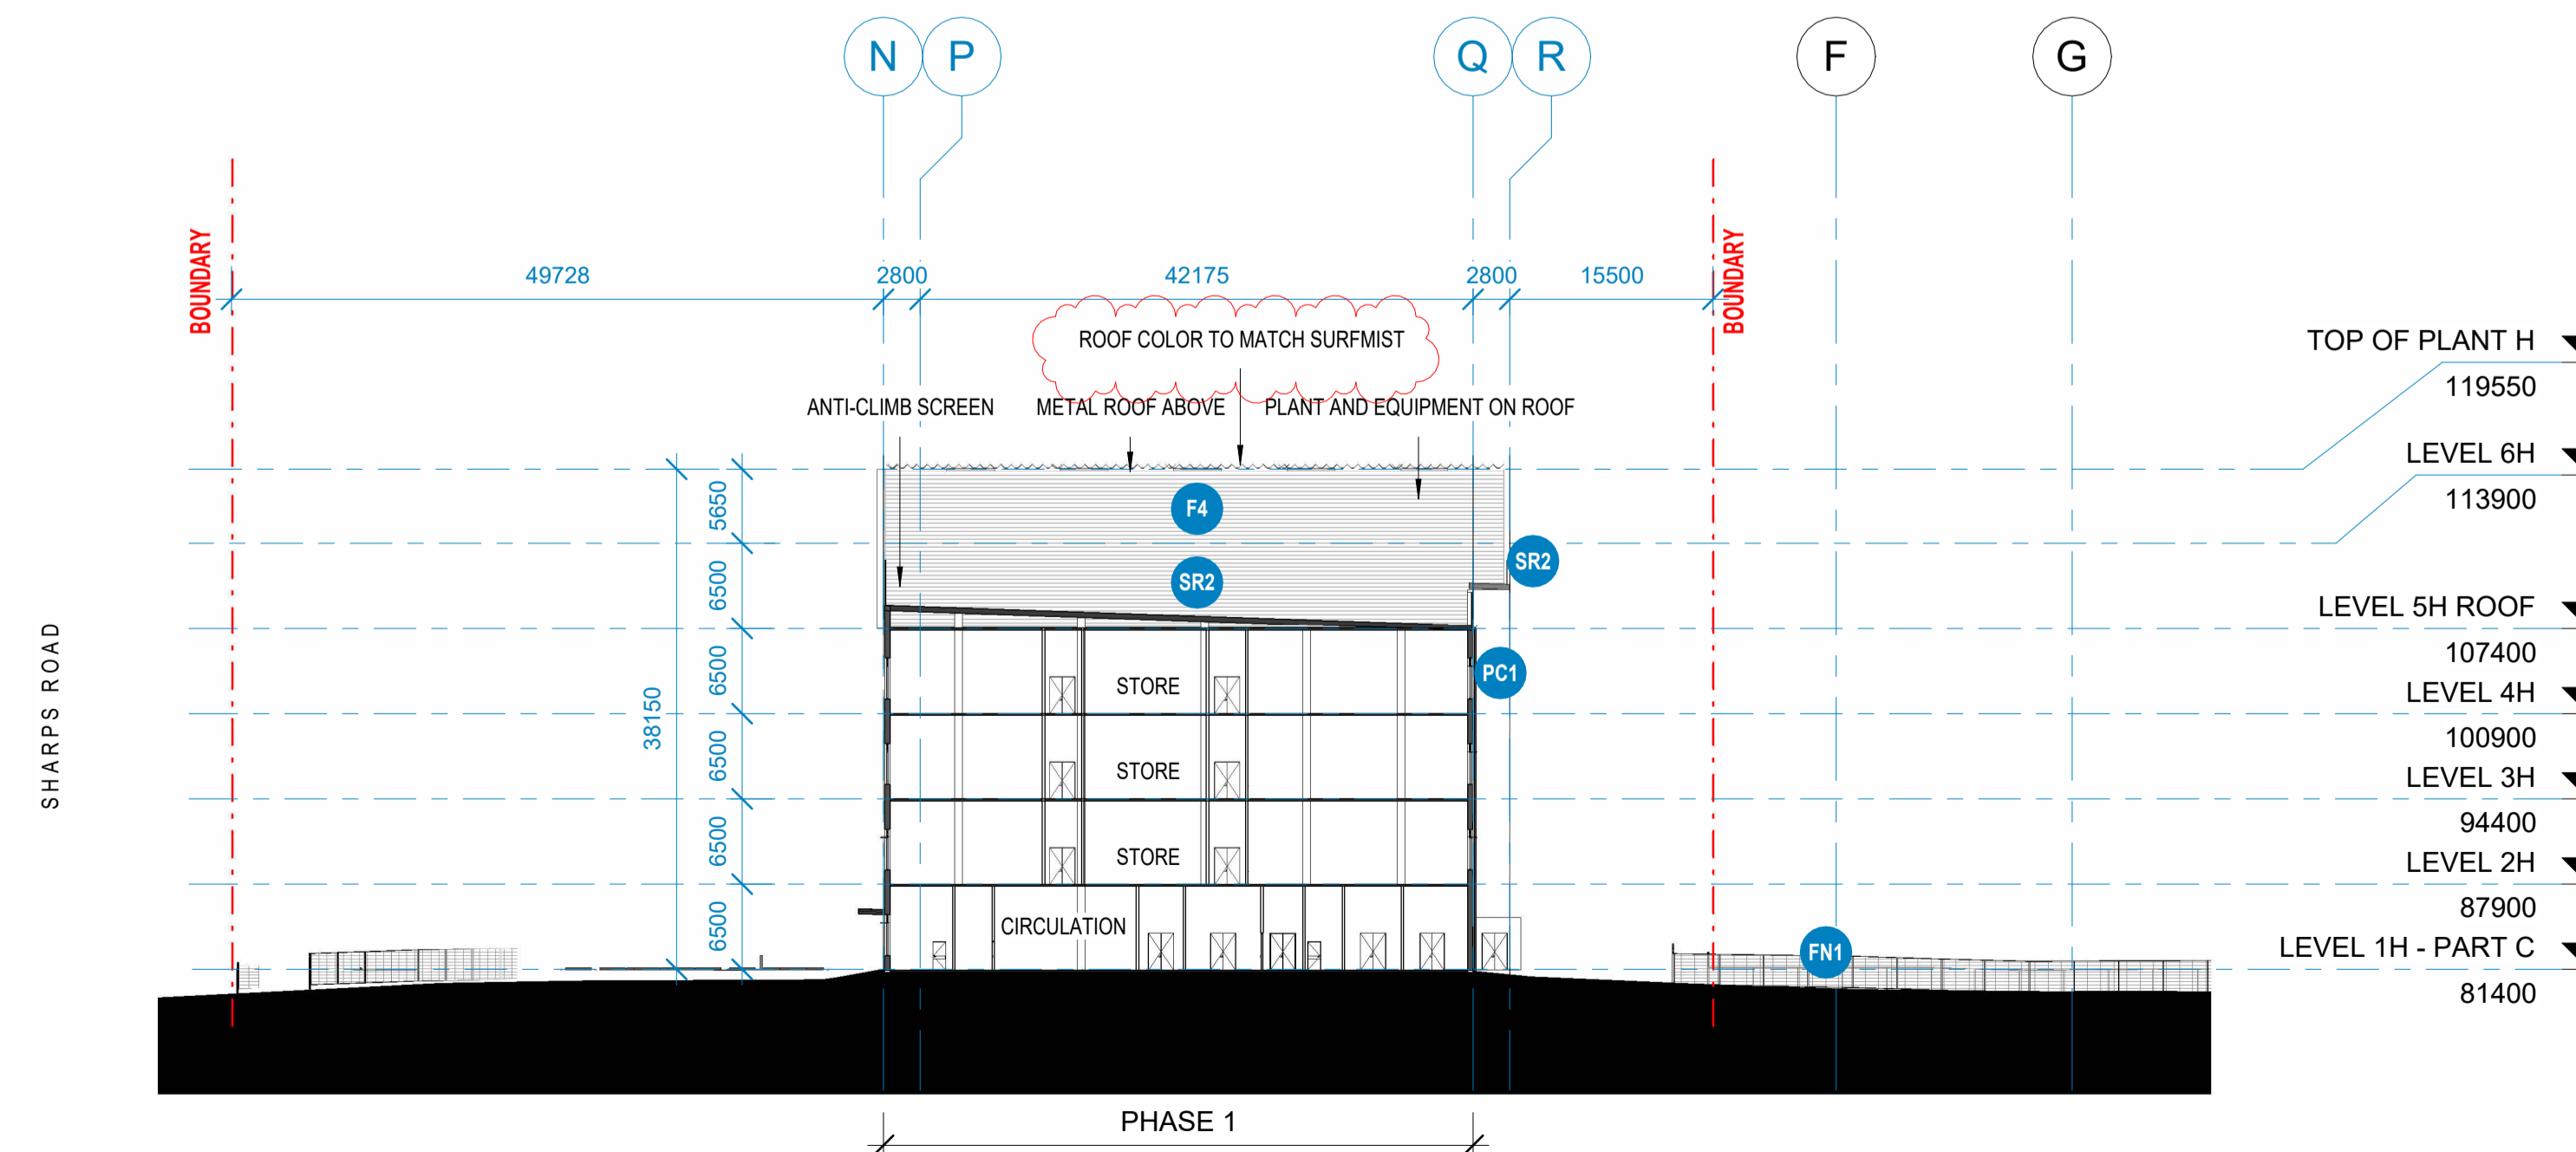

EXTERNAL FINISHES SCHEDULE


TOP OF PLANT ▼  
116550  
LEVEL 6 ▼  
110900  
LEVEL 5 ROOF ▼  
104400  
LEVEL 4 ▼  
97900  
LEVEL 3 ▼  
91400  
LEVEL 2 ▼  
84900  
LEVEL 1 ▼  
78400

TOP OF PLANT ▼  
116550  
LEVEL 6 ▼  
110900  
LEVEL 5 ROOF ▼  
104400  
LEVEL 4 ▼  
97900  
LEVEL 3 ▼  
91400  
LEVEL 2 ▼  
84900  
LEVEL 1 ▼  
78400

TOP OF PLANT H ▼  
119550  
LEVEL 6H ▼  
113900  
LEVEL 5H ROOF ▼  
107400  
LEVEL 4H ▼  
100900  
LEVEL 3H ▼  
94400  
LEVEL 2H ▼  
87900  
LEVEL 1H - PART C ▼  
81400

Issue	Date	Description
A	31.07.2024	FOR DA
B	21.08.2024	FOR DA
D	28.08.2024	FOR DA
E	03.09.2024	FOR DA
G	18.12.2024	FOR DA

Notes

Key Plan

Project Manager

Client




+61 2 8069 8030  
LEVEL 27  
68 PITT STREET  
SYDNEY NSW 2000 AUSTRALIA

GREENBOX ARCHITECTURE PTY LTD  
ABN: 79 139 779 098


• Use written dimensions only  
• Do not scale from drawing  
• Contractors shall confirm all dimensions on-site prior to commencing any work or producing any shop drawings  
• All materials to be used in accordance with the manufacturer's specifications and instructions and shall comply with the relevant Australian Standards  
• Copyright of this drawing and design remain the property of Greenbox Architecture Pty Ltd  
• Nominated Architect - Gerard Page; NSW reg No. 7247; Vic reg No. 17954; QLD reg no. 4538

Client EMCC	Scale 1:500	Sheet 1:500	Scale Bar 0 5 10 15 25m
Project PROPOSED DATA CENTRE 85-86 Sharps Road Tullamarine VIC 3043	Checked By DK/SFI	Approved By AD	Job Number 240004
Project Status DA SUBMISSION	Drawing Title SITE SECTION	Drawing Number DA030	Issue G




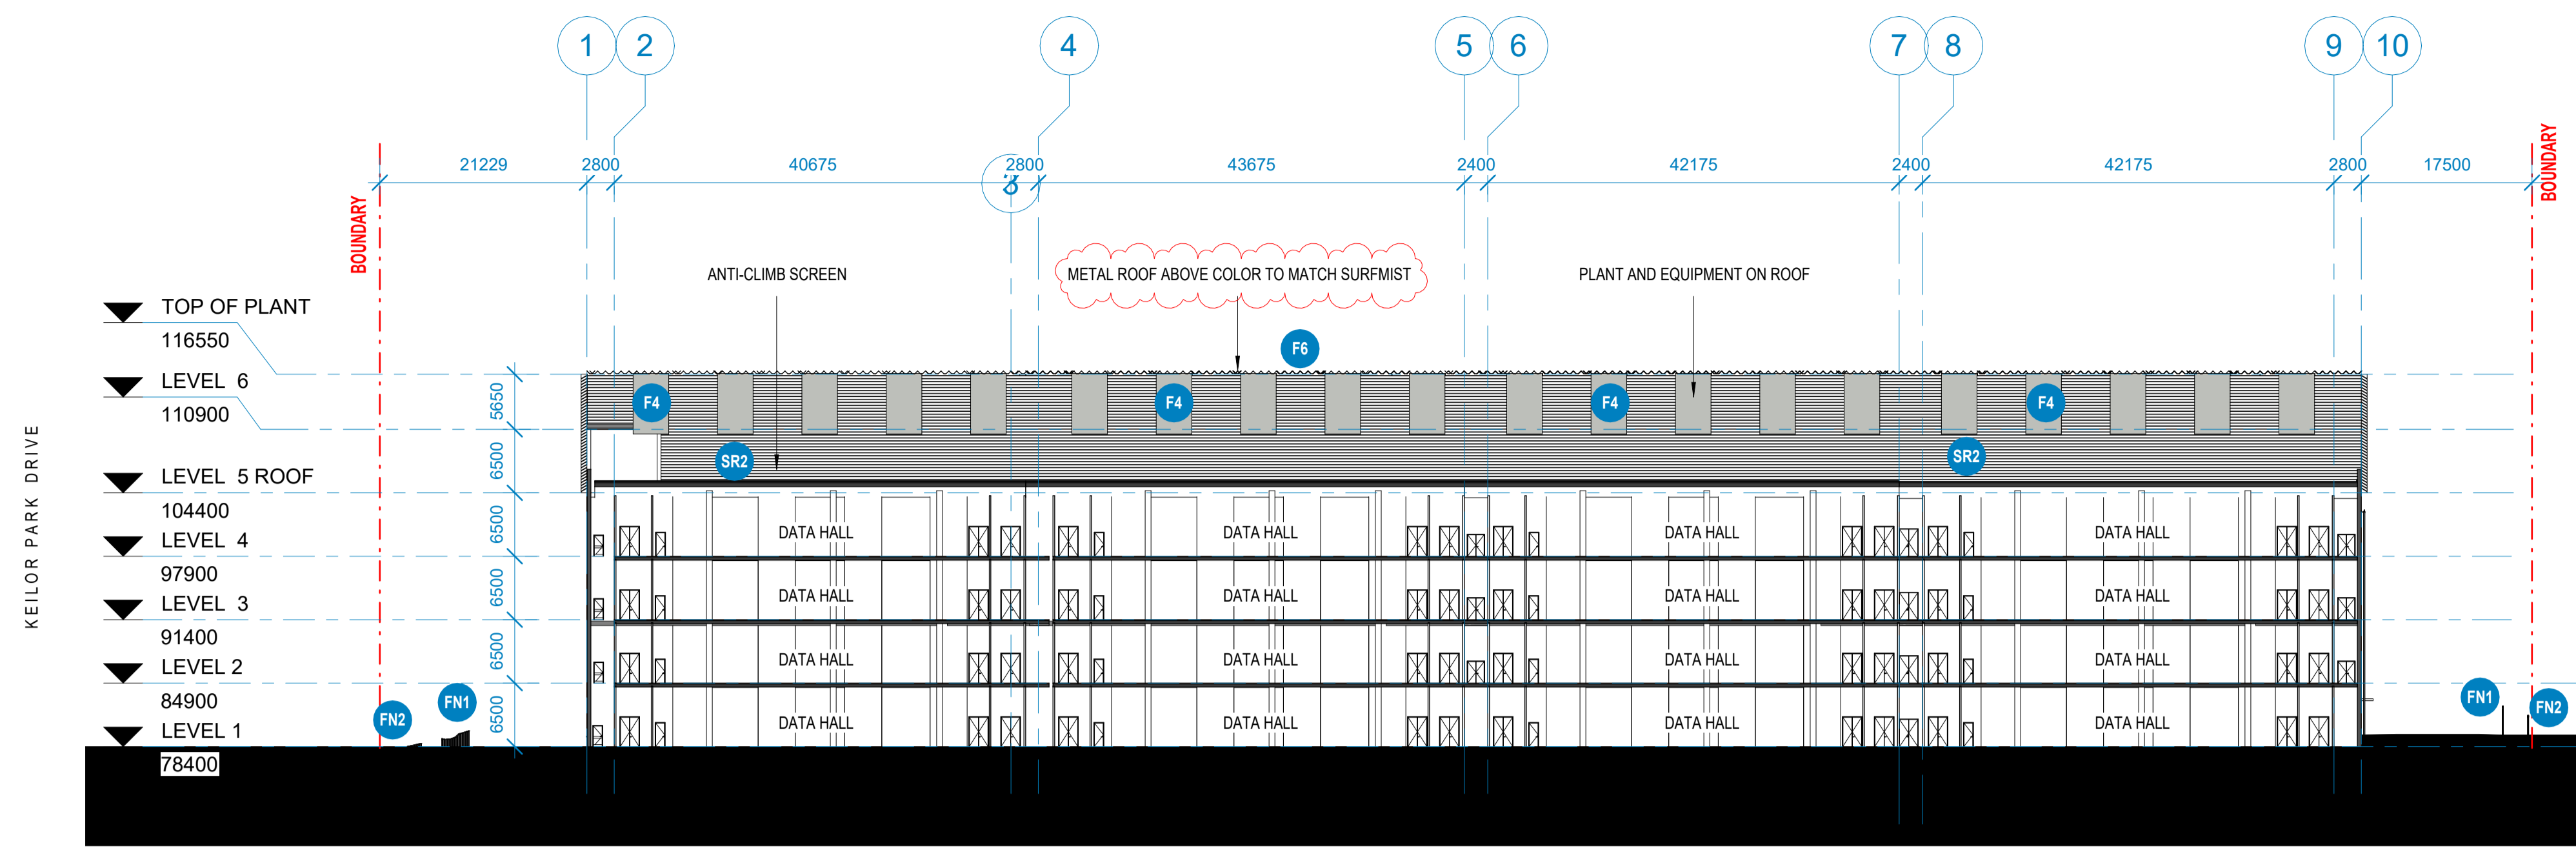

2 DA - SITE SECTION\_WE 03  
1:500

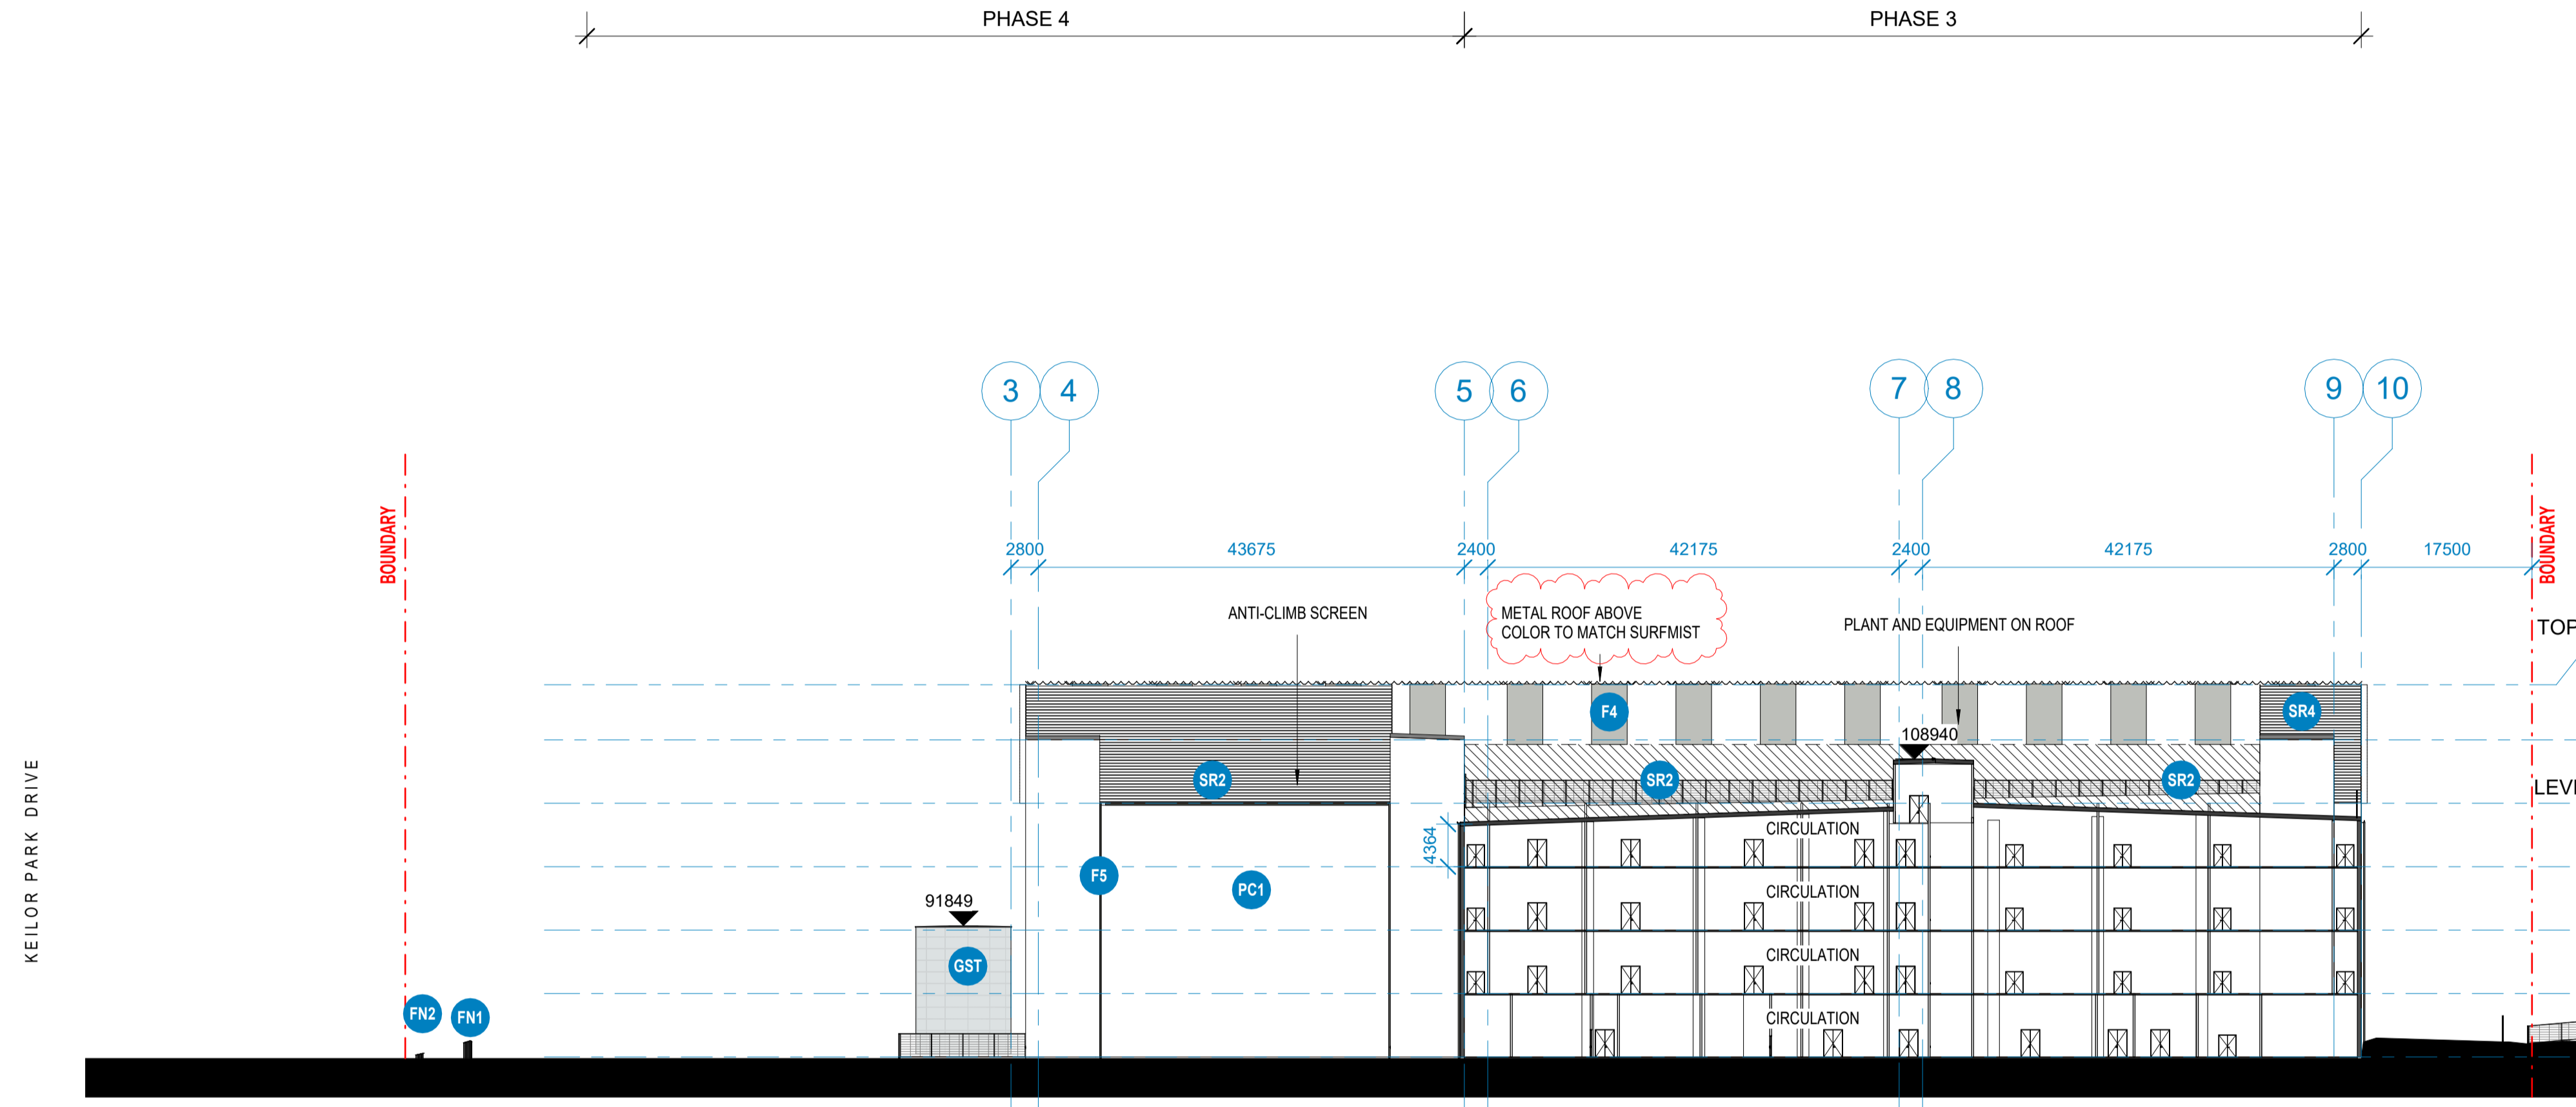

1 DA - SITE SECTION\_WE 02  
1:500

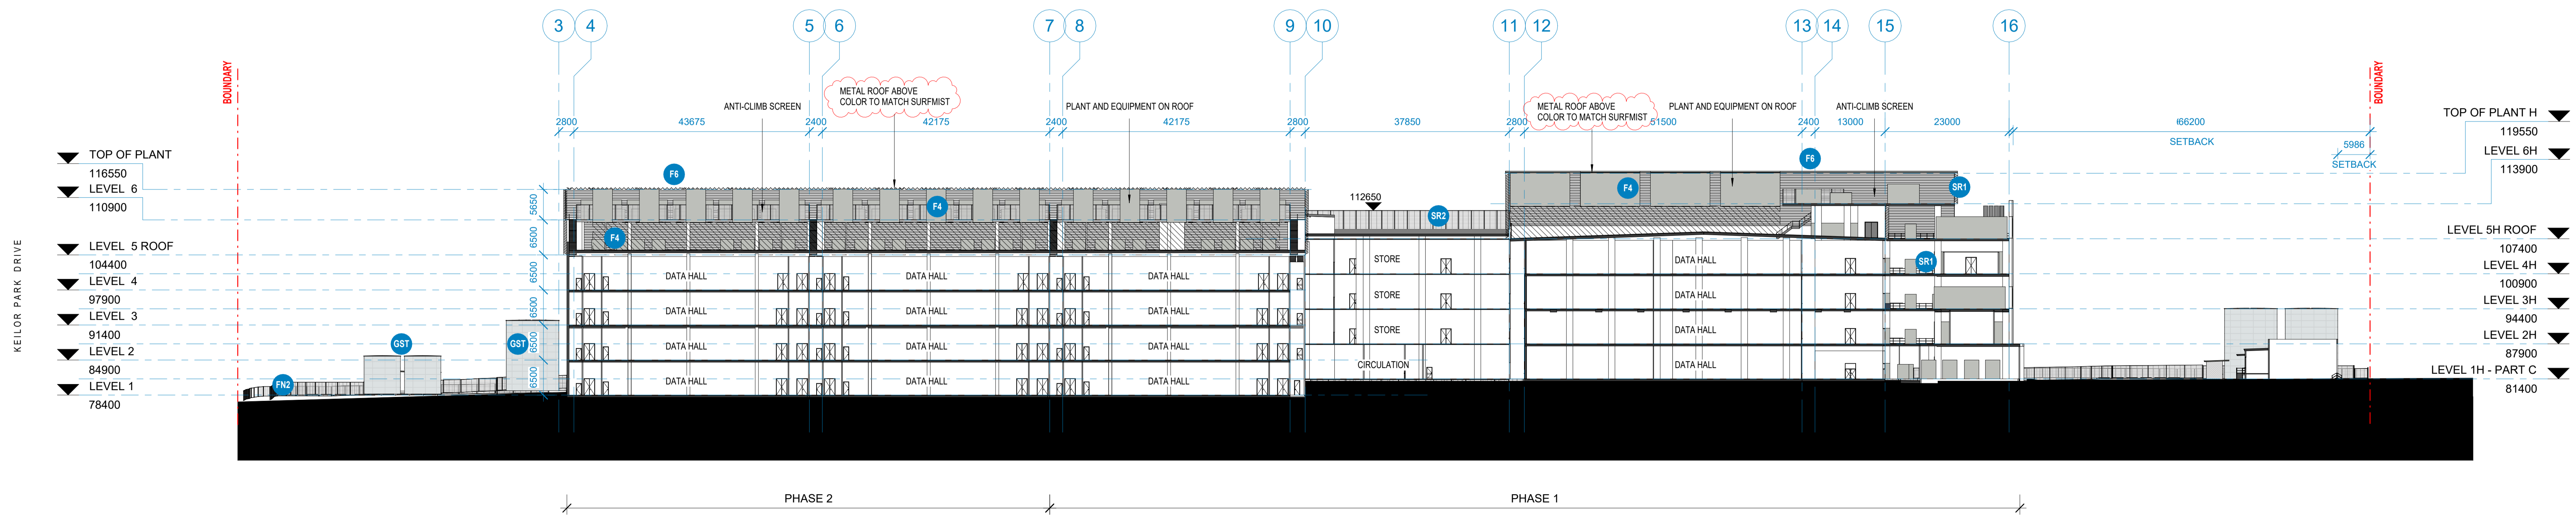

3 DA - SITE SECTION\_WE 01  
1:500

EXTERNAL FINISHES SCHEDULE


Issue	Date	Description
A	31.07.2024	FOR DA
B	21.08.2024	FOR DA
C	26.08.2024	FOR DA
D	28.08.2024	FOR DA
E	03.09.2024	FOR DA
G	18.12.2024	FOR DA

Notes	Key Plan

Project Manager	Client

Construction Manager

**AIRTRUNK Greenbox**  
A WOOLPERT COMPANY

+61 2 8069 8000  
LEVEL 22  
68 PITT STREET  
SYDNEY NSW 2000 AUSTRALIA

GREENBOX ARCHITECTURE PTY LTD  
ABN: 79 139 779 098  
ISO 9001 CERTIFIED QUALITY SYSTEM

• Use written dimensions only  
• Do not scale from drawing  
• Contractors shall confirm all dimensions on-site prior to commencing any work or producing any shop drawings  
• All materials to be used in accordance with the manufacturer's specifications and instructions and shall comply with the relevant Australian Standards  
• Copyright of this drawing and design remain the property of Greenbox Architecture Pty Ltd  
• Nominated Architect - Gerard Page; NSW reg No. 7247; Vic reg No. 17954; QLD reg No. 4538


Client EMKC	Scale 1:500	Sheet 1 of 5	Scale Bar 0 5 10 15 25m
Project PROPOSED DATA CENTRE 85-85 Sharns Road Tullahoma VIC 3043	Drawn By SP	Checked By DK/SFI	Project Status DA SUBMISSION
Job Number 240004	Approved By AD	Drawing Title SITE SECTION	Drawing Number DA031
Issue G			









1 BUILDING G SECTION 1  
1:200

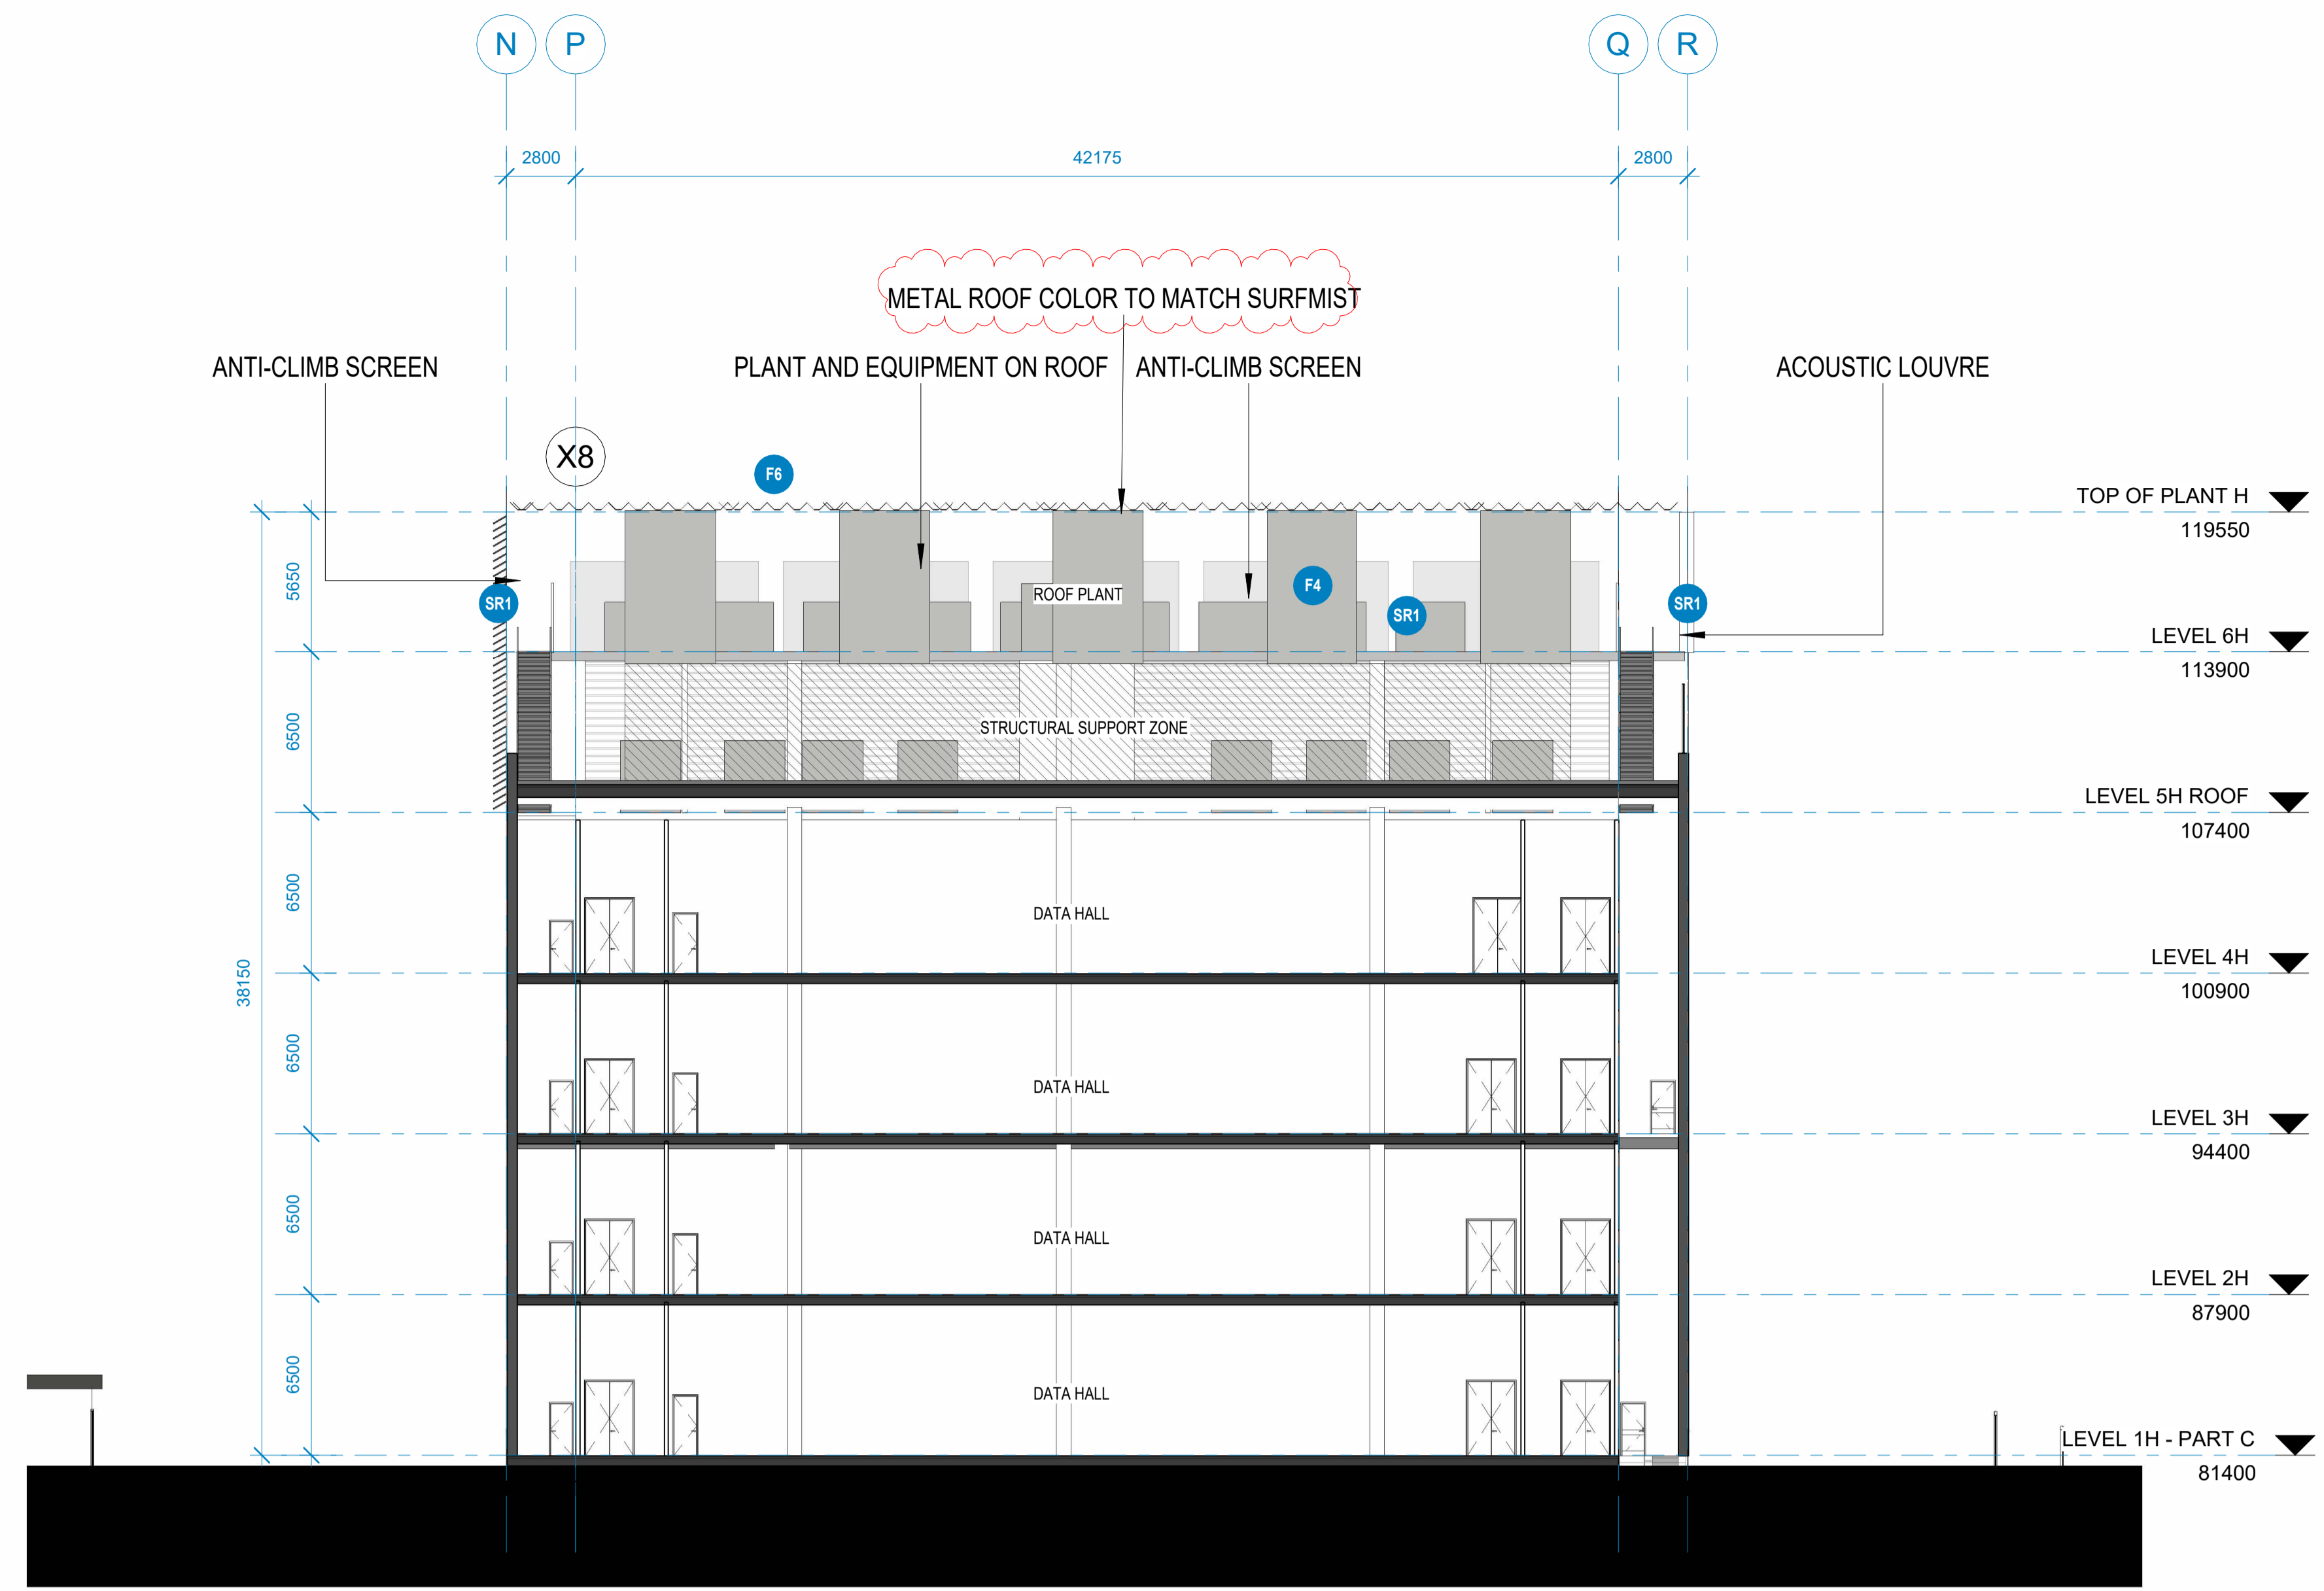

2 BUILDING G SECTION 2  
1:200

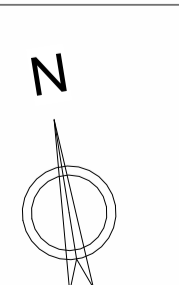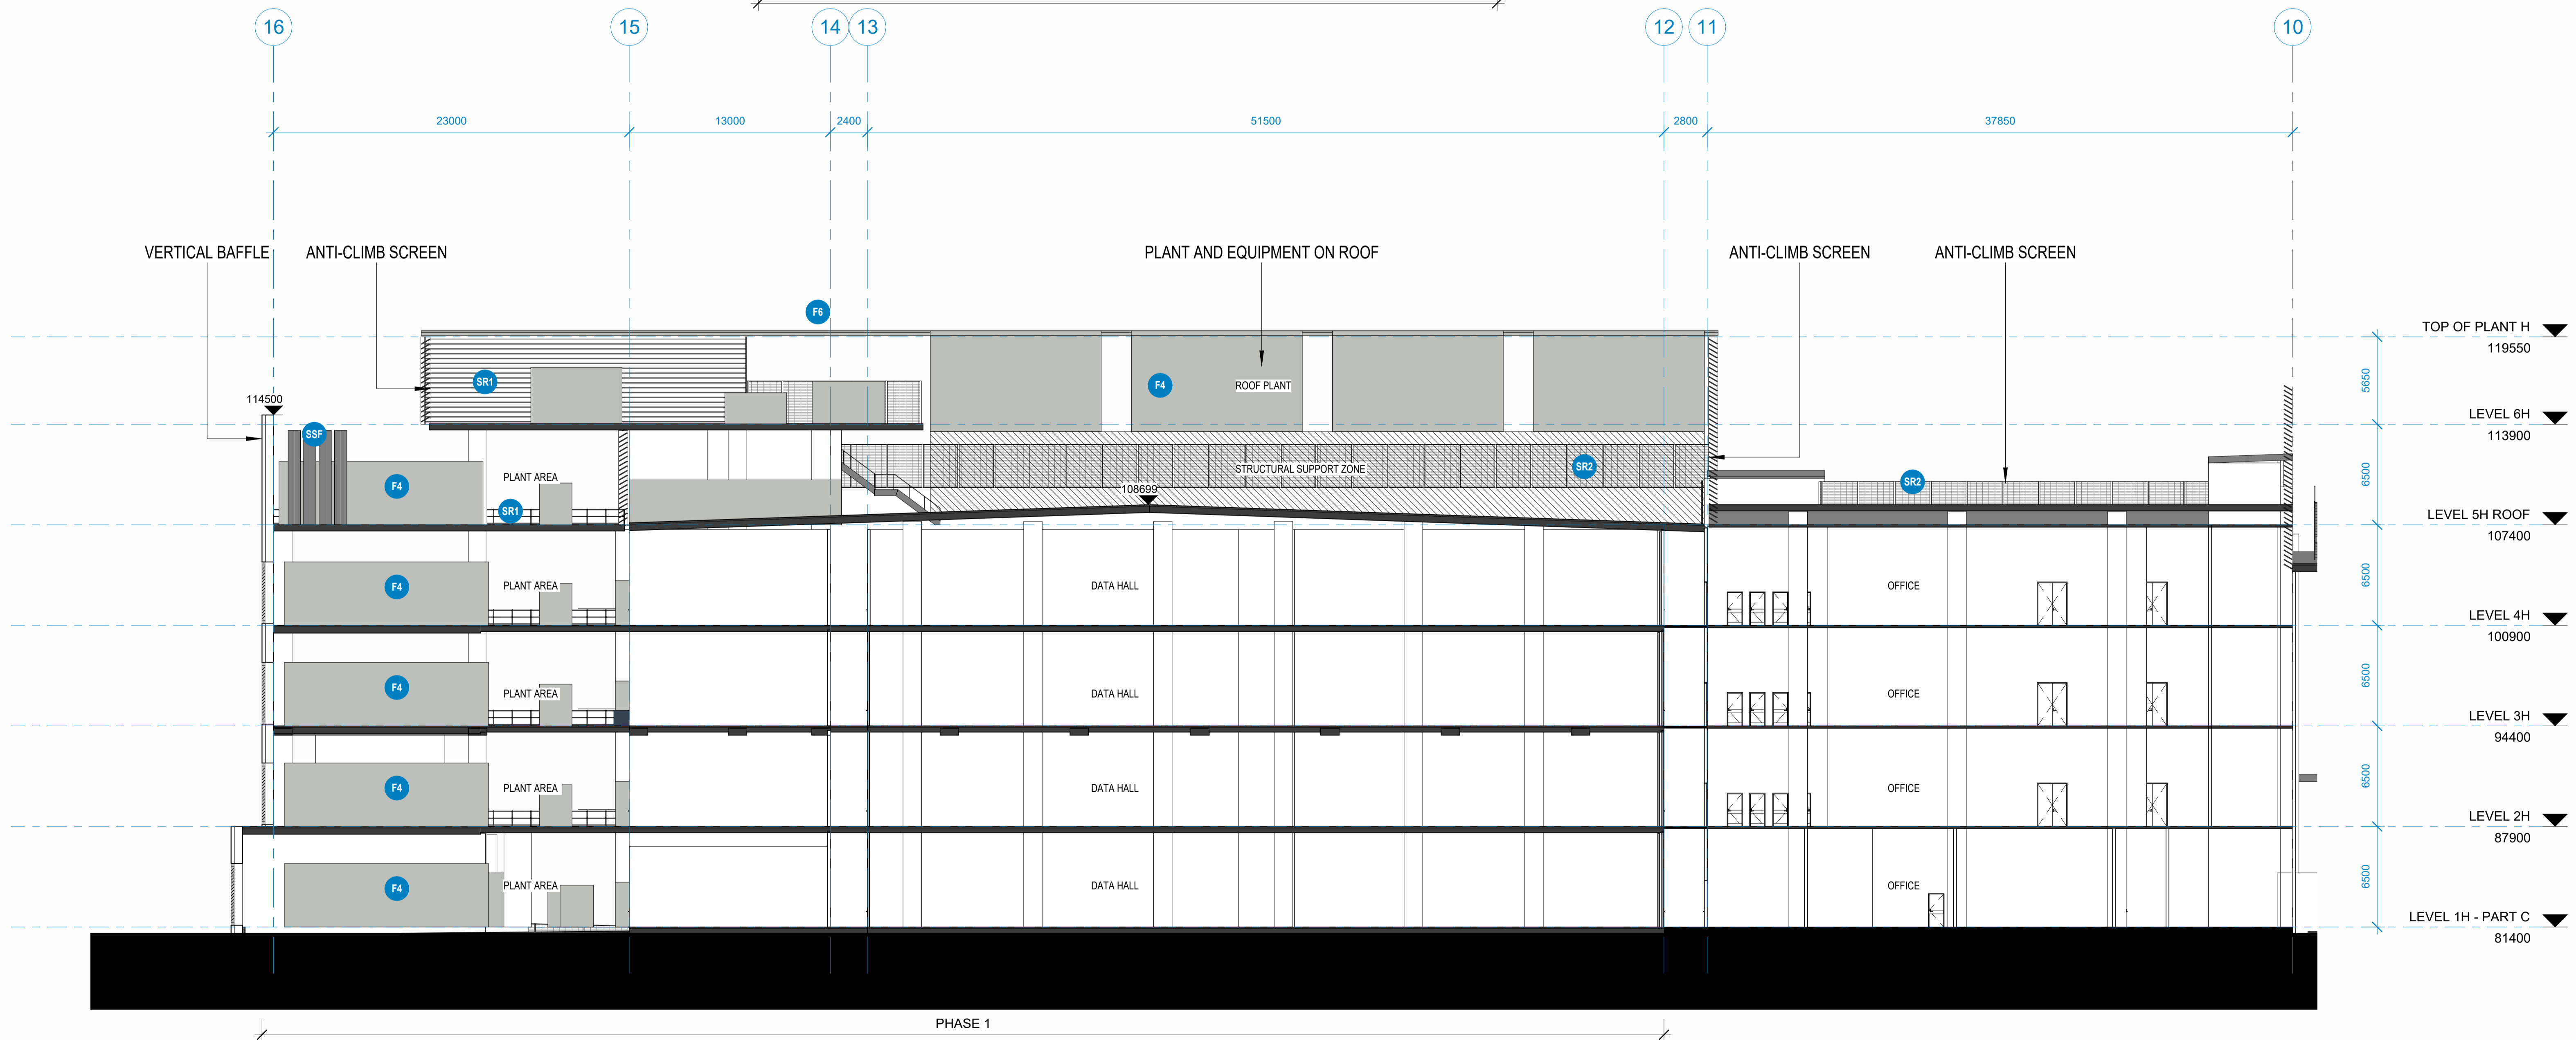

Issue	Date	Description
A	31.07.2024	FOR DA
B	21.08.2024	FOR DA
C	26.08.2024	FOR DA
D	28.08.2024	FOR DA
E	03.09.2024	FOR DA
G	18.12.2024	FOR DA

Notes

Key Plan

Project Manager

Construction Manager

Client

**AIRTRUNK Greenbox**  
A WOOLPERT COMPANY

#1 2 8069 8030  
LEVEL 22  
68 PITT STREET  
SYDNEY NSW 2000 AUSTRALIA

GREENBOX ARCHITECTURE PTY LTD  
ABN: 79 139 779 098  
ISO 9001 CERTIFIED QUALITY SYSTEM

- Use written dimensions only
- Do not scale from drawing
- Contractors shall confirm all dimensions on-site prior to commencing any work or producing any shop drawings
- All materials to be used in accordance with the manufacturer's specifications and instructions and shall comply with the relevant Australian Standards
- Copyright of this drawing and design remain the property of Greenbox Architecture Pty Ltd
- Nominated Architect - Gerard Page, NSW reg No. 7247, Vic reg No. 17864, QLD reg no. 4538


Client

EMKC


Project  
PROPOSED DATA CENTRE  
85-86 Sharps Road  
Tullahoma VIC 3043

Scale	Sheet	Scale Bar
1:200	0 1 2 3 5 10m	
Drawn By SP	Checked By DK/SFI	Project Status <b>DA SUBMISSION</b>
Approved By AD	Job Number 240004	Drawing Title <b>BUILDING SECTION</b>
	Drawing Number DA033	Issue G



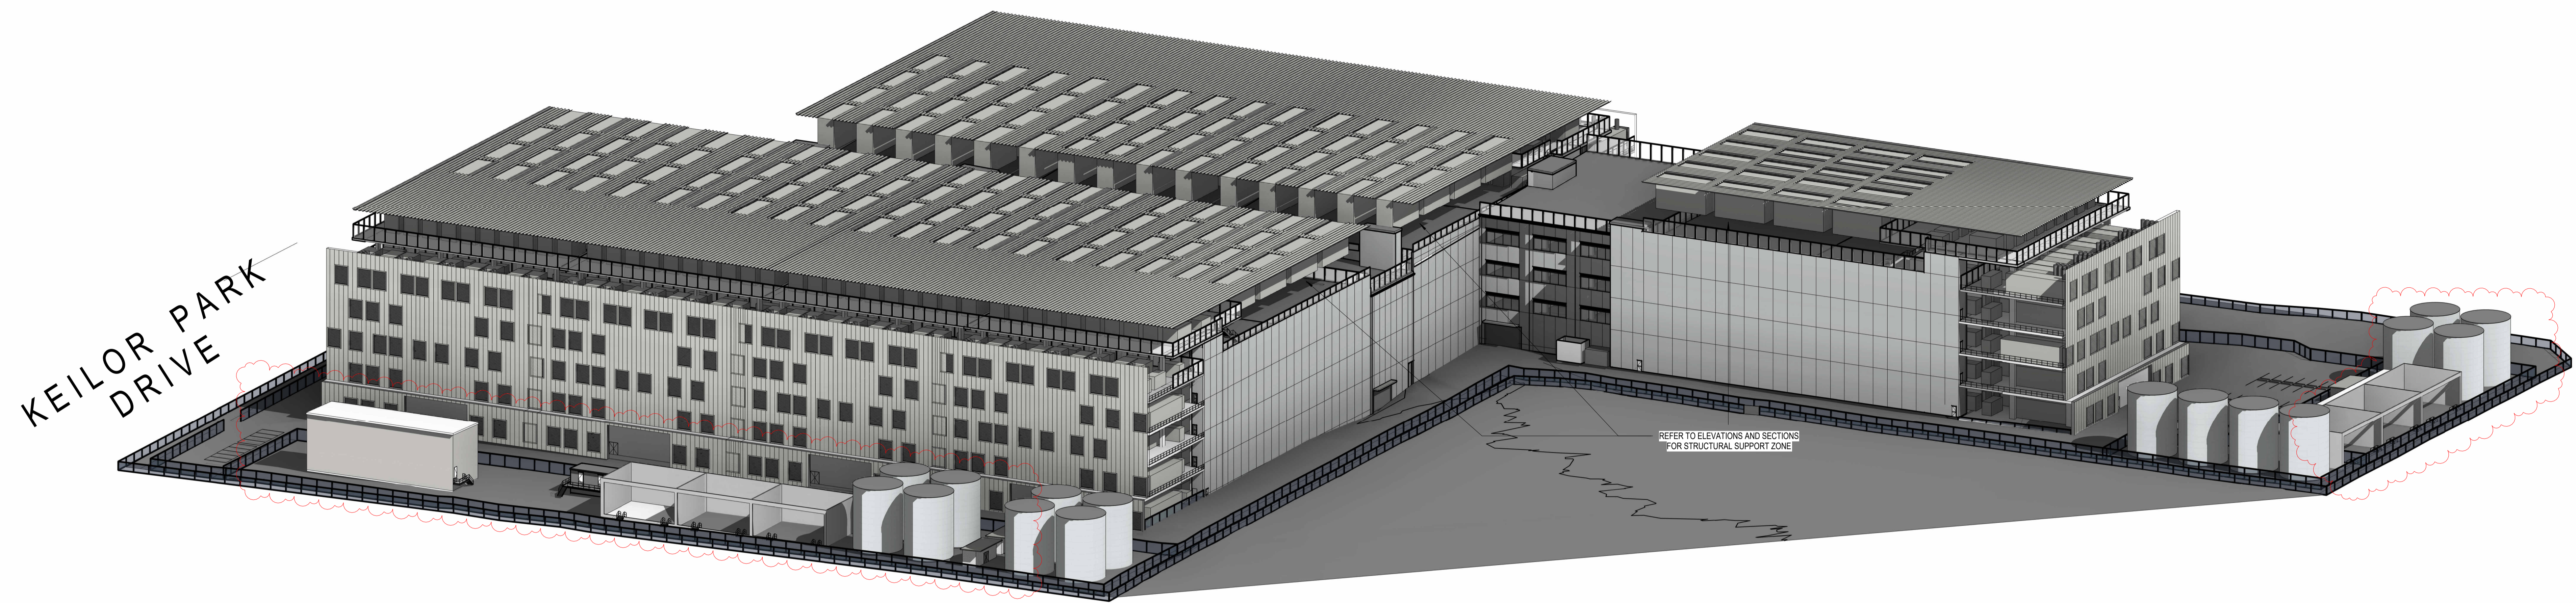

1 DA - AXO VIEW FROM SOUTH

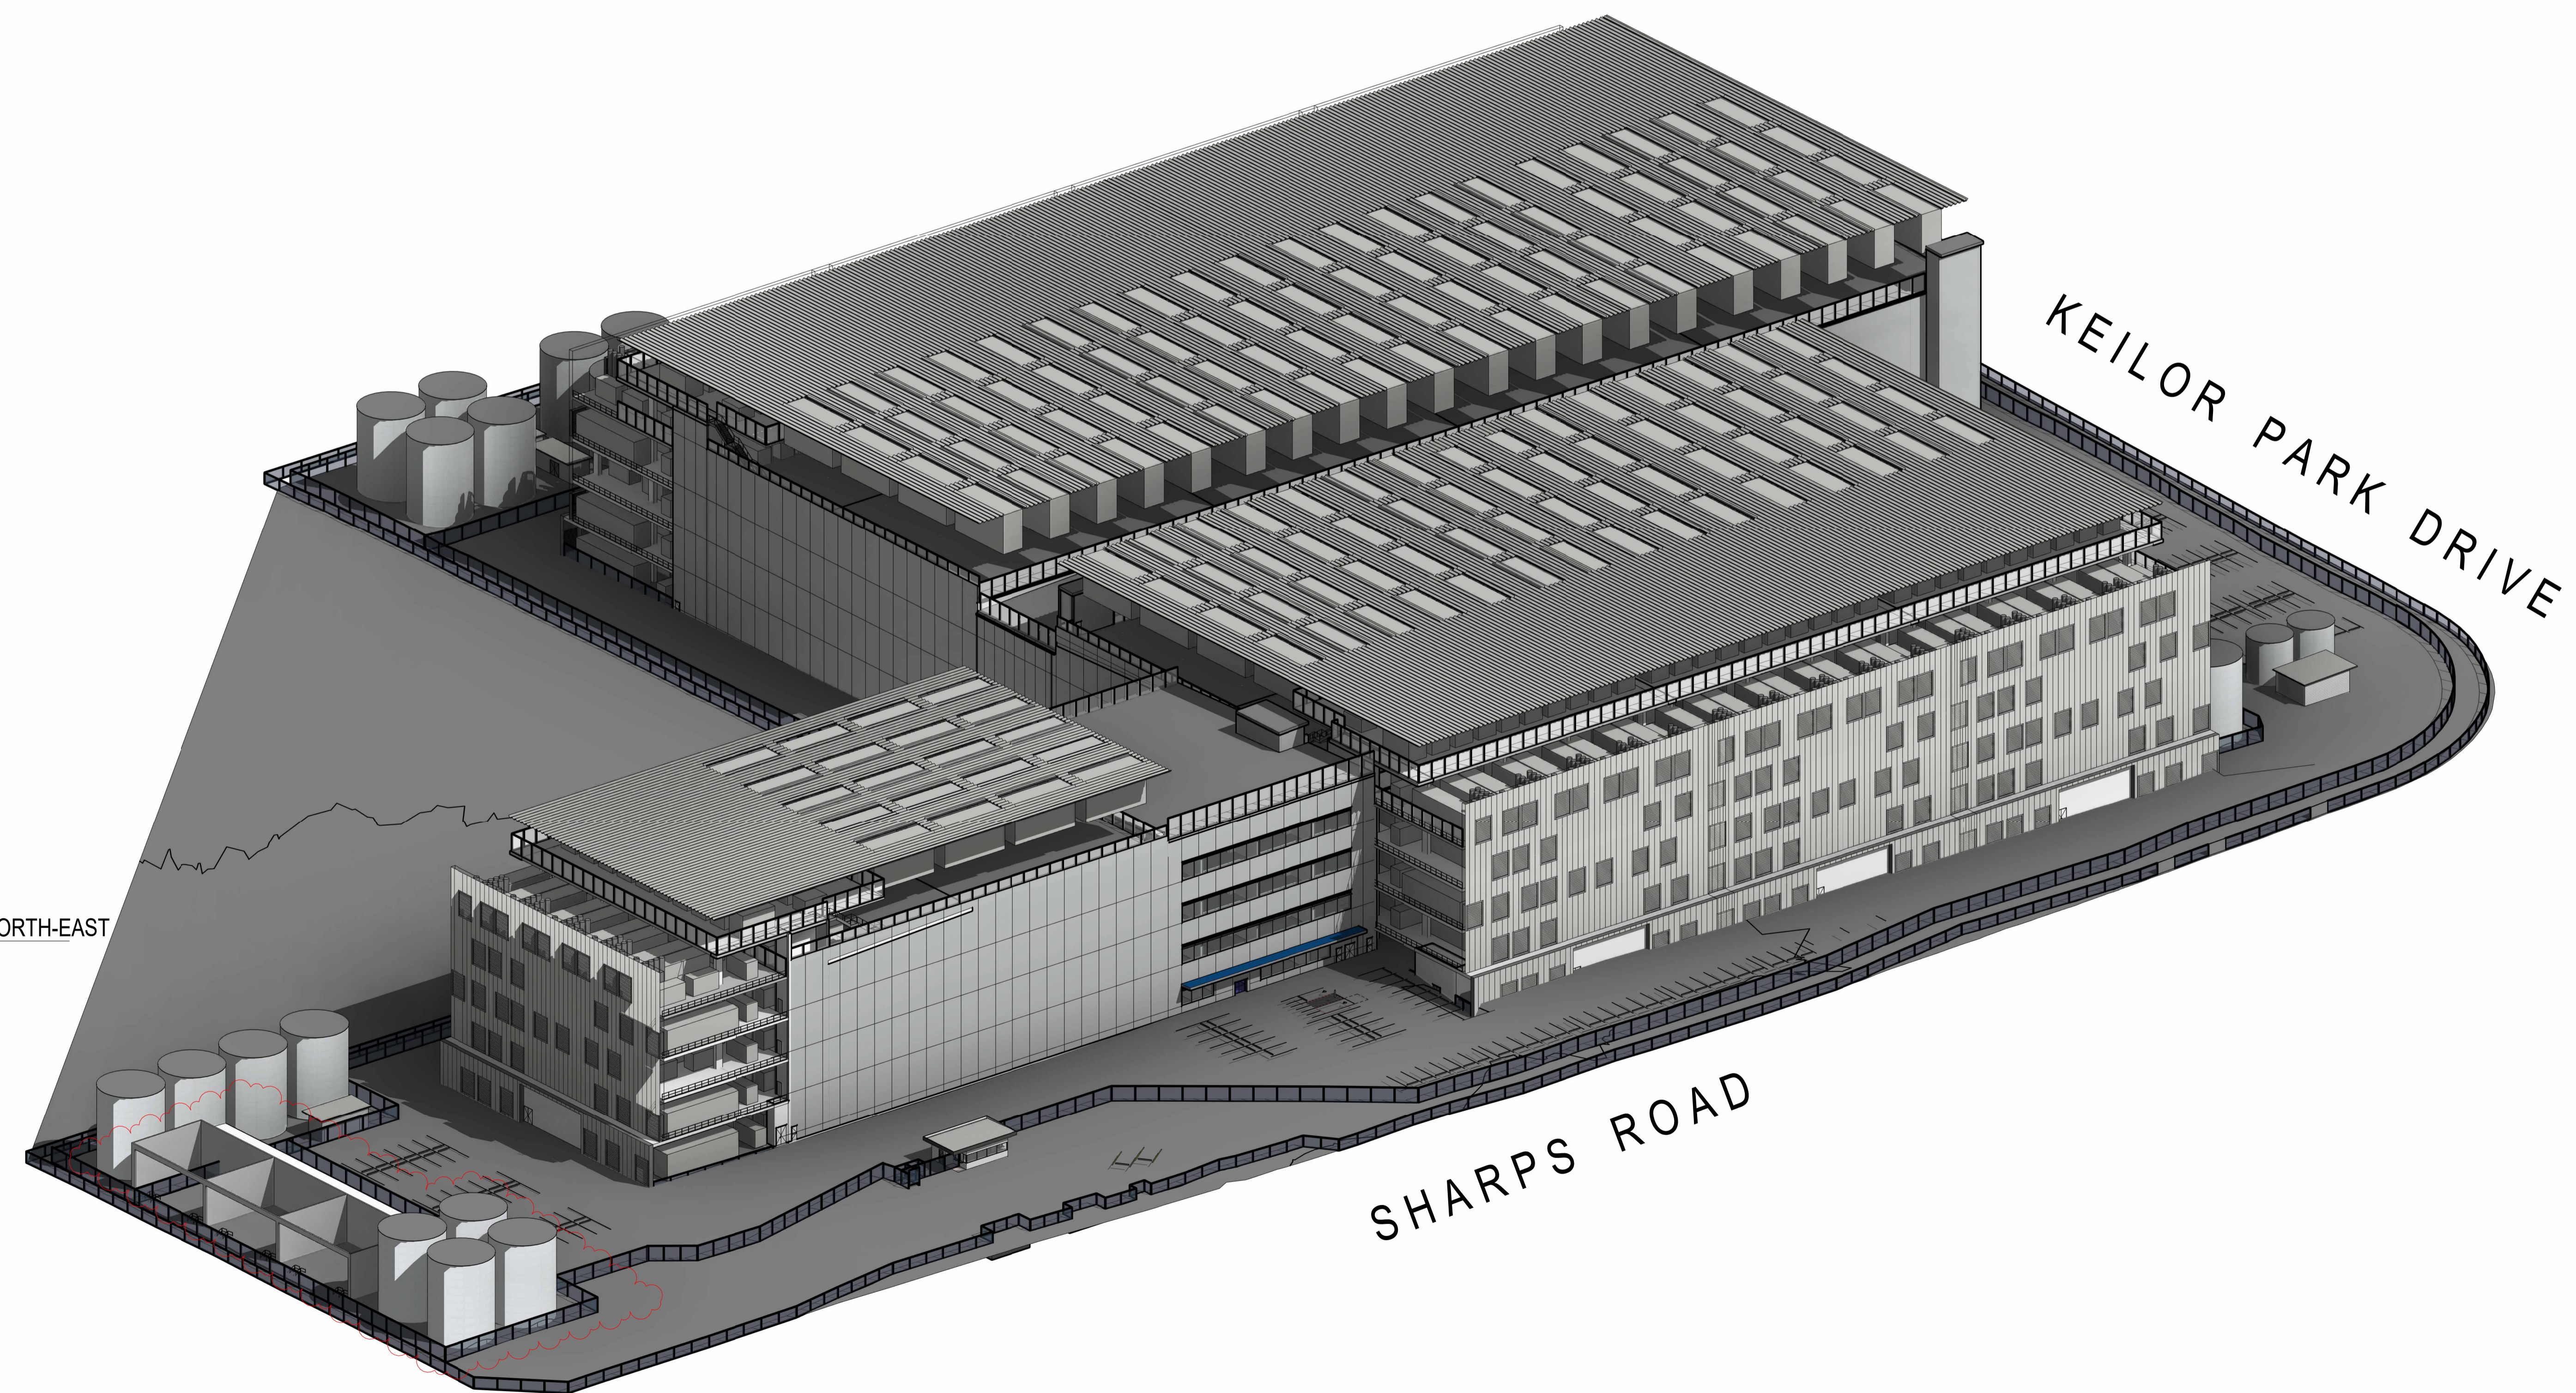


2 DA - AXO VIEW FROM NORTH-EAST

Issue A 31.07.2024 FOR DA B 21.08.2024 FOR DA D 28.08.2024 FOR DA G 18.12.2024 FOR DA	Date Description Description	Notes	Key Plan	Project Manager	Client <b>AIRTRUNK Greenbox</b> A WOOLPERT COMPANY	• Use written dimensions only • Do not scale from drawing • Contractors shall confirm all dimensions on-site prior to commencing any work or producing any shop drawings • All materials to be used in accordance with the manufacturer's specifications and instructions and shall comply with the relevant Australian Standards • Copyright of this drawing and design remain the property of Greenbox Architecture Pty Ltd • Nominated Architect - Gerard Page; NSW reg No. 7247, Vic reg No. 17954, QLD reg no. 4538	Client EMKC	Scale N.T.S. Drawing By SP Checked By DK/SFI Approved By AD Job Number 240004	Sheet Scale Bar N.T.S. Project Status <b>DA SUBMISSION</b> Drawing Title <b>3D VIEWS</b> Drawing Number DA040 Issue G	DRAWING IS NOT TO SCALE DO NOT SCALE DRAWING





1 LEVEL 1 - PART A  
1:200

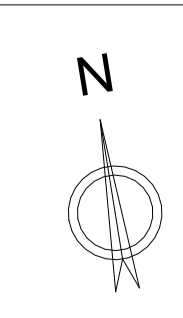

Issue	Date	Description
A	31.07.2024	FOR DA
B	21.08.2024	FOR DA
C	26.08.2024	FOR DA
D	28.08.2024	FOR DA

Notes

Key Plan

Project Manager

Client

Construction Manager



+61 2 8069 8600  
LEVEL 22  
68 PITT STREET  
SYDNEY NSW 2000 AUSTRALIA

GREENBOX ARCHITECTURE PTY LTD  
ABN: 79 139 778 098  
ISO 9001 CERTIFIED QUALITY SYSTEM

• Use written dimensions only  
• Do not scale from drawing  
• Contractors shall confirm all dimensions on-site prior to commencing any work or producing any shop drawings  
• All materials to be used in accordance with the manufacturer's specifications and instructions and shall comply with the relevant Australian Standards  
• Copyright of this drawing and design remain the property of Greenbox Architecture Pty Ltd  
• Nominated Architect - Gerard Page; NSW reg No. 7247; Vic reg No. 17864; QLD reg no. 4538

Client  
EMKC

Project  
PROPOSED DATA CENTRE  
85-86 Sharps Road  
Tullamarine VIC 3043

Scale  
1:200

Checked By  
DK/SFI

Approved By  
AD

Job Number  
240004

Sheet  
1:200

Project Status


Drawing Title  
PART A LEVEL 1

Drawing Number  
DA101


Scale Bar  
0 1 2 3 5 10m

Issue  
D



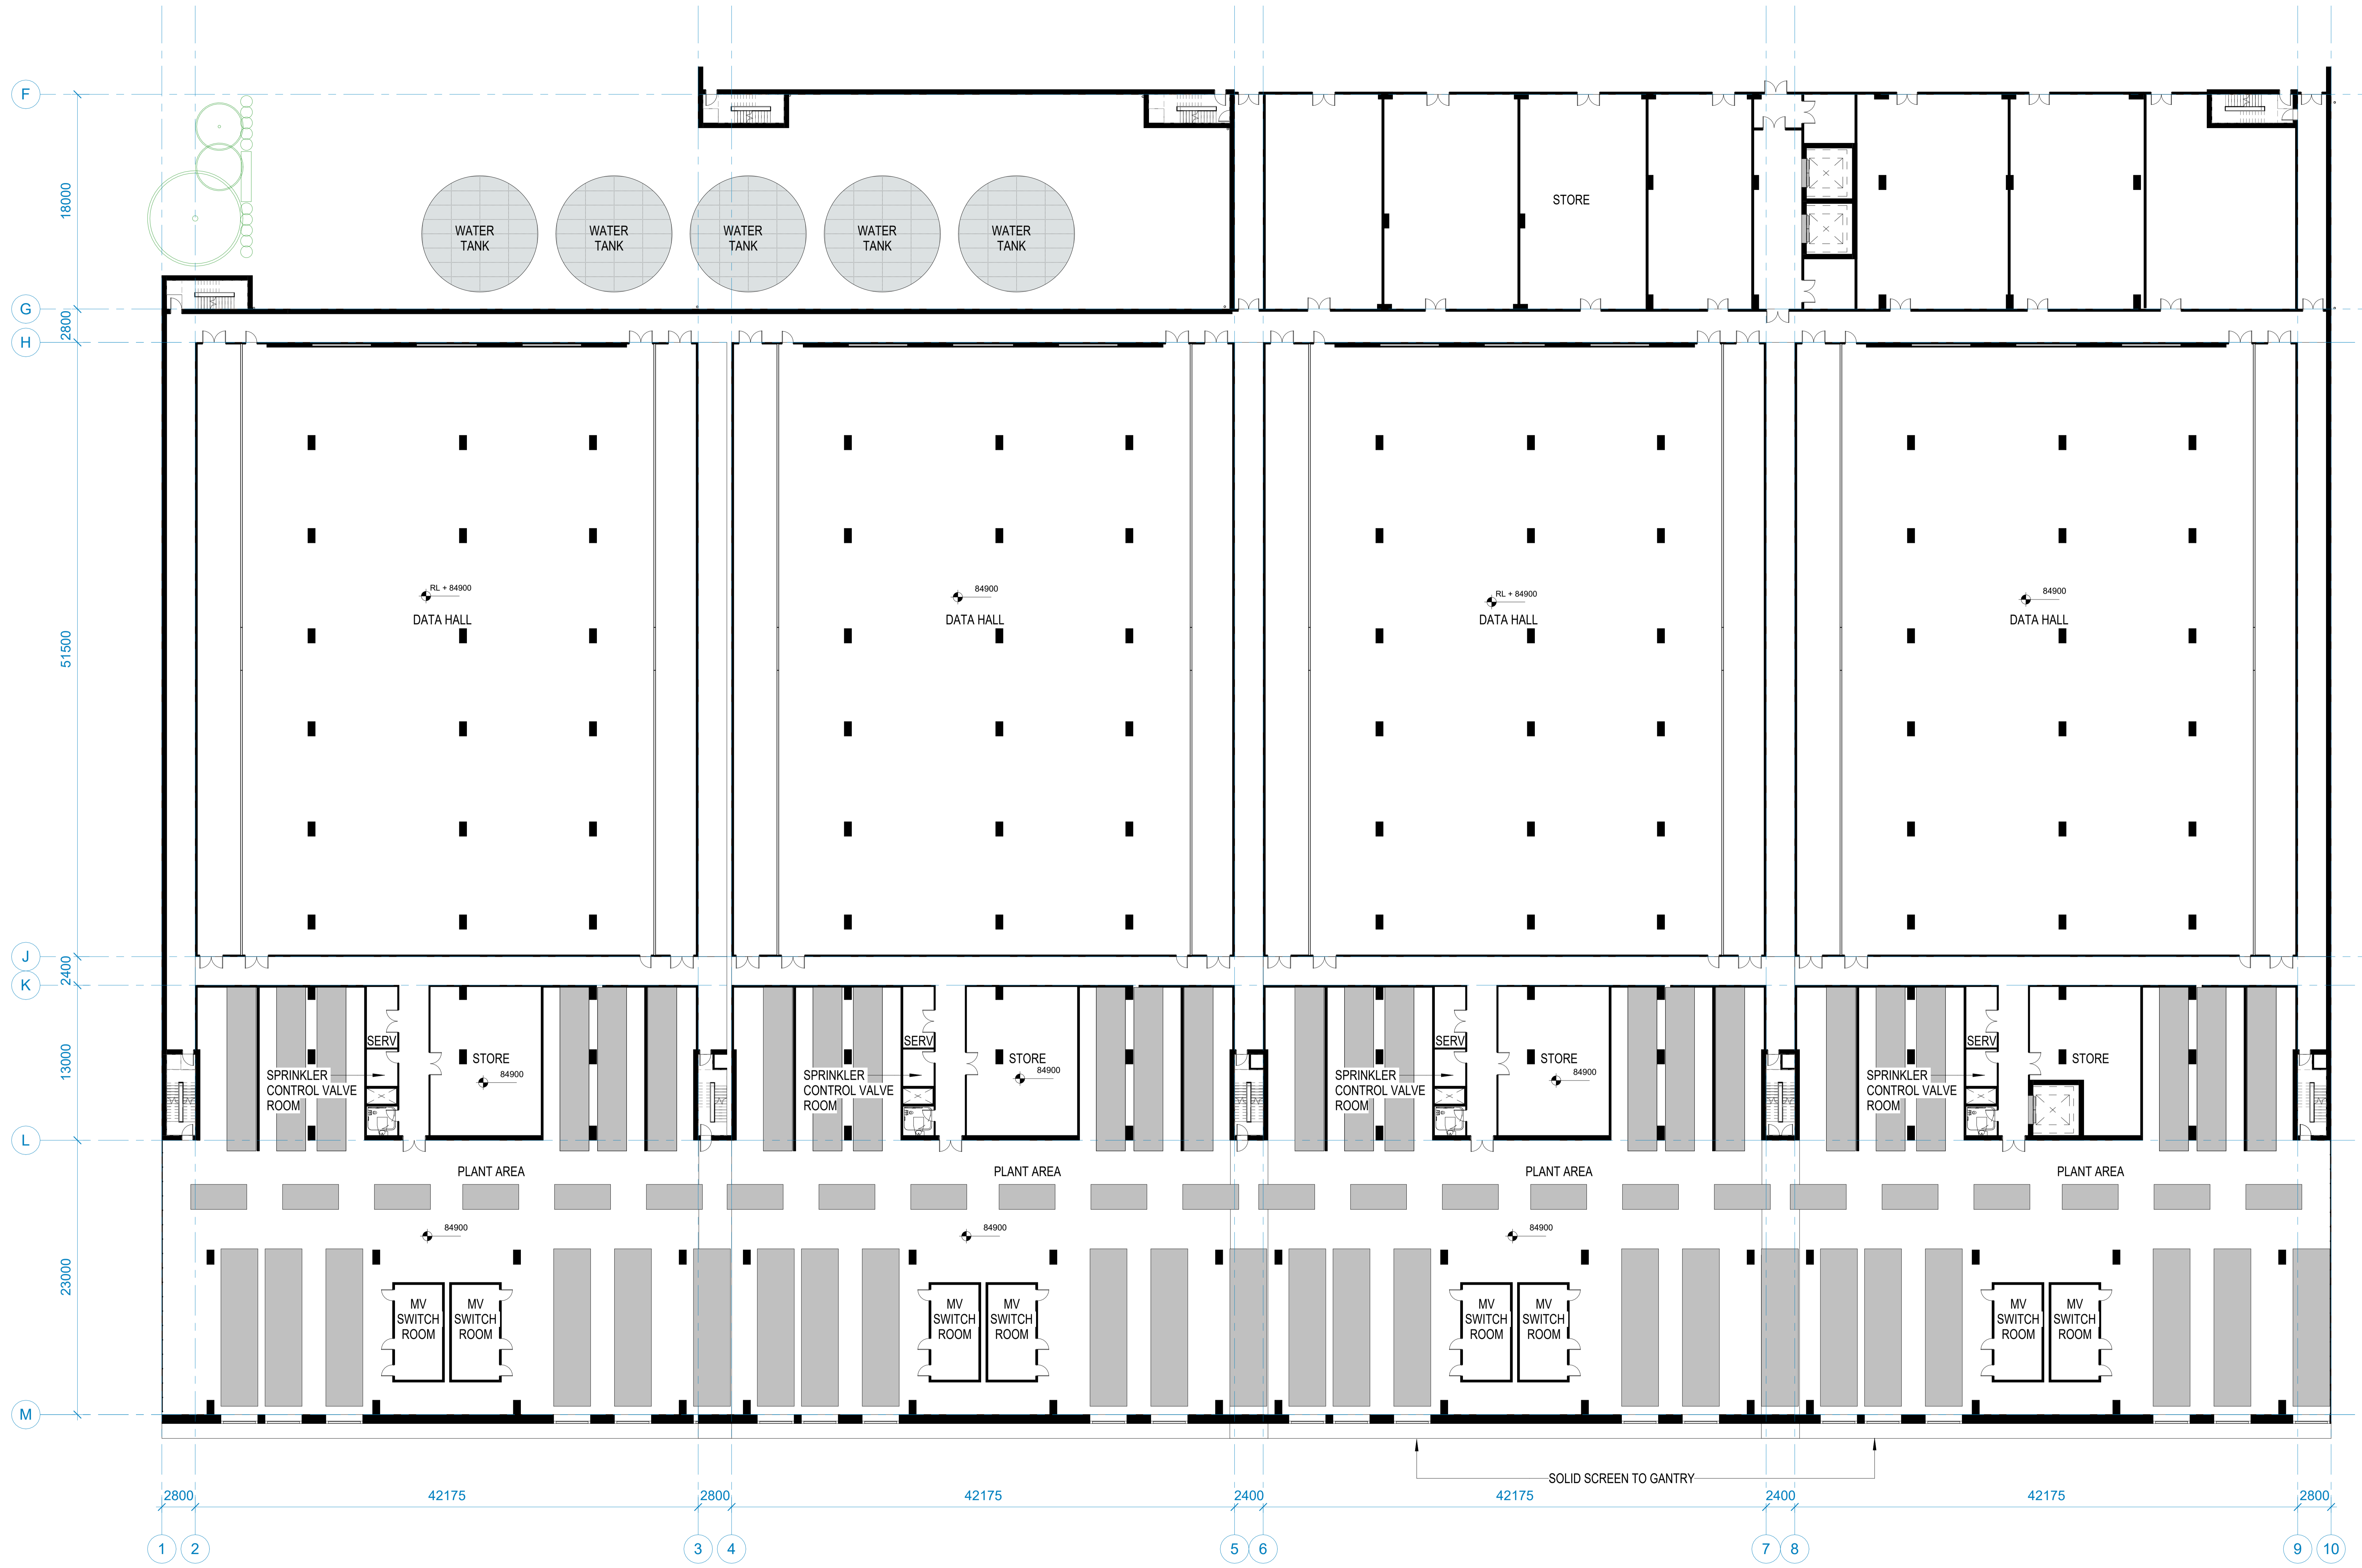

1 PART A - L2 - L4 PLAN (TYPICAL)  
1:200

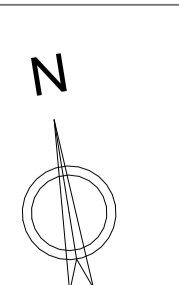

Issue	Date	Description
A	31.07.2024	FOR DA
B	21.08.2024	FOR DA
C	26.08.2024	FOR DA
D	28.08.2024	FOR DA

Notes

Key Plan

Project Manager

Client

Construction Manager



+61 2 8069 8600  
LEVEL 22  
68 PITT STREET  
SYDNEY NSW 2000 AUSTRALIA

GREENBOX ARCHITECTURE PTY LTD  
ABN: 79 139 778 098  
ISO 9001 CERTIFIED QUALITY SYSTEM


- Use written dimensions only
- Do not scale from drawing
- Contractors shall confirm all dimensions on-site prior to commencing any work or producing any shop drawings
- All materials to be used in accordance with the manufacturer's specifications and instructions and shall comply with the relevant Australian Standards
- Copyright of this drawing and design remain the property of Greenbox Architecture Pty Ltd
- Nominated Architect - Gerard Page; NSW reg No. 7247; Vic reg No. 17954; QLD reg No. 4538

Client  
EMKC


Project  
PROPOSED DATA CENTRE  
85-86 Sharps Road  
Tullahoma VIC 3043

Scale	Sheet	Scale Bar	Project Status
1:200	1:500	0 5 10 15 25m	Project Status
Drawn By AZ/SFI	Checked By DK/SFI	Approved By AD	Drawing Title PART A L2 - L4 PLAN (TYPICAL)
Job Number 240004	Drawing Number DA102	Issue D	



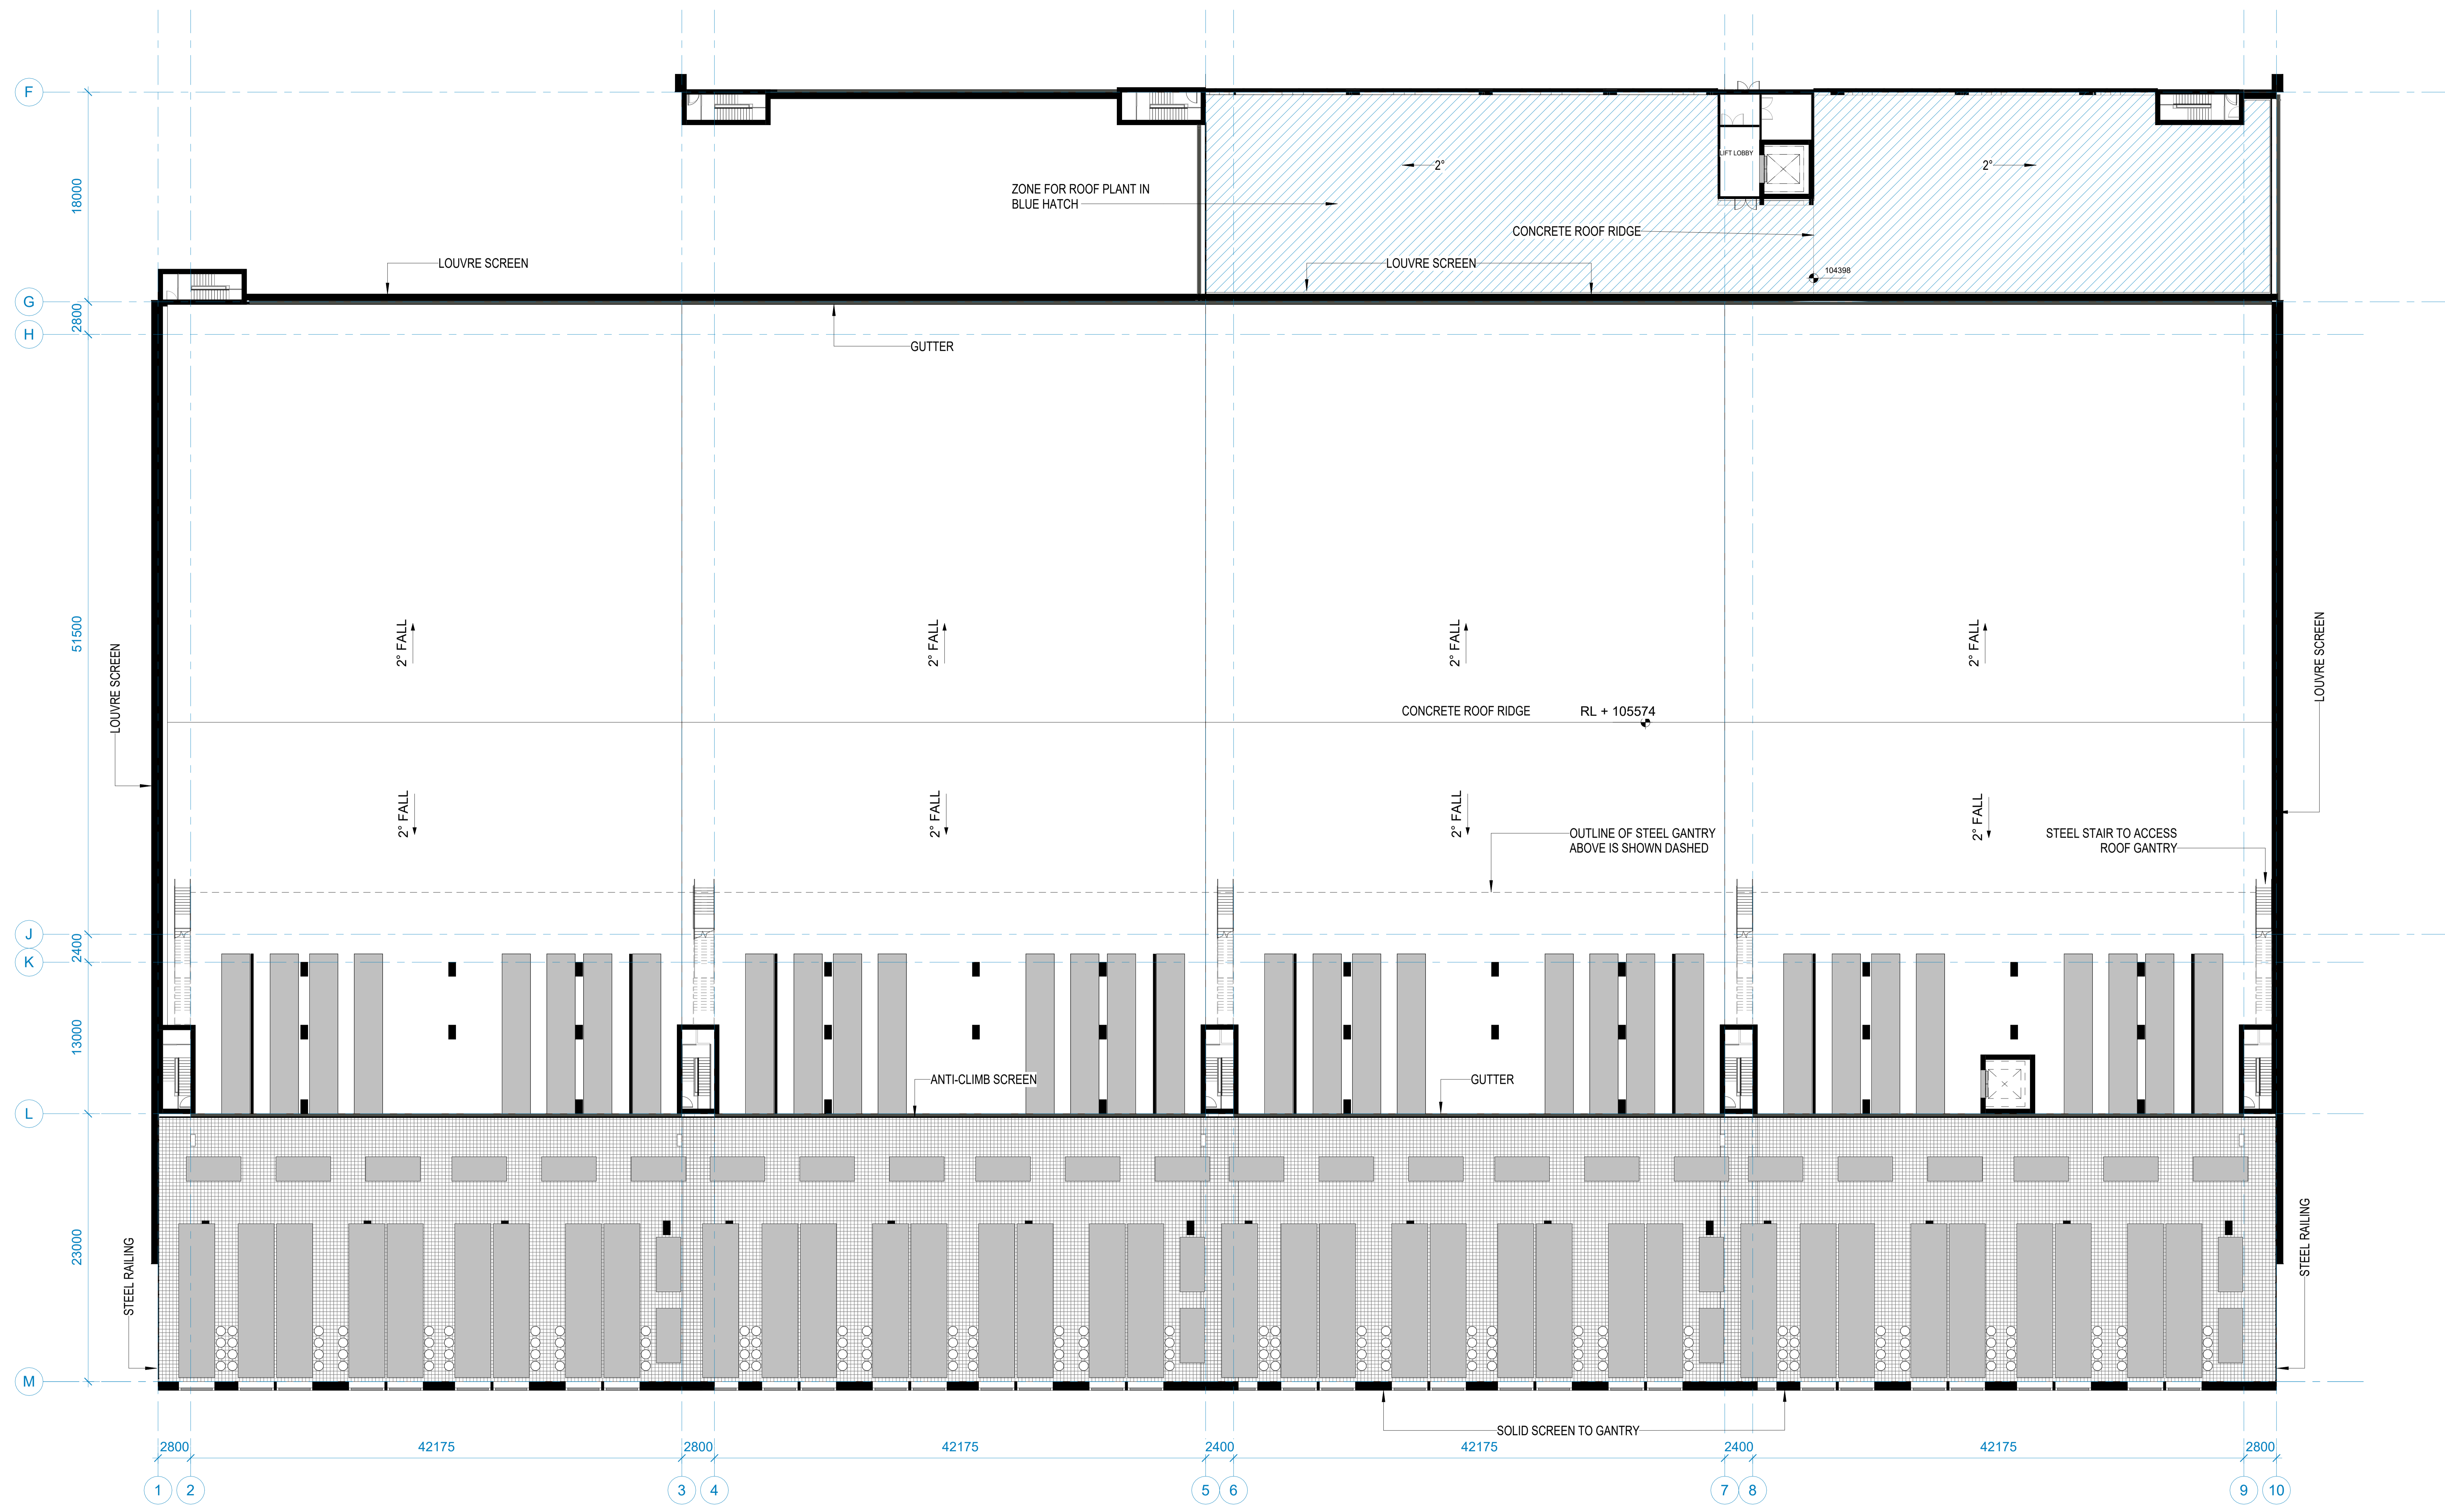

1 DA - LEVEL 5 ROOF - PART A  
1:200

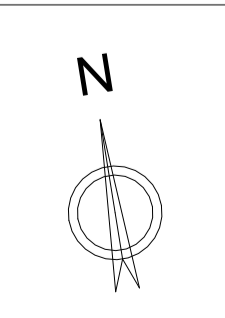

Issue	Date	Description
A	31.07.2024	FOR DA
B	21.08.2024	FOR DA
C	26.08.2024	FOR DA
D	28.08.2024	FOR DA
E	03.09.2024	FOR DA

Notes

Key Plan

Project Manager

Client

Construction Manager



+61 2 8069 8600  
LEVEL 22  
68 PITT STREET  
SYDNEY NSW 2000 AUSTRALIA

GREENBOX ARCHITECTURE PTY LTD  
ABN: 79 139 778 098  
ISO 9001 CERTIFIED QUALITY SYSTEM

- Use written dimensions only
- Do not scale from drawing
- Contractors shall confirm all dimensions on-site prior to commencing any work or producing any shop drawings
- All materials to be used in accordance with the manufacturer's specifications and instructions and shall comply with the relevant Australian Standards
- Copyright of this drawing and design remain the property of Greenbox Architecture Pty Ltd
- Nominated Architect - Gerard Page; NSW reg No. 7247; Vic reg No. 17954; QLD reg No. 4538

Client

EMKC

Project

PROPOSED DATA CENTRE

85-86 Sharps Road  
Tullamarine VIC 3043

Scale

1:200

Drawn By

AZ/SFI

Checked By

DK/SFI

Approved By

AD

Sheet

1

Scale Bar

1:500

Project Scale

DA SUBMISSION

Drawing Title

PART A LEVEL 5 (ROOF)

Drawing Number

DA105

Issue

E


Job Number

240004


Scale Bar

0 5 10 15 25m



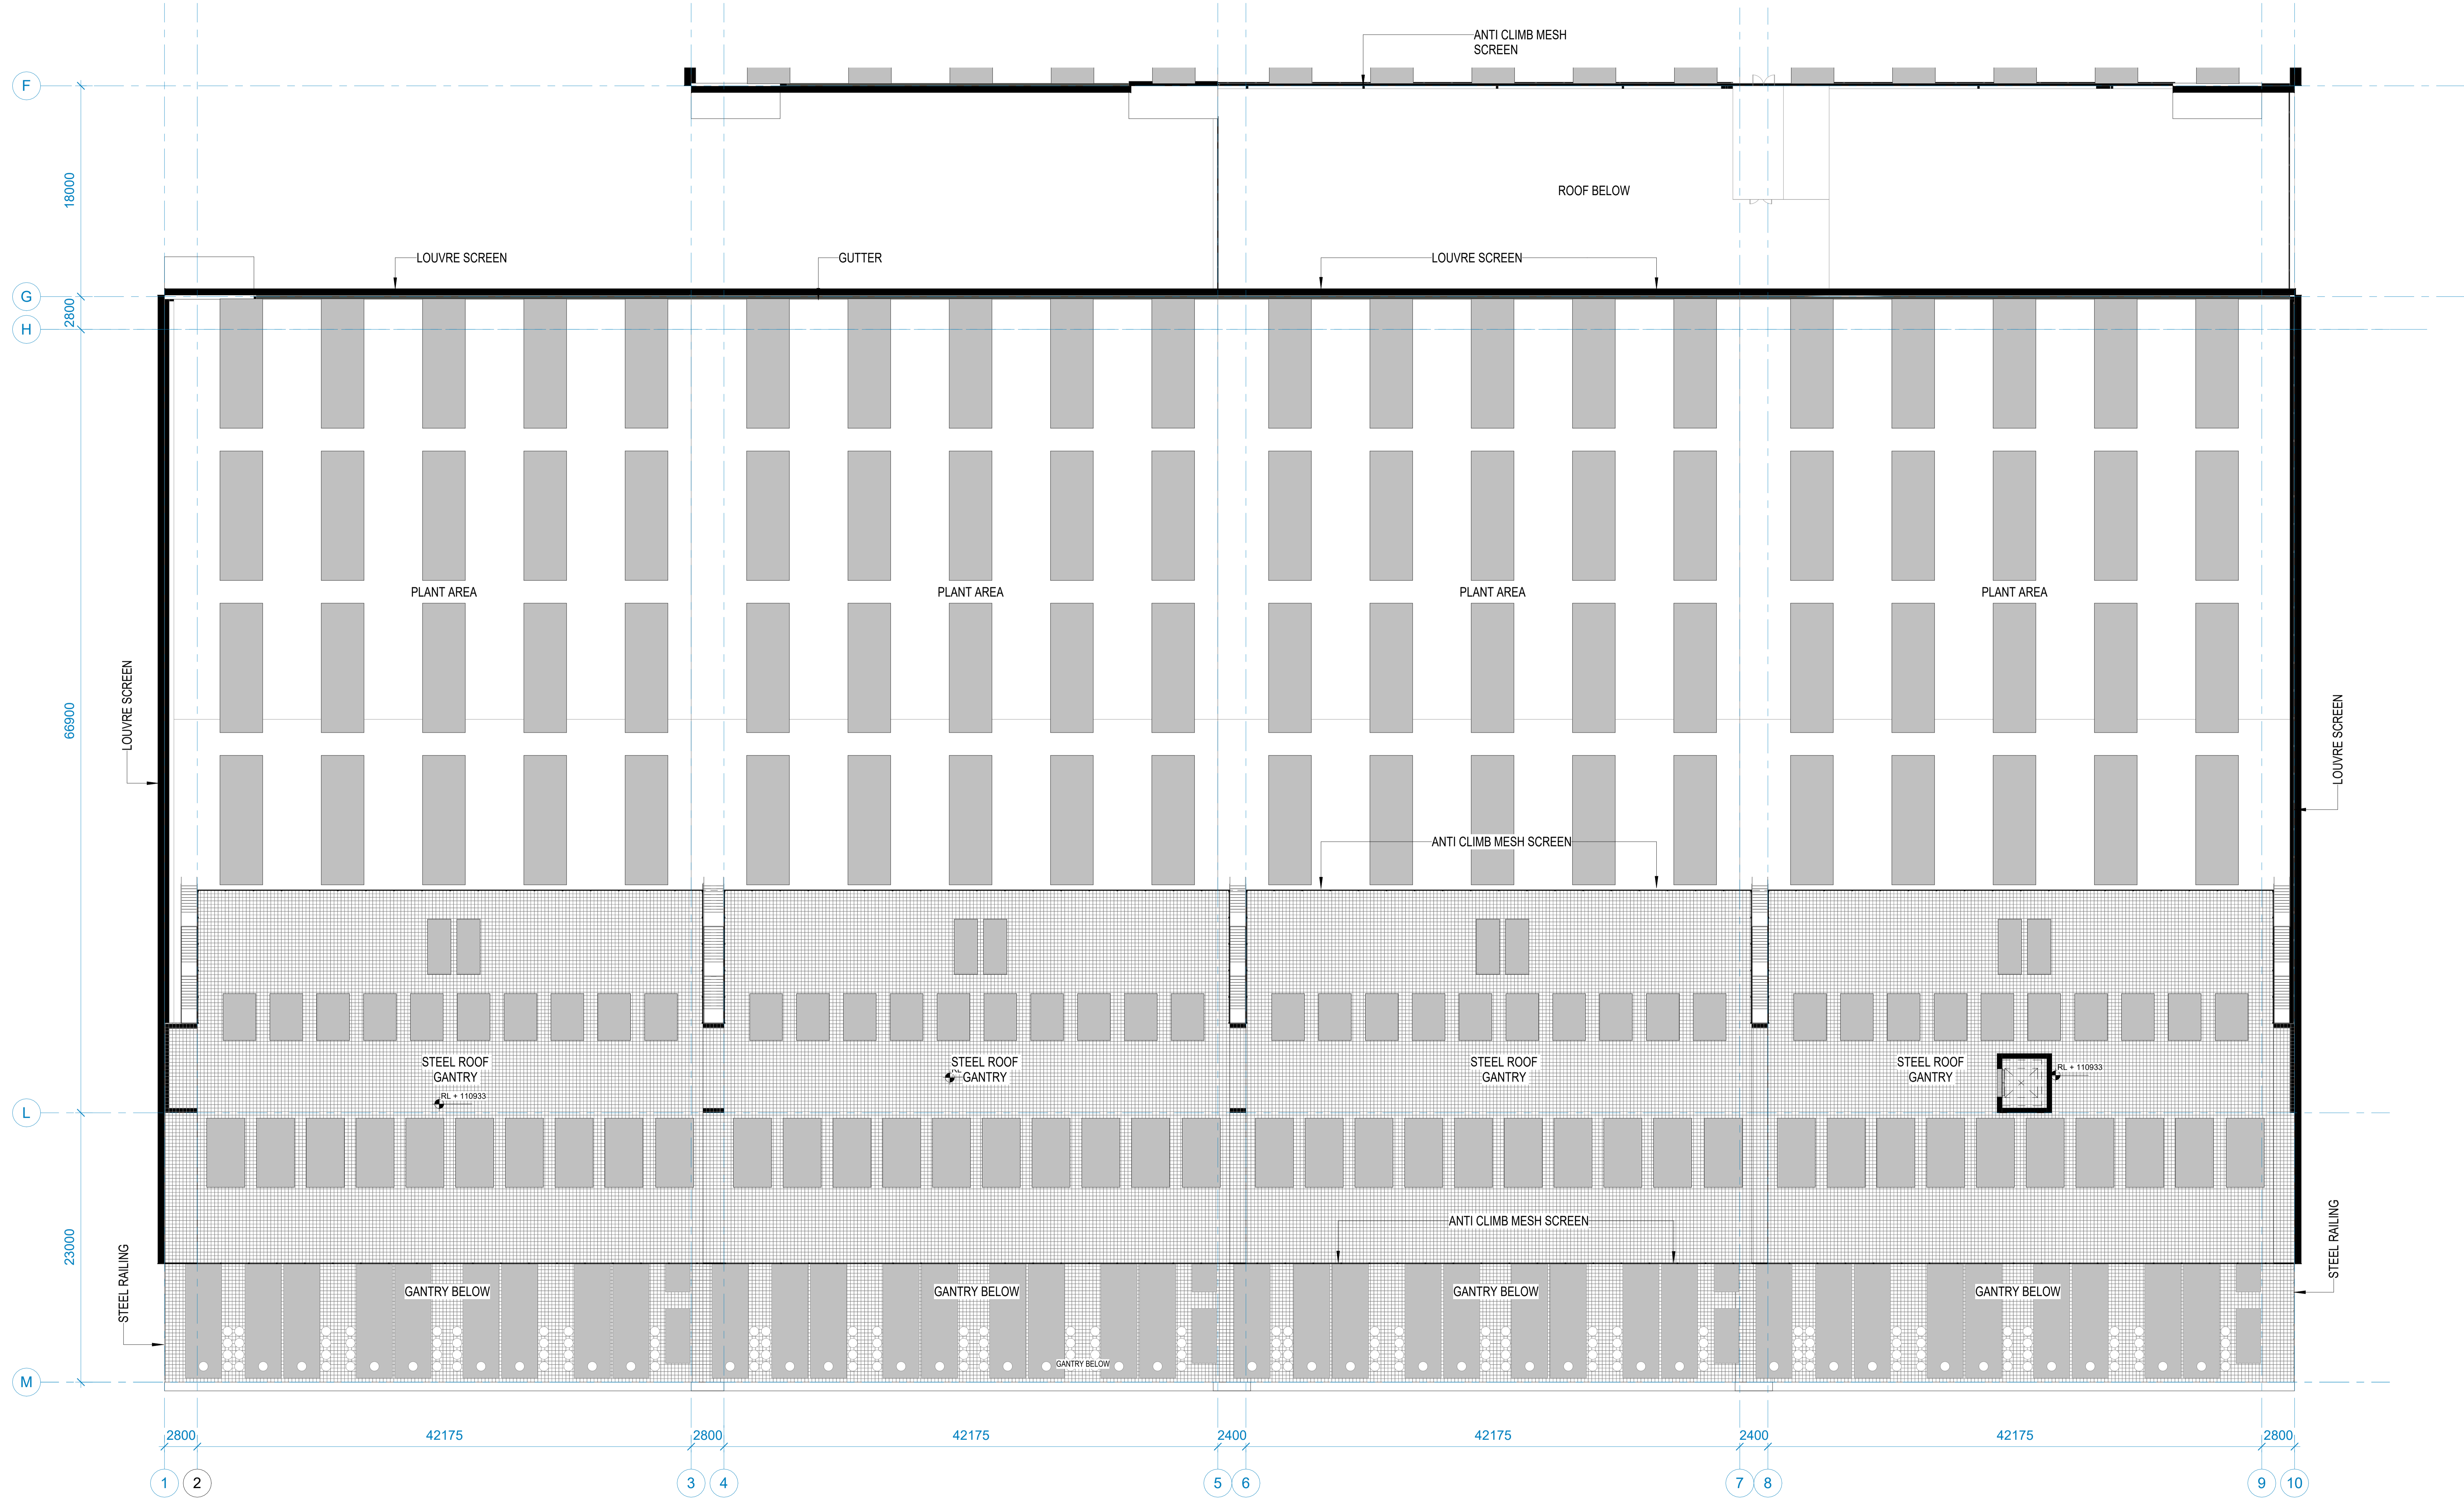

1 DA - LEVEL 6 - PART A  
1:200

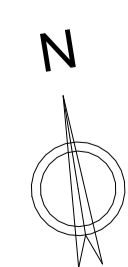

Issue	Date	Description
A	31.07.2024	FOR DA
B	21.08.2024	FOR DA
C	26.08.2024	FOR DA
D	28.08.2024	FOR DA
E	03.09.2024	FOR DA

Notes

Key Plan

Project Manager

Client

Construction Manager

**Greenbox**

+61 2 8069 8600  
LEVEL 22  
68 PITT STREET  
SYDNEY NSW 2000 AUSTRALIA

GREENBOX ARCHITECTURE PTY LTD  
ABN: 79 139 779 098  
ISO 9001 CERTIFIED QUALITY SYSTEM

- Use written dimensions only
- Do not scale from drawing
- Contractors shall confirm all dimensions on-site prior to commencing any work or producing any shop drawings
- All materials to be used in accordance with the manufacturer's specifications and instructions and shall comply with the relevant Australian Standards
- Copyright of this drawing and design remain the property of Greenbox Architecture Pty Ltd
- Nominated Architect - Gerard Page: NSW reg No. 7247, Vic reg No. 17954, QLD reg No. 4538

Client  
EMKC


Project  
PROPOSED DATA CENTRE  
85-86 Sharps Road  
Tullahoma VIC 3043

Scale	Scale Bar	Sheet	Scale Bar
1:200	0 1 2 3 5 10m	1:200	0 1 2 3 5 10m
Drawn By AZ/SFI	Checked By DK/SFI	Project Status DA SUBMISSION	Drawing Title PART A LEVEL 6
Approved By AD	Job Number 240004	Drawing Number DA106	Issue E





1 LEVEL 1 - PART B  
1:200

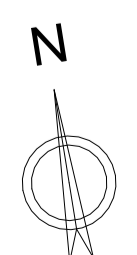

Issue	Date	Description
A	31.07.2024	FOR DA
B	21.08.2024	FOR DA
C	26.08.2024	FOR DA
D	28.08.2024	FOR DA

Notes

Key Plan

Project Manager

Client

Construction Manager




+61 2 8069 8600  
LEVEL 22  
68 PITT STREET  
SYDNEY NSW 2000 AUSTRALIA

GREENBOX ARCHITECTURE PTY LTD  
ABN: 79 139 779 098  
ISO 9001 CERTIFIED QUALITY SYSTEM


- Use written dimensions only
- Do not scale from drawing
- Contractors shall confirm all dimensions on-site prior to commencing any work or producing any shop drawings
- All materials to be used in accordance with the manufacturer's specifications and instructions and shall comply with the relevant Australian Standards
- Copyright of this drawing and design remain the property of Greenbox Architecture Pty Ltd
- Nominated Architect - Gerard Page; NSW reg No. 7247; Vic reg No. 17954; QLD reg no. 4538

Client EMKC	Scale 1:200	Sheet 1/200	Scale Bar 0 1 2 3 5 10m
Project PROPOSED DATA CENTRE 85-86 Sharps Road Tullahoma VIC 3043	Drawn By AK/SFI	Checked By DK/SFI	Project Status PART B LEVEL 1
Job Number 240004	Approved By AD	Drawing Number DA111	Issue D



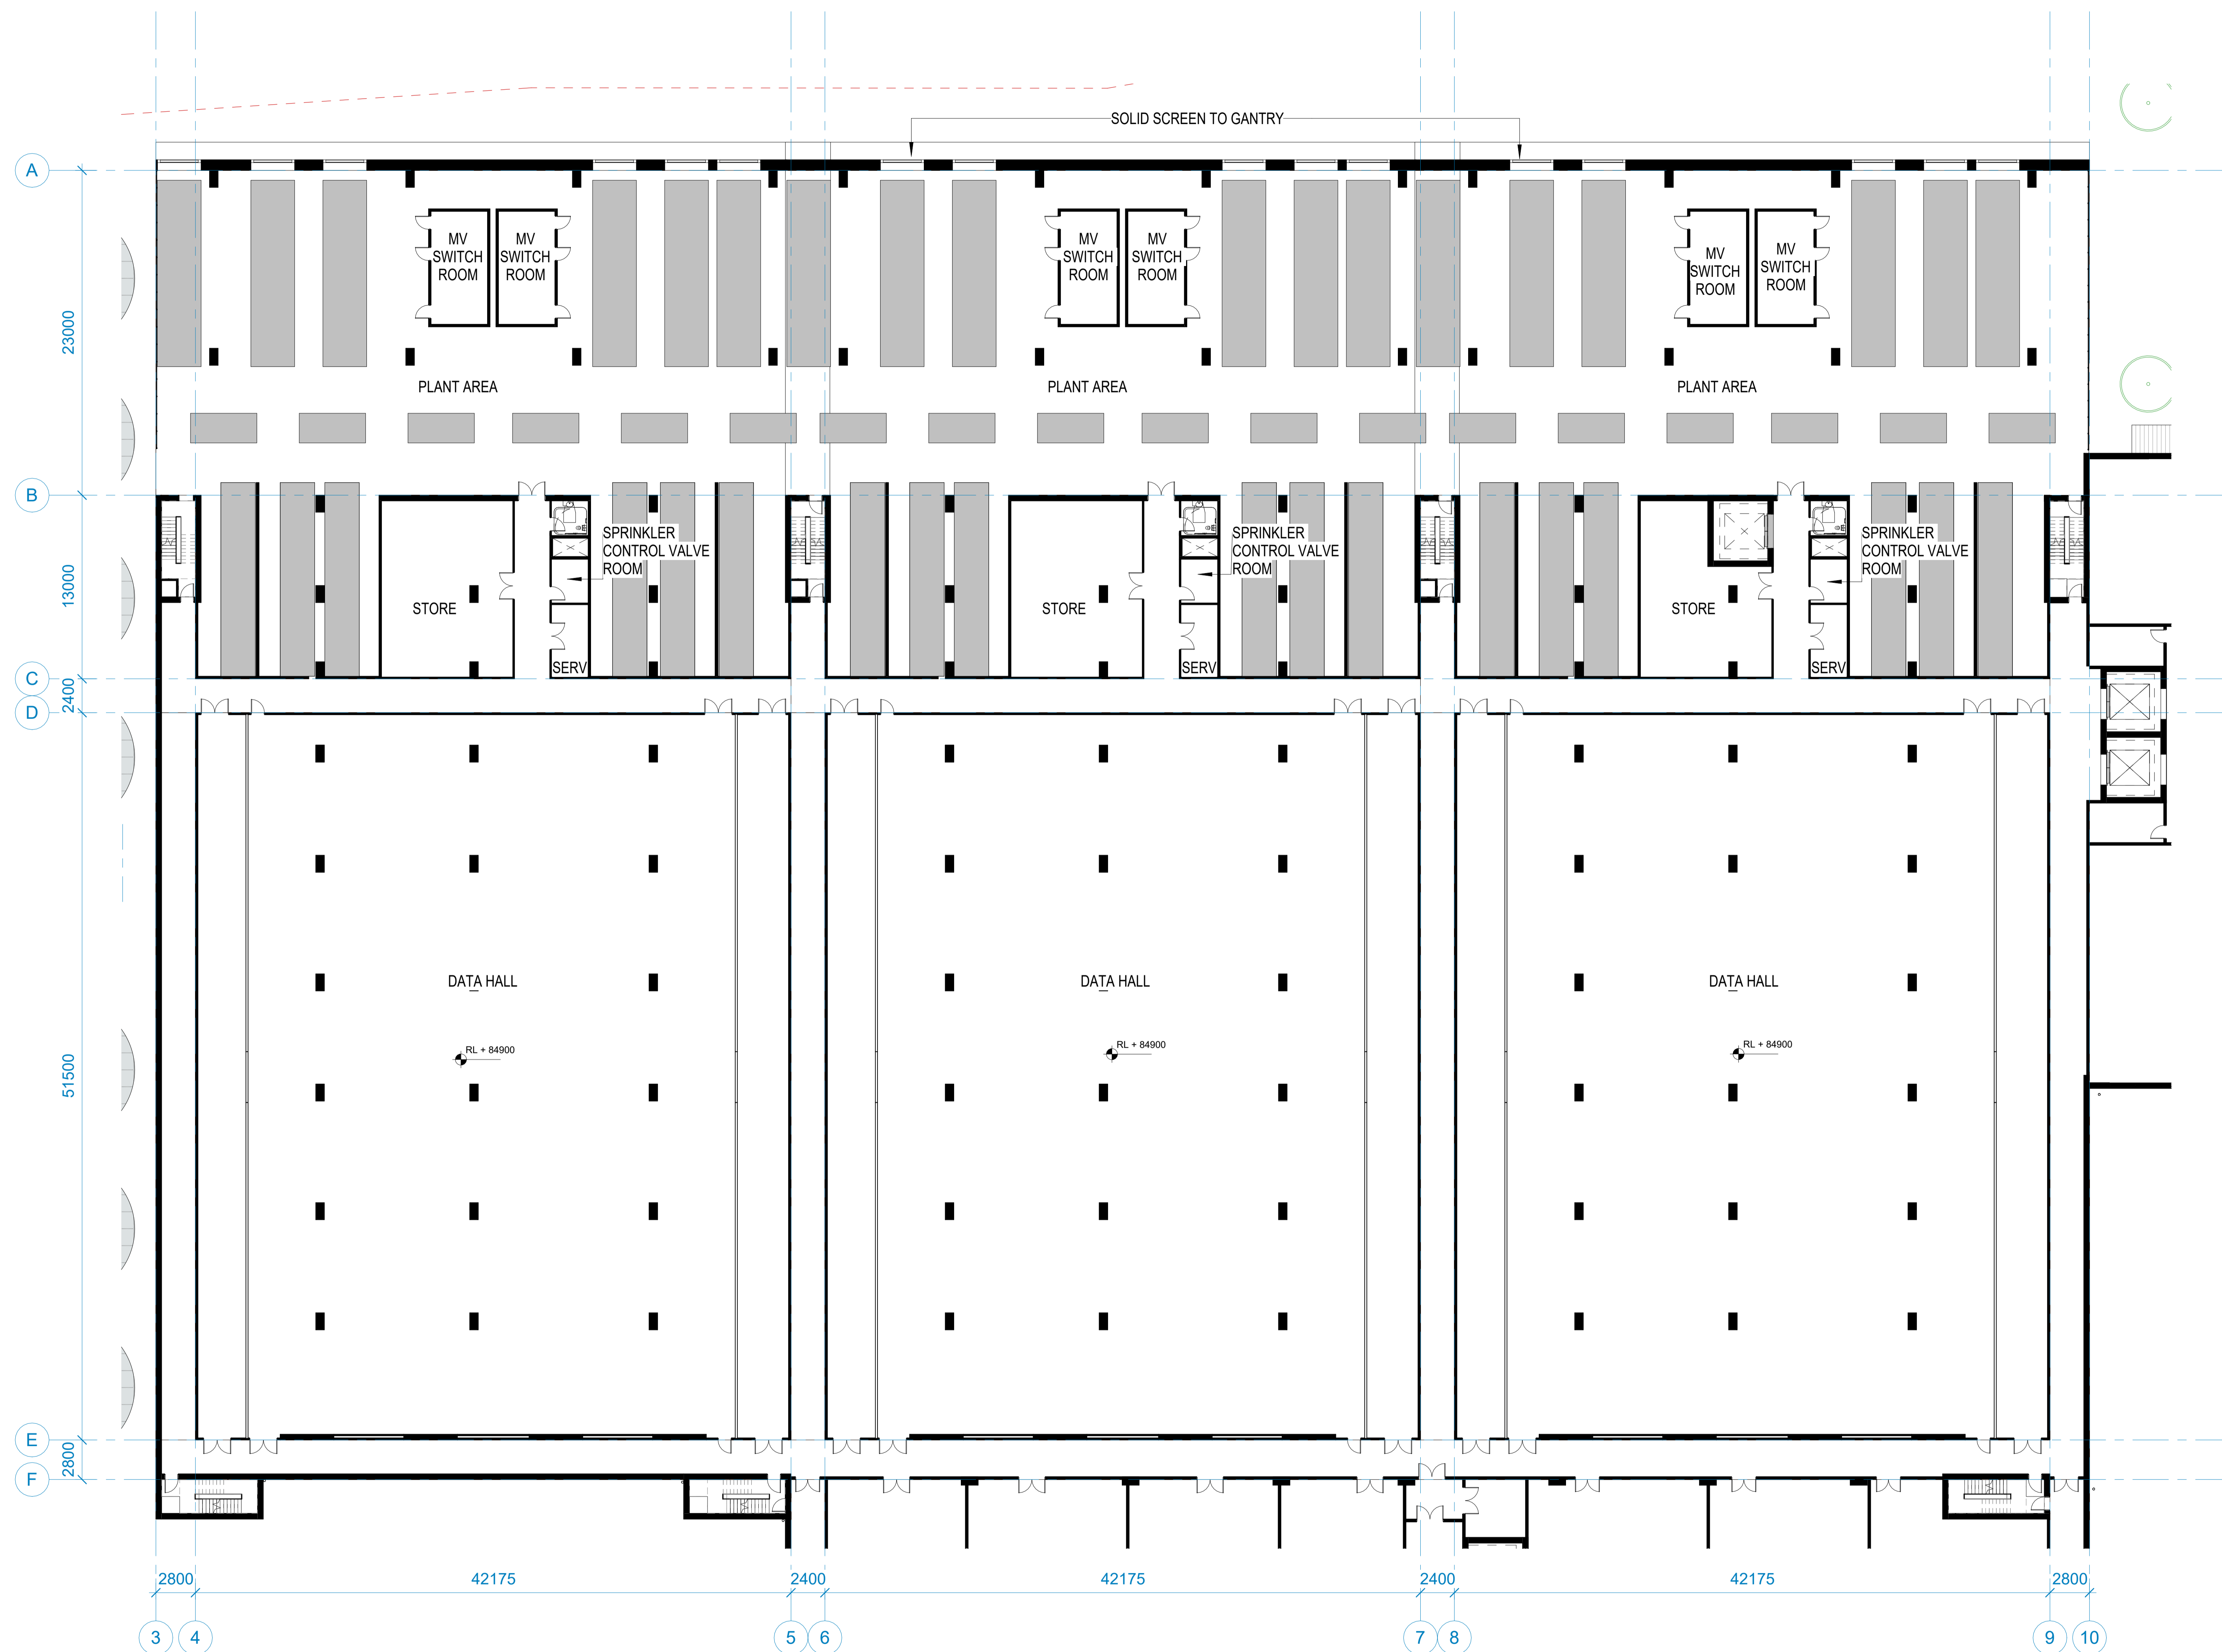

1 PART B - L2 - L4 PLAN (TYPICAL)  
1:200

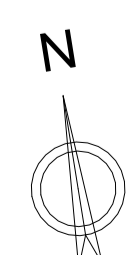

Issue	Date	Description
A	31.07.2024	FOR DA
B	21.08.2024	FOR DA
C	26.08.2024	FOR DA
D	28.08.2024	FOR DA

Notes

Key Plan

Project Manager

Client

Construction Manager

**Greenbox**

+61 2 8069 8000  
LEVEL 22  
68 PITT STREET  
SYDNEY NSW 2000 AUSTRALIA

GREENBOX ARCHITECTURE PTY LTD  
ABN: 79 139 779 098  
ISO 9001 CERTIFIED QUALITY SYSTEM

- Use written dimensions only
- Do not scale from drawing
- Contractors shall confirm all dimensions on-site prior to commencing any work or producing any shop drawings
- All materials to be used in accordance with the manufacturer's specifications and instructions and shall comply with the relevant Australian Standards
- Copyright of this drawing and design remain the property of Greenbox Architecture Pty Ltd
- Nominated Architect - Gerard Page; NSW reg No. 7247; Vic reg No. 17954; QLD reg no. 4538

Client  
EMKC

Project  
PROPOSED DATA CENTRE  
85-86 Sharps Road  
Tullahoma VIC 3043

Scale  
1:200

Sheet  
1:200 0 1 2 3 5 10m

Project Status

Checked By  
DK/SFI

Approved By  
AD


Job Number  
240004

Drawing Title  
PART B L2 - L4 PLAN (TYPICAL)

Drawing Number  
DA112

Issue  
D




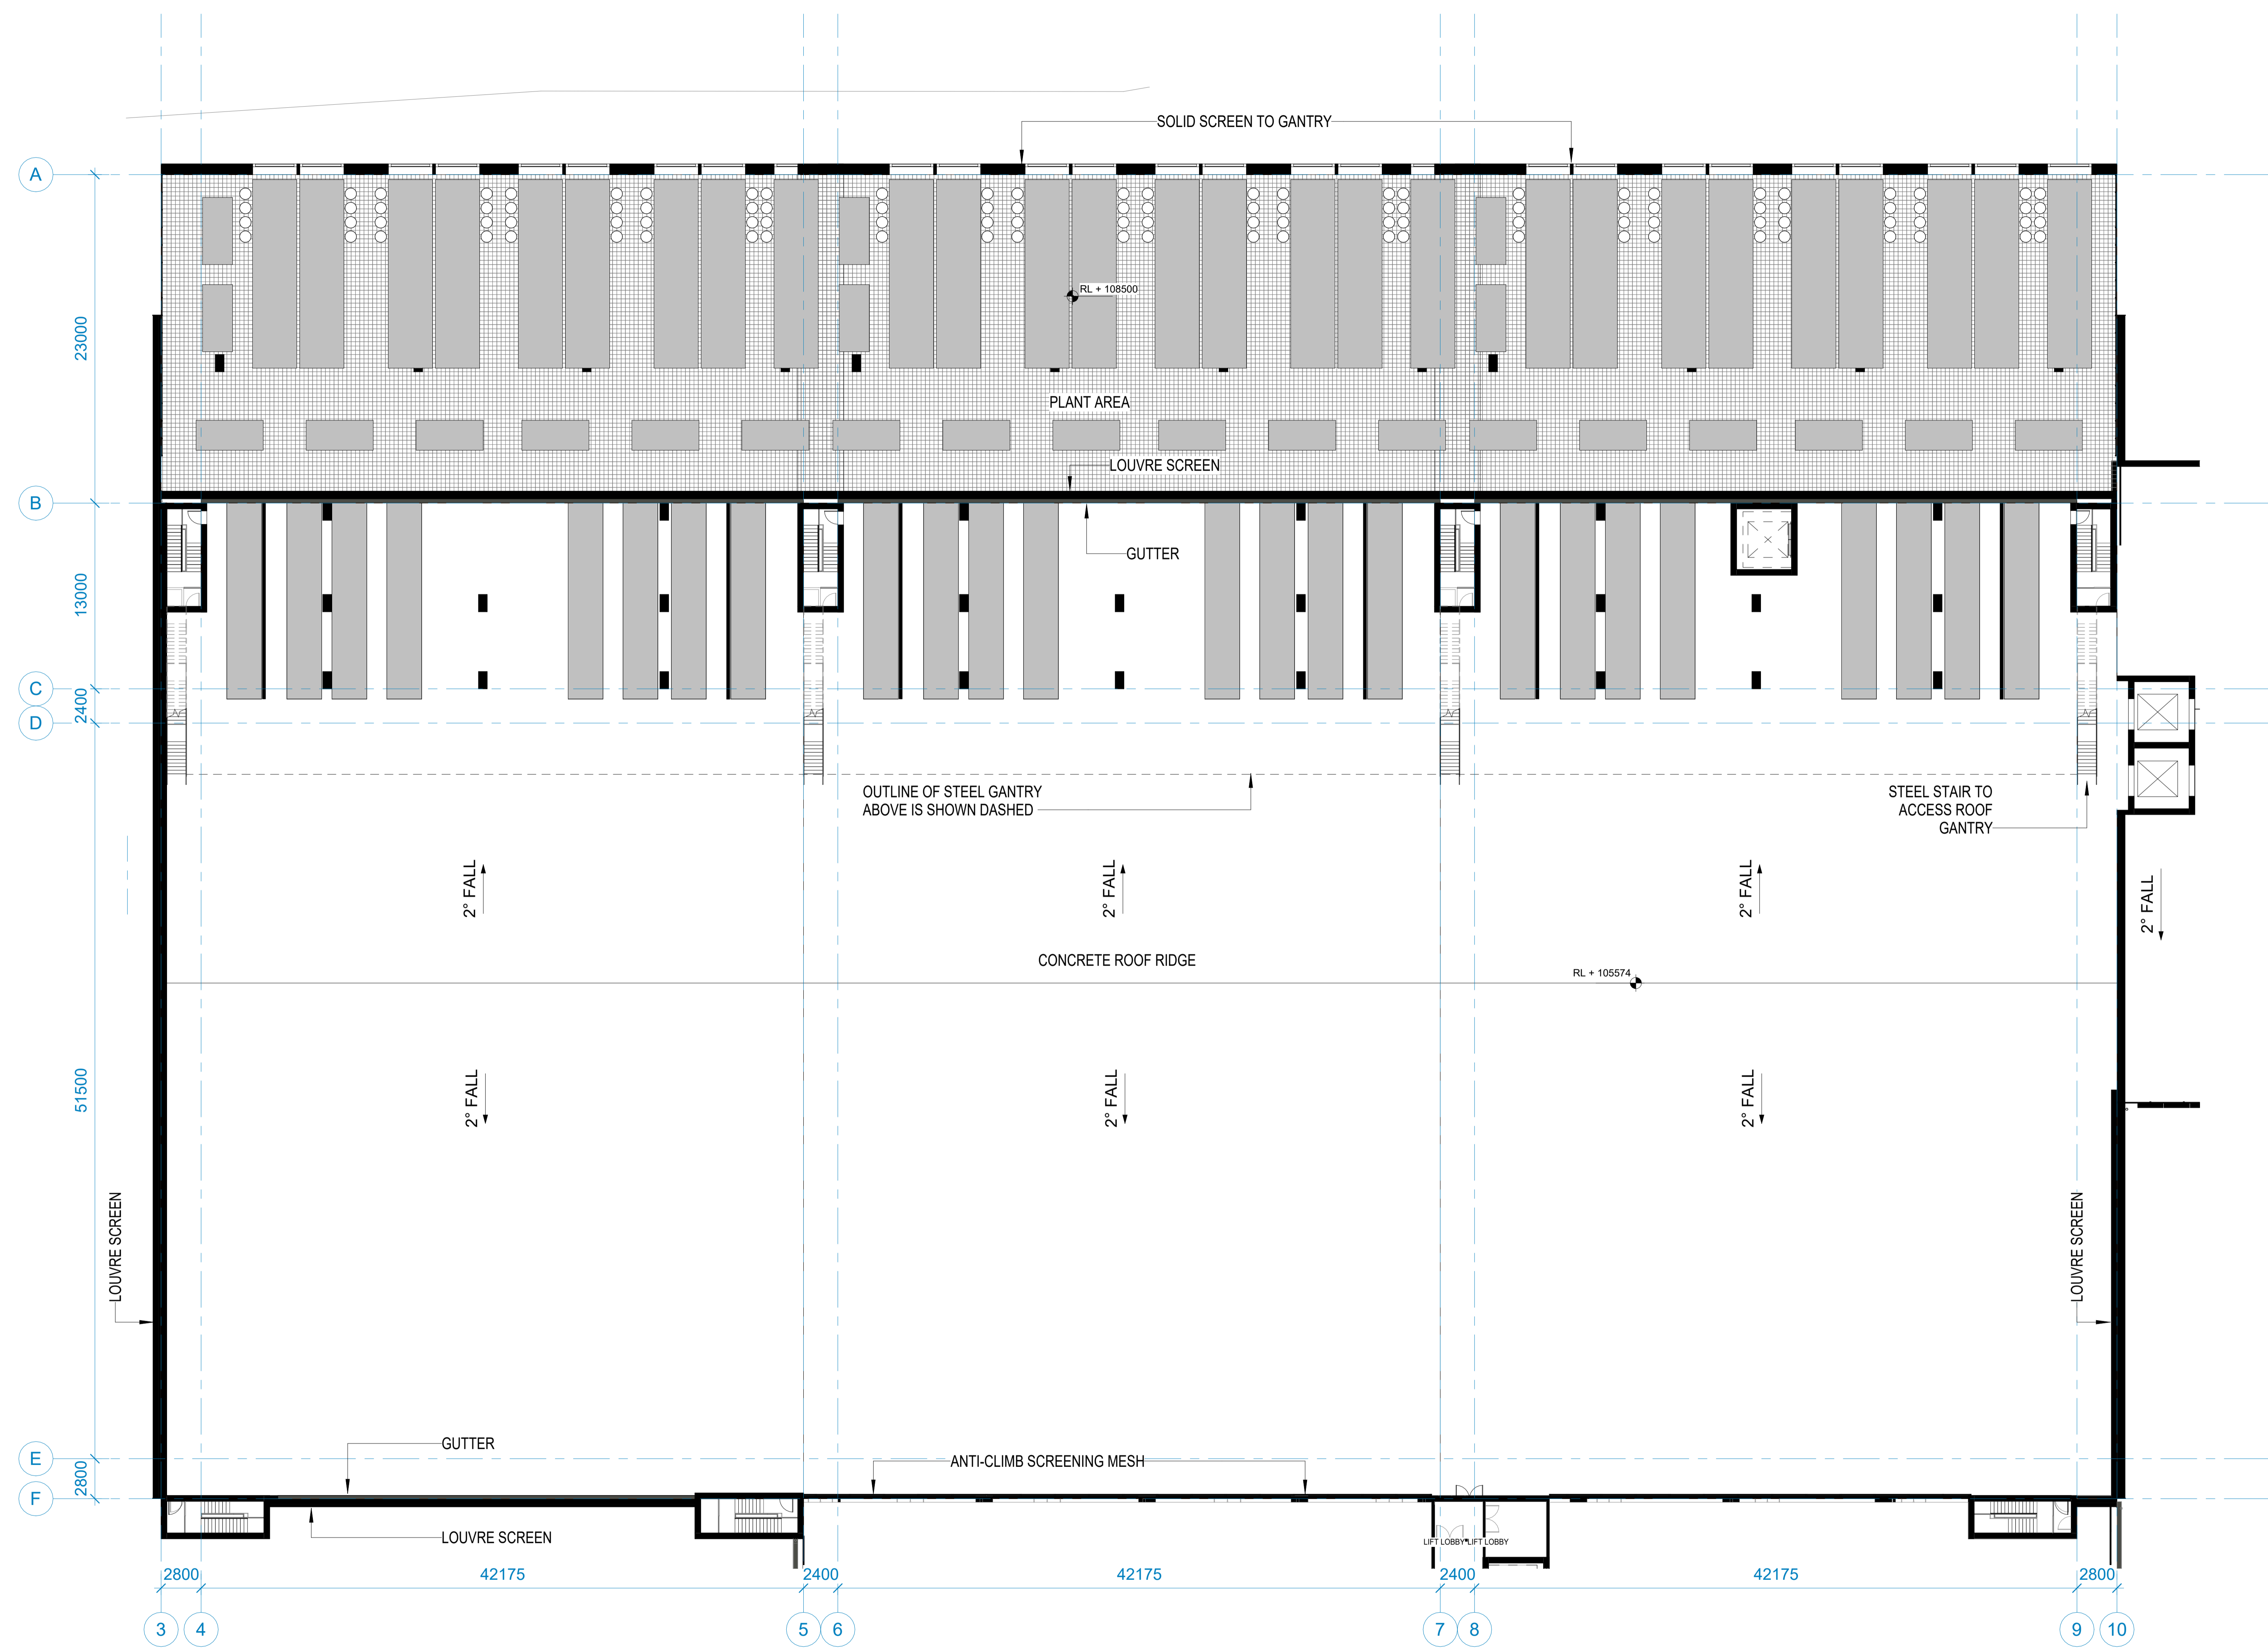


1 DA - LEVEL 5 ROOF - PART B  
1:200

	<table border="1"> <thead> <tr> <th>Issue</th> <th>Date</th> <th>Description</th> </tr> </thead> <tbody> <tr> <td>A</td> <td>31.07.2024</td> <td>FOR DA</td> </tr> <tr> <td>B</td> <td>21.08.2024</td> <td>FOR DA</td> </tr> <tr> <td>C</td> <td>26.08.2024</td> <td>FOR DA</td> </tr> <tr> <td>D</td> <td>28.08.2024</td> <td>FOR DA</td> </tr> <tr> <td>E</td> <td>03.09.2024</td> <td>FOR DA</td> </tr> </tbody> </table>	Issue	Date	Description	A	31.07.2024	FOR DA	B	21.08.2024	FOR DA	C	26.08.2024	FOR DA	D	28.08.2024	FOR DA	E	03.09.2024	FOR DA	Notes	Key Plan	Project Manager	Client	<p>+61 2 8069 8000 LEVEL 22 68 PITT STREET SYDNEY NSW 2000 AUSTRALIA</p> <p>GREENBOX ARCHITECTURE PTY LTD ABN: 79 139 779 098 ISO 9001 CERTIFIED QUALITY SYSTEM</p>	<ul style="list-style-type: none"> <li>Use written dimensions only</li> <li>Do not scale from drawing</li> <li>Contractors shall confirm all dimensions on-site prior to commencing any work or producing any shop drawings</li> <li>All materials to be used in accordance with the manufacturer's specifications and instructions and shall comply with the relevant Australian Standards</li> <li>Copyright of this drawing and design remain the property of Greenbox Architecture Pty Ltd</li> <li>Nominated Architect - Gerard Page: NSW reg No. 7247, Vic reg No. 17954, QLD reg No. 4538</li> </ul>	Client EMKC	Scale 1:200	Sheet 1/200	Scale Bar 0 1 2 3 5 10m
	Issue	Date	Description																										
A	31.07.2024	FOR DA																											
B	21.08.2024	FOR DA																											
C	26.08.2024	FOR DA																											
D	28.08.2024	FOR DA																											
E	03.09.2024	FOR DA																											
<table border="1"> <thead> <tr> <th>Project</th> <th>Checked By</th> <th>Approved By</th> <th>Job Number</th> </tr> </thead> <tbody> <tr> <td>PROPOSED DATA CENTRE 85-86 Sharps Road Tullahoma VIC 3043</td> <td>DK/SFI</td> <td>AD</td> <td>240004</td> </tr> </tbody> </table>	Project	Checked By	Approved By	Job Number	PROPOSED DATA CENTRE 85-86 Sharps Road Tullahoma VIC 3043	DK/SFI	AD	240004	<table border="1"> <thead> <tr> <th>Project Status</th> <th>Drawing Title</th> <th>Drawing Number</th> <th>Issue</th> </tr> </thead> <tbody> <tr> <td>DA SUBMISSION</td> <td>PART B LEVEL 5 (ROOF)</td> <td>DA115</td> <td>E</td> </tr> </tbody> </table>	Project Status	Drawing Title	Drawing Number	Issue	DA SUBMISSION	PART B LEVEL 5 (ROOF)	DA115	E												
Project	Checked By	Approved By	Job Number																										
PROPOSED DATA CENTRE 85-86 Sharps Road Tullahoma VIC 3043	DK/SFI	AD	240004																										
Project Status	Drawing Title	Drawing Number	Issue																										
DA SUBMISSION	PART B LEVEL 5 (ROOF)	DA115	E																										



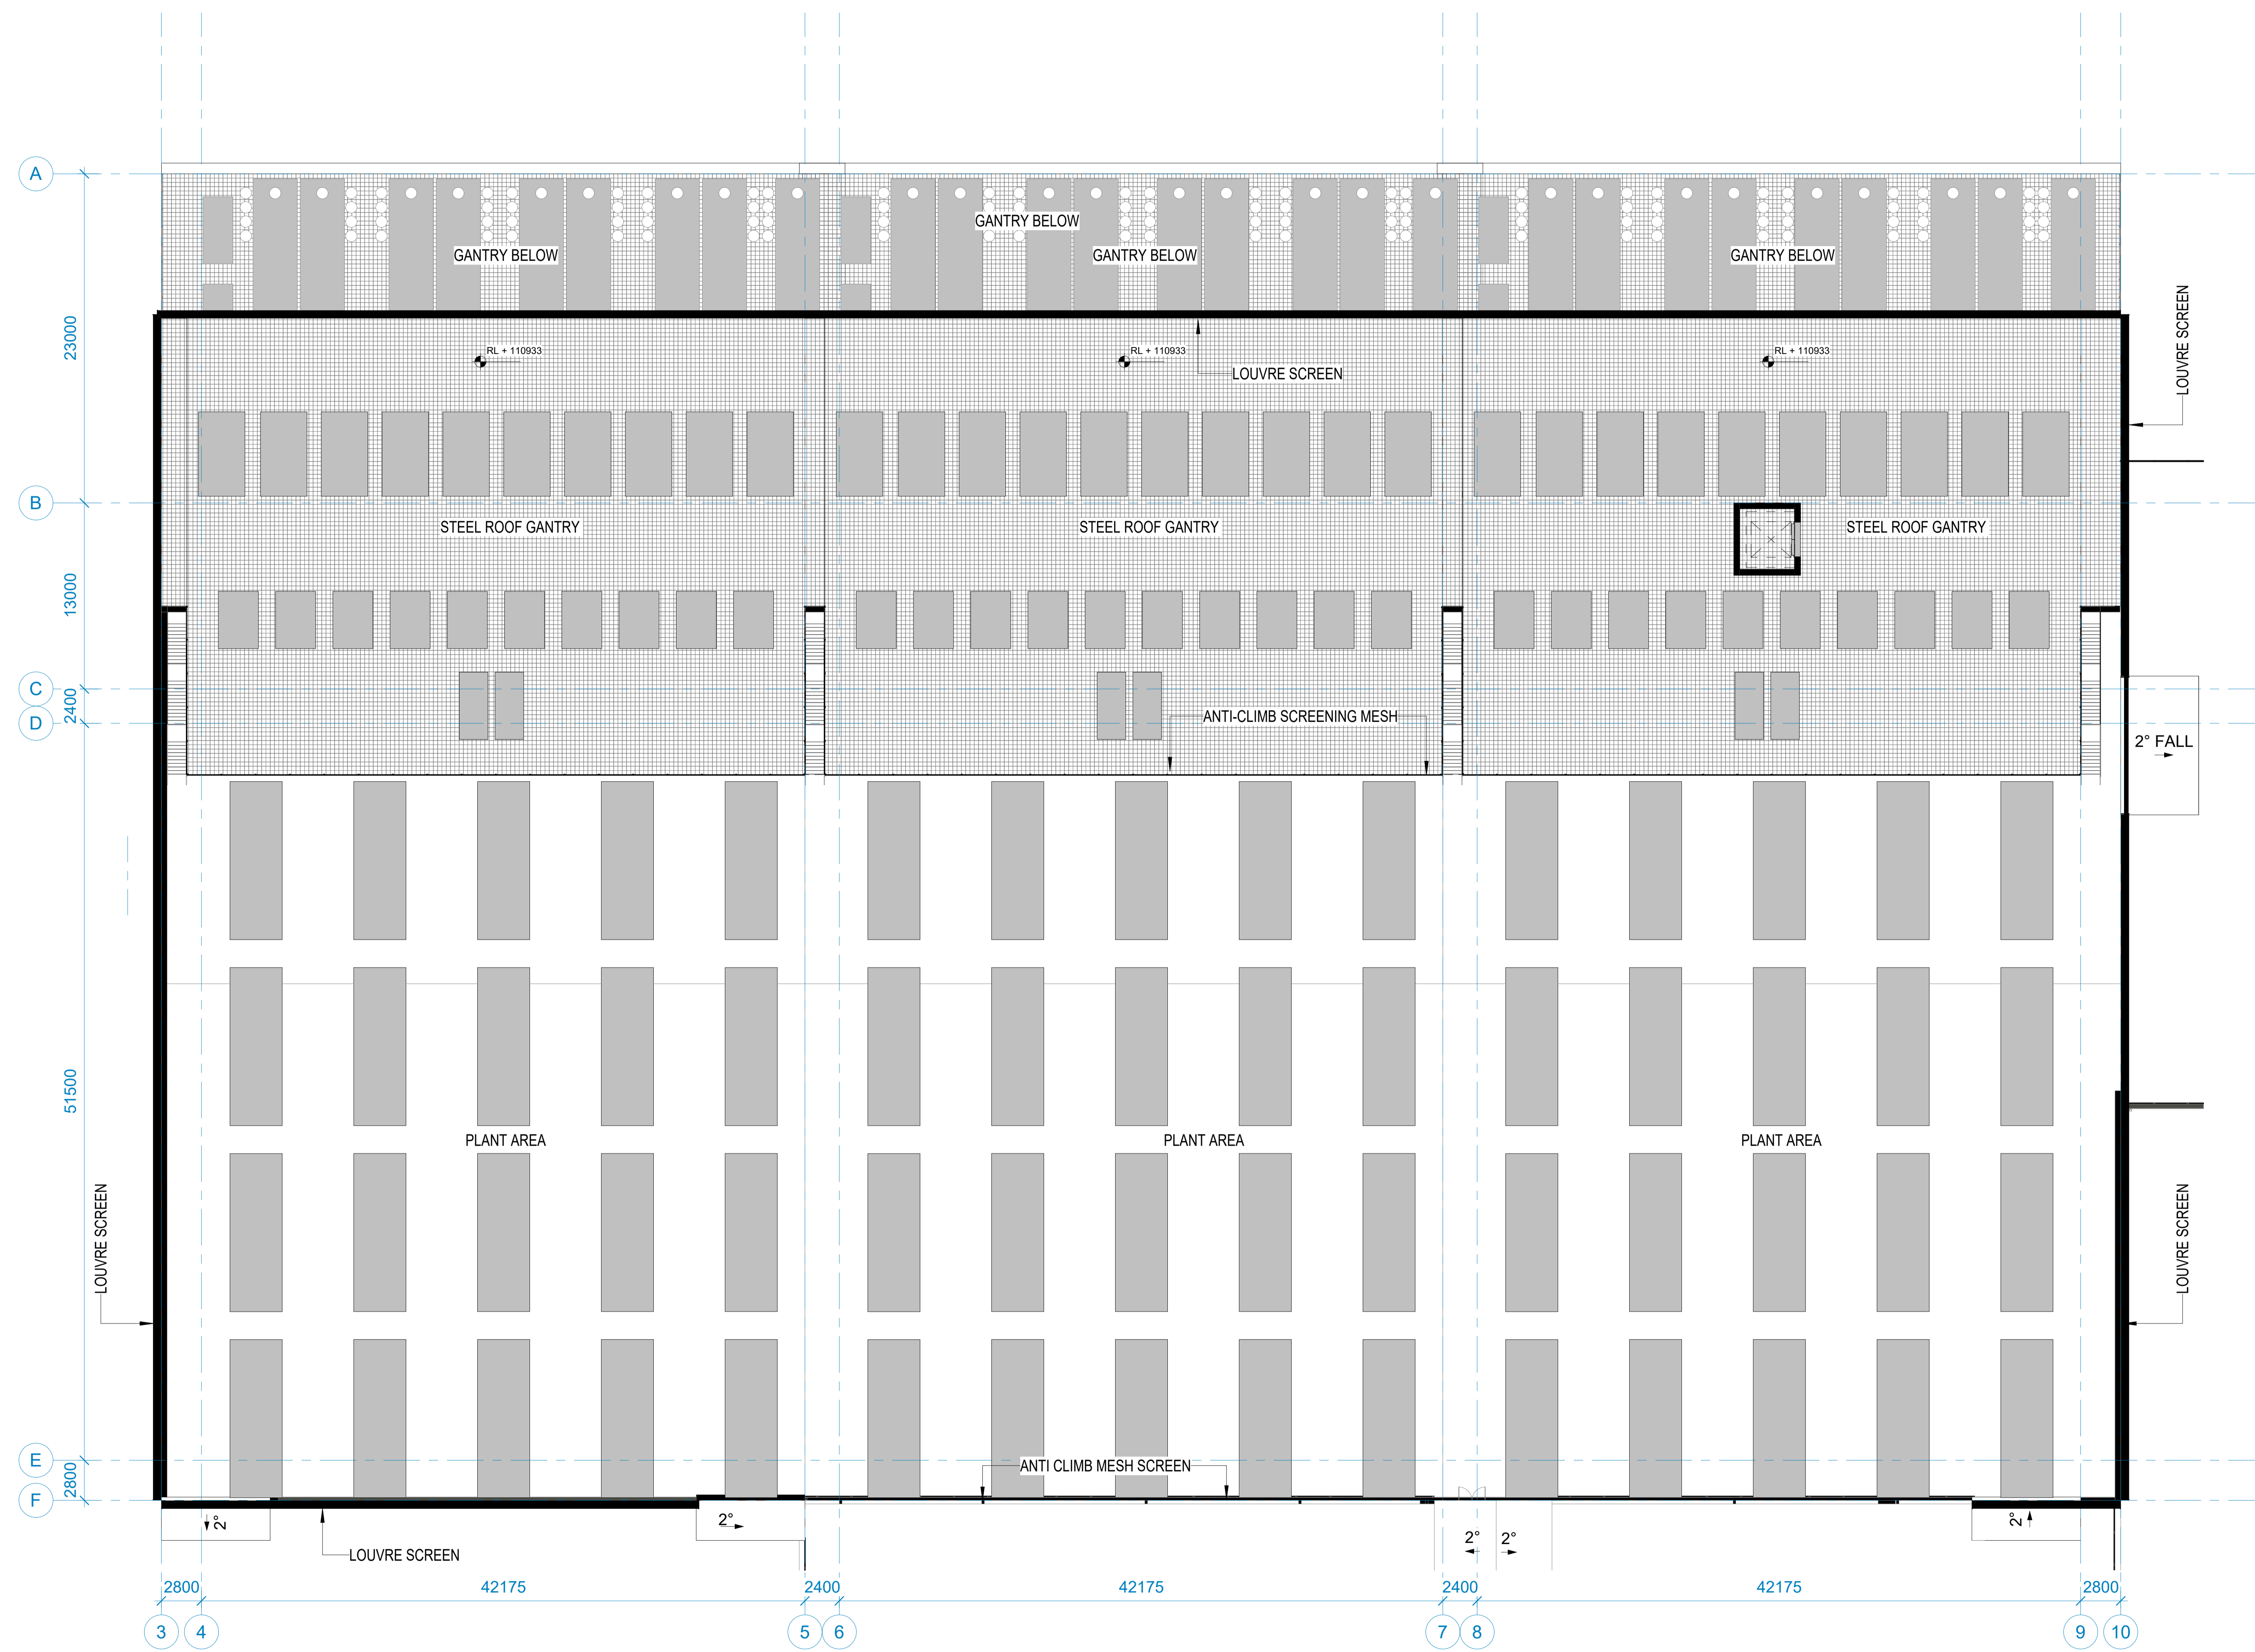

1 DA - LEVEL 6 - PART B  
1:200

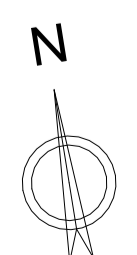

Issue	Date	Description
A	31.07.2024	FOR DA
B	21.08.2024	FOR DA
C	26.08.2024	FOR DA
D	28.08.2024	FOR DA
E	03.09.2024	FOR DA

Notes

Key Plan

Project Manager

Client

Construction Manager



+61 2 8069 8600  
LEVEL 22  
68 PITT STREET  
SYDNEY NSW 2000 AUSTRALIA

GREENBOX ARCHITECTURE PTY LTD  
ABN: 79 139 779 098  
ISO 9001 CERTIFIED QUALITY SYSTEM



- Use written dimensions only
- Do not scale from drawing
- Contractors shall confirm all dimensions on-site prior to commencing any work or producing any shop drawings
- All materials to be used in accordance with the manufacturer's specifications and instructions and shall comply with the relevant Australian Standards
- Copyright of this drawing and design remain the property of Greenbox Architecture Pty Ltd
- Nominated Architect - Gerard Page; NSW reg No. 7247; Vic reg No. 17954; QLD reg no. 4538

Client  
EMKC

Project  
PROPOSED DATA CENTRE  
85-86 Sharps Road  
Tullahoma VIC 3043

Scale	Sheet	Scale Bar
1:200	0 1 2 3 5 10m	
Drawn By A2/SFI	Project Status DA SUBMISSION	
Checked By DK/SFI	Drawing Title PART B LEVEL 6	
Approved By AD	Drawing Number 240004	Issue E



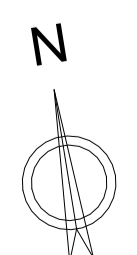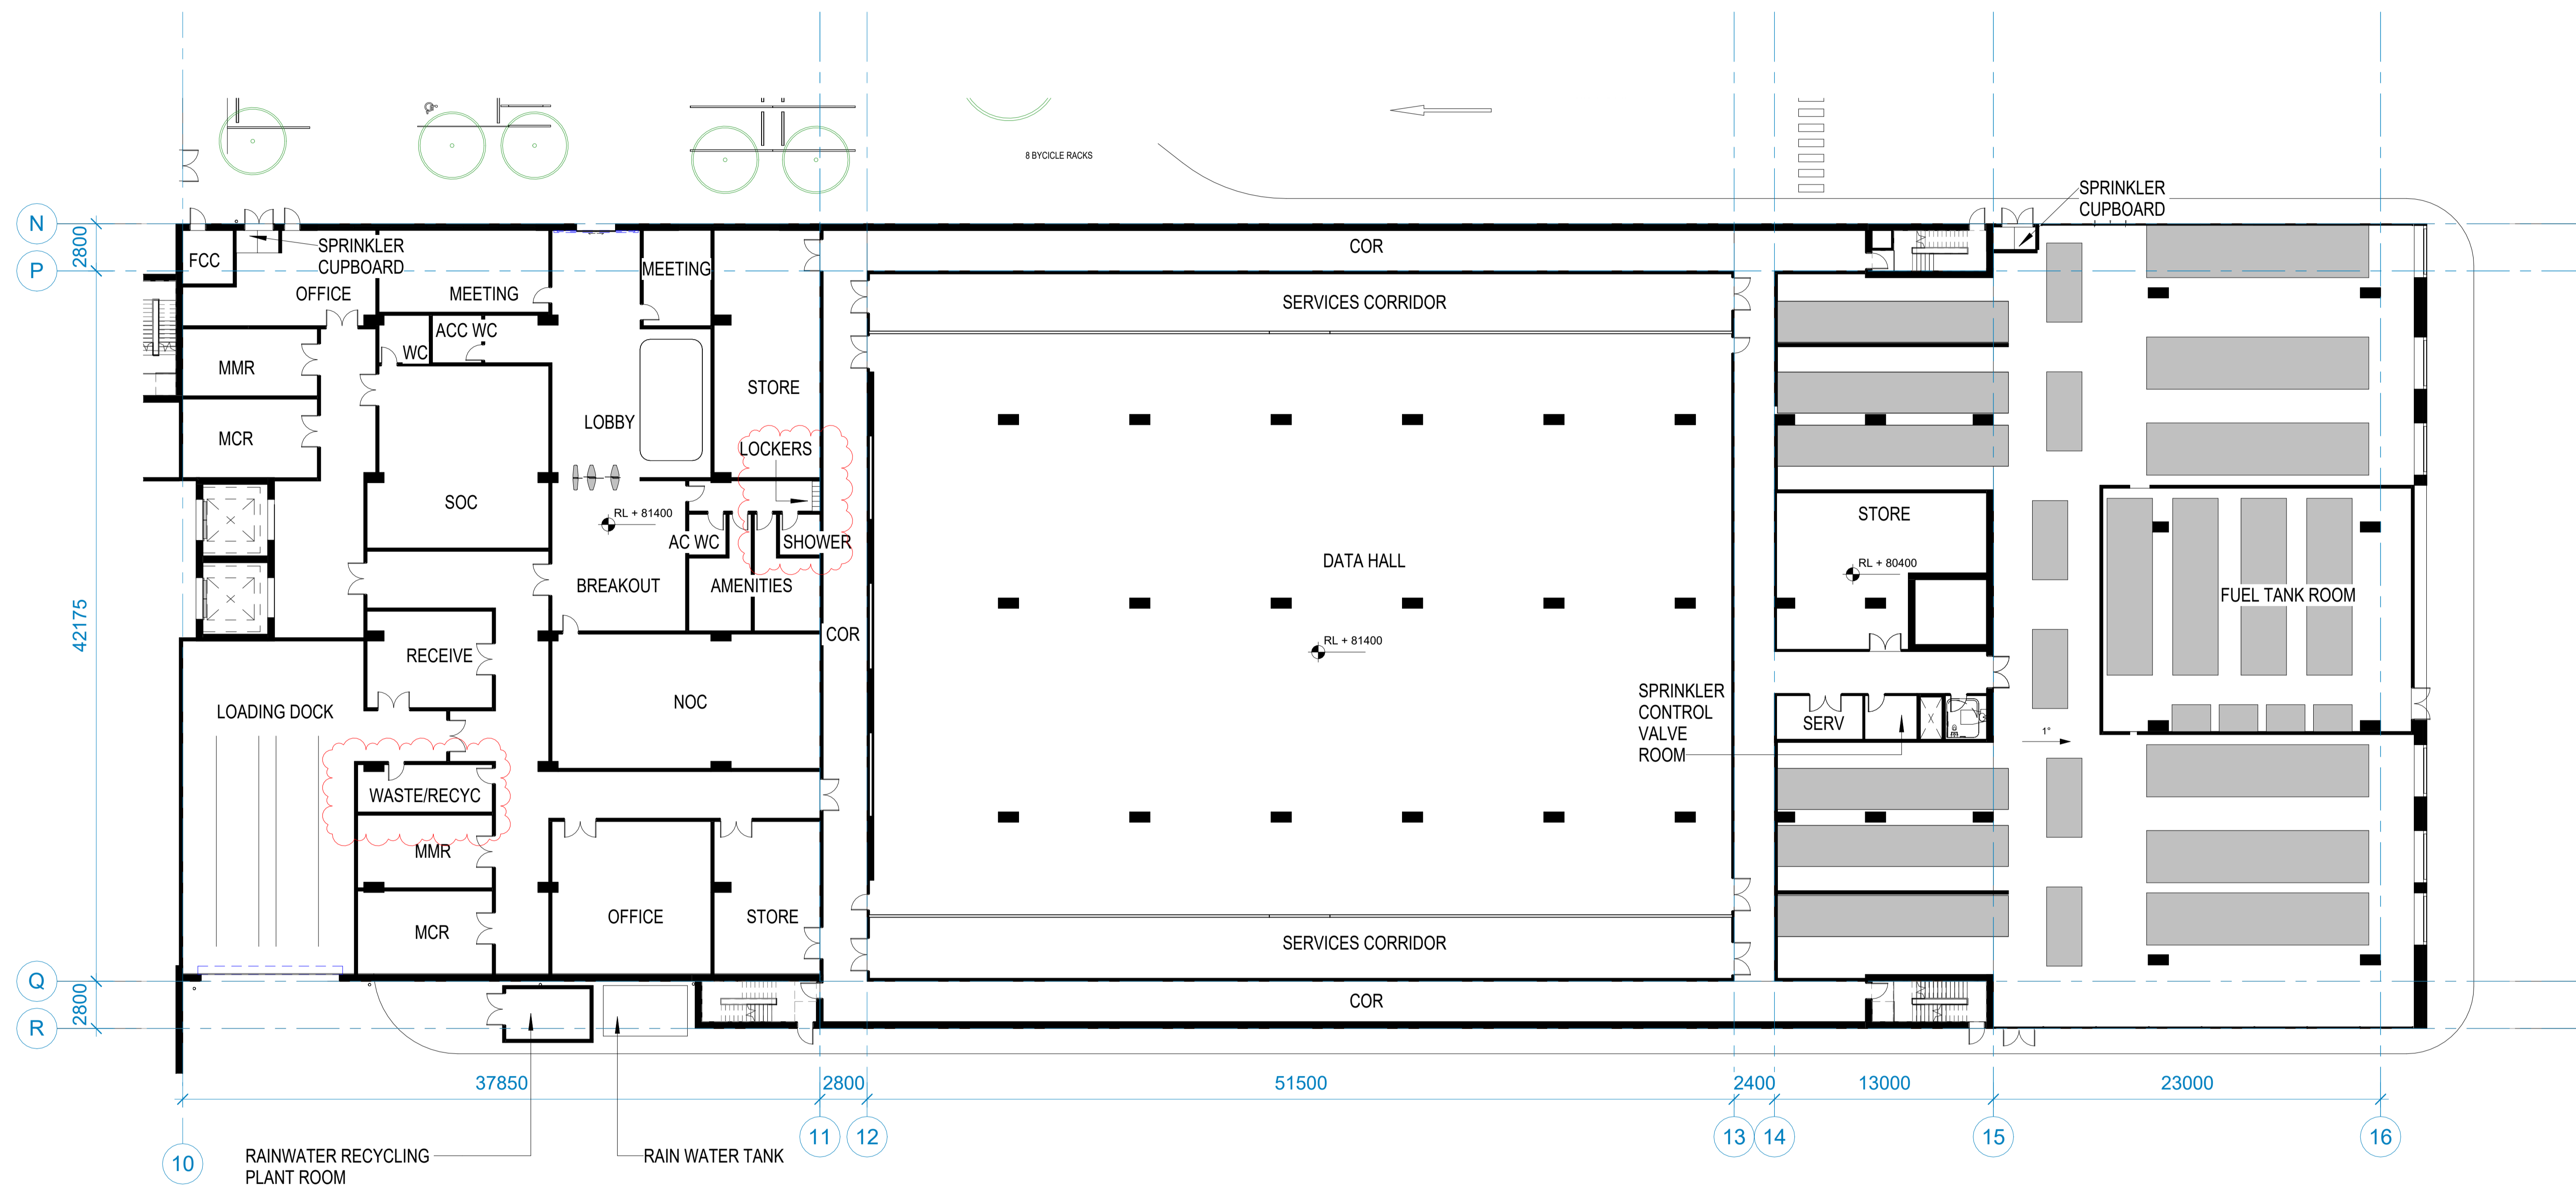

Issue	Date	Description
A	31.07.2024	FOR DA
B	21.08.2024	FOR DA
C	26.08.2024	FOR DA
D	28.08.2024	FOR DA
E	03.09.2024	FOR DA
G	18.12.2024	FOR DA

Notes

Key Plan

Project Manager

Client



+61 2 8069 6000  
LEVEL 22  
68 PITT STREET  
SYDNEY NSW 2000 AUSTRALIA

GREENBOX ARCHITECTURE PTY LTD  
ABN: 79 139 779 098  
ISO 9001 CERTIFIED QUALITY SYSTEM


- Use written dimensions only
- Do not scale from drawing
- Contractors shall confirm all dimensions on-site prior to commencing any work or producing any shop drawings
- All materials to be used in accordance with the manufacturer's specifications and instructions and shall comply with the relevant Australian Standards
- Copyright of this drawing and design remain the property of Greenbox Architecture Pty Ltd
- Nominated Architect - Gerard Page: NSW reg No. 7247, Vic reg No. 17954, QLD reg No. 4538

Client  
EMKC


Project  
PROPOSED DATA CENTRE  
85-86 Sharps Road  
Tullahoma VIC 3043

Scale	Sheet	Scale Bar
1:200	1200	0 1 2 3 5 10m
Drawn By A2/SFI	Checked By DK/SFI	Project Status <b>DA SUBMISSION</b>
Approved By AD	Job Number 240004	Drawing Title <b>PART C LEVEL 1</b>
	Drawing Number DA121	Issue G



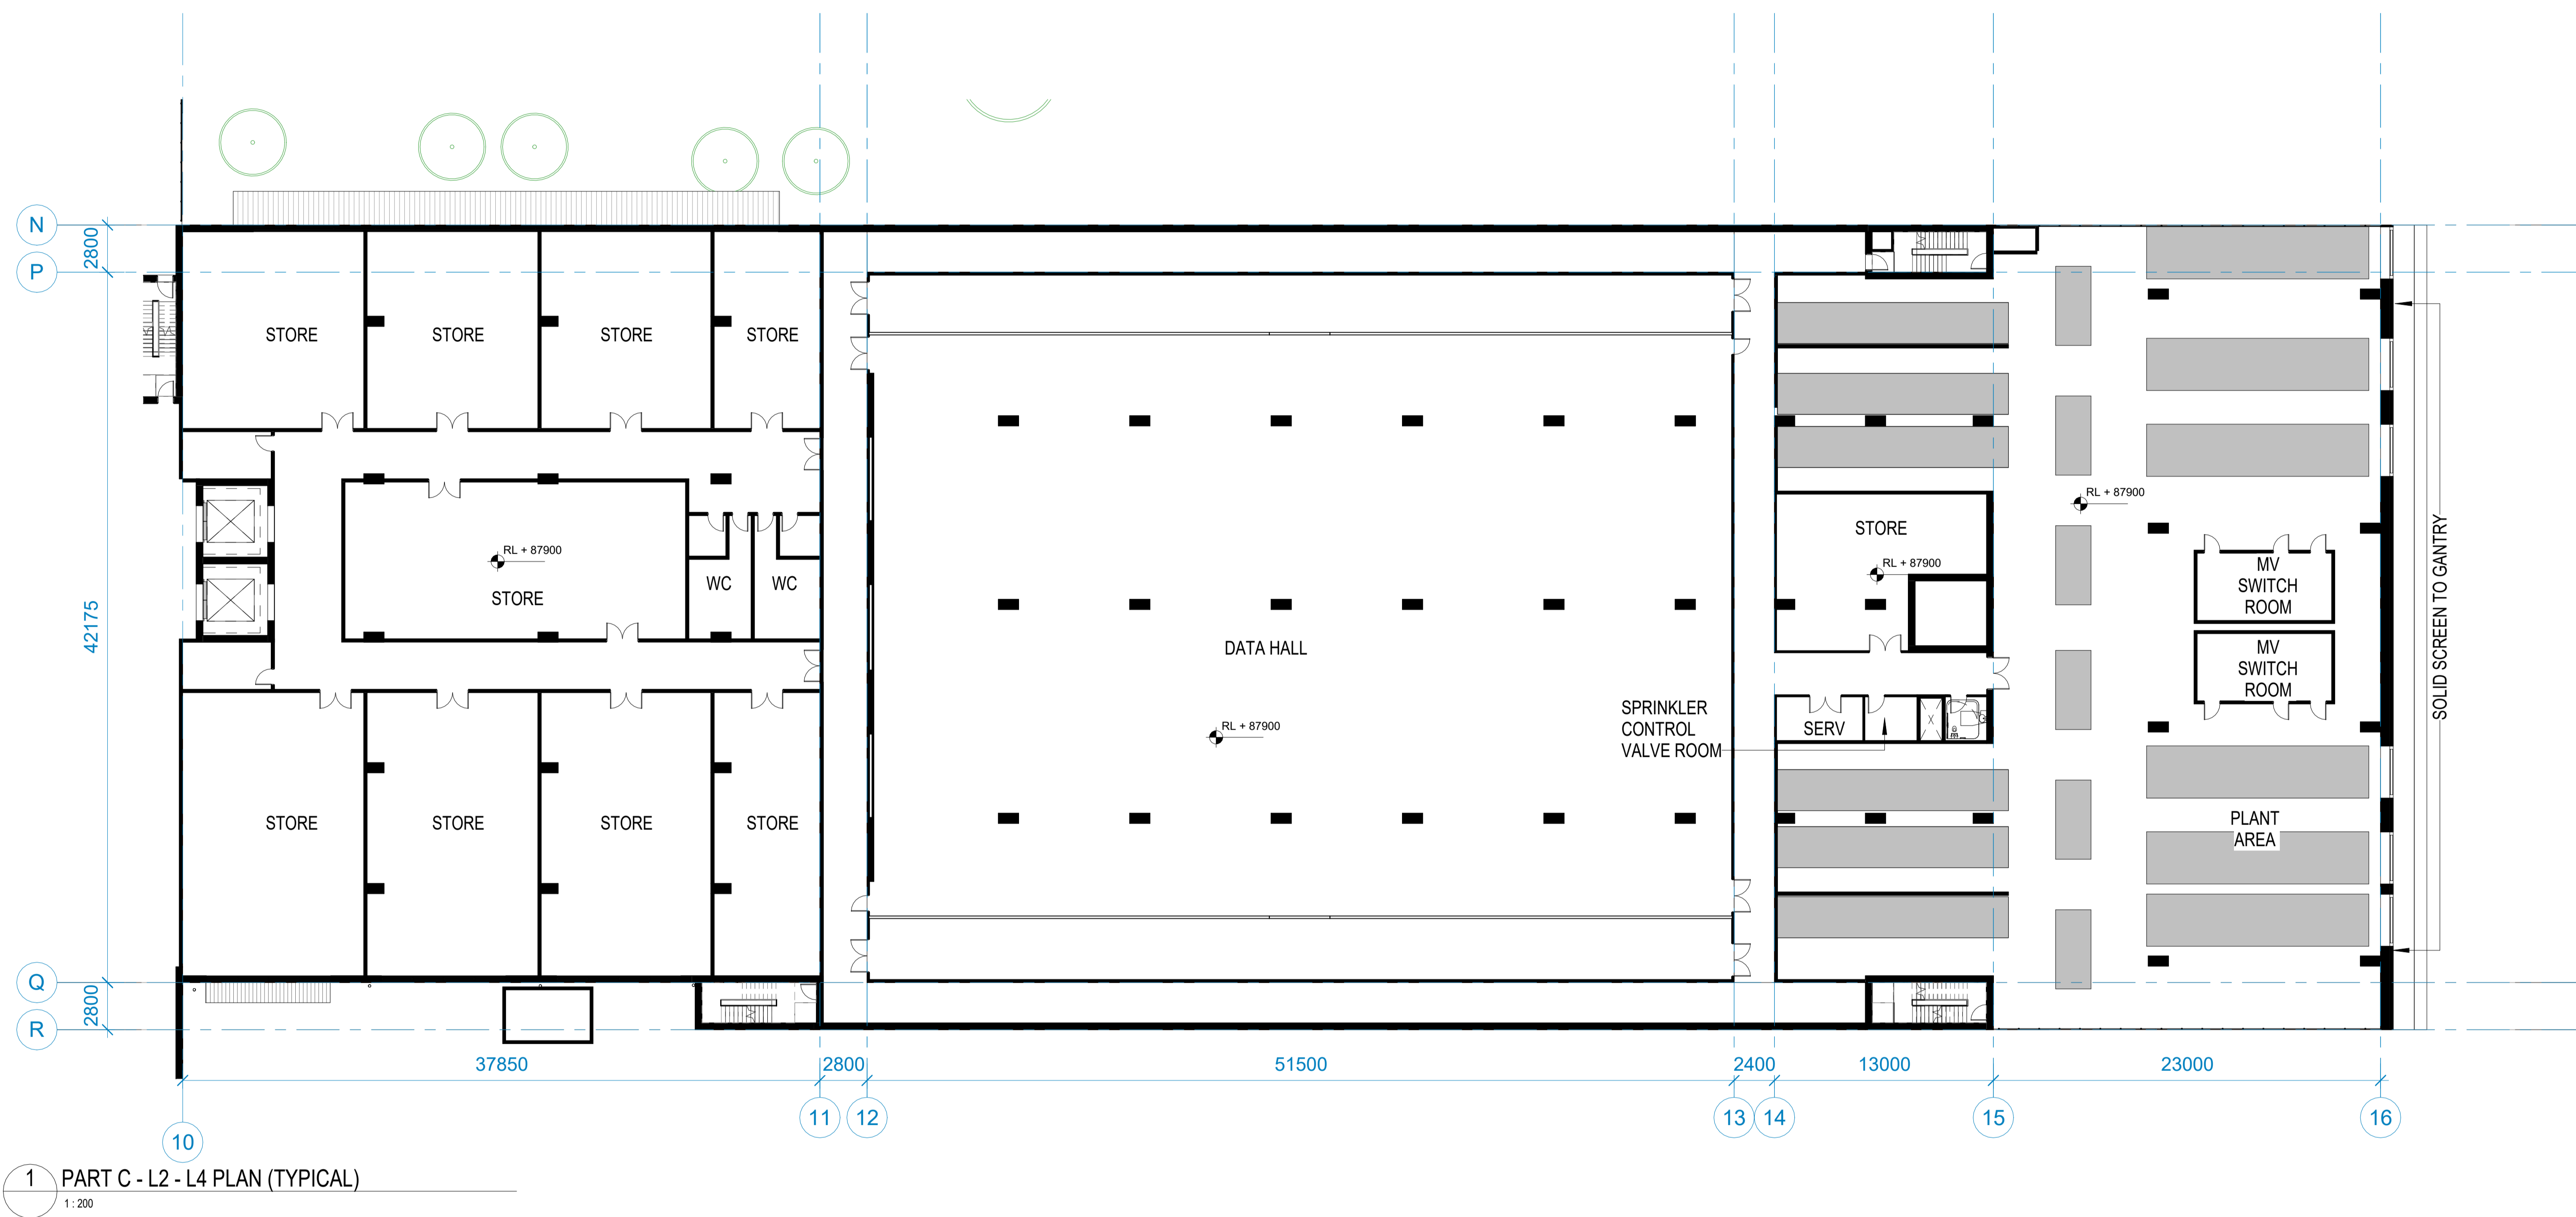

1 PART C - L2 - L4 PLAN (TYPICAL)  
1:200

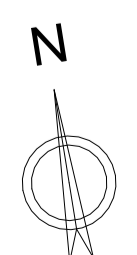

Issue	Date	Description
A	31.07.2024	FOR DA
B	21.08.2024	FOR DA
C	26.08.2024	FOR DA
D	28.08.2024	FOR DA

Notes

Key Plan

Project Manager

Client

Construction Manager

**Greenbox**

+61 2 8069 6030  
LEVEL 22  
68 PITT STREET  
SYDNEY NSW 2000 AUSTRALIA

GREENBOX ARCHITECTURE PTY LTD  
ABN: 79 139 779 098  
ISO 9001 CERTIFIED QUALITY SYSTEM

- Use written dimensions only
- Do not scale from drawing
- Contractors shall confirm all dimensions on-site prior to commencing any work or producing any shop drawings
- All materials to be used in accordance with the manufacturer's specifications and instructions and shall comply with the relevant Australian Standards
- Copyright of this drawing and design remain the property of Greenbox Architecture Pty Ltd
- Nominated Architect - Gerard Page; NSW reg No. 7247; Vic reg No. 17954; QLD reg no. 4538

Client  
EMKC

Project  
PROPOSED DATA CENTRE  
85-86 Sharps Road  
Tullahoma VIC 3043

Scale  
1:200

Drawn By  
AZ/SFI

Checked By  
DK/SFI

Approved By  
AD

Job Number  
240004

Sheet  
1:200

Scale Bar  
0 1 2 3 5 10m


Project Status

Drawing Title  
PART C L2 - L4 PLAN (TYPICAL)


Drawing Number  
DA122

Issue  
D



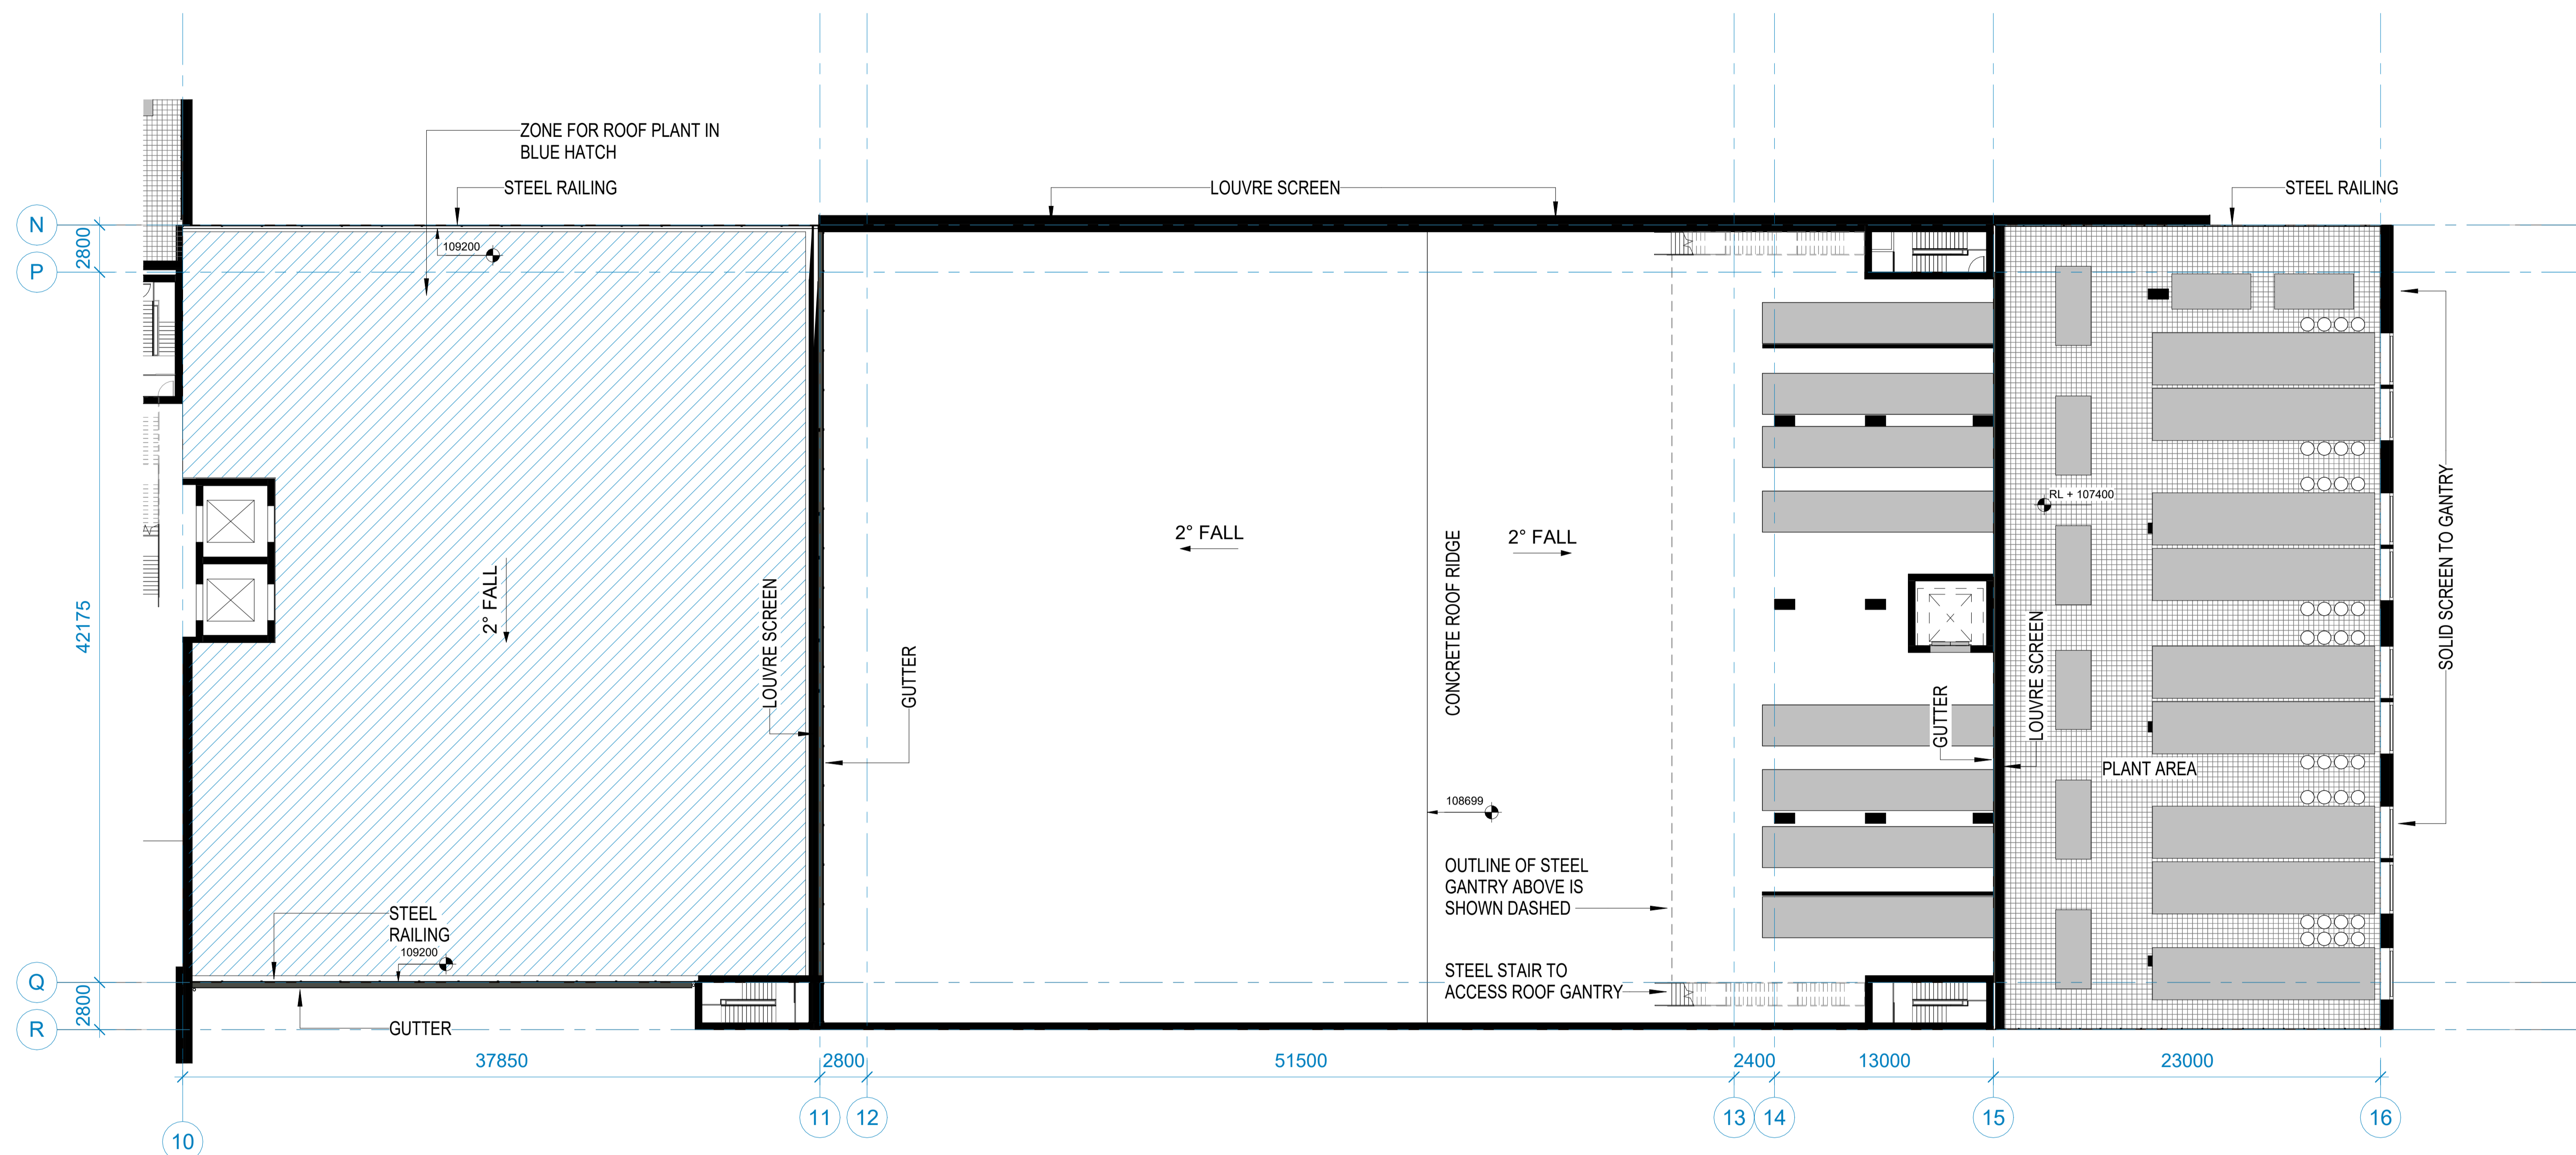

1 DA - LEVEL 5 ROOF - PART C  
1:200

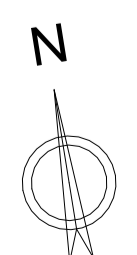

Issue	Date	Description
A	31.07.2024	FOR DA
B	21.08.2024	FOR DA
C	26.08.2024	FOR DA
D	28.08.2024	FOR DA
E	03.09.2024	FOR DA

Notes

Key Plan

Project Manager

Client

Construction Manager



+61 2 8069 8600  
LEVEL 22  
68 PITT STREET  
SYDNEY NSW 2000 AUSTRALIA

GREENBOX ARCHITECTURE PTY LTD  
ABN: 79 139 779 098  
ISO 9001 CERTIFIED QUALITY SYSTEM



- Use written dimensions only
- Do not scale from drawing
- Contractors shall confirm all dimensions on-site prior to commencing any work or producing any shop drawings
- All materials to be used in accordance with the manufacturer's specifications and instructions and shall comply with the relevant Australian Standards
- Copyright of this drawing and design remain the property of Greenbox Architecture Pty Ltd
- Nominated Architect - Gerard Page; NSW reg No. 7247; Vic reg No. 17954; QLD reg no. 4538

Client  
EMKC

Project  
PROPOSED DATA CENTRE  
85-86 Sharps Road  
Tullahoma VIC 3043

Scale	Sheet	Scale Bar
1:200	1:200	0 1 2 3 5 10m
Drawn By AZ/SFI	Project Status DA SUBMISSION	
Checked By DK/SFI	Drawing Title PART C LEVEL 5 (ROOF)	
Approved By AD	Drawing Number 240004	Issue DA125 E



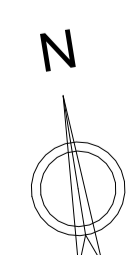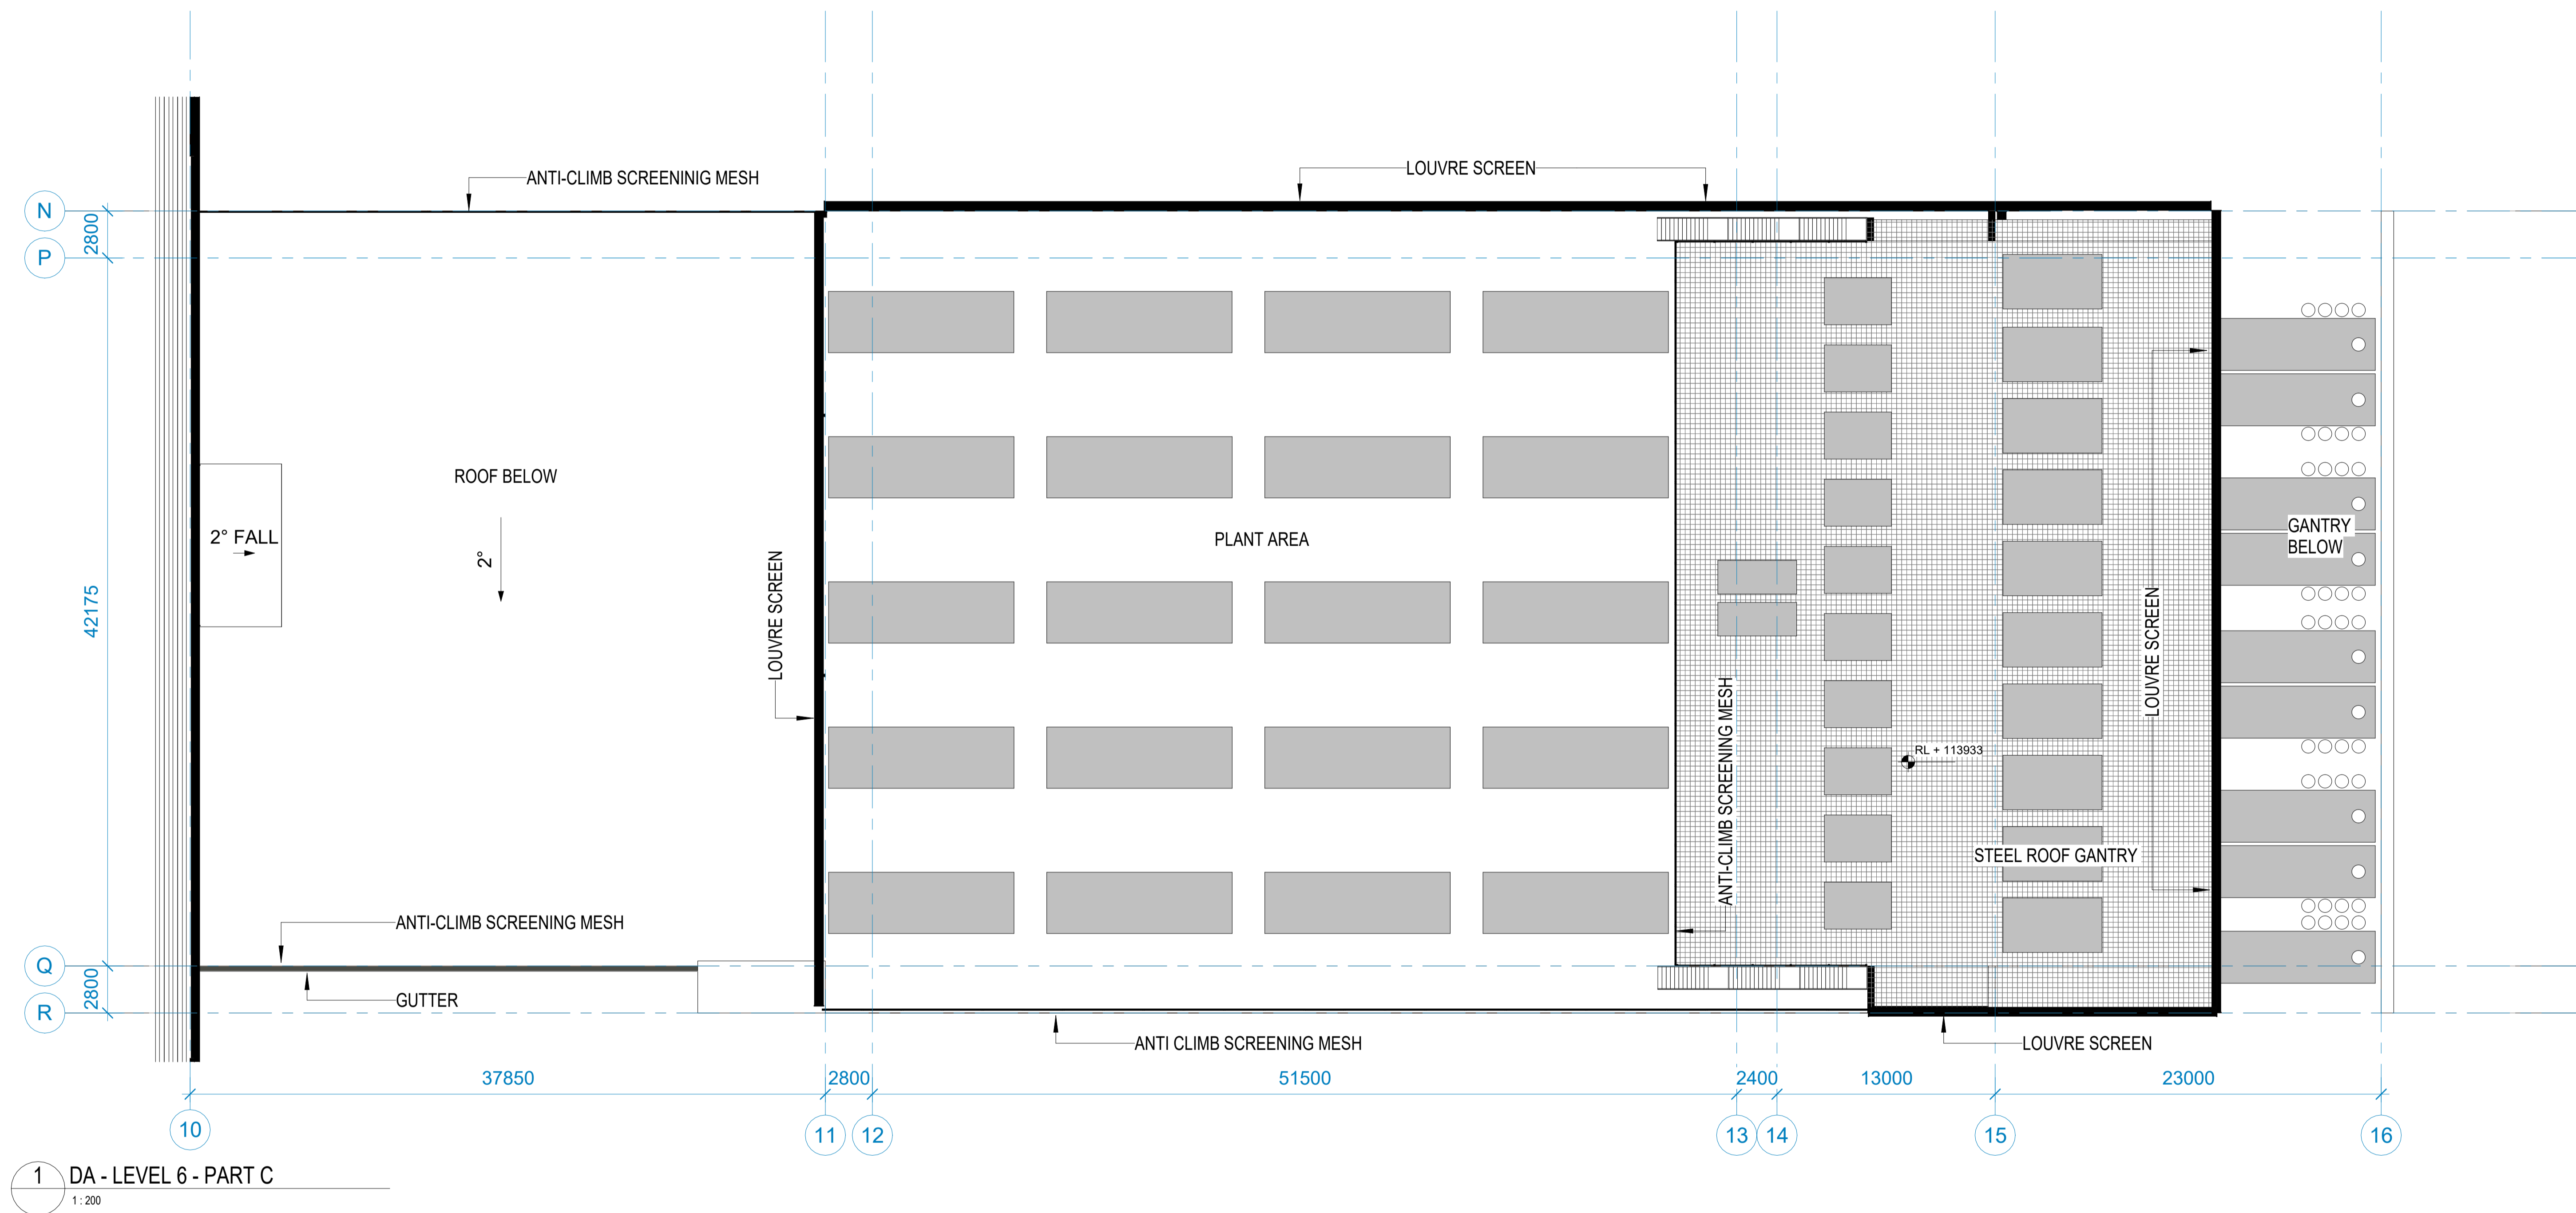

Issue	Date	Description
A	31.07.2024	FOR DA
B	21.08.2024	FOR DA
C	26.08.2024	FOR DA
D	28.08.2024	FOR DA
E	03.09.2024	FOR DA

Notes

Key Plan

Project Manager

Client

Construction Manager

**Greenbox**

+61 2 8069 6000  
LEVEL 22  
68 PITT STREET  
SYDNEY NSW 2000 AUSTRALIA

GREENBOX ARCHITECTURE PTY LTD  
ABN: 79 139 779 098  
ISO 9001 CERTIFIED QUALITY SYSTEM









- Use written dimensions only
- Do not scale from drawing
- Contractors shall confirm all dimensions on-site prior to commencing any work or producing any shop drawings
- All materials to be used in accordance with the manufacturer's specifications and instructions and shall comply with the relevant Australian Standards
- Copyright of this drawing and design remain the property of Greenbox Architecture Pty Ltd
- Nominated Architect - Gerard Page; NSW reg No. 7247; Vic reg No. 17954; QLD reg No. 4536

Client  
EMKC

Project  
PROPOSED DATA CENTRE  
85-86 Sharps Road  
Tullahoma VIC 3043


Scale	Sheet	Scale Bar
1:200	1:200	0 1 2 3 5 10m
Drawn By AZ/SFI	Project Status <b>DA SUBMISSION</b>	
Checked By DK/SFI	Drawing Title <b>PART C LEVEL 6</b>	
Approved By AD	Drawing Number <b>DA126</b>	Issue <b>E</b>
Job Number <b>240004</b>		



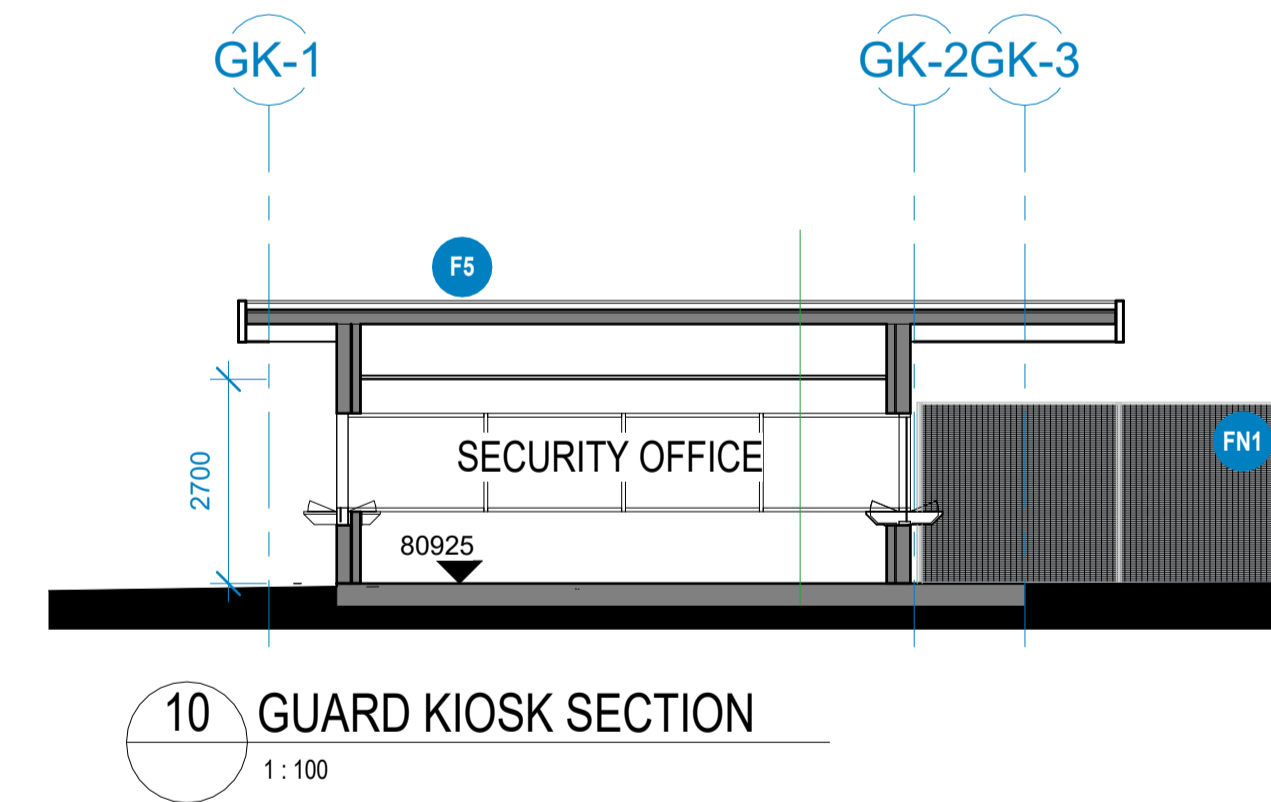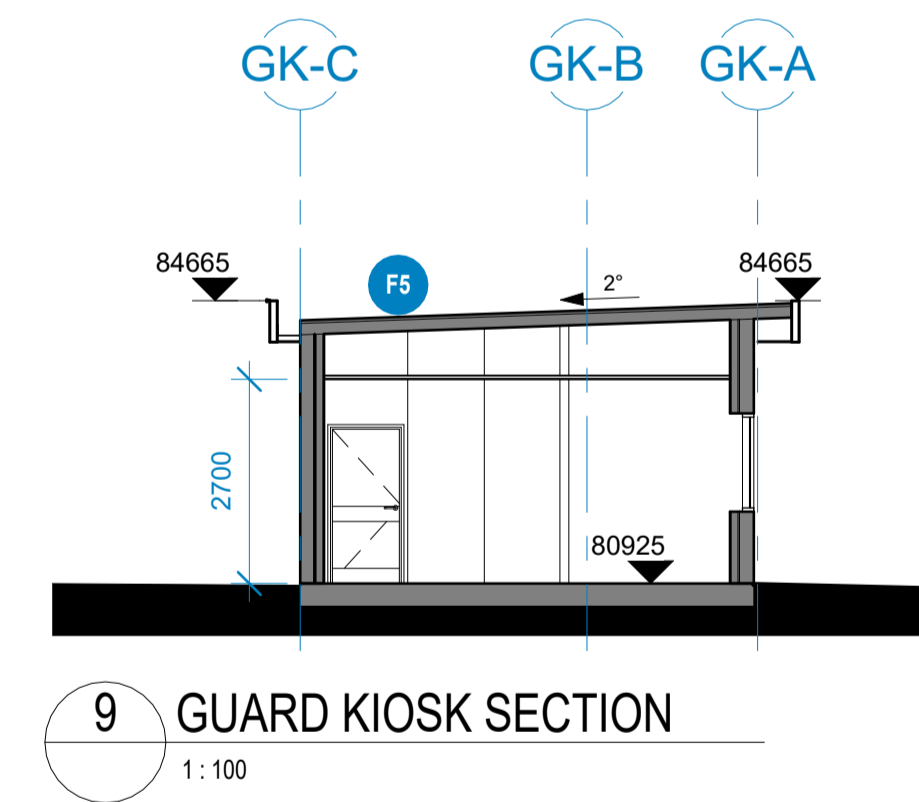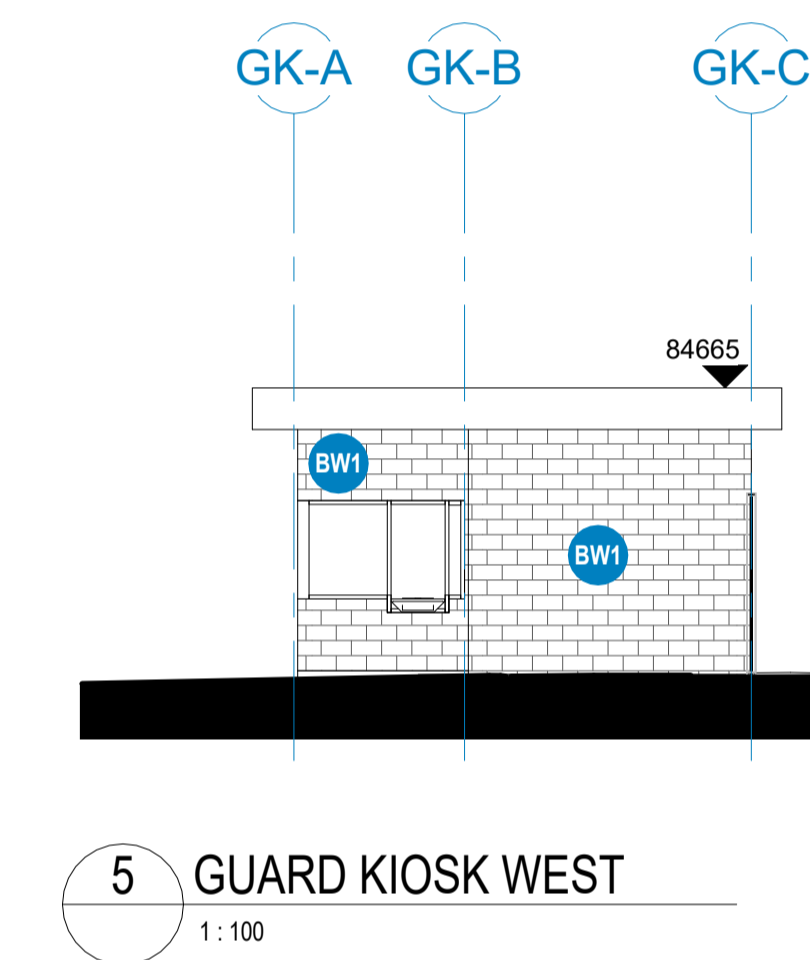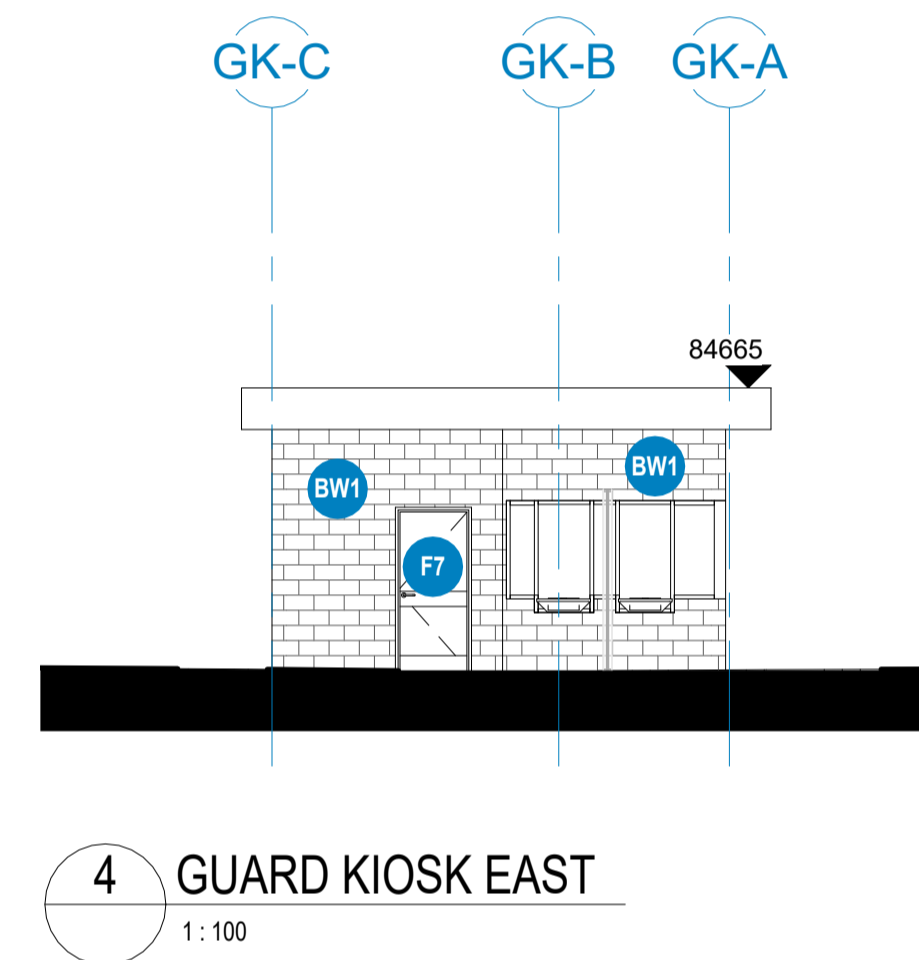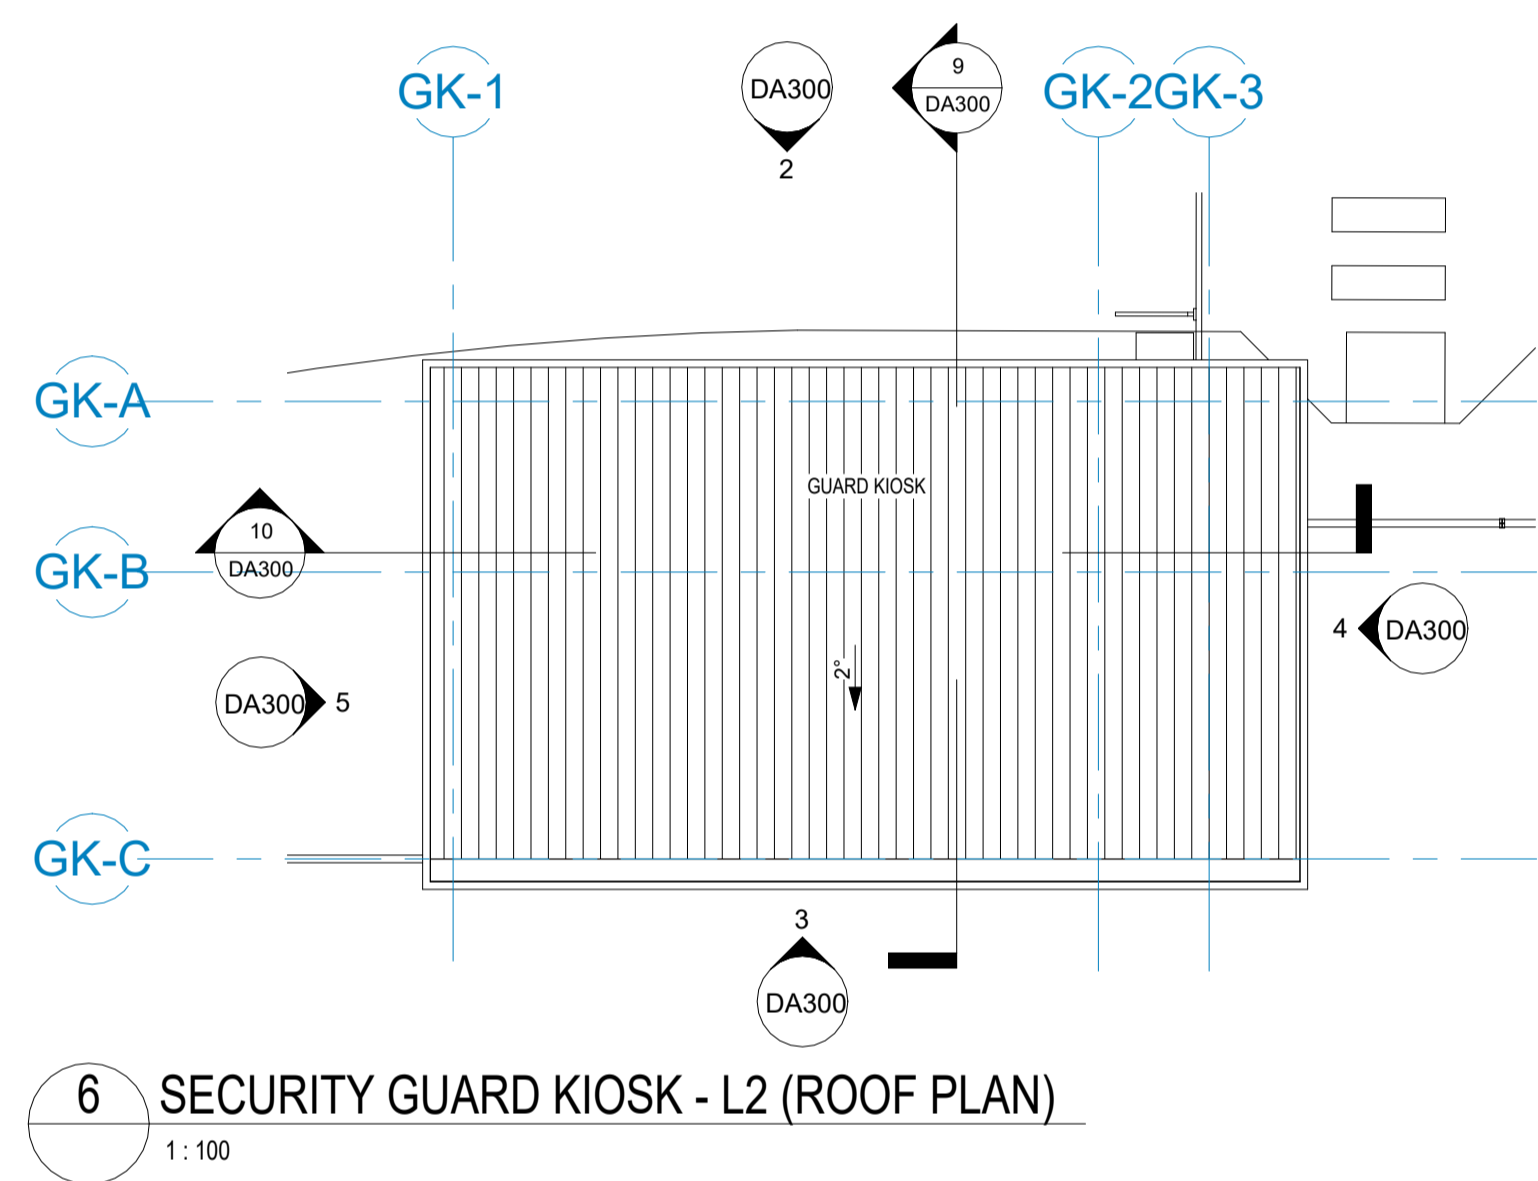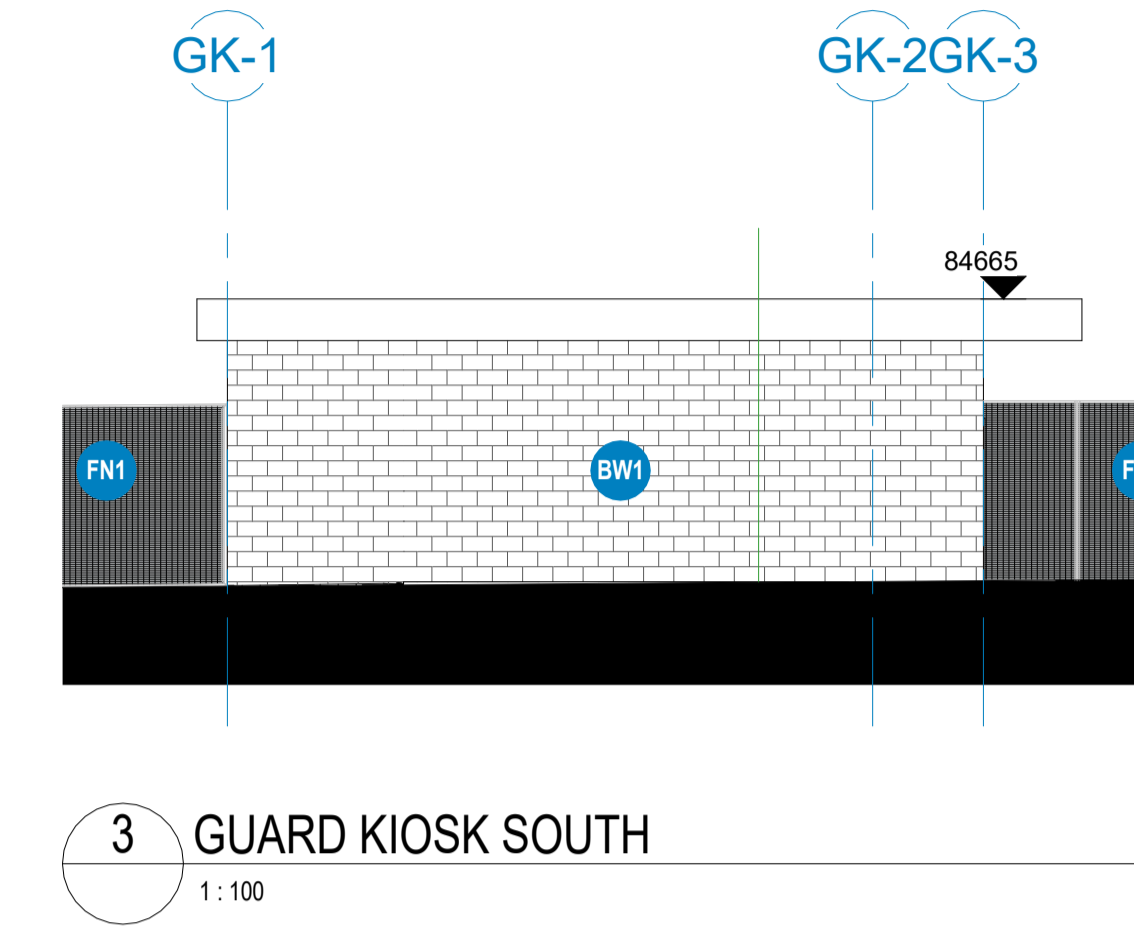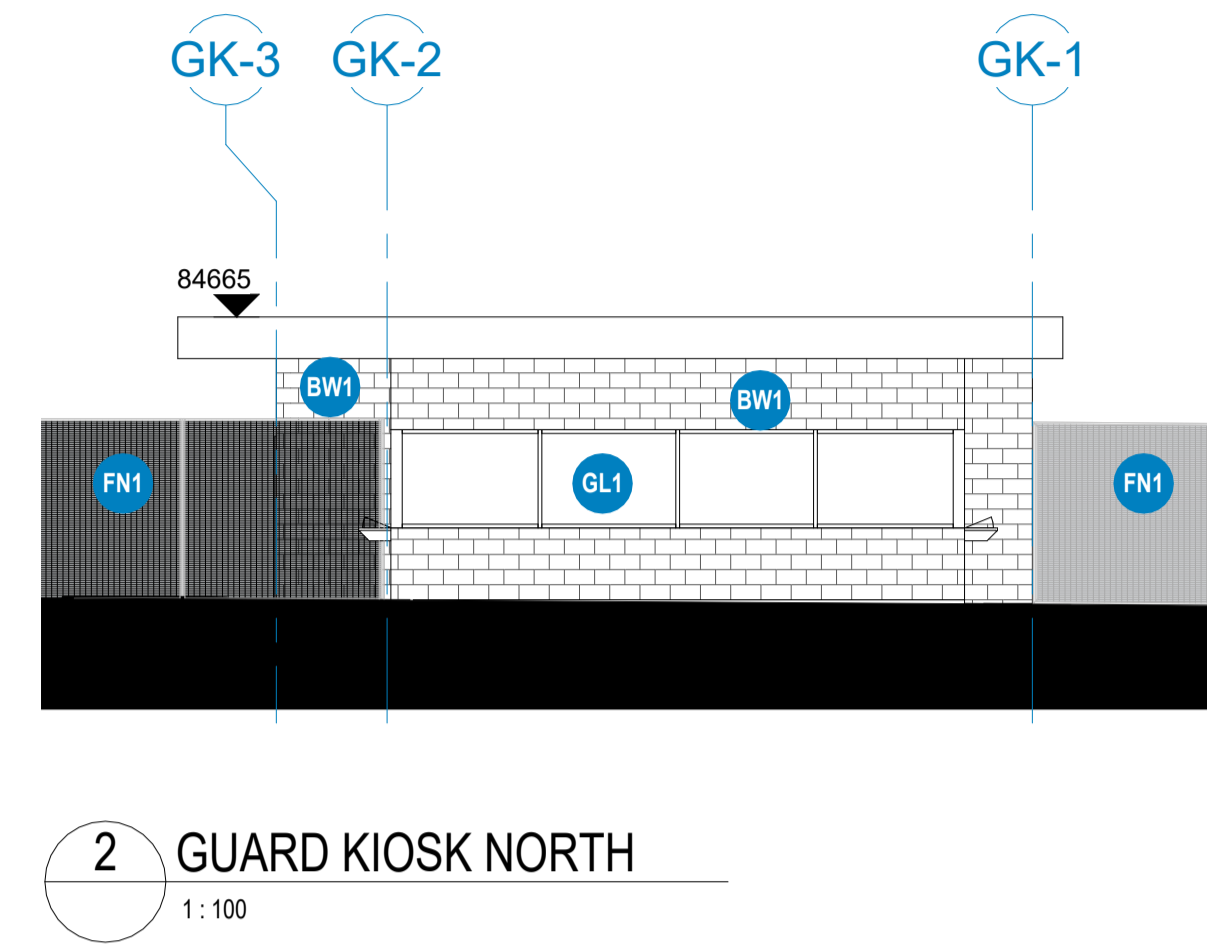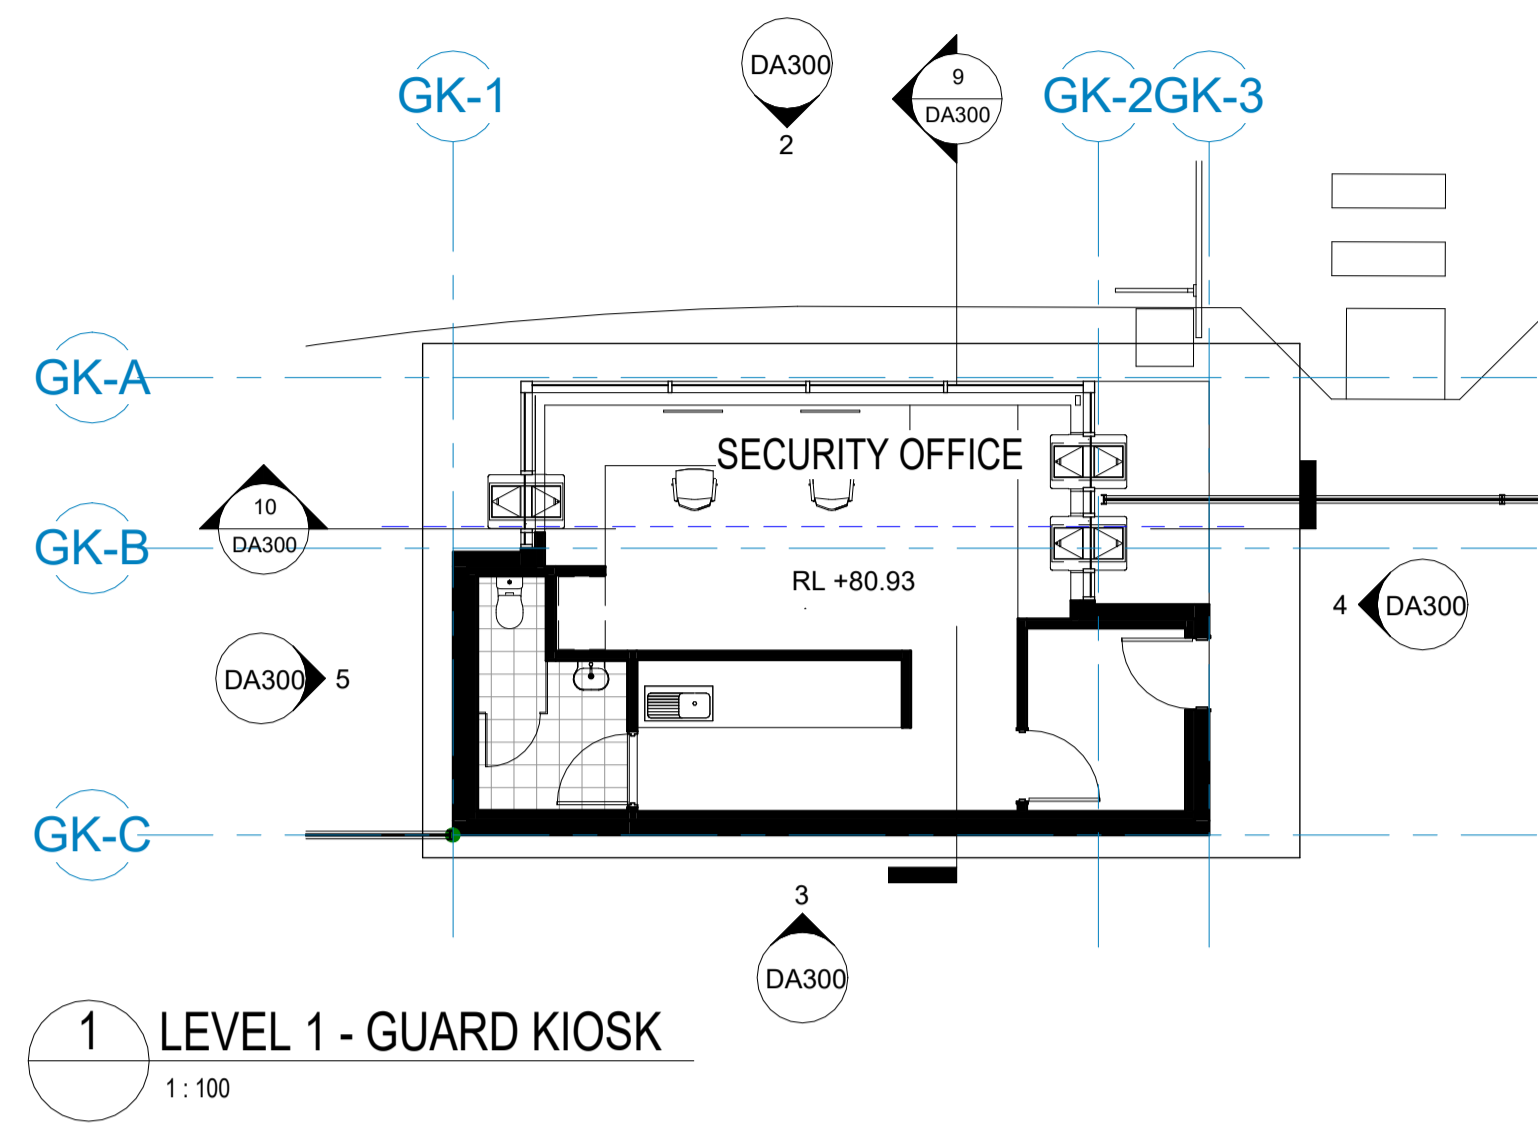


AD	<table border="1"> <thead> <tr> <th>Issue</th> <th>Date</th> <th>Description</th> </tr> </thead> <tbody> <tr> <td>A</td> <td>31.07.2024</td> <td>FOR DA</td> </tr> <tr> <td>B</td> <td>21.08.2024</td> <td>FOR DA</td> </tr> <tr> <td>C</td> <td>26.08.2024</td> <td>FOR DA</td> </tr> <tr> <td>D</td> <td>28.08.2024</td> <td>FOR DA</td> </tr> </tbody> </table>	Issue	Date	Description	A	31.07.2024	FOR DA	B	21.08.2024	FOR DA	C	26.08.2024	FOR DA	D	28.08.2024	FOR DA		Key Plan	Project Manager	Client	<p>GREENBOX ARCHITECTURE PTY LTD 68 PITT STREET SYDNEY NSW 2000 AUSTRALIA</p> <p>ABN: 79 139 779 098 ISO 9001 CERTIFIED QUALITY SYSTEM</p>	<ul style="list-style-type: none"> <li>Use written dimensions only</li> <li>Do not scale from drawing</li> <li>Contractors shall confirm all dimensions on-site prior to commencing any work or producing any shop drawings</li> <li>All materials to be used in accordance with the manufacturer's specifications and instructions and shall comply with the relevant Australian Standards</li> <li>Copyright of this drawing and design remain the property of Greenbox Architecture Pty Ltd</li> <li>Nominated Architect - Gerard Page, NSW reg No. 7247, Vic reg No. 17954, QLD reg No. 4536</li> </ul>	<table border="1"> <tr> <td>Client</td> <td>EMKC</td> </tr> <tr> <td>Project</td> <td>PROPOSED DATA CENTRE 85-86 Sharps Road Tullamarine VIC 3043</td> </tr> </table>	Client	EMKC	Project	PROPOSED DATA CENTRE 85-86 Sharps Road Tullamarine VIC 3043	<table border="1"> <tr> <td>Scale</td> <td>1:100</td> <td>Sheet</td> <td>Scale Bar</td> <td>0 1 2 3 5m</td> </tr> <tr> <td>Drawn By</td> <td>KG</td> <td>Project Status</td> <td colspan="2">FOR COORDINATION</td> </tr> <tr> <td>Checked By</td> <td>DK/SFI</td> <td>Drawing Title</td> <td colspan="2">SECURITY GUARD KIOSK DETAILS</td> </tr> <tr> <td>Approved By</td> <td>AD</td> <td>Job Number</td> <td>240004</td> <td>Issue</td> </tr> <tr> <td></td> <td></td> <td>Drawing Number</td> <td>DA300</td> <td>D</td> </tr> </table>	Scale	1:100	Sheet	Scale Bar	0 1 2 3 5m	Drawn By	KG	Project Status	FOR COORDINATION		Checked By	DK/SFI	Drawing Title	SECURITY GUARD KIOSK DETAILS		Approved By	AD	Job Number	240004	Issue			Drawing Number	DA300	D
	Issue	Date	Description																																																		
A	31.07.2024	FOR DA																																																			
B	21.08.2024	FOR DA																																																			
C	26.08.2024	FOR DA																																																			
D	28.08.2024	FOR DA																																																			
Client	EMKC																																																				
Project	PROPOSED DATA CENTRE 85-86 Sharps Road Tullamarine VIC 3043																																																				
Scale	1:100	Sheet	Scale Bar	0 1 2 3 5m																																																	
Drawn By	KG	Project Status	FOR COORDINATION																																																		
Checked By	DK/SFI	Drawing Title	SECURITY GUARD KIOSK DETAILS																																																		
Approved By	AD	Job Number	240004	Issue																																																	
		Drawing Number	DA300	D																																																	
	Notes			Construction Manager																																																	




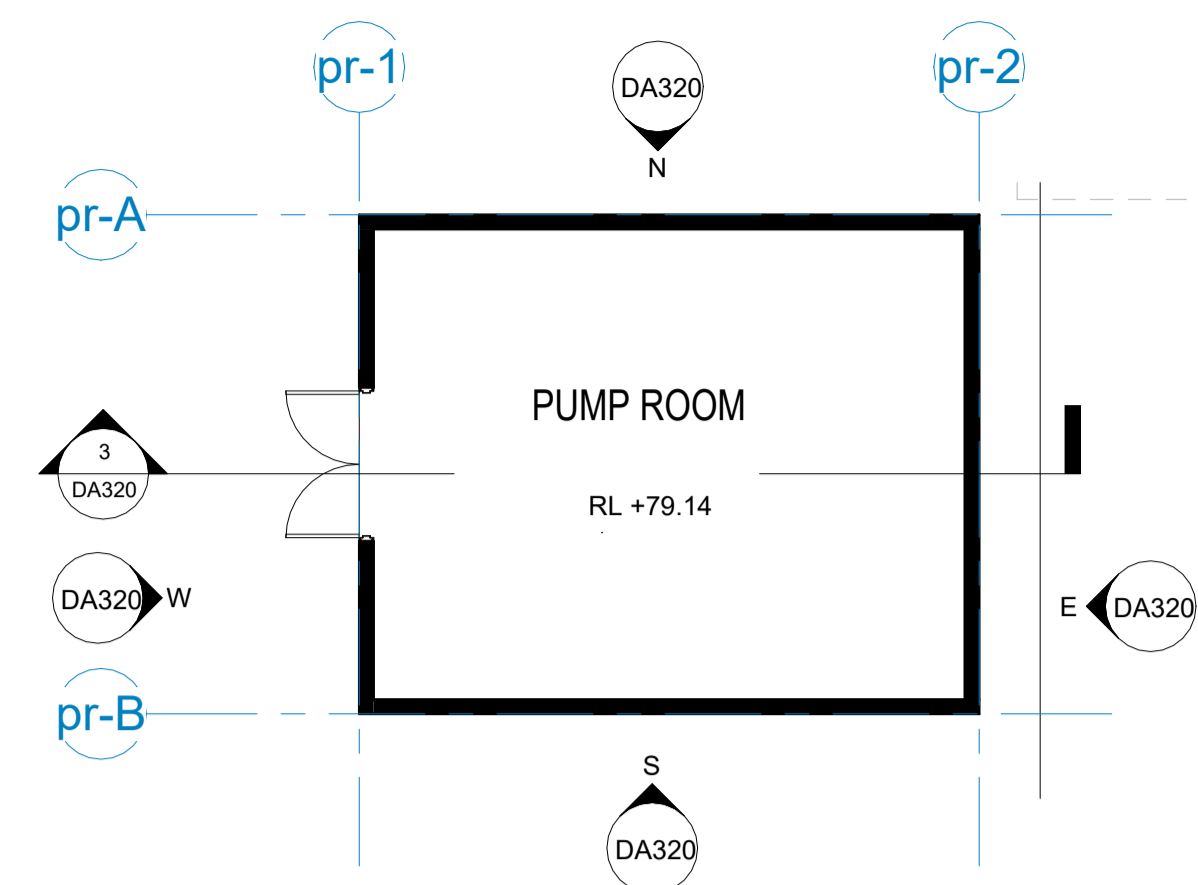


1 LEVEL 1 - FIRE PUMP ROOM  
1:100

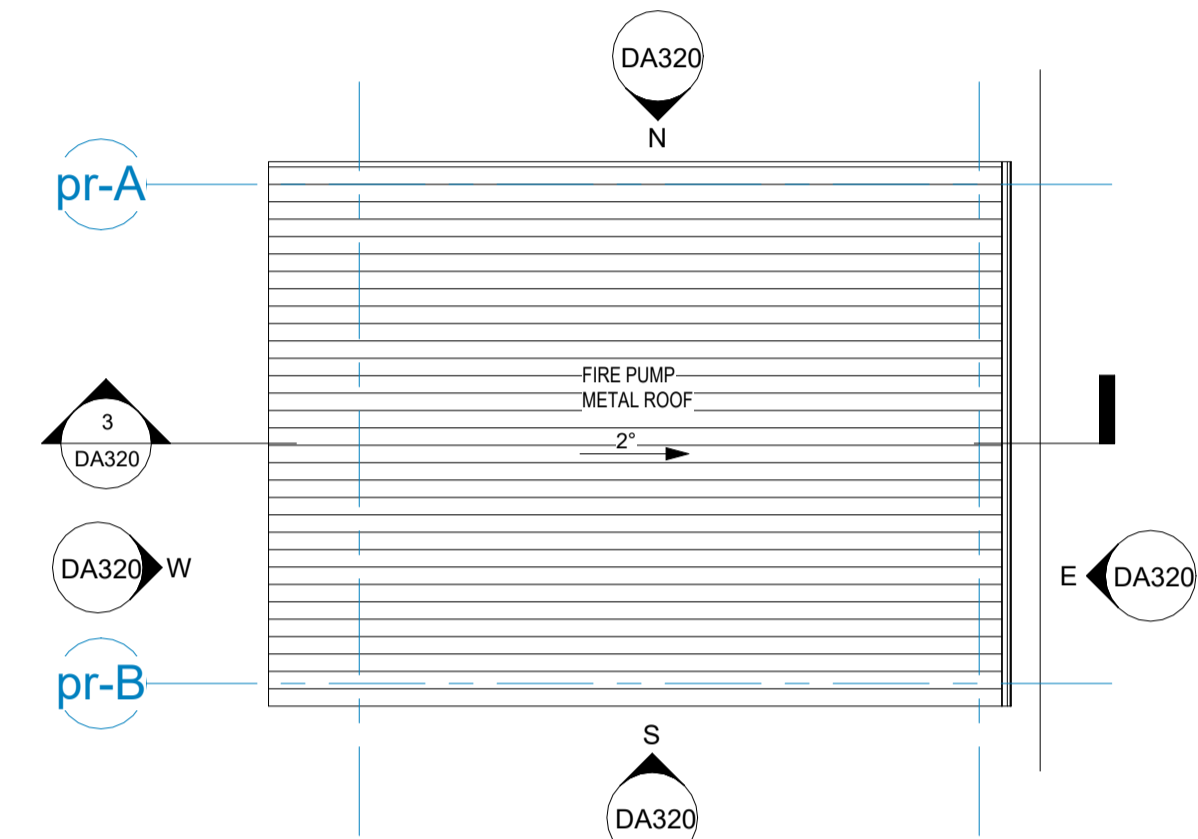


2 PUMP ROOMS L2 (ROOF)  
1:100

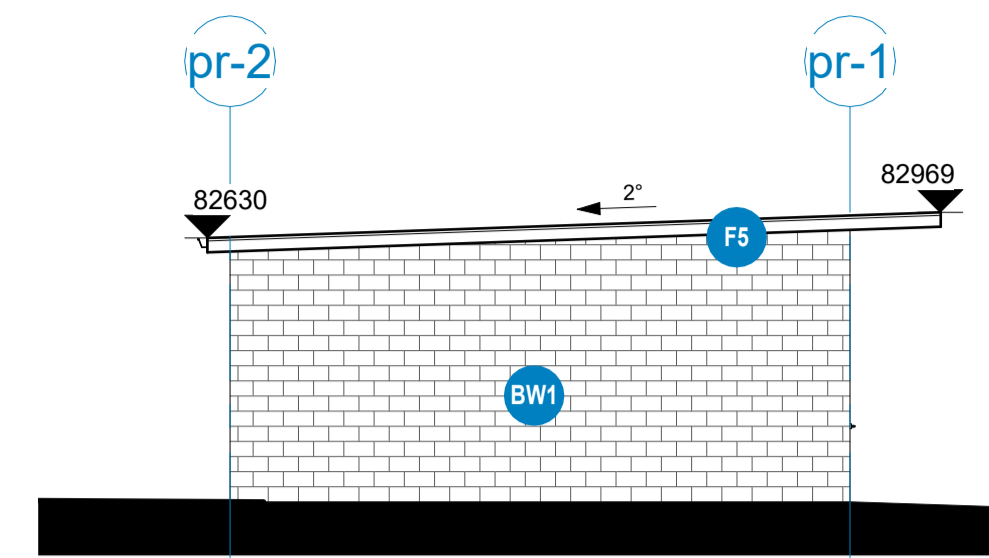


N PUMP FR NORTH  
1:100

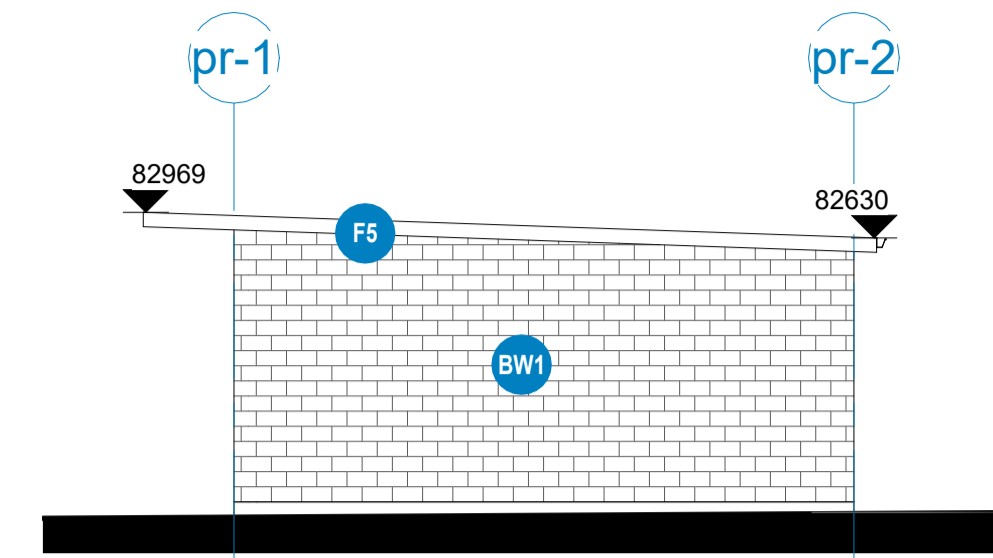


S PUMP FR SOUTH  
1:100

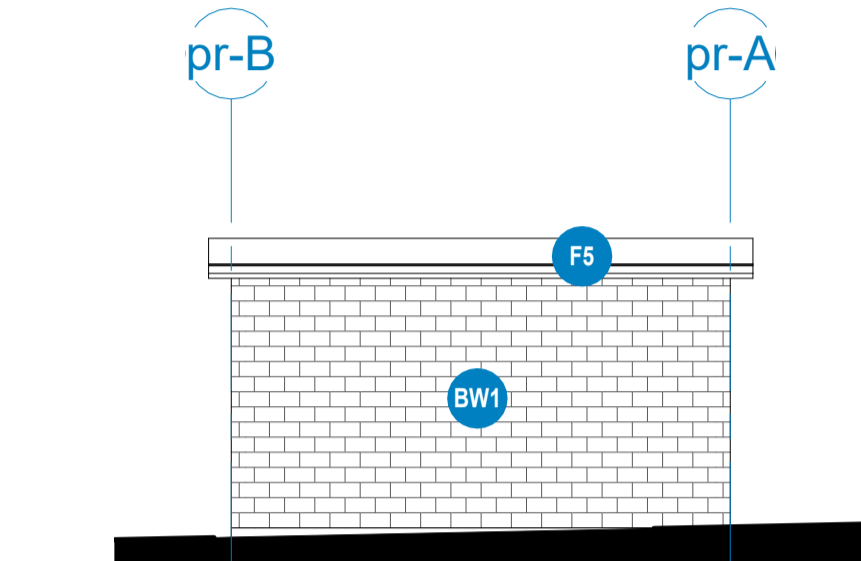


E PUMP FR EAST  
1:100

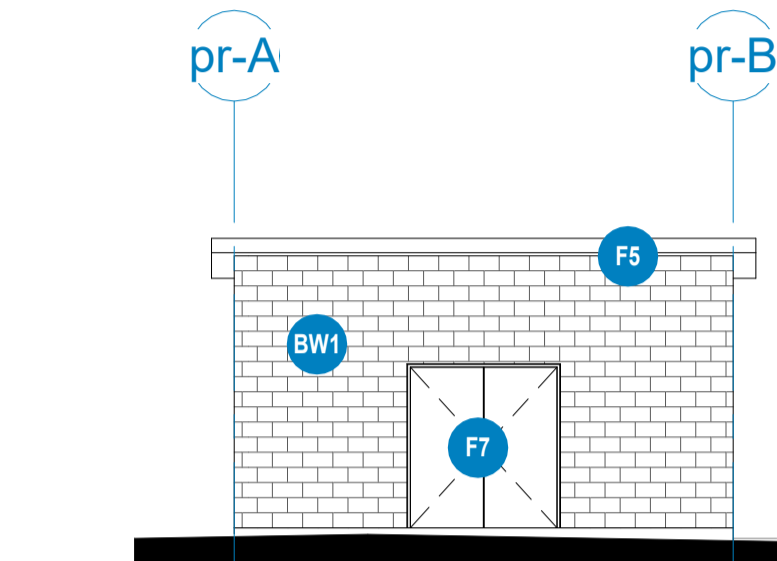


W PUMP FR WEST  
1:100

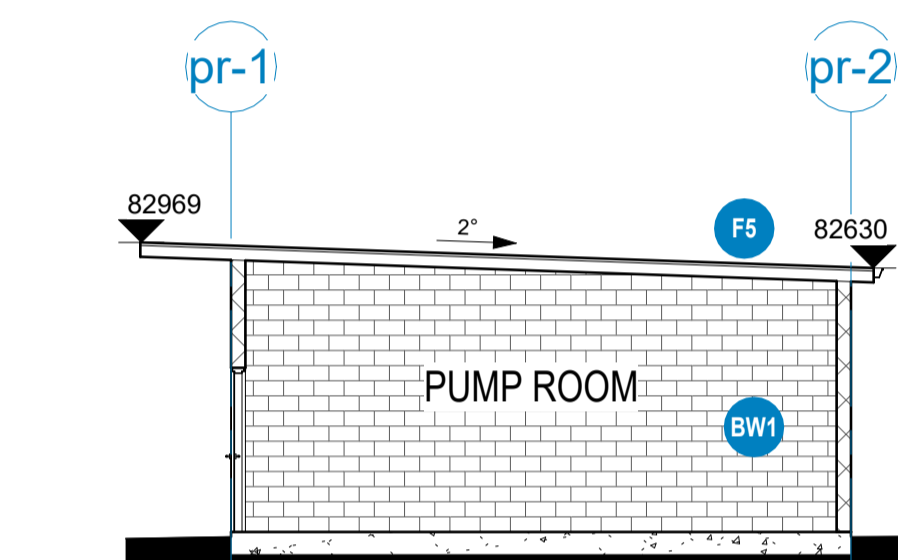


3 PUMP FR SECTION1  
1:100

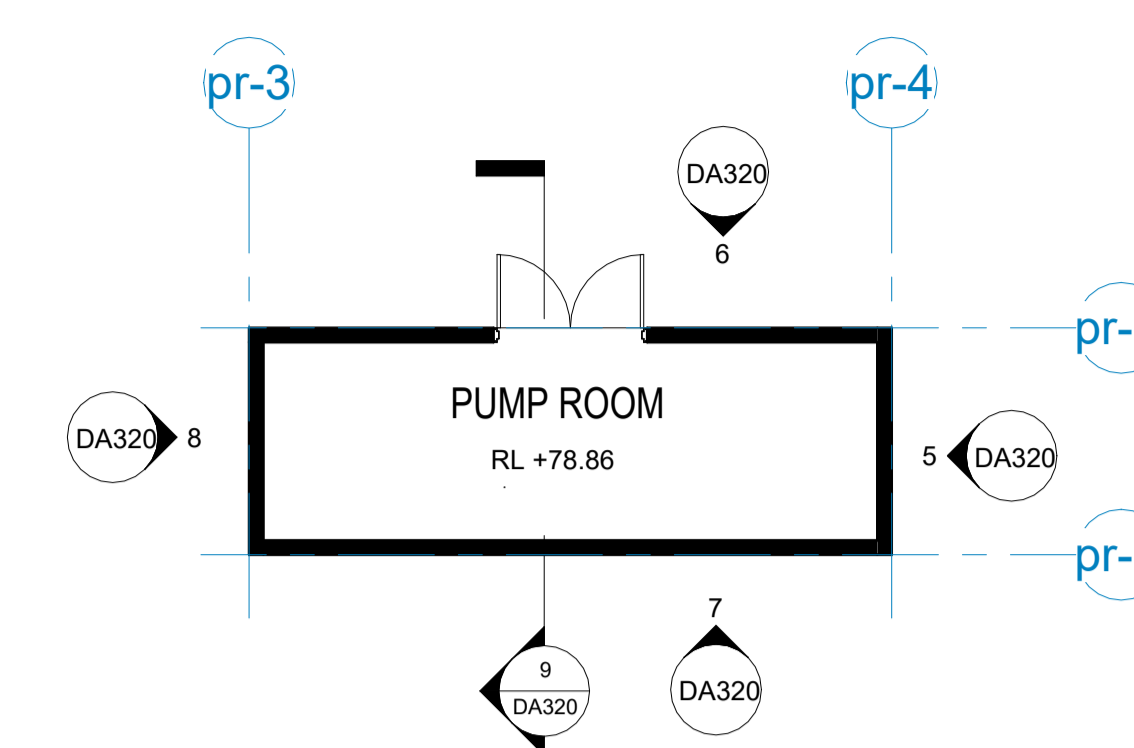


4 WATER PUMP ROOM - L1  
1:100

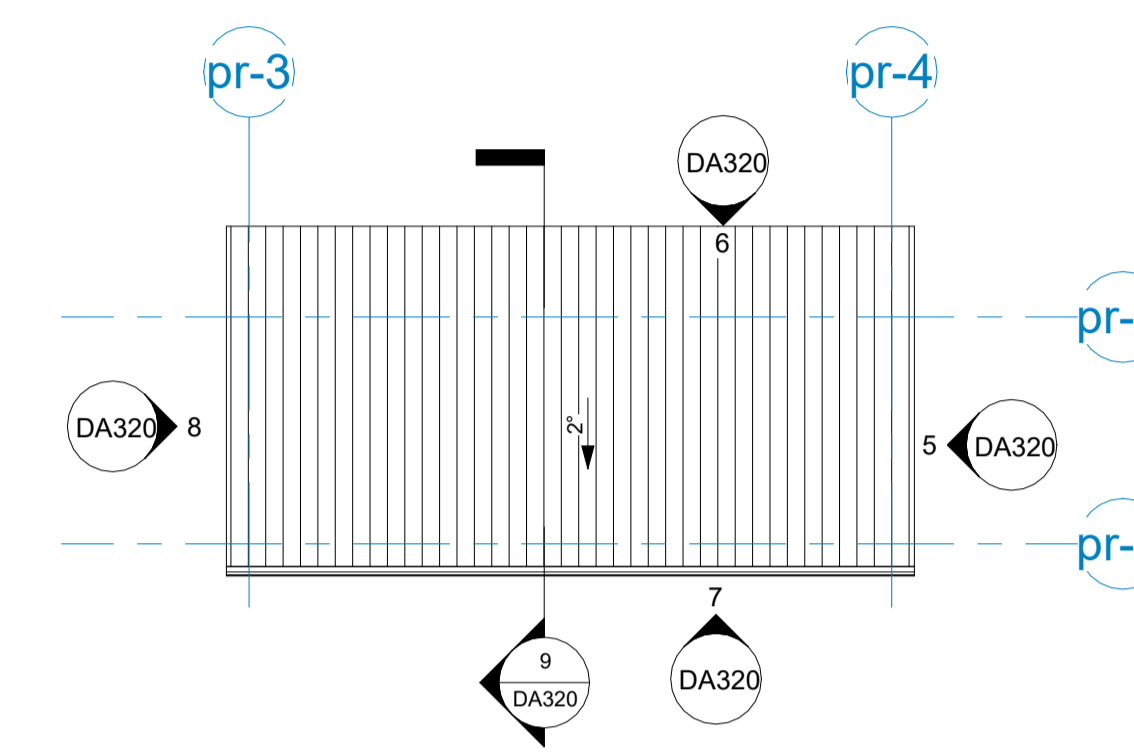


10 WATER PUMP ROOM - ROOF  
1:100

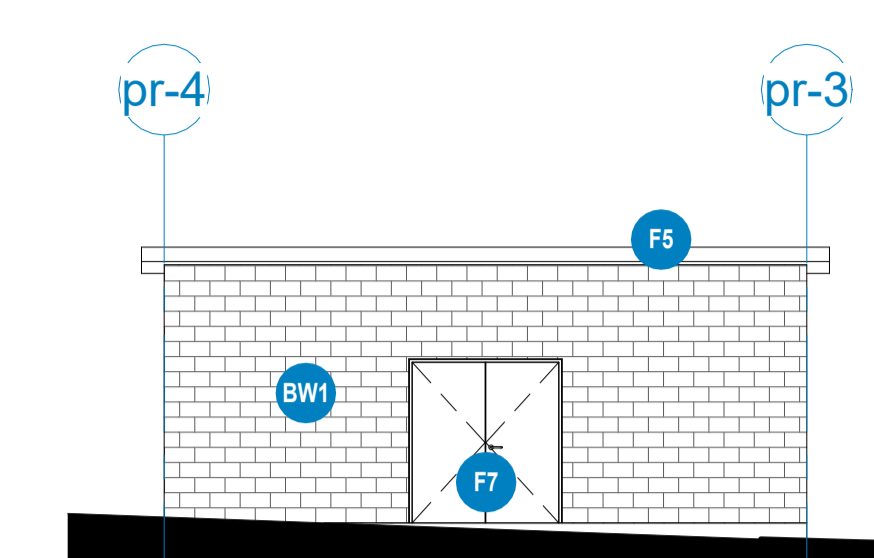


6 WATER PUMP NORTH  
1:100

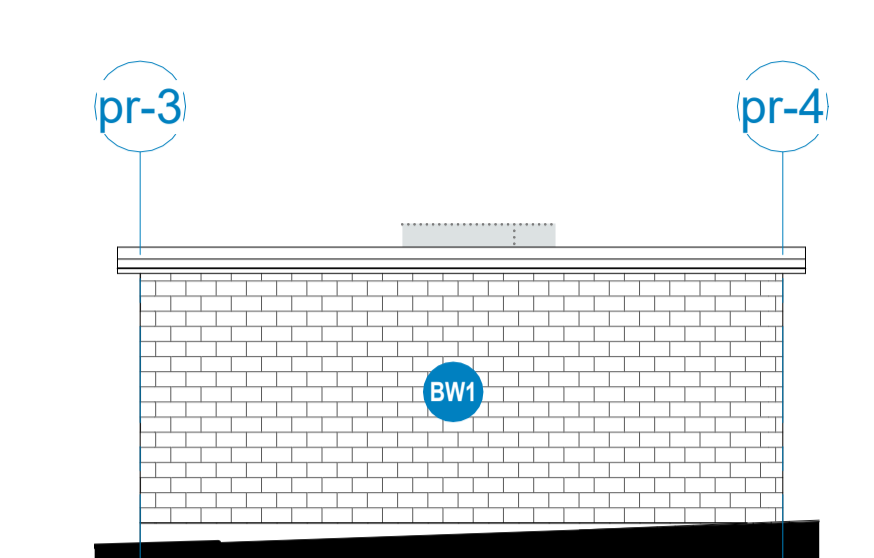


7 WATER PUMP SOUTH  
1:100

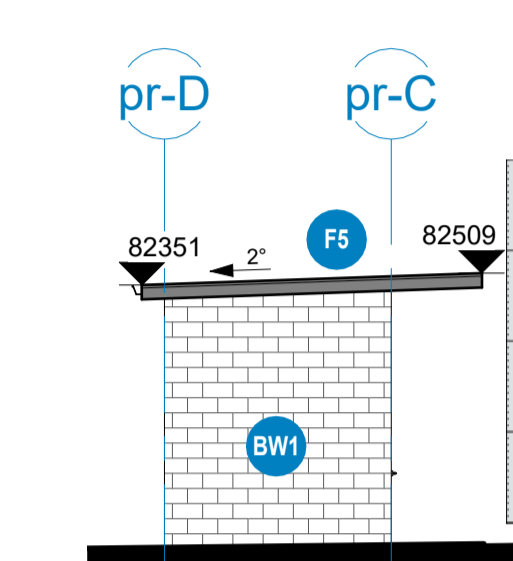

5 WATER PUMP EAST  
1:100

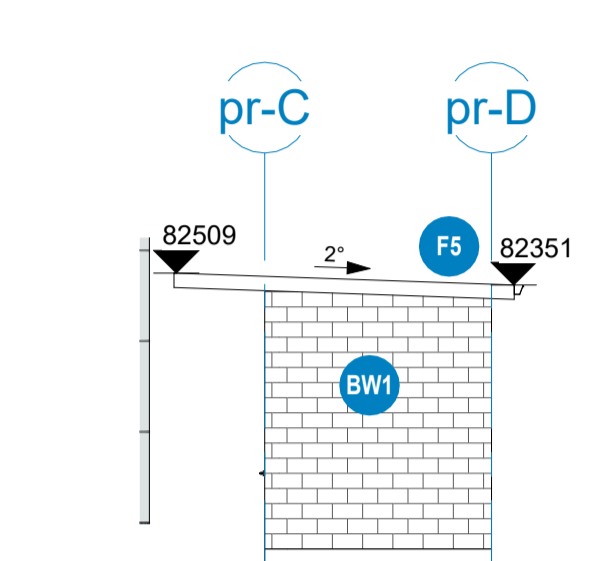


8 WATER PUMP WEST  
1:100

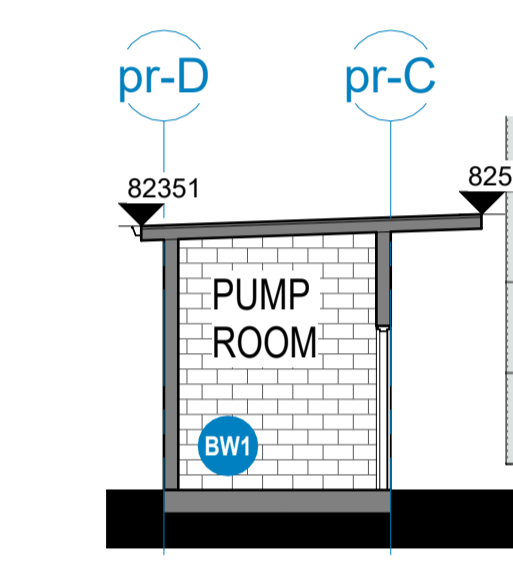

9 WATER PUMP ROOM SECTION  
1:100


AD	Issue	Date	Description	Notes	Key Plan	Project Manager	Client	<p>+61 2 8069 8030 LEVEL 22 68 PITT STREET SYDNEY NSW 2000 AUSTRALIA</p> <p>GREENBOX ARCHITECTURE PTY LTD ABN: 79 139 778 098 ISO 9001 CERTIFIED QUALITY SYSTEM</p>	<ul style="list-style-type: none"> <li>Use written dimensions only</li> <li>Do not scale from drawing</li> <li>Contractors shall confirm all dimensions on-site prior to commencing any work or producing any shop drawings</li> <li>All materials to be used in accordance with the manufacturer's specifications and instructions and shall comply with the relevant Australian Standards</li> <li>Copyright of this drawing and design remain the property of Greenbox Architecture Pty Ltd</li> <li>Nominated Architect - Gerard Page, NSW reg No. 7247, Vic reg No. 17954, QLD reg No. 4538</li> </ul>	Client	EMKC	Scale	1:100	Sheet	Scale Bar	0 1 2 3 5m
	Project	PROPOSED DATA CENTRE	Checked By							DK/SFI	Project Status	FOR COORDINATION	Drawing Title	PUMP ROOM DETAILS	Job Number	240004



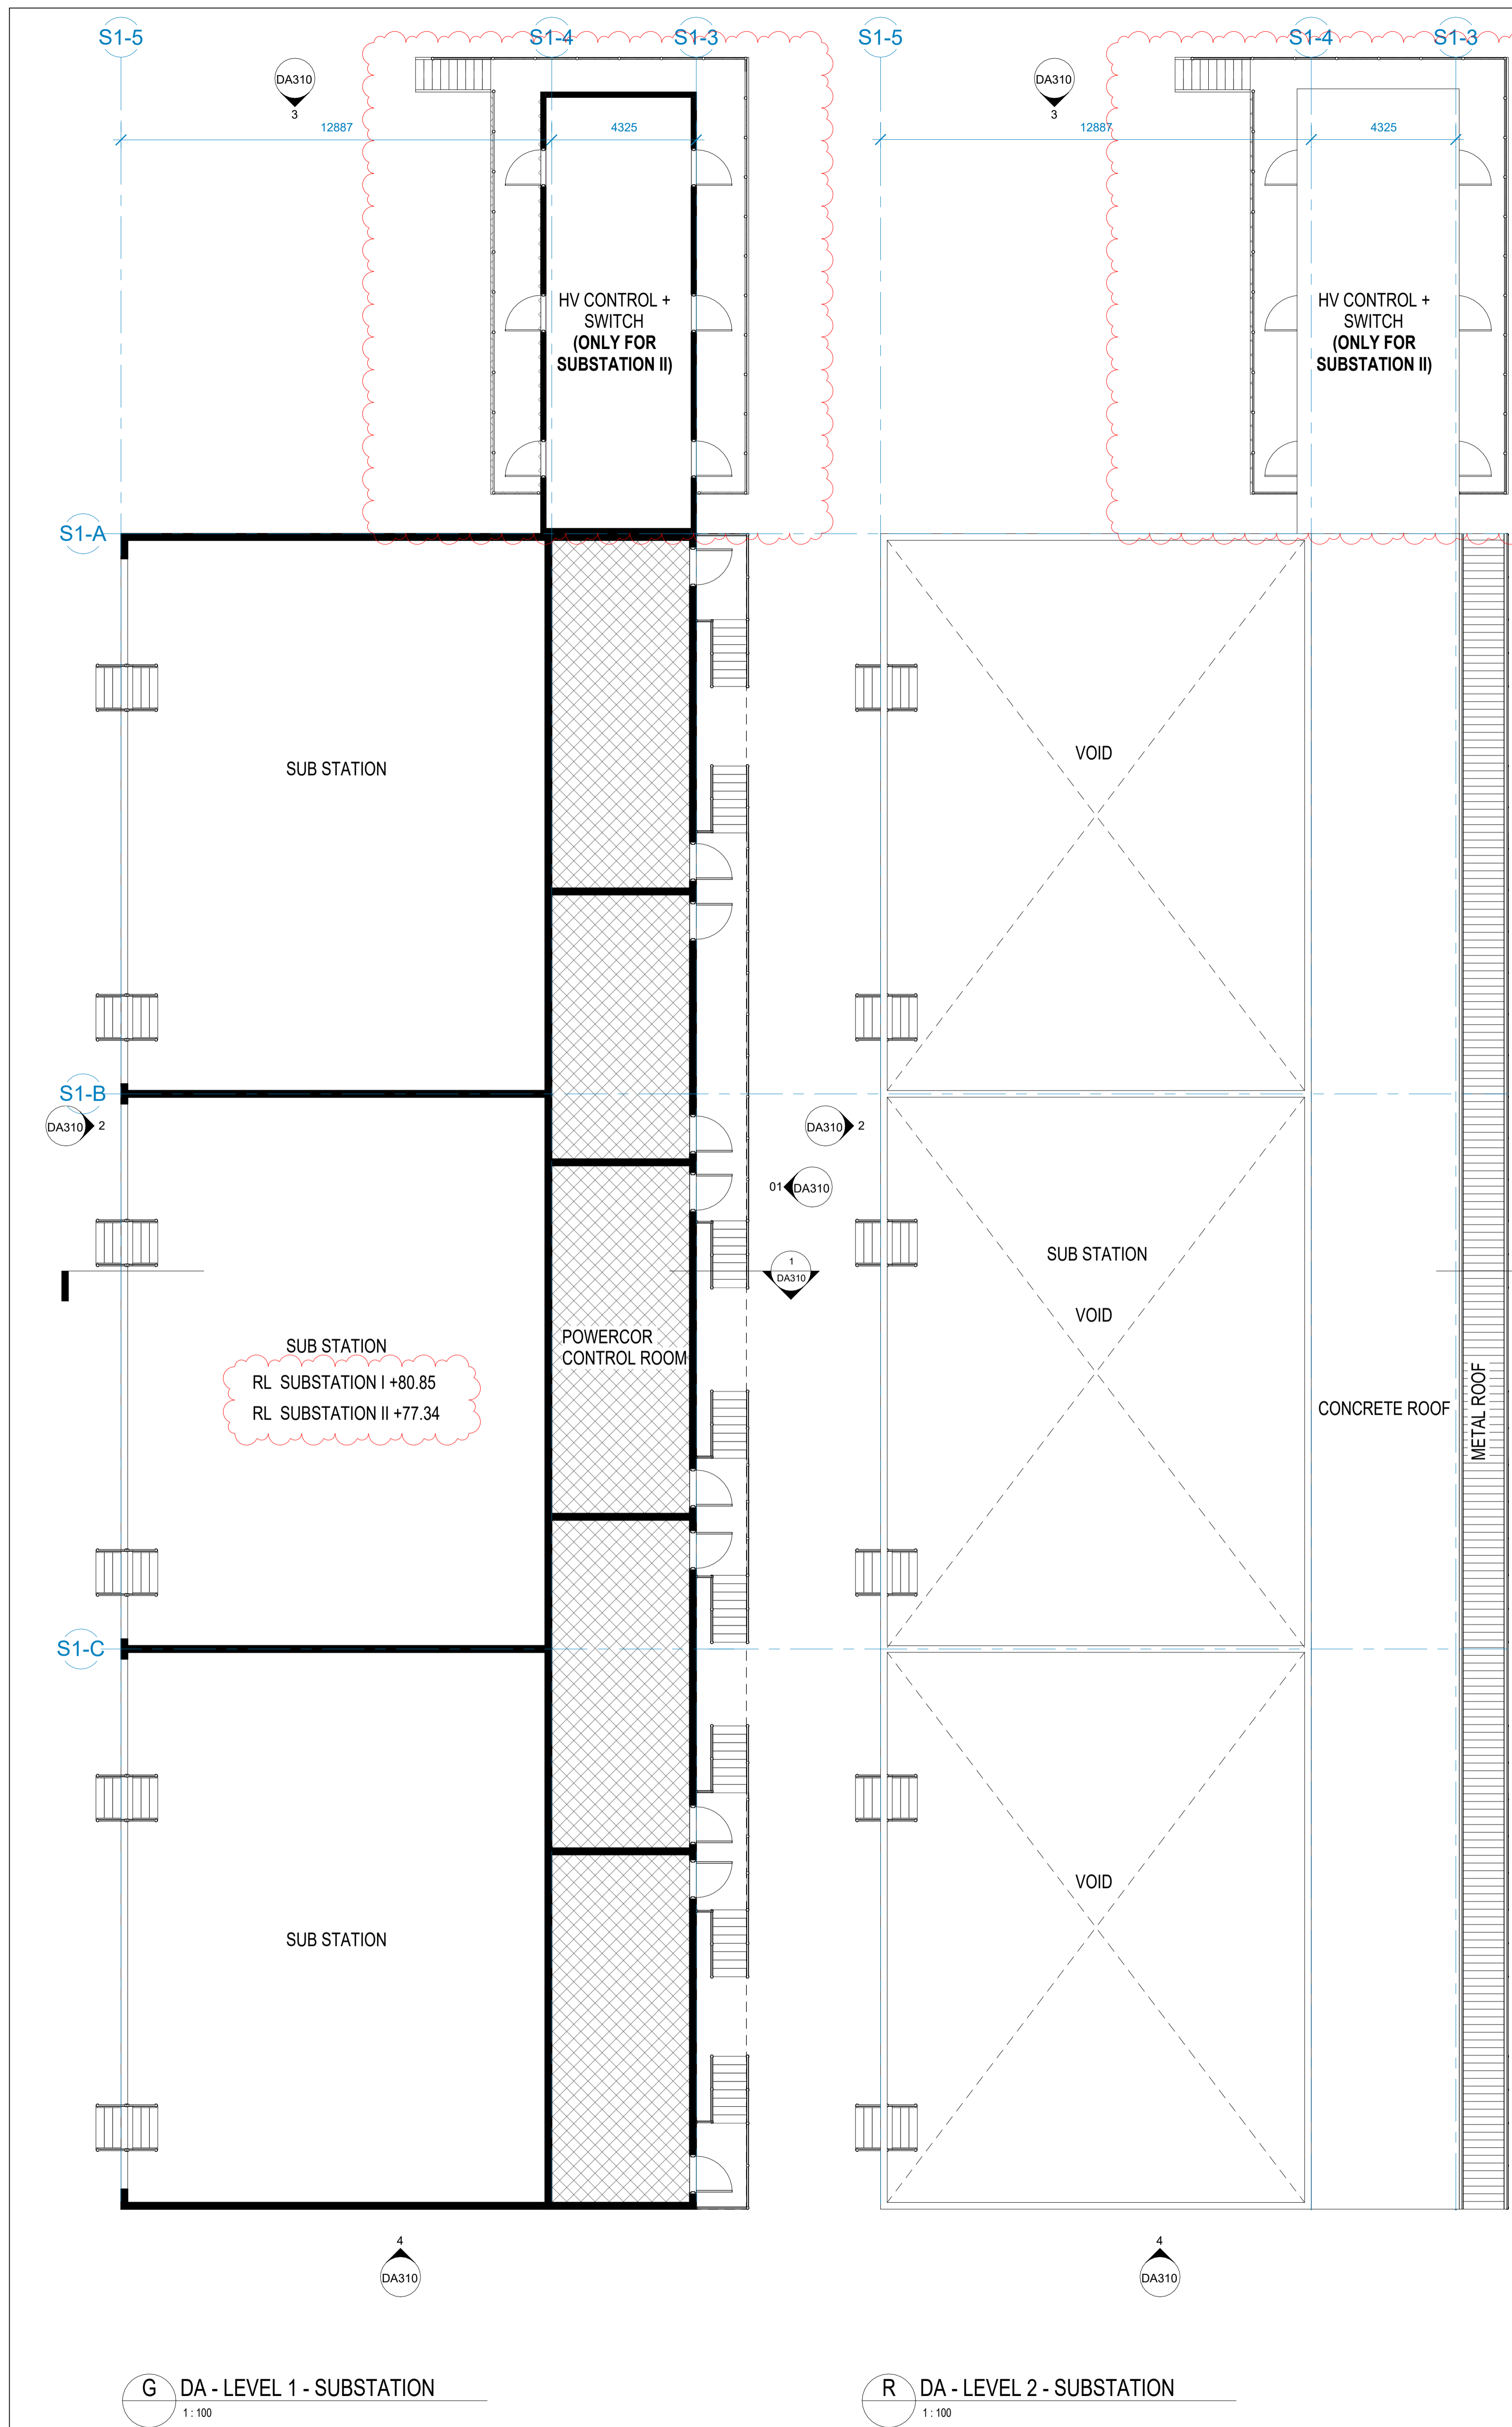


G DA - LEVEL 1 - SUBSTATION  
1:100


R DA - LEVEL 2 - SUBSTATION  
1:100

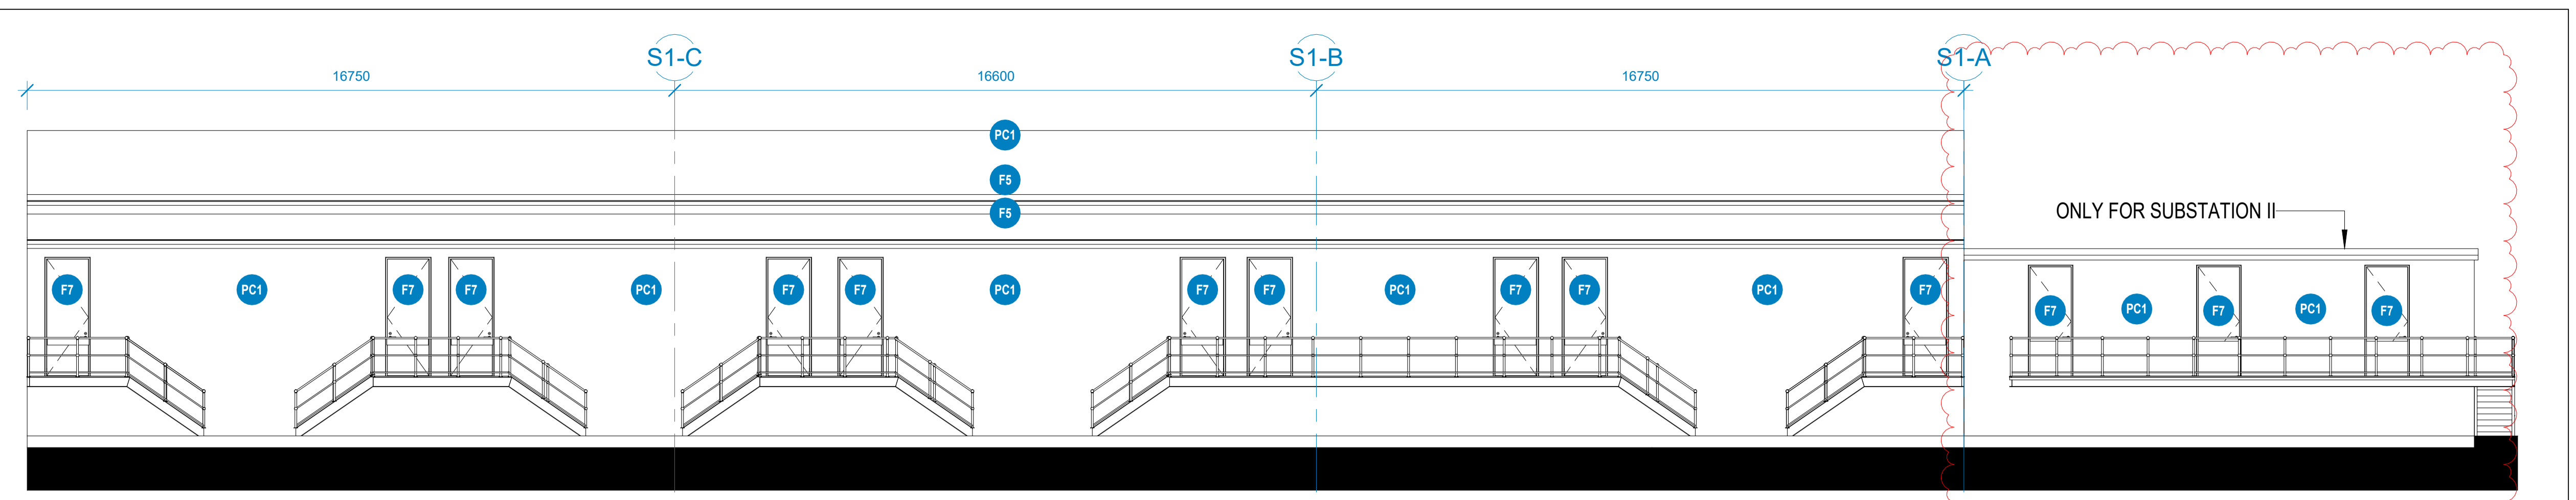


01 SUBSTATION ELEV 01  
1:100

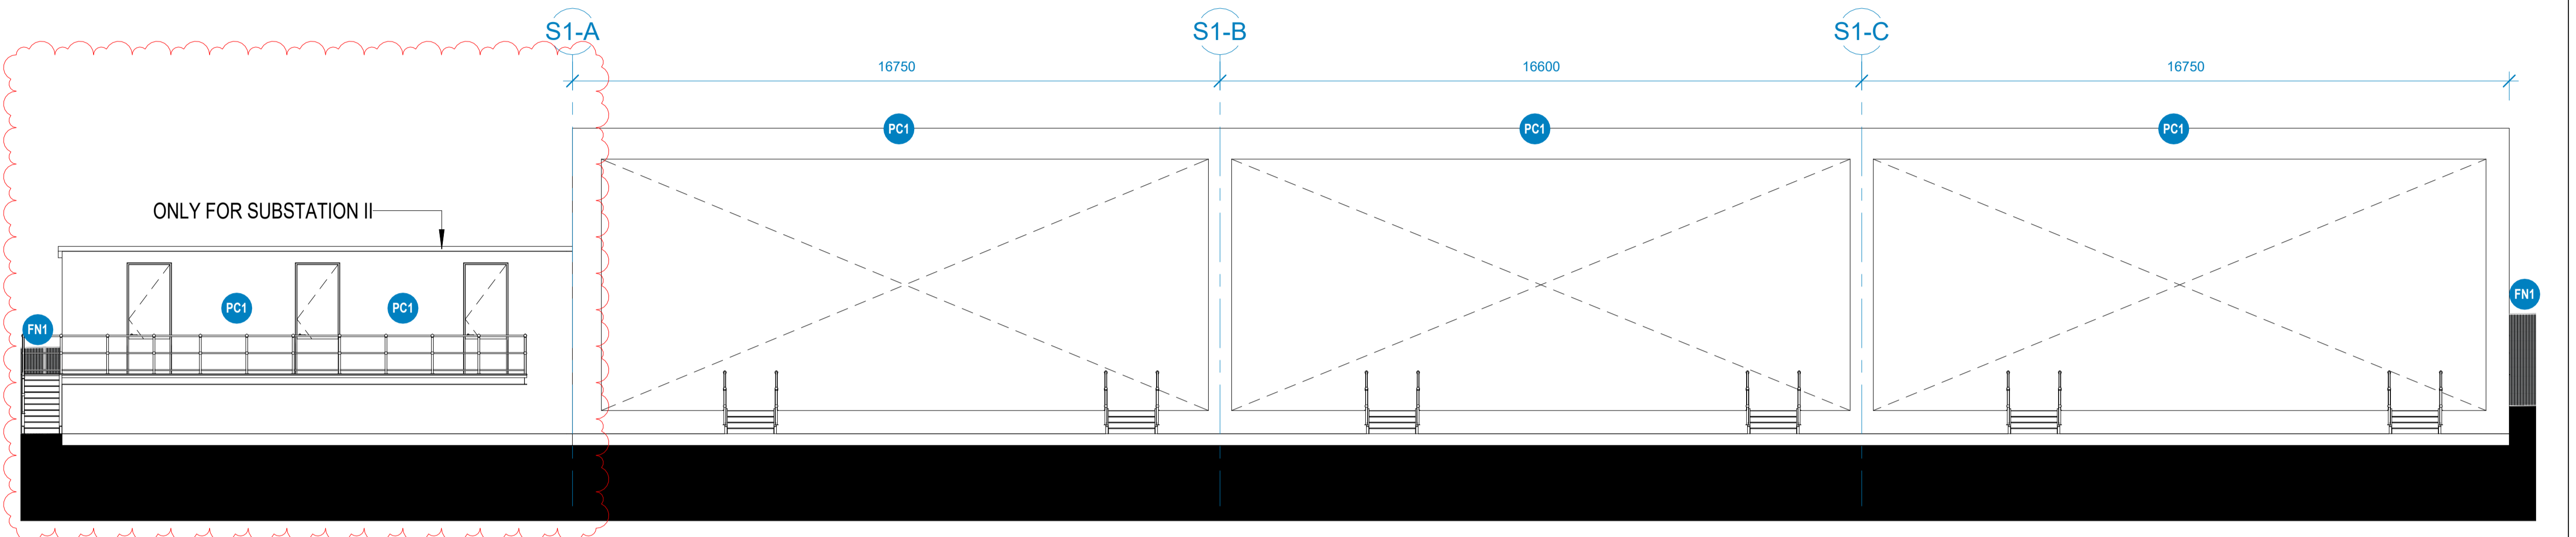


2 SUBSTATION ELEV 02  
1:100

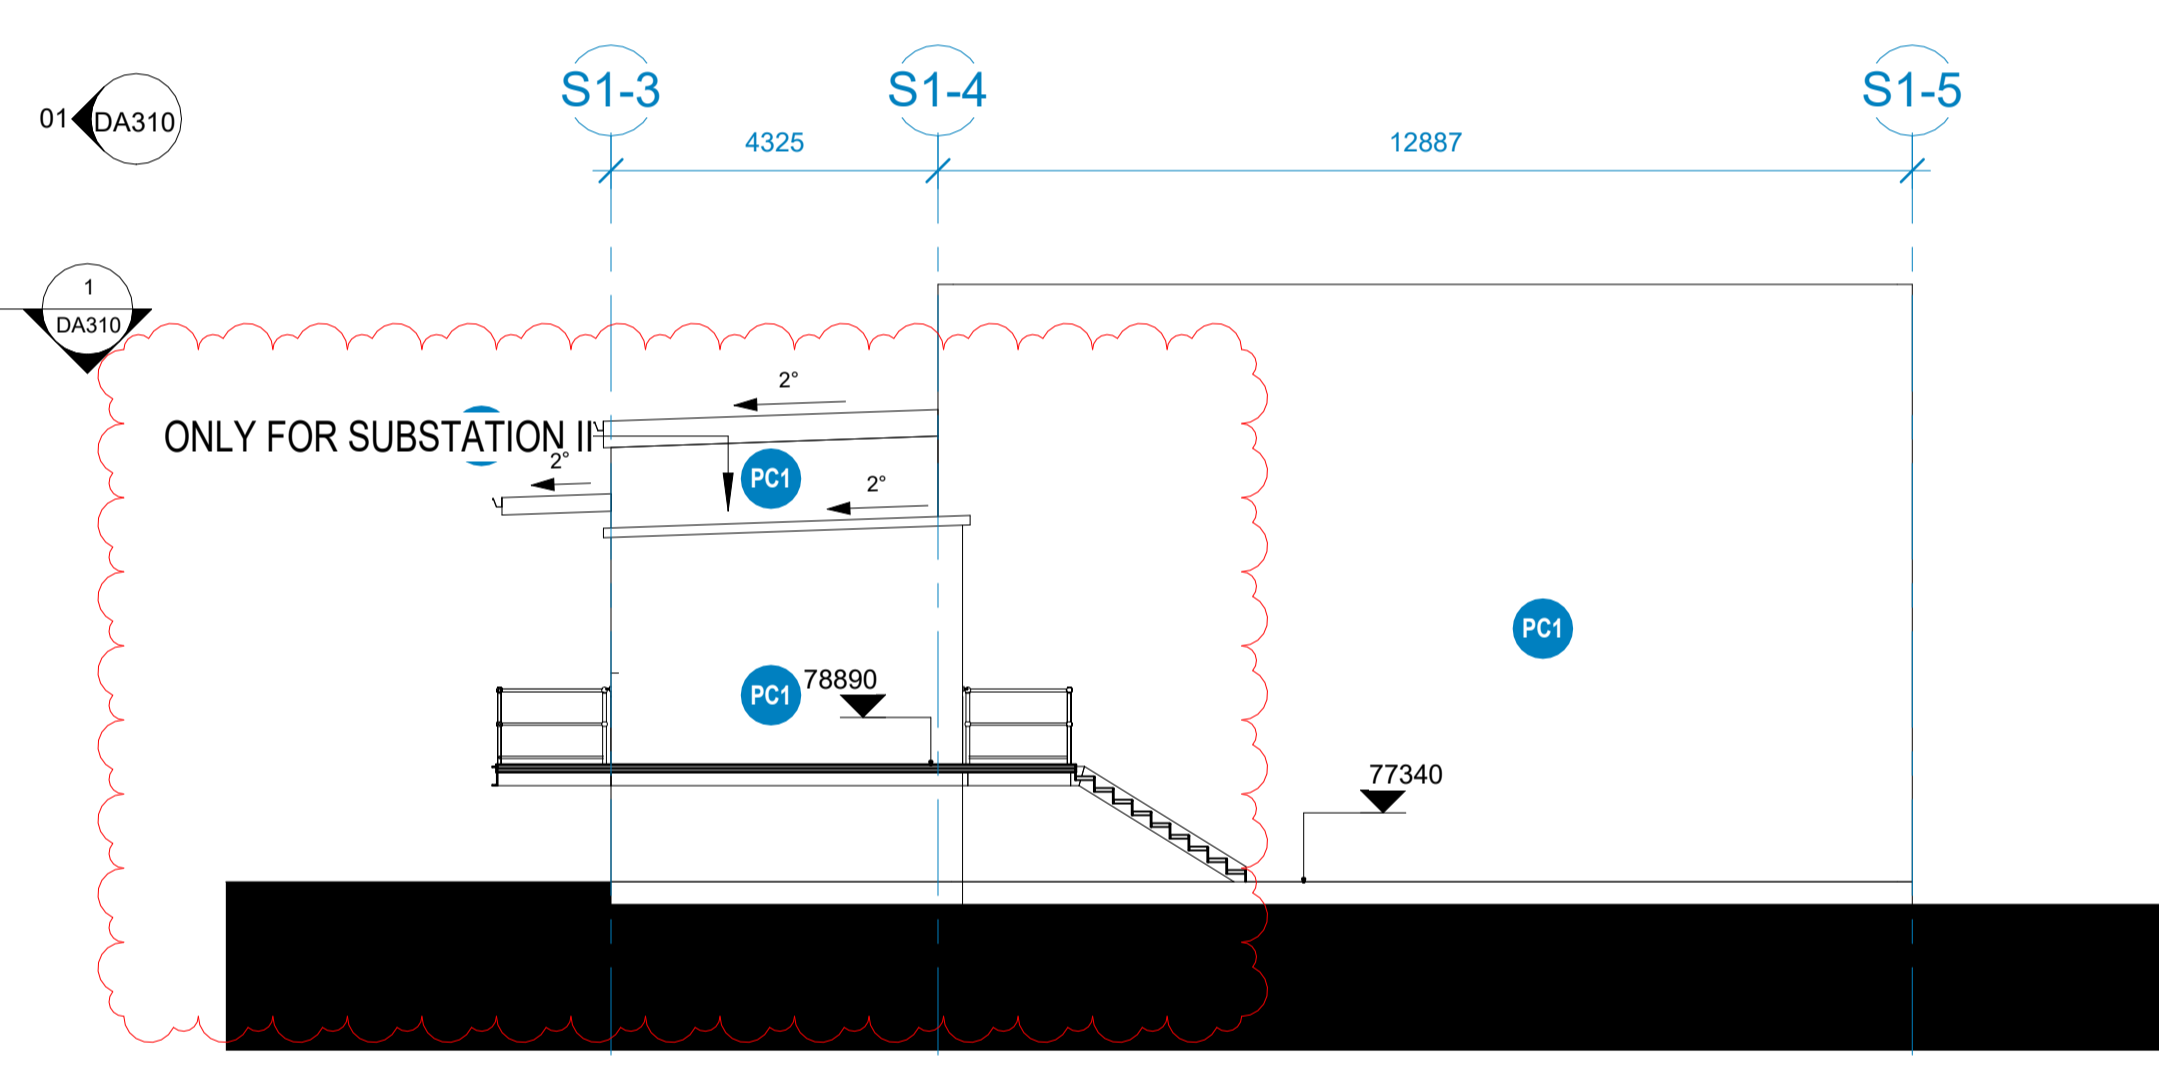

3 SUBSTATION ELEV 03  
1:100

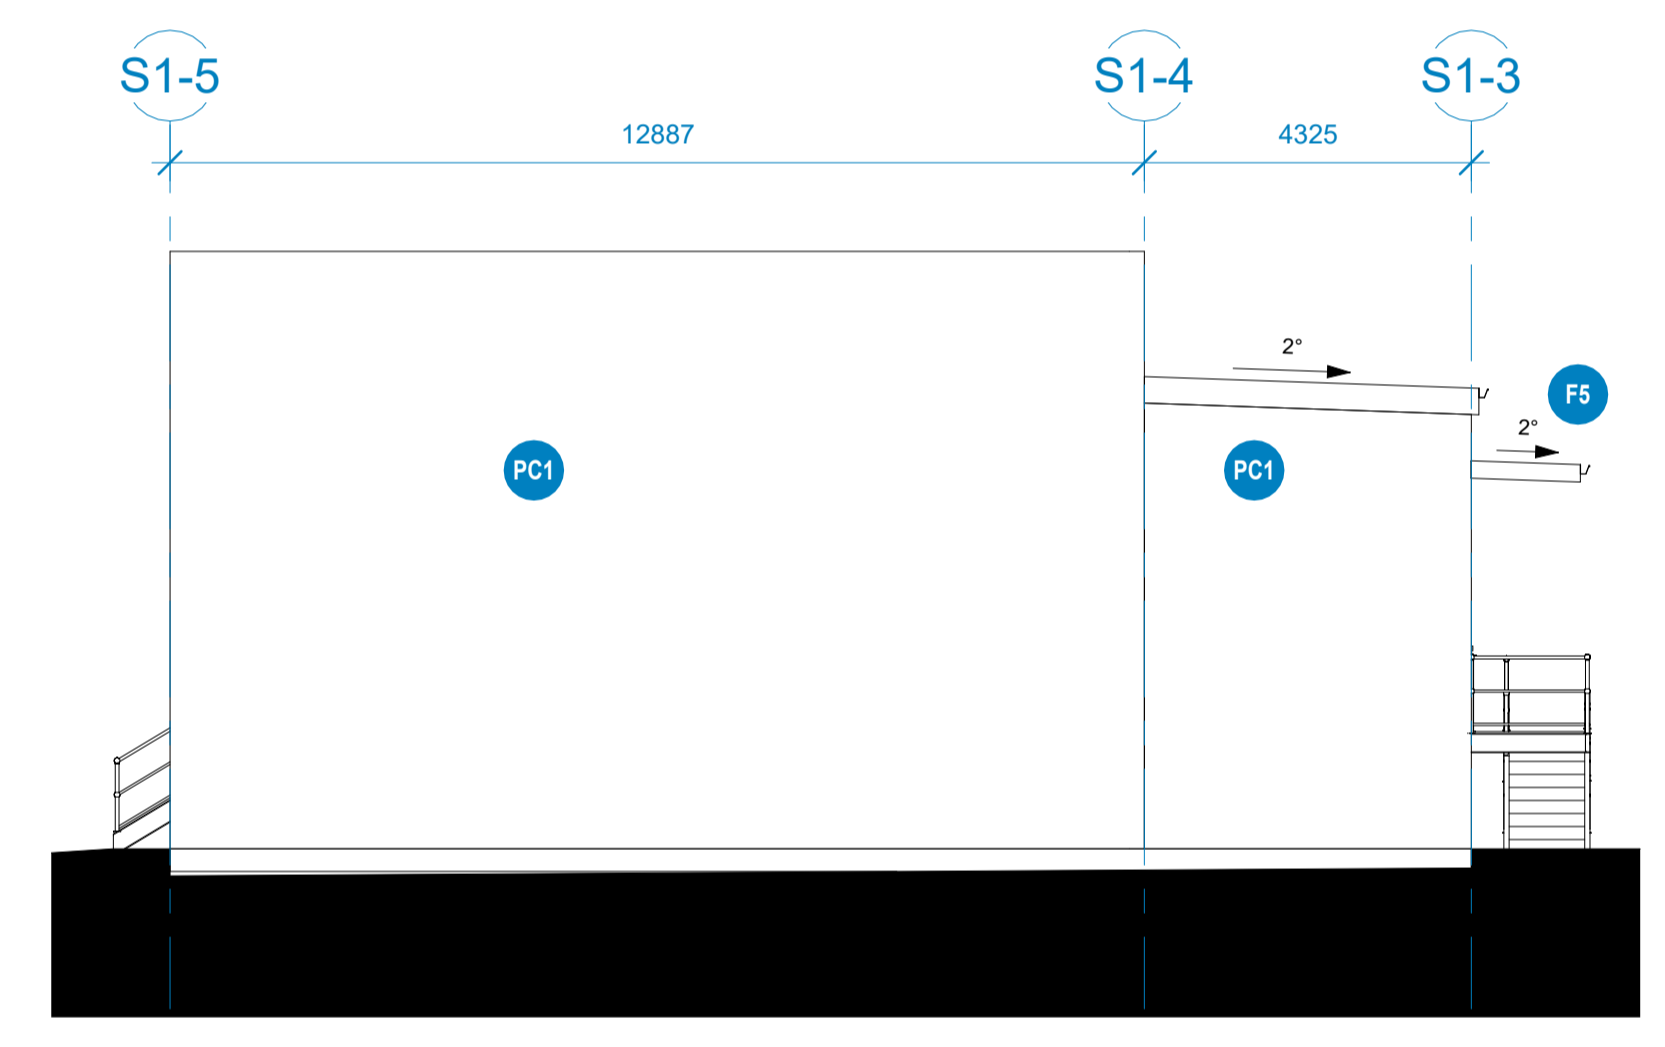

4 SUBSTATION ELEV 04  
1:100

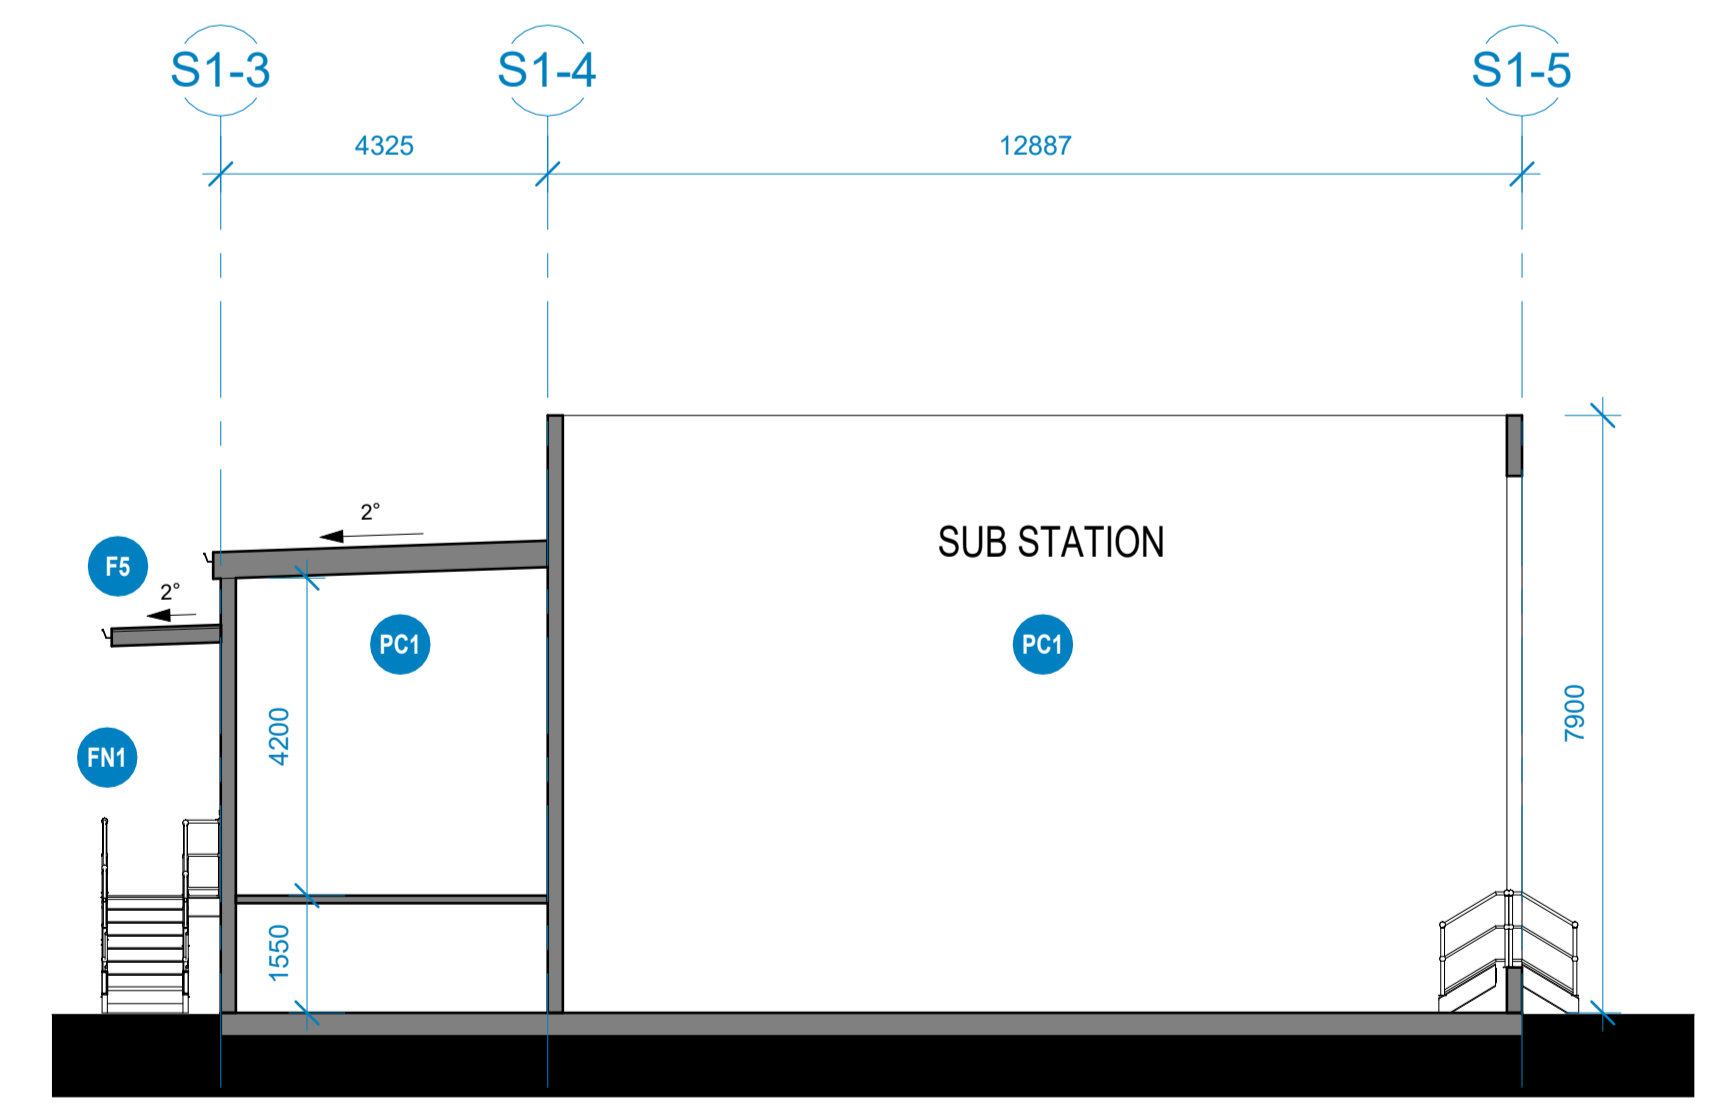


1 SUBSTATION SECTION  
1:100

NOTE:  
DRAWINGS MARKED AS "ONLY FOR SUBSTATION II"  
DO NOT APPLY TO OTHER SUBSTATIONS

	<b>Issue</b> A 31.07.2024 FOR DA B 21.08.2024 FOR DA C 26.08.2024 FOR DA D 28.08.2024 FOR DA E 18.12.2024 FOR DA	<b>Date</b> 31.07.2024 21.08.2024 26.08.2024 28.08.2024 18.12.2024	<b>Description</b> FOR DA FOR DA FOR DA FOR DA FOR DA	<b>Notes</b>	<b>Key Plan</b>	<b>Project Manager</b>	<b>Client</b> 	+61 2 8069 8600 LEVEL 22 68 PITT STREET SYDNEY NSW 2000 AUSTRALIA	GREENBOX ARCHITECTURE PTY LTD ABN: 79 139 778 098 ISO 9001 CERTIFIED QUALITY SYSTEM	• Use written dimensions only • Do not scale from drawing • Contractors shall confirm all dimensions on-site prior to commencing any work or producing any shop drawings • All materials to be used in accordance with the manufacturer's specifications and instructions and shall comply with the relevant Australian Standards • Copyright of this drawing and design remain the property of Greenbox Architecture Pty Ltd • Nominated Architect - Gerard Page; NSW reg No. 7247; Vic reg No. 17954; QLD reg no. 4538	<b>Client</b> EMKC	<b>Scale</b> 1:100	<b>Sheet</b> 1:100	<b>Scale Bar</b> 0 1 2 3 5m	<b>Project Status</b> DA SUBMISSION	<b>Project</b> PROPOSED DATA CENTRE 85-86 Sharps Road Tullamarine VIC 3043	<b>Checked By</b> DK/SFI	<b>Drawing Title</b> SUBSTATION I AND II DETAILS	<b>Approved By</b> AD	<b>Drawing Number</b> 240004	<b>Issue</b> G
	<b>Job Number</b> 240004	<b>Drawing Number</b> DA310	<b>Issue</b> G																		



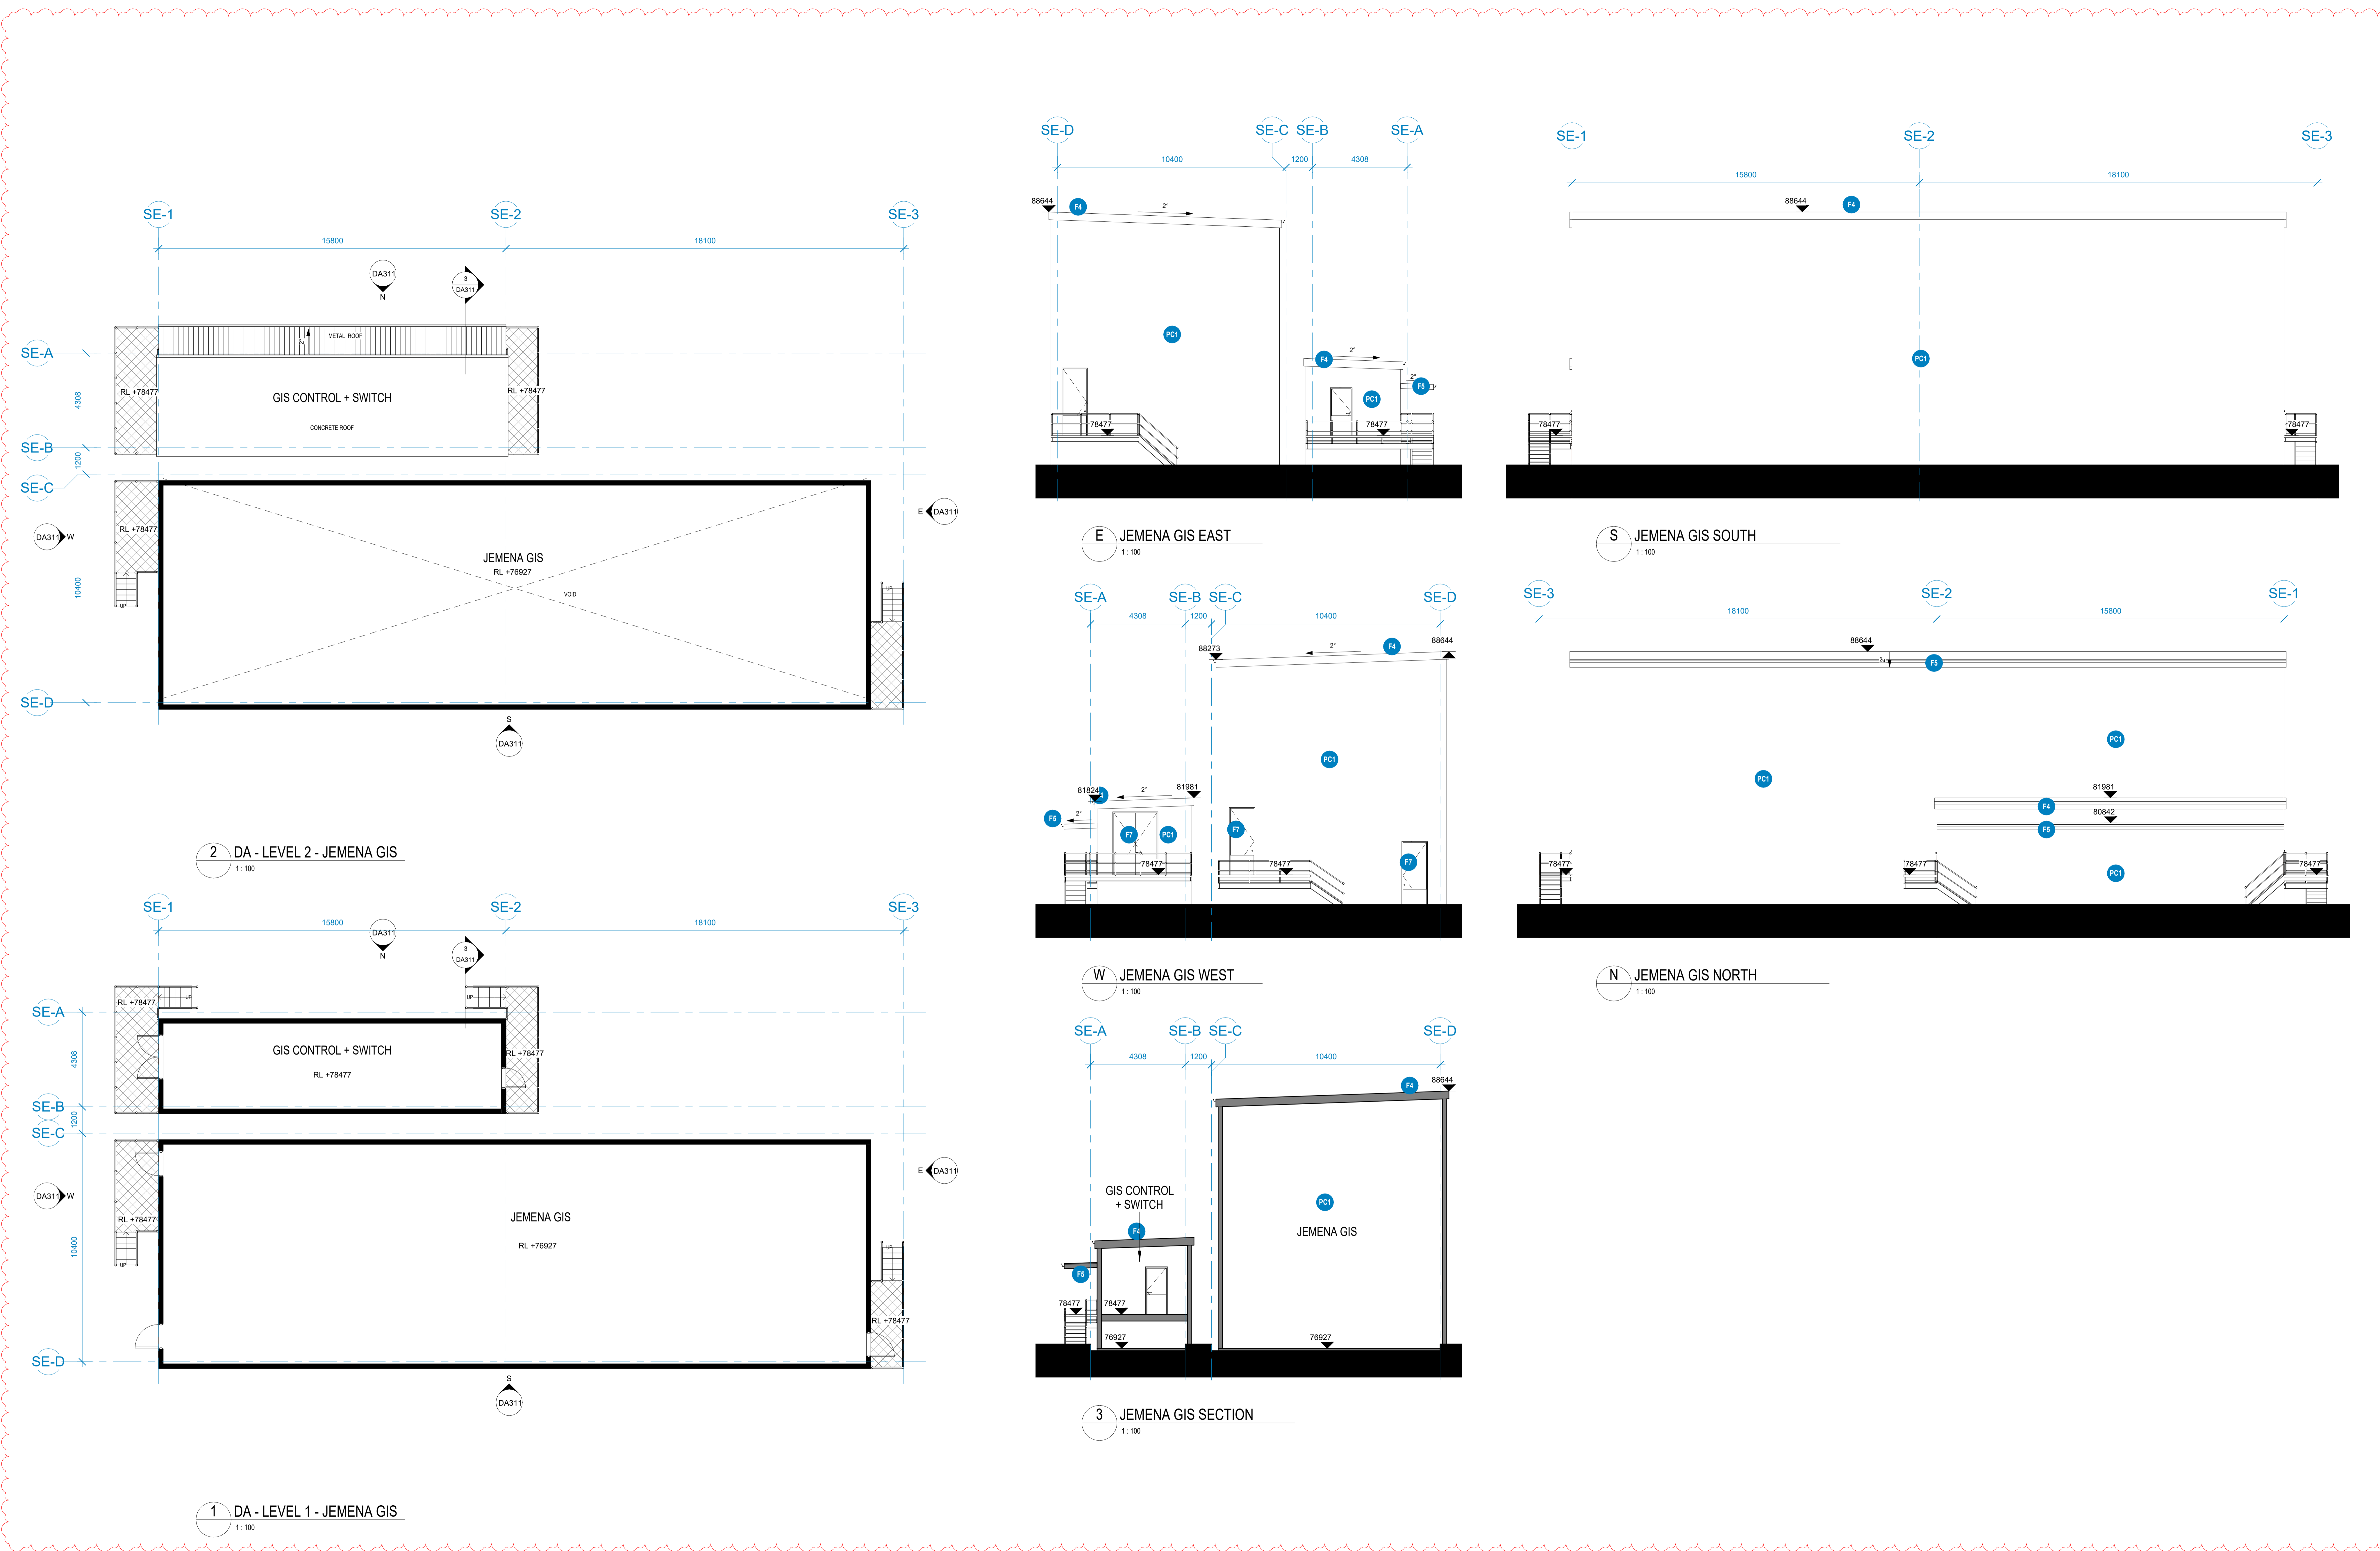

	<b>Issue</b> A 31.07.2024 FOR DA B 21.08.2024 FOR DA C 26.08.2024 FOR DA D 28.08.2024 FOR DA E 18.12.2024 FOR DA	<b>Date</b> 31.07.2024 21.08.2024 26.08.2024 28.08.2024 18.12.2024	<b>Description</b> FOR DA FOR DA FOR DA FOR DA FOR DA	<b>Notes</b>	<b>Key Plan</b>	<b>Project Manager</b>	<b>Client</b> 	<ul style="list-style-type: none"> <li>Use written dimensions only</li> <li>Do not scale from drawing</li> <li>Contractors shall confirm all dimensions on-site prior to commencing any work or producing any shop drawings</li> <li>All materials to be used in accordance with the manufacturer's specifications and instructions and shall comply with the relevant Australian Standards</li> <li>Copyright of this drawing and design remain the property of Greenbox Architecture Pty Ltd</li> <li>Nominated Architect - Gerard Page, NSW reg No. 7247, Vic reg No. 17954, QLD reg no. 4538</li> </ul>	<b>Client</b> EMKC	<b>Scale</b> 1:100	<b>Sheet</b> 1:100	<b>Scale Bar</b> 0 1 2 3 5m
	<b>Project</b> PROPOSED DATA CENTRE 85-86 Sharps Road Tullahoma VIC 3043	<b>Checked By</b> DK/SFI	<b>Approved By</b> AD	<b>Job Number</b> 240004	<b>Project Status</b> DA SUBMISSION	<b>Drawing Title</b> JEMENA GIS DETAILS	<b>Drawing Number</b> DA311	<b>Issue</b> G				