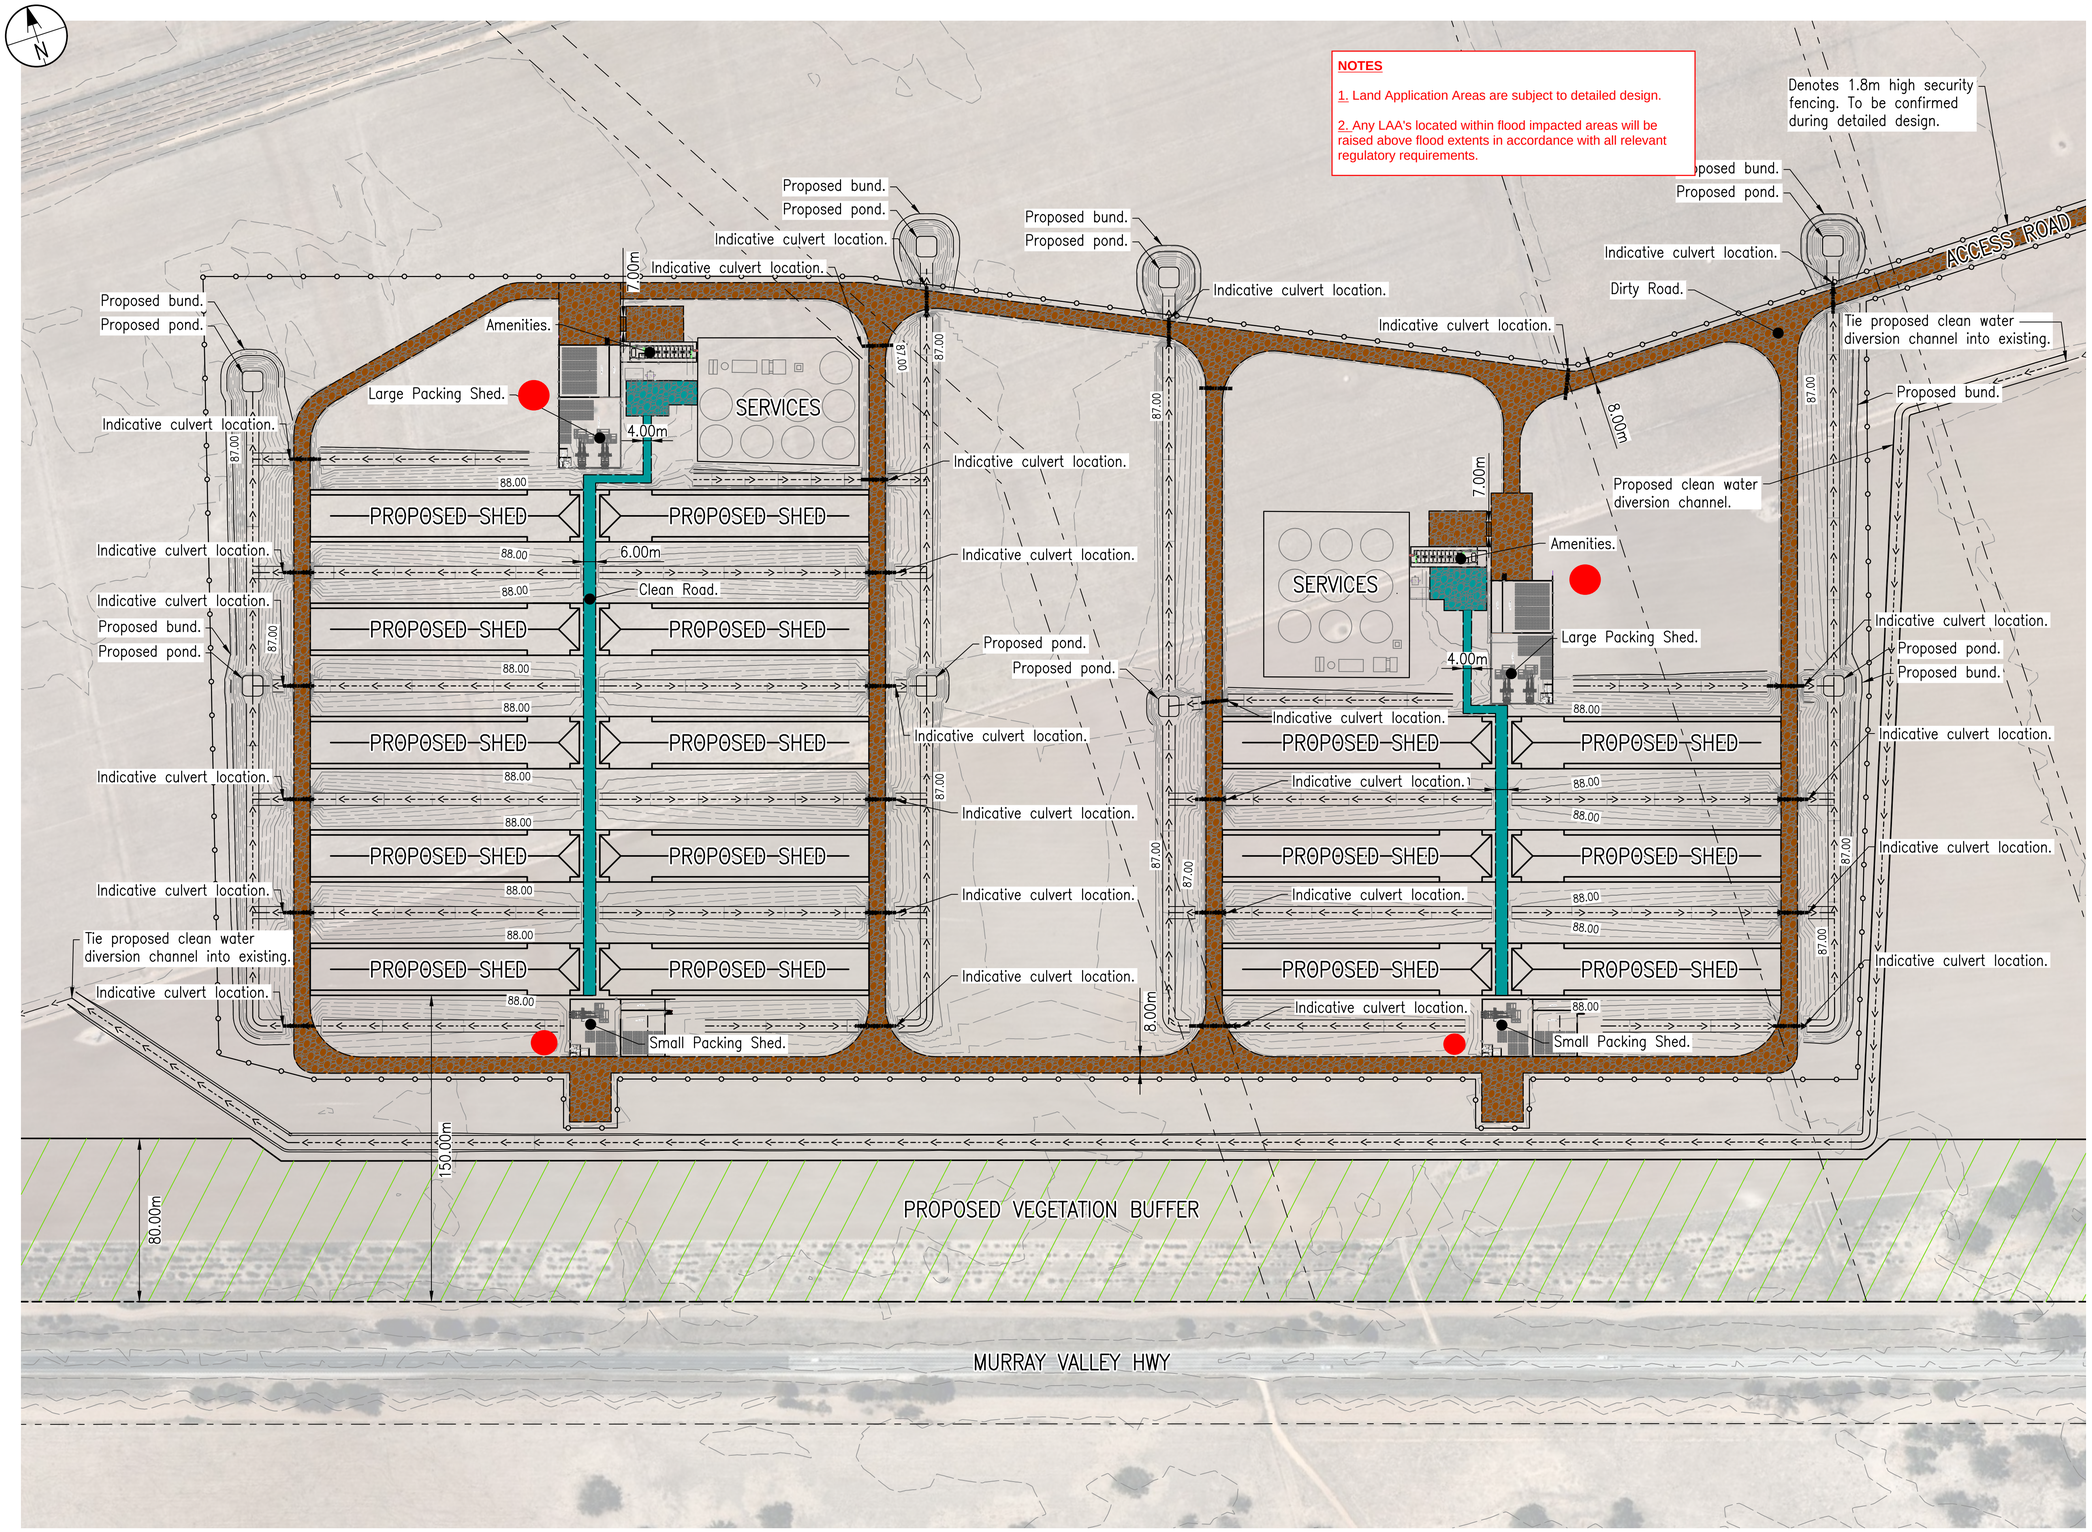

NOTES

1. Land Application Areas are subject to detailed design.

2. Any LAA's located within flood impacted areas will be raised above flood extents in accordance with all relevant regulatory requirements.

LEGEND:

EXISTING

- Invert
- Property Boundary

PROPOSED

- Clean Area Road Pavement
- Dirty Area Road Pavement
- Vegetation Buffer
- Property Boundary
- Minor Contours
- 609.00 Major Contours
- Invert
- --(D)---(D)-- Indicative Stormwater Culvert
- Fence

PLAN NOTES:

P.1. Plan is intended to be viewed in colour.
P.2. Intervals between contours - 0.2m.
Contours are design surface levels.

DISCLAIMER NOTES:

D.1. This is a sketch plan only and is conceptual only.
D.2. This sketch plan represents design intent and concepts only.
D.3. Information shown on these plans has been compiled from varying sources and may not be accurate and will need verifying. This includes imagery, existing infrastructure, property boundaries and natural surface data.
D.4. No reliance should be placed on the information on this plan for detailed design or any financial dealings involving this land.
D.5. This plan shall not be used for tendering, financing, ordering of materials, construction or any other unintended purpose.

Indicative Land Application Area (LAA) locations

ADVERTISED PLAN

This copied document to be made available for the sole purpose of enabling its consideration and review as part of a planning process under the Planning and Environment Act 1987. The document must not be used for any purpose which may breach any copyright

WARWICK'S BLOCK CAGE FREE CONCEPT LAYOUT PLAN

Scale 1:1500 (A1)

0 15 30 45 60m
1:1500(A1) 1:3000(A3)

ISSUE	DESCRIPTION	DATE	DWN	DES	CHK	APP
1	FOR APPROVAL	16/10/25	LMB	LMB	GS	
0	FOR APPROVAL	15/08/25	LMB	LMB	GS	
A	FOR COMMENT	08/08/25	LMB	LMB	GS	

R.P.E.Q.

THIS DOCUMENT IS UNCONTROLLED AND IS NOT TO BE USED FOR CONSTRUCTION UNTIL THIS NOTE IS REMOVED AND A DIGITAL SIGNATURE PROVIDED IN ITS PLACE

RMA Engineers
www.rmaeng.com.au

CLIENT
MCLEAN FARMS AUSTRALIA PTY LTD
PO BOX 158
PITTSWORTH, QLD, 4356

PROJECT
INTEGRATED EGG LAYING OPERATION
MURRAY VALLEY HIGHWAY
TORRUMBARRY, VIC, 3562

TITLE
WARWICK'S BLOCK CAGE FREE CONCEPT LAYOUT PLAN

COPYRIGHT RMA ENGINEERS PTY LTD ©

HEIGHT DATUM	MAP GRID	SIZE
AHD	VICGRID	A1

COUNCIL RAL/MCU NO.
-

COUNCIL OW NO.
-

PROJECT NO.	DRAWING NO.	ISSUE
25E-0010	P-SK2001	1

Copyright©: RMA ENGINEERS PTY LTD
N:\Synergy\Projects\25E-0010 Poultry Farm - Torrumbarry\8 Civil Model and Doc\MASTER DOCUMENTATION\02 Package\Drafting\P-SK2001.dwg P-SK2001